


DETAILS OF QUANTITIES
 3064.2 LINEAR FEET OF 24" VITRIFIED SEWER PIPE
 1076.1 LINEAR FEET OF 18" VITRIFIED SEWER PIPE (including pipe)
 621.0 LINEAR FEET OF 16" VITRIFIED SEWER PIPE (including pipe)
 6 - 18" x 4' WYES
 (16 MANHOLES) 6 - 3' WY AND 10 - 2' WY
 ONE 24" CONNECTION INTO PRESENT MANHOLE


Note:
 Vitrified pipe shall be double strength

PLAN AND PROFILE
 N^o 195
 OF
I STREET SEWER
 FROM VAN NESS AVENUE TO EIGHTH STREET
 SCALE (HORIZONTAL) 1" = 40 FEET
 AUG 1911. K.F. TULLIE, C.E.
 REVISED JUNE 1912
 REVISED NOV. 1912
 Levels B'58 F-1-9

ABBREVIATIONS
 THE MARK () MEANS FEET OR FOOT
 THE MARK (") MEANS INCH OR INCHES
 ELEV. MEANS ELEVATION
 BLUE LINES ON PLAN SHOW CURB LINE
 RED LINES ON PLAN SHOW CENTER
 LINES OF SEWER
 RED LINE ON PROFILE SHOWS GRADE
 OF BOTTOM OF SEWER
 RED LINES ON PLAN MARKED "S" SHOW
 LOCATION OF WYES
 BLACK LINES ON PLAN SHOW PROPERTY LINES

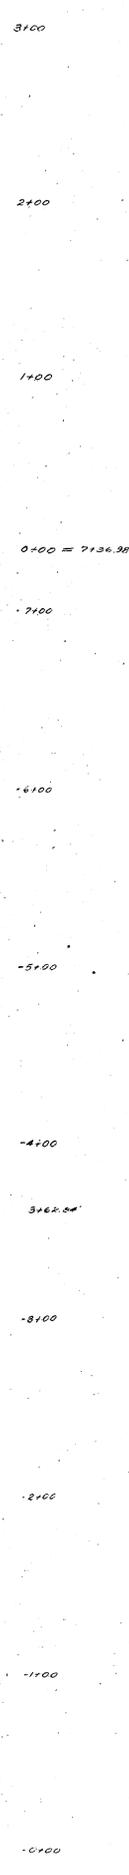

Plan No. 98 - I Street Sewer - Van Ness Ave to 8th Street

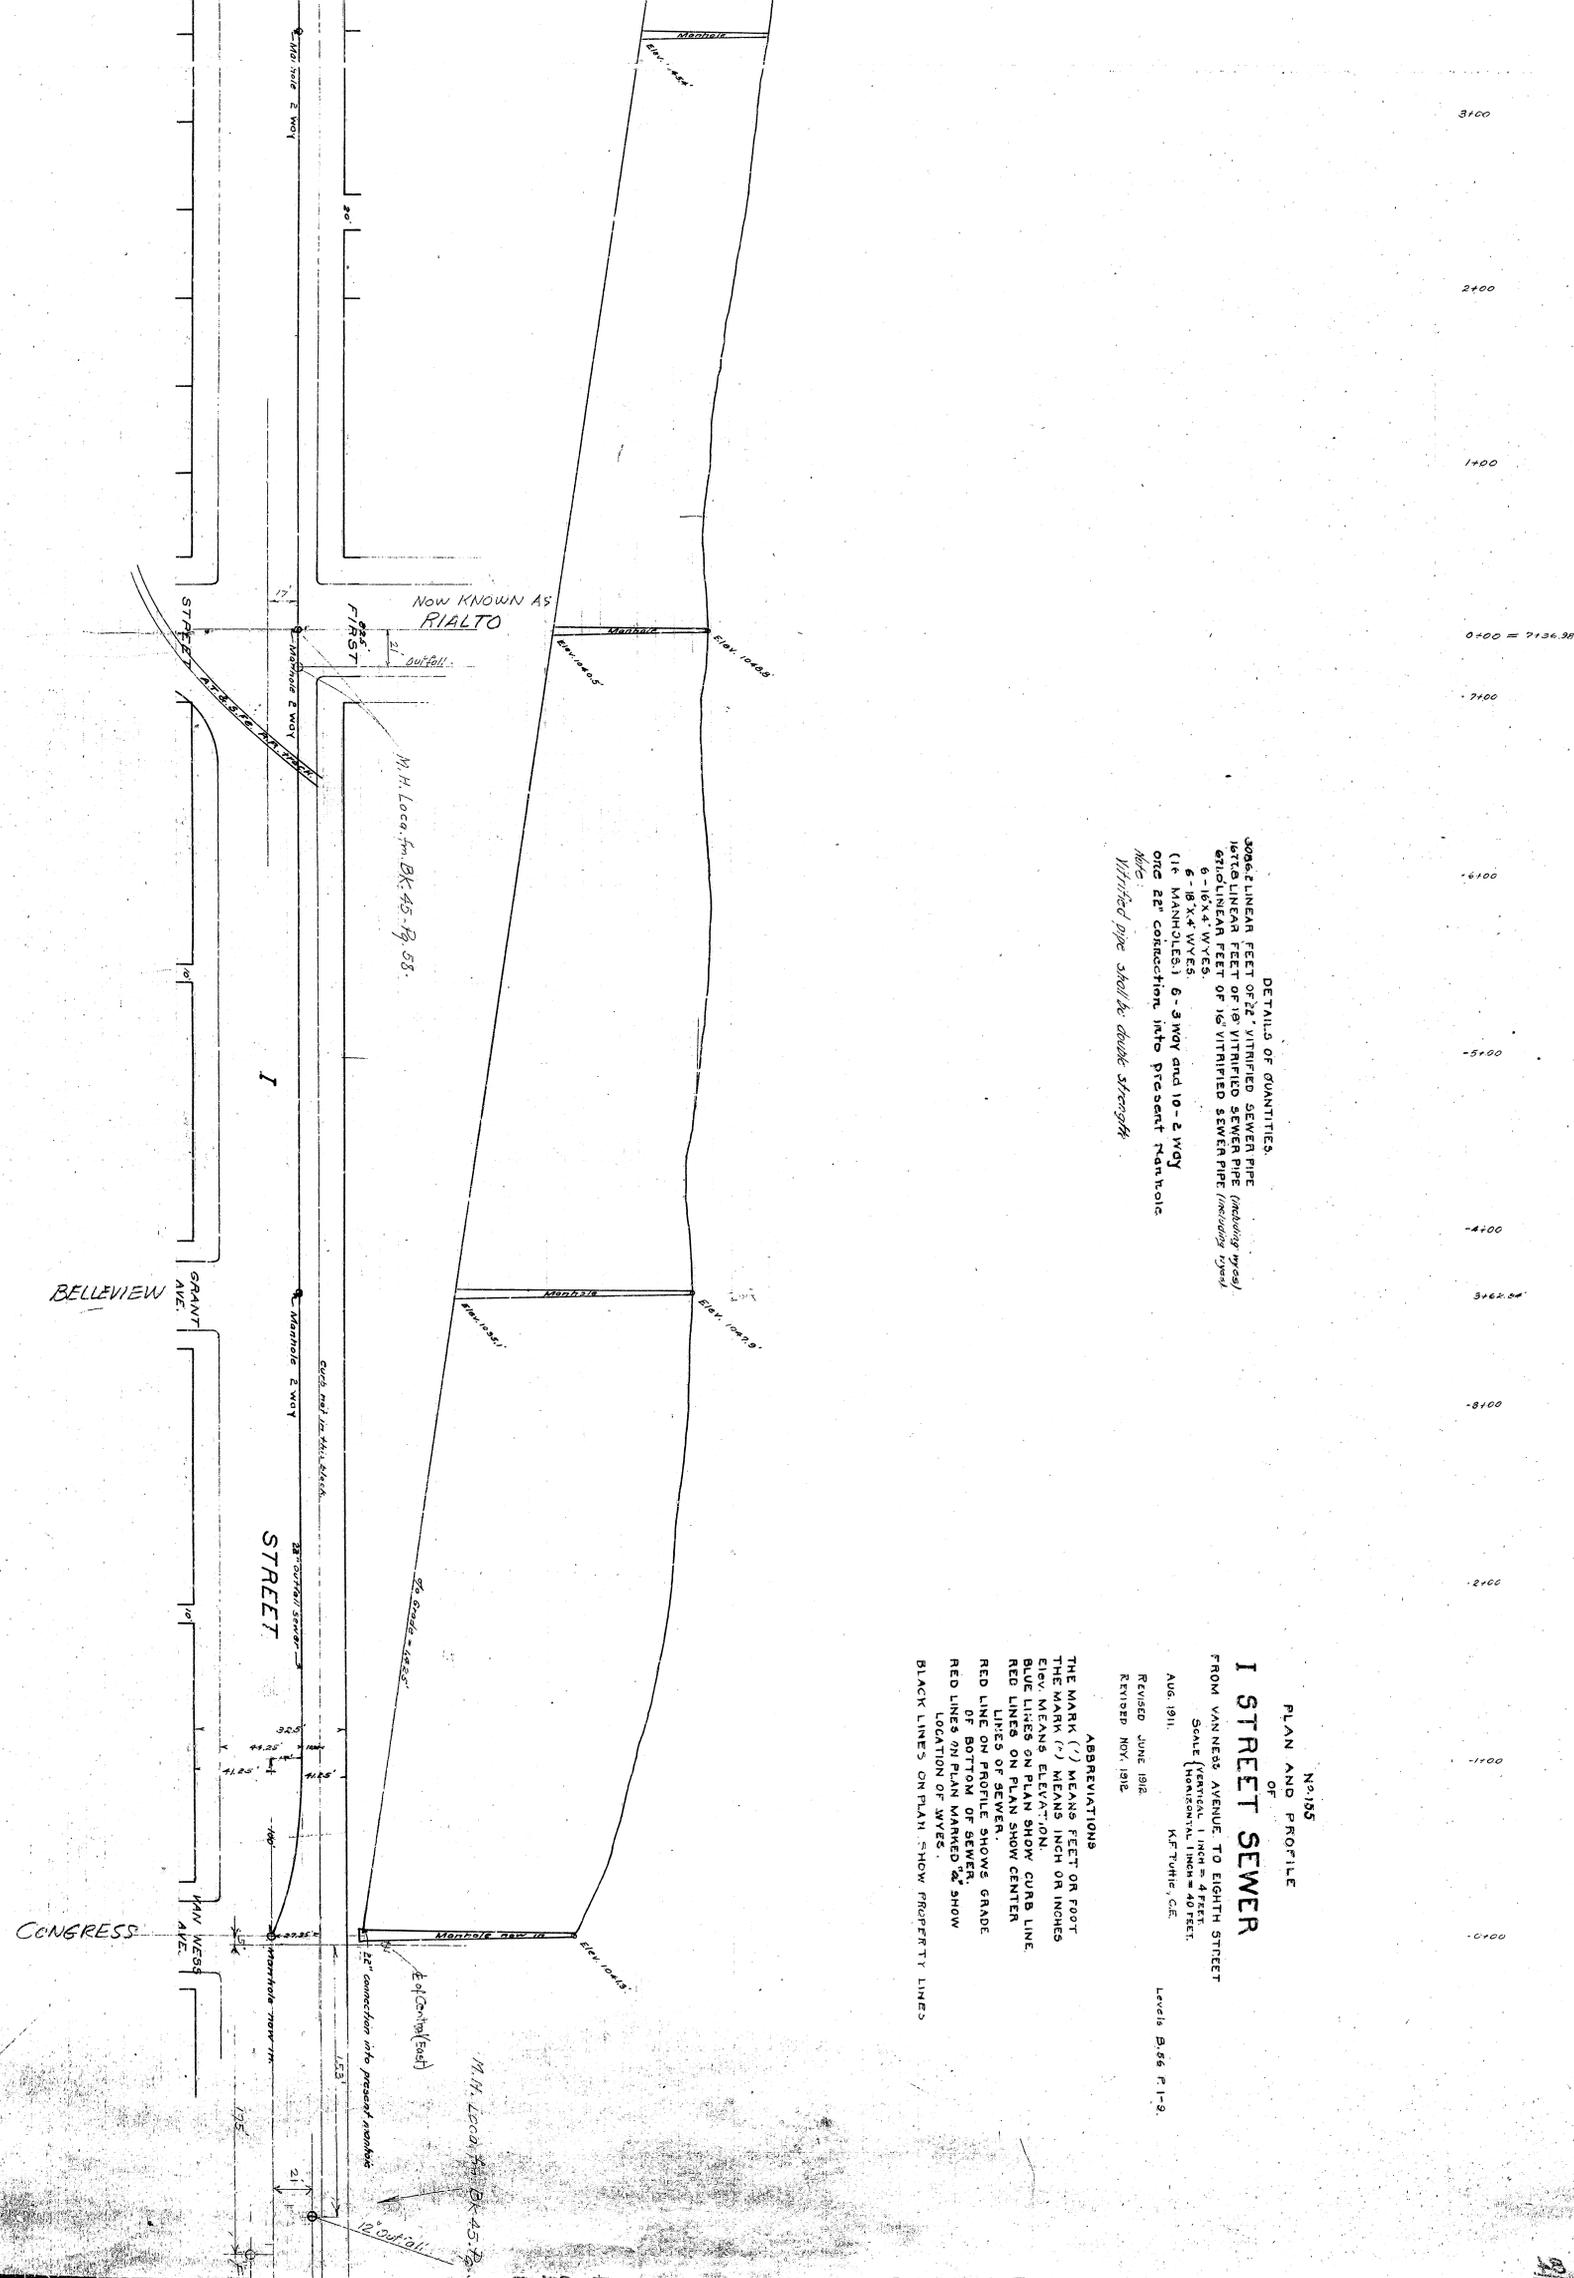


DETAILS OF QUANTITIES
 3064.2 LINEAR FEET OF 24" VITRIFIED SEWER PIPE
 1076.1 LINEAR FEET OF 18" VITRIFIED SEWER PIPE (including pipe)
 621.0 LINEAR FEET OF 16" VITRIFIED SEWER PIPE (including pipe)
 6 - 18" x 4' WYES
 (16 MANHOLES) 6 - 3' WY AND 10 - 2' WY
 ONE 24" CONNECTION INTO PRESENT MANHOLE

PLAN AND PROFILE
 N^o 195
 OF
I STREET SEWER
 FROM VAN NESS AVENUE TO EIGHTH STREET
 SCALE (HORIZONTAL) 1" = 40 FEET
 AUG 1911. K.F. TULLIE, C.E.
 REVISED JUNE 1912
 REVISED NOV. 1912
 LEVELS BY S.F. 1-9.

ABBREVIATIONS
 THE MARK () MEANS FEET OR FOOT
 THE MARK (") MEANS INCH OR INCHES
 ELEV. MEANS ELEVATION.
 BLUE LINES ON PLAN SHOW CURB LINE
 RED LINES ON PLAN SHOW CENTER
 LINES OF SEWER.
 RED LINE ON PROFILE SHOWS GRADE
 OF BOTTOM OF SEWER.
 RED LINES ON PLAN MARKED "S" SHOW
 LOCATION OF WYES.
 BLACK LINES ON PLAN SHOW PROPERTY LINES

Note:
 Vitrified pipe shall be double strength

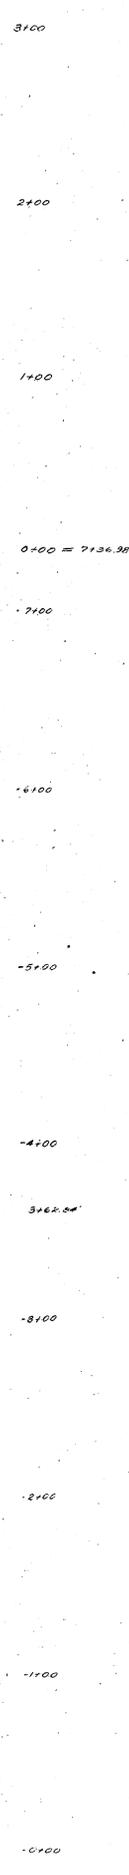

Plan No 98
 I Street Sewer - Van Ness Ave to 8th Street