

PLAN
Scale: 1" = 40'

TITLE TO STREET

Genevieve Street, adjudicated by Map of "Tract No. 2059" - Recorded Book 22 of Maps, - Page 24 - Thirtieth Street, dedicated by Map of "Arrowhead Tract" - Recorded Book 11 of Maps, - Page 37, Genevieve Street - By Deed recorded in Book 1257 of Page 237, 238, 239, 999, 1000.

GRADE



Grade of Genevieve Street established by Resolution No. 178, adopted March 23, 1931. Grade of Thirtieth Street established by Ordinance No. 1270, adopted January 4, 1930.

Plan adopted March 31, 1947

SHEET No. 1
PLAN No. 1692
FOR SEWER IN
GENEVIEVE STREET
BETWEEN THIRTIETH ST. AND MARSHALL BOULEVARD
AND IN THIRTIETH ST.
BETWEEN MOUNTAIN VIEW AVE AND GENEVIEVE ST.
MARCH 1947

CITY OF SAN BERNARDINO
CALIFORNIA

EDGA
CITY

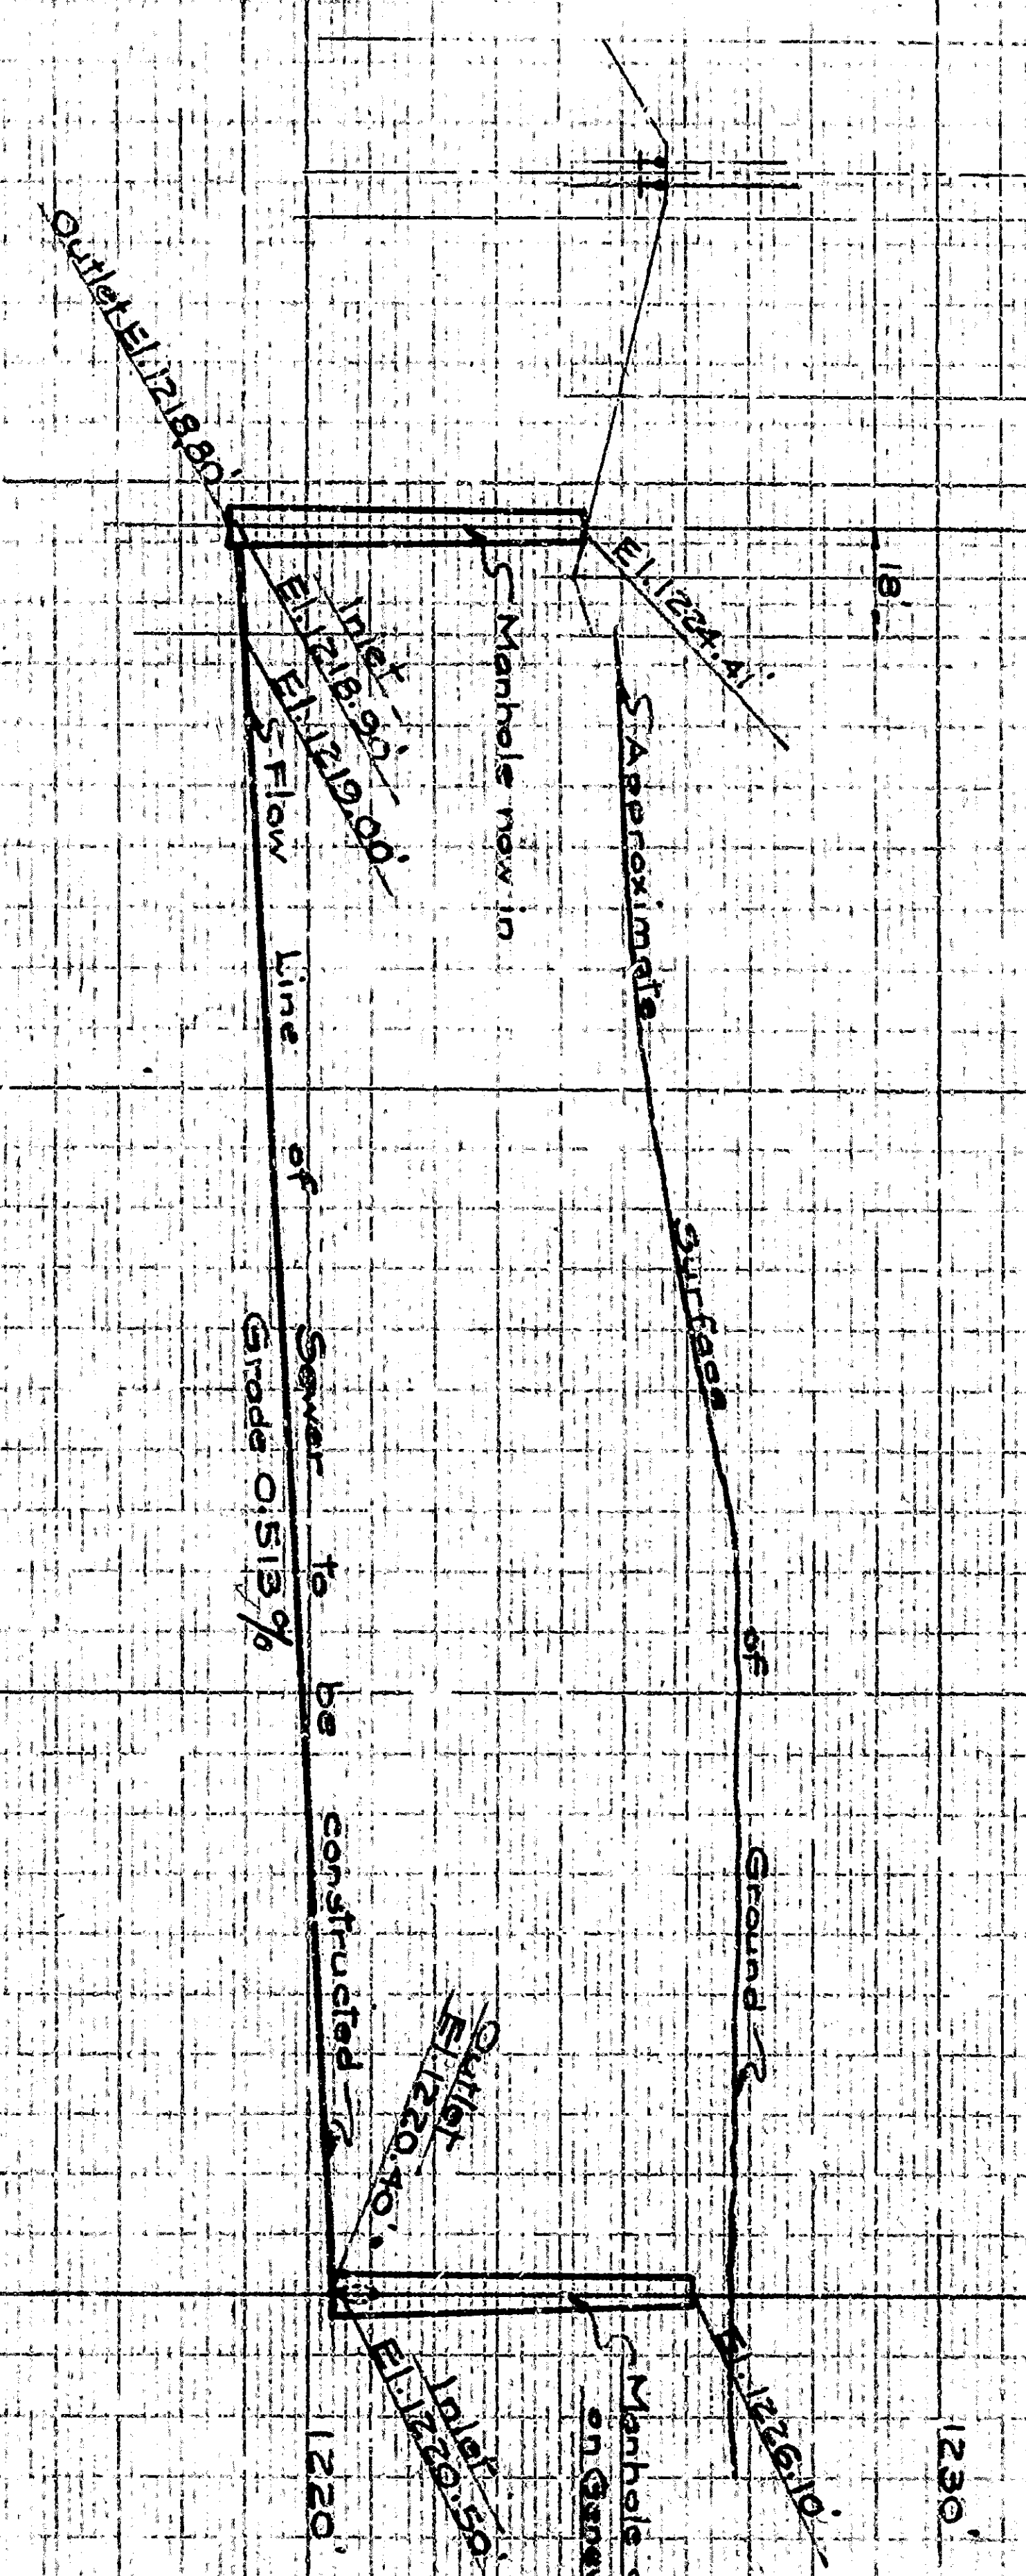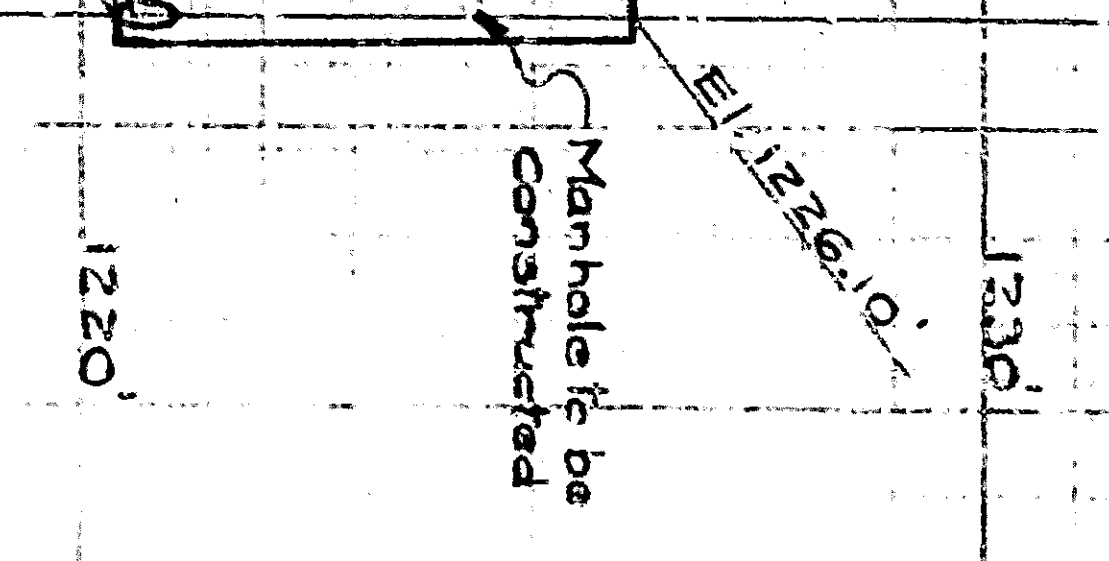

PROFILE

Horizontal - 1" = 40'
Vertical - 1" = 4'

PROFILE LEGEND

As shown, Elevation Surface of Ground, Thru, etc.
Line of Sewer to be constructed, Thru, etc.



LEGEND

1/2" or in, means inch or inches	Blue, means distance
1/2" or in, means feet or feet	Red, means property
No. means No. of feet	Lin. means line
4" means center line	
St. means Street	
500' means station	
Manhole, now in shown this	
Sewer now in shown this	
Standard type manhole to be constructed shown this	
4" 1/2" 6" 8" 10" 12" 14" 16" 18" 20" 24" 28" 30" 36" 42" 48" 54" 60" 72" 84" 96" 108" 120" 144" 168" 192" 216" 240" 270" 300" 360" 420" 480" 540" 600"	
4" 6" 8" 10" 12" 14" 16" 18" 20" 24" 28" 30" 36" 42" 48" 54" 60" 72" 84" 96" 108" 120" 144" 168" 192" 216" 240" 270" 300" 360" 420" 480" 540" 600"	
4" 6" 8" 10" 12" 14" 16" 18" 20" 24" 28" 30" 36" 42" 48" 54" 60" 72" 84" 96" 108" 120" 144" 168" 192" 216" 240" 270" 300" 360" 420" 480" 540" 600"	
4" 6" 8" 10" 12" 14" 16" 18" 20" 24" 28" 30" 36" 42" 48" 54" 60" 72" 84" 96" 108" 120" 144" 168" 192" 216" 240" 270" 300" 360" 420" 480" 540" 600"	

**APPROXIMATE
DETAIL OF SEWER
TO BE CONSTRUCTED
AS FOLLOWS**

No. Lin. Ft. of 6" vitrified pipe sewer	142.47'
No. Lin. Ft. of 4" vitrified pipe sewer	61.5'
No. of 6" 4" boxes with 4" connecting sewer	41
No. of standard type manholes	3

EDGA
CITY

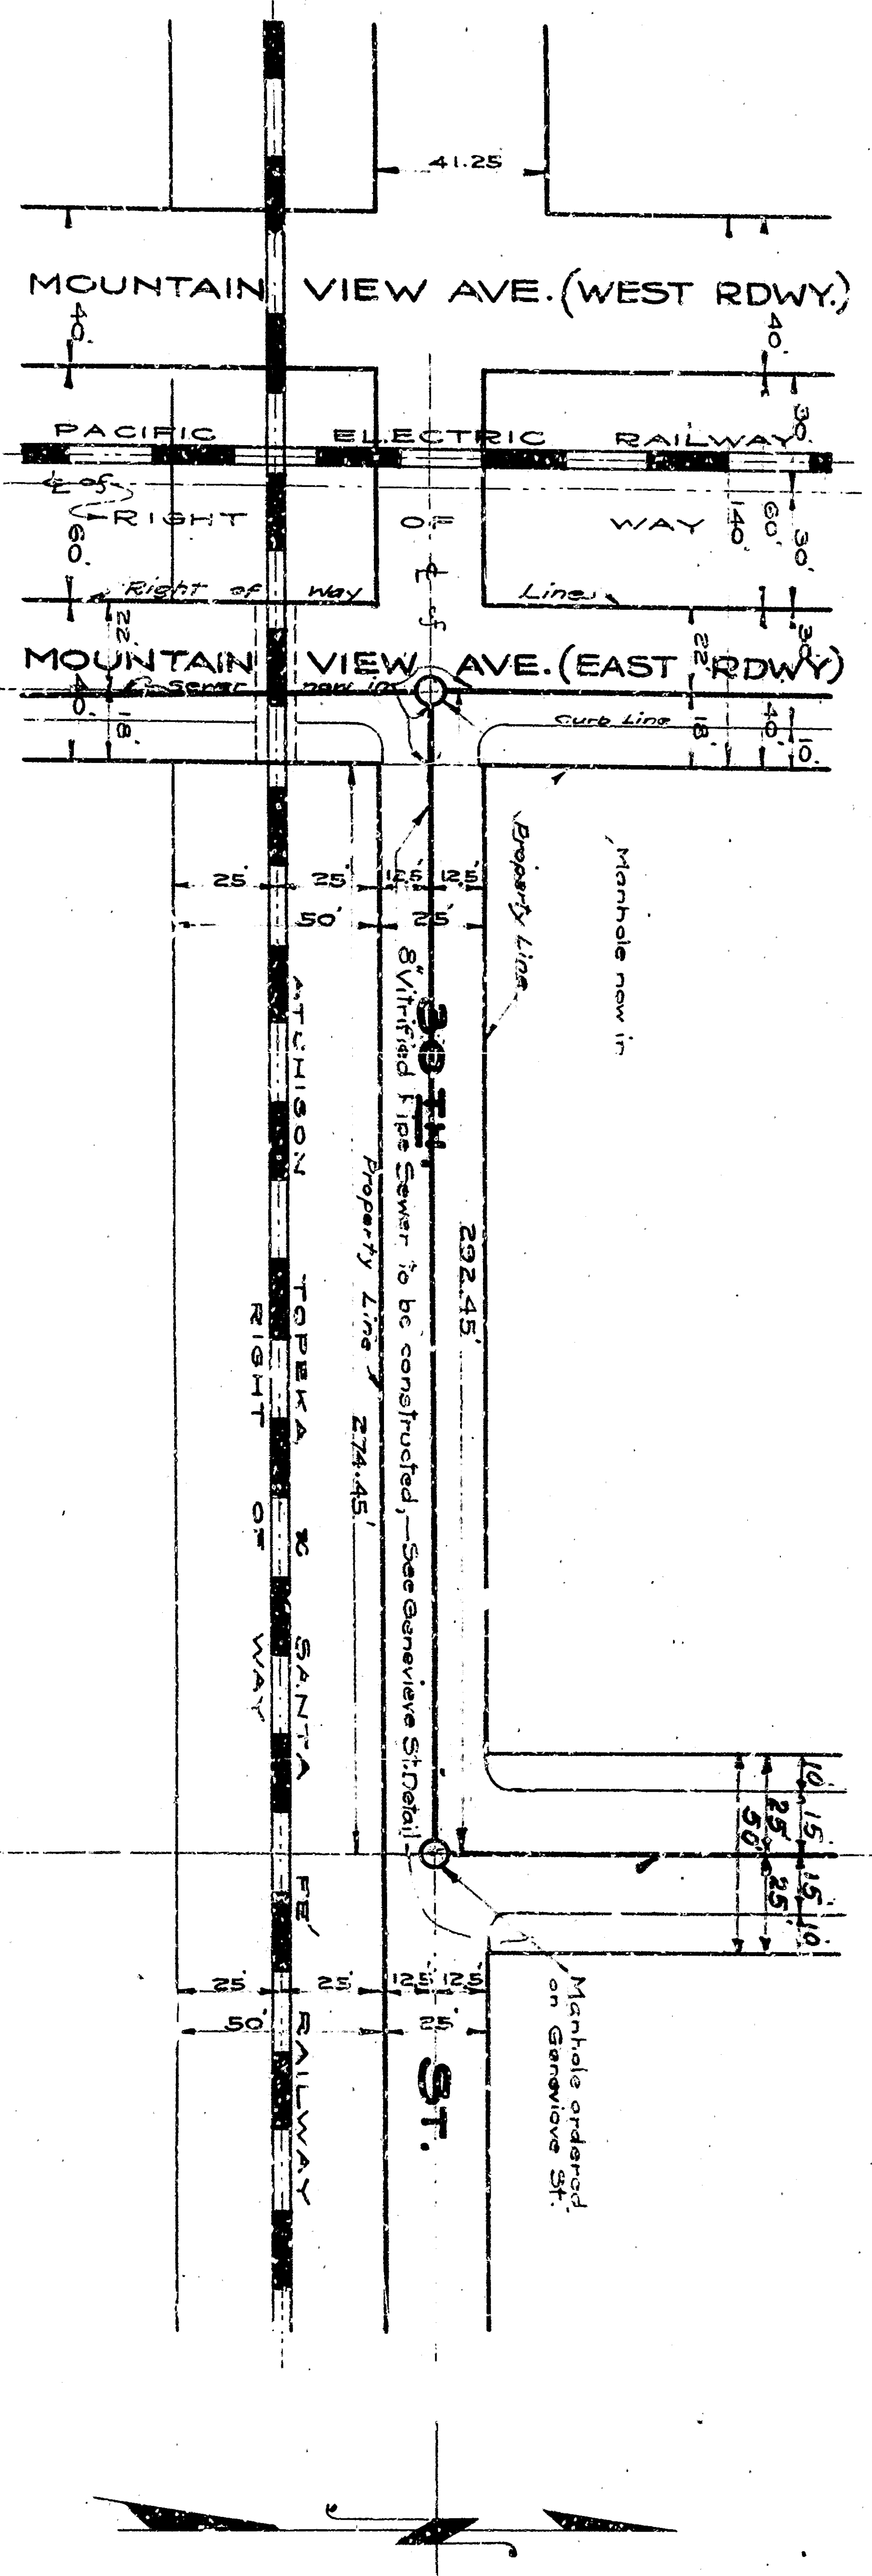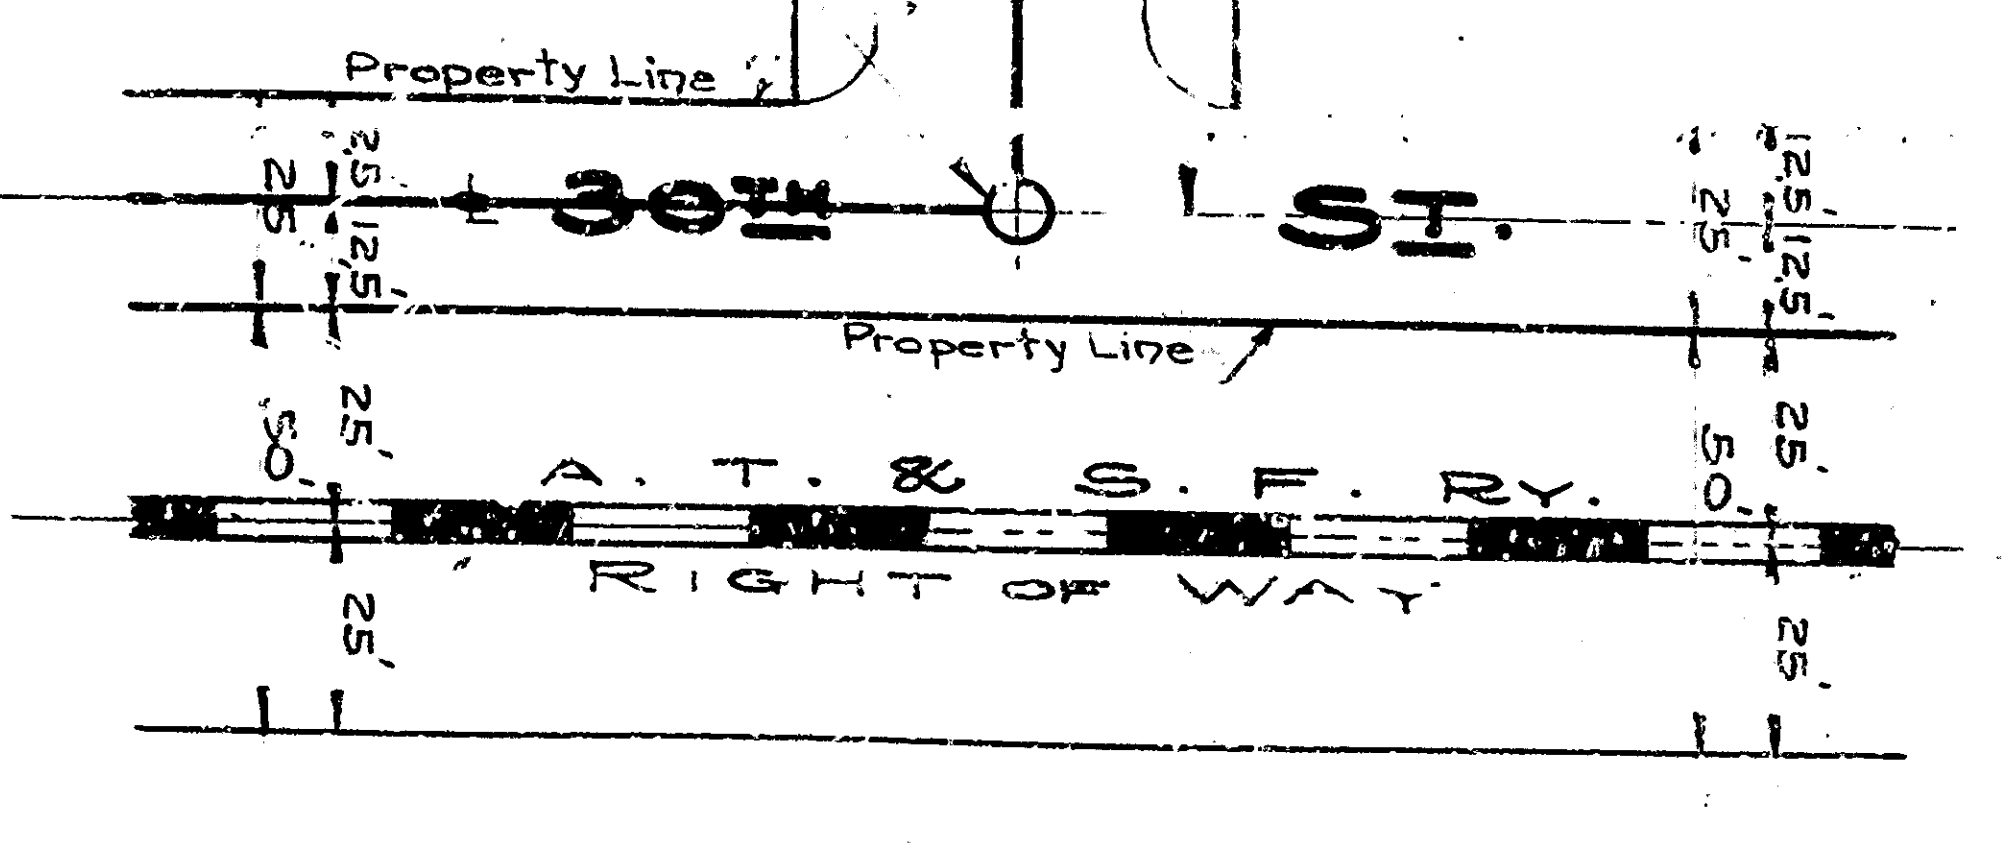

PLAN
Scale: 1" = 40'

TITLE TO STREET

Genevieve Street, adjudicated by Map of "Tract No. 2059" -
Recorded Book 22 of Maps, - Page 34.
Thirtieth Street, dedicated by Map of "Arrowhead Tract" -
Recorded Book 11 of Maps, - Page 37.
Genevieve Street - By Deed recorded in Book 1957 of Page 237, 238, 239,
Recorded in 1907 in San Bernardino County.

GRADE



Grade of Genevieve Street established by Resolution No. 178, adopted March 23, 1931.
Grade of Thirtieth Street established by Ordinance No. 1270, adopted January 4, 1920.

Plan adopted March 31, 1947

SHEET No. 1
PLAN No. 1692
FOR SEWER IN
GENEVIEVE STREET
BETWEEN THIRTIETH ST AND MARSHALL BOULEVARD
AND IN THIRTIETH ST.
BETWEEN MOUNTAIN VIEW AVE AND GENEVIEVE ST.
MARCH 1947

CITY OF SAN BERNARDINO
CALIFORNIA

EDGA
CITY

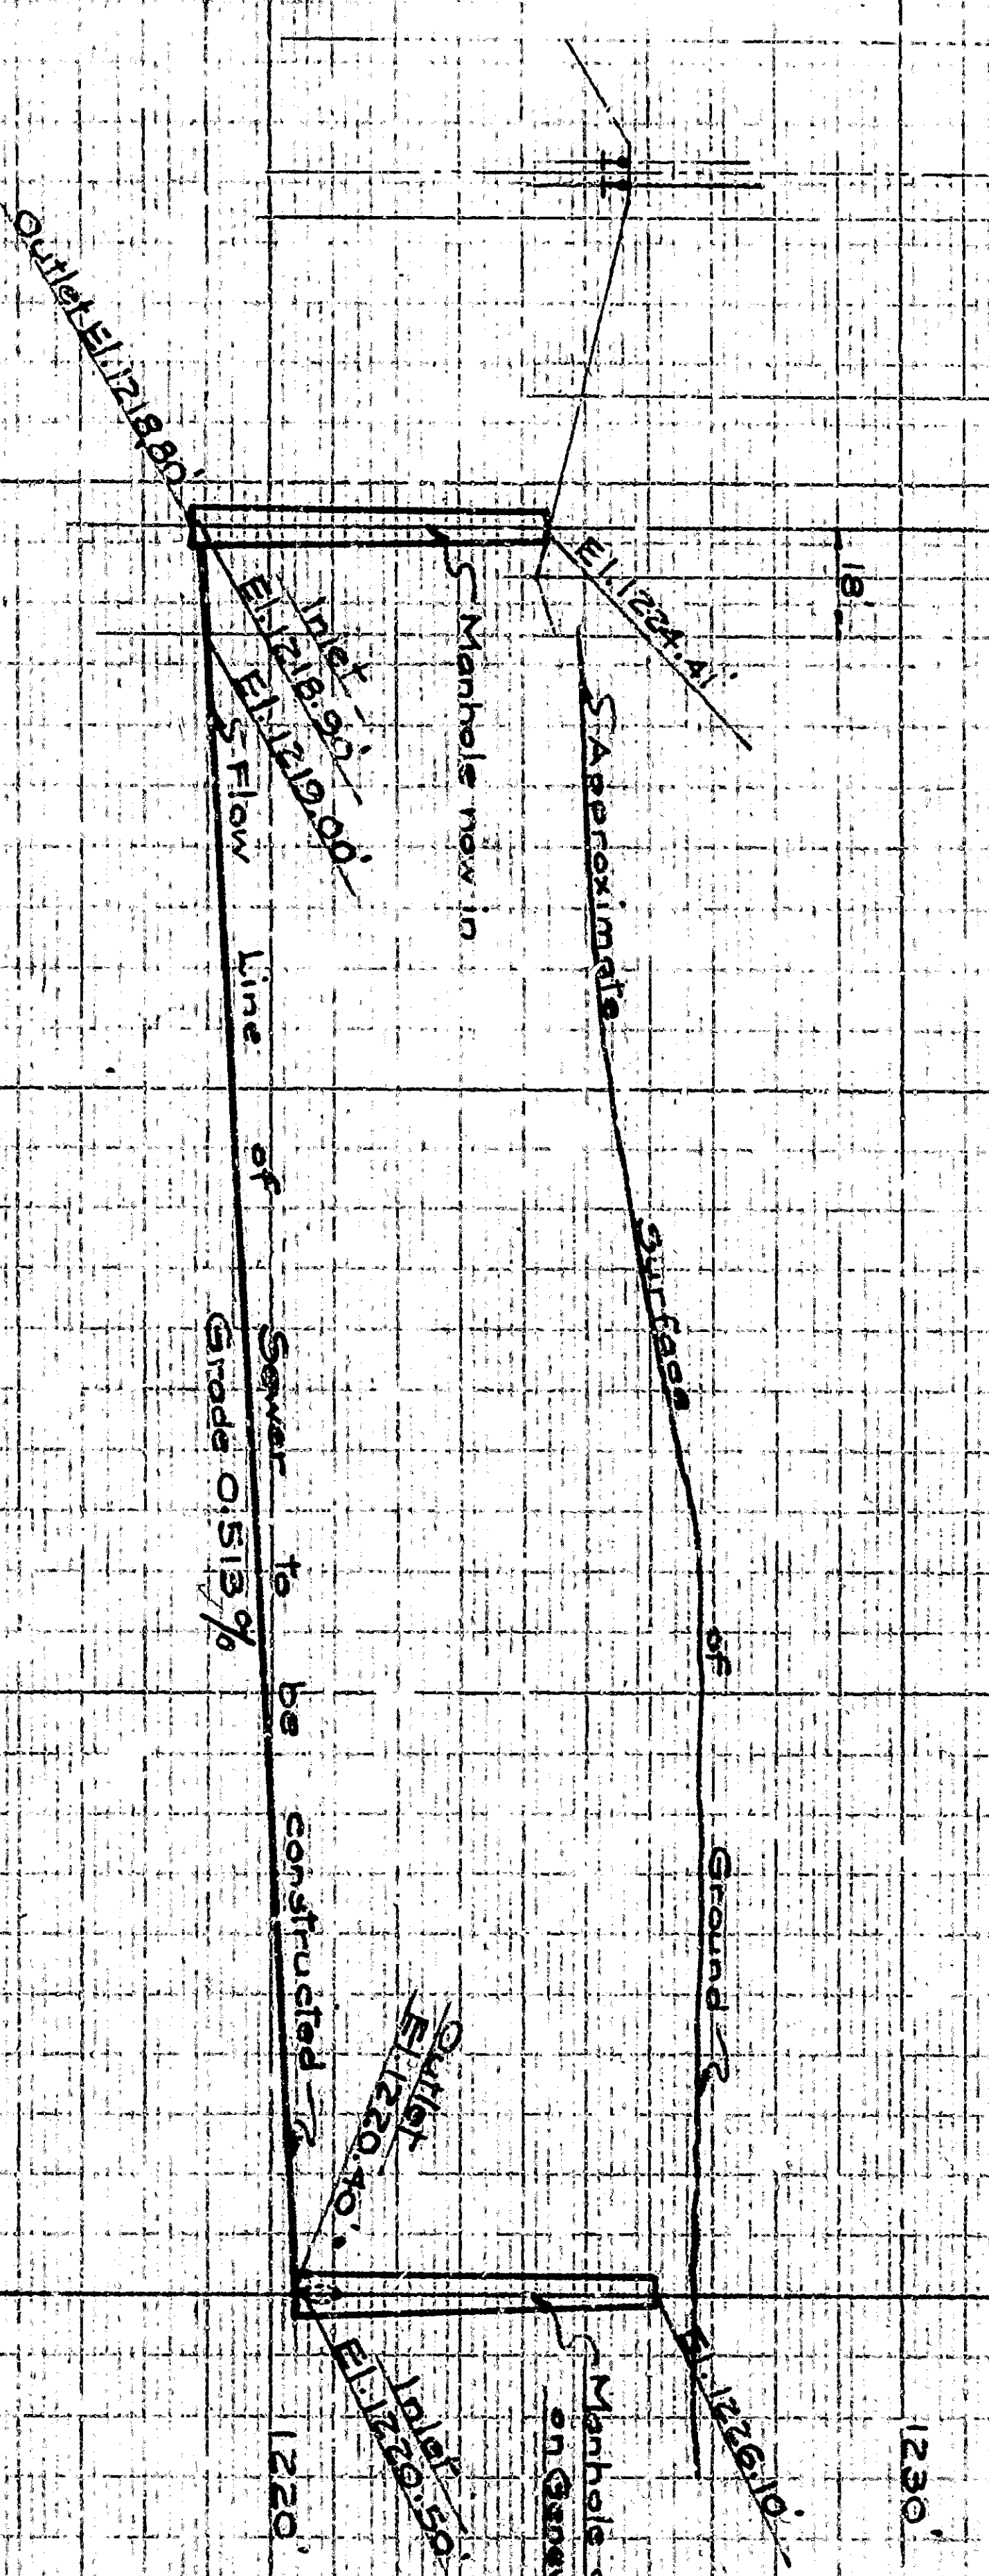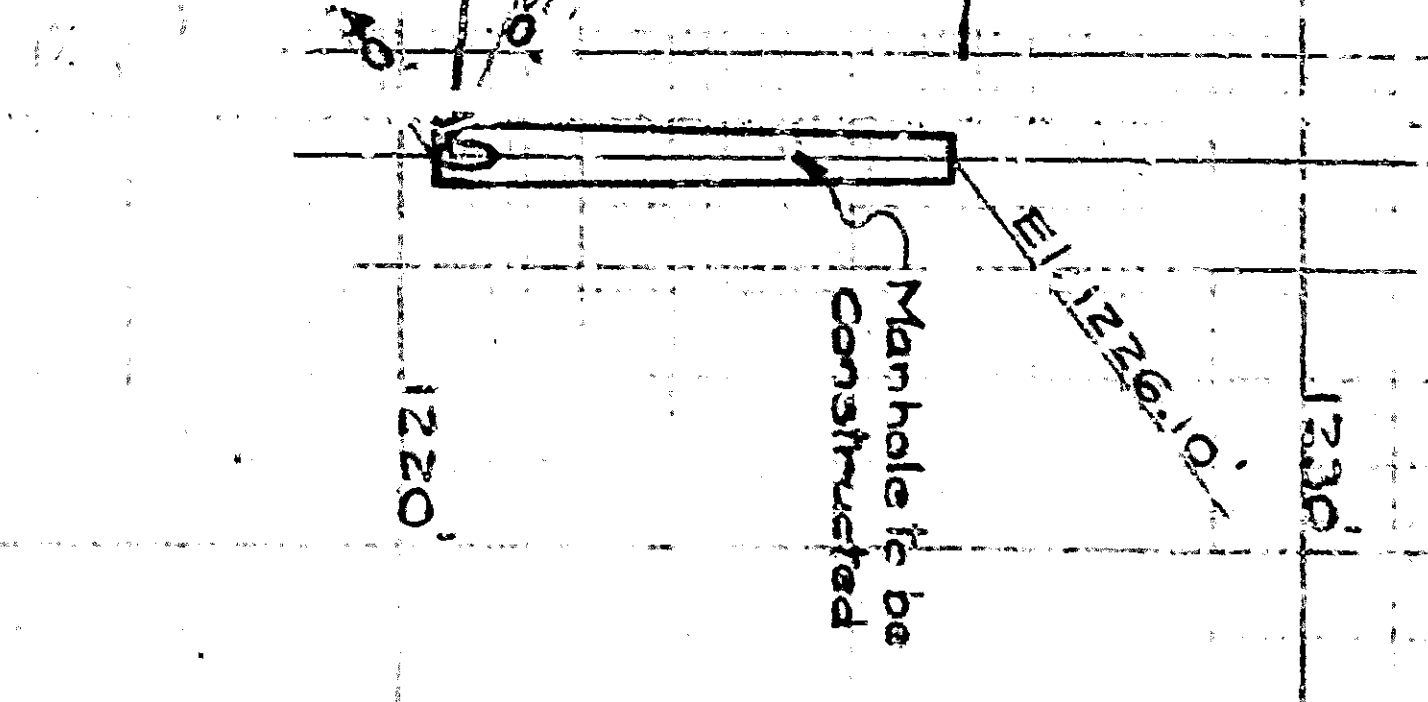

PROFILE
Horizontal - 1" = 40'
Vertical - 1" = 4'

PROFILE LEGEND

As indicated, Elevation Surface of Ground shown.
Line of Sewer to be constructed shown.

LEGEND

1/2" or in, means inch or inches	Blue means diameter
1/2" or in, means feet or feet	Red, means existing
No. means No.	Lin. means line
4" means 4 inch pipe	
St. means Street	
3" means 3 inch pipe	
Manhole, new in shown this	
Sewer, new in shown this	
Standard pipe - Manhole to be constructed shown this	
6" 1/2" 1/2" pipe - Manhole to be constructed shown this	
6" 3/4" pipe with 4" connecting sewer to be installed shown this	

**APPROXIMATE
DETAIL OF SEWER
TO BE CONSTRUCTED
AS FOLLOWS**

No. 10" Ft. of 6" 1/2" pipe Sewer	142.47'
No. 10" Ft. of 4" 1/2" pipe Connecting Sewer	61.5'
No. of 6" 3/4" pipe with 4" connecting sewer	41
No. of Standard Pipe Manholes	3

AS BUILT
PROCESSED UNDER NO. 1692

AS BUILT
PROCESSED UNDER NO. 1692

AS BUILT
PROCESSED UNDER NO. 1692

AS BUILT
PROCESSED UNDER NO. 1692