


STORM DRAIN
 FROM
 RIALTO AVE. TO GRANT AVE.
 BETWEEN
 K ST. AND CARTER AVENUE
 (Through Mr. J. B. Dill's Property.)

PLAN
 Scale - 1"=40'

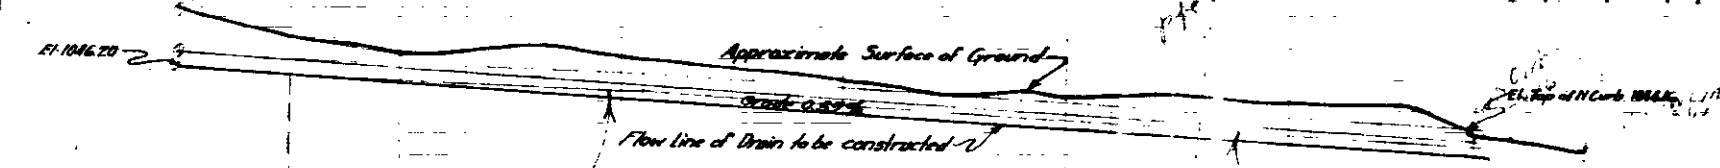

PROFILE

Black Line Shows Approximate Ground Surface
 Red Line Shows Flow Line of Drain to be constructed.
 Scale Horizontal 1"=40'
 Vertical 1"=4'

raised gutter over
 main pipe
 0.4% 0.31/100 ft
 grade below 2+0 = per old surface

0+00
 0+20
 1+00
 1+20
 1+40
5+00
 5+20
 5+40
 5+60
 5+80
 6+00
 6+20