
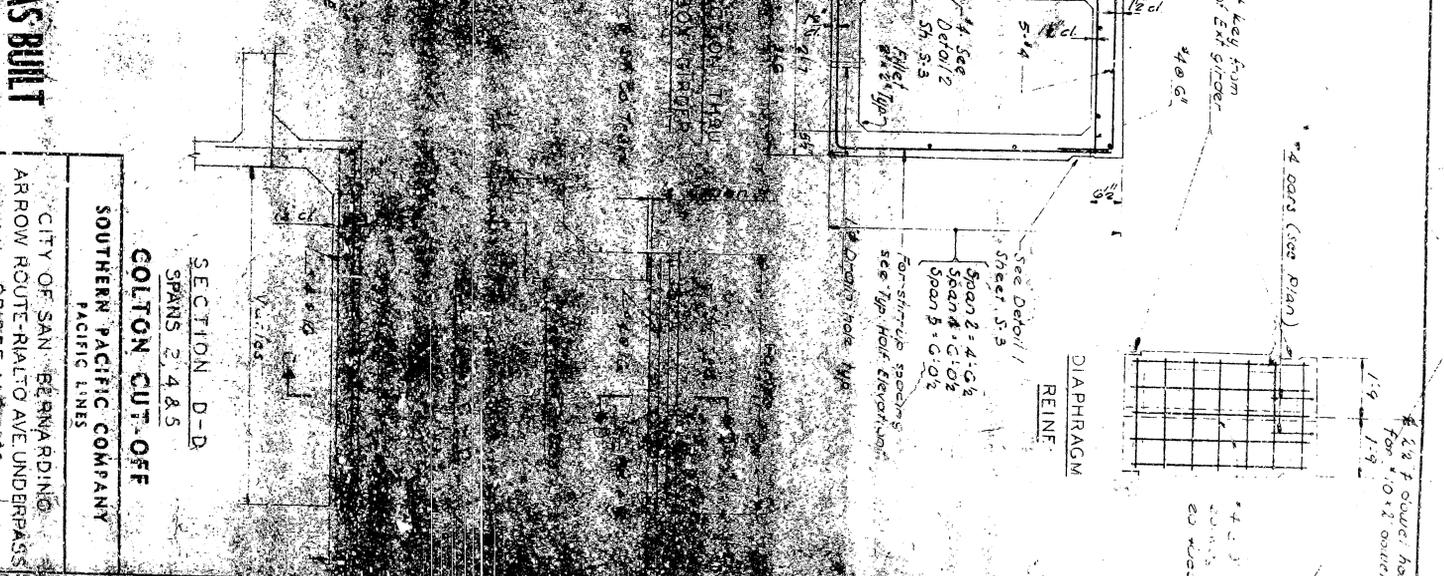
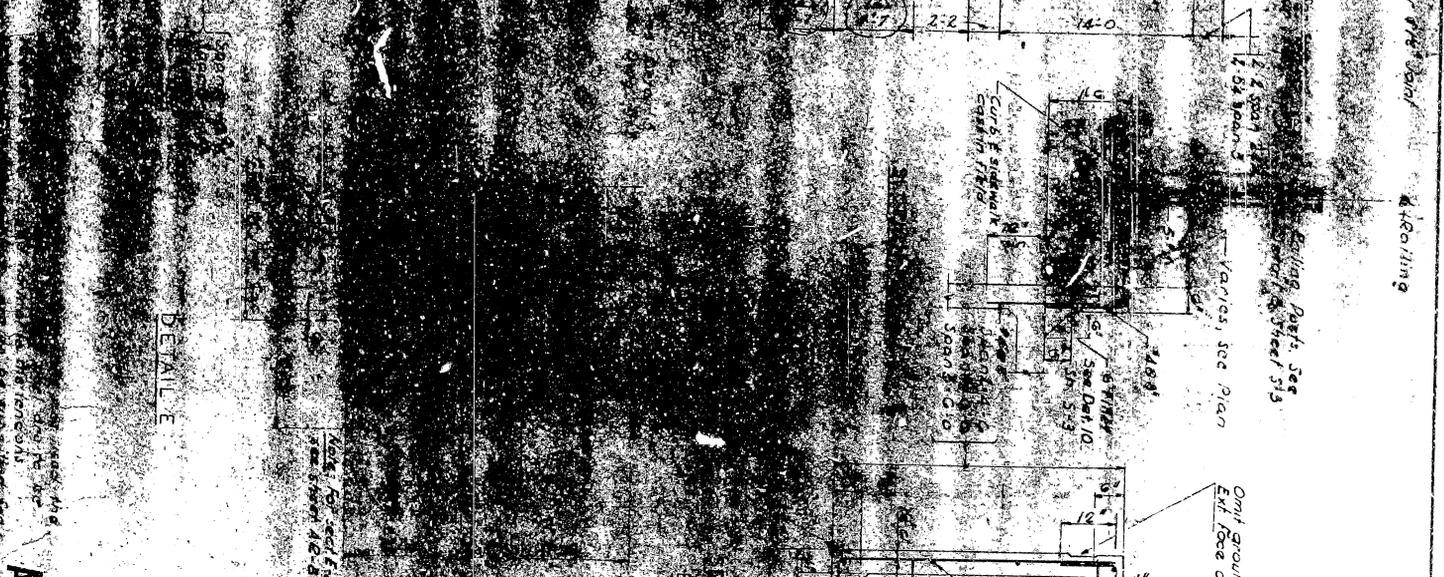


DESIGNED BY: W. W. LITTLE
 DRAWN BY: E. J. HICKS
 CHECKED BY: J. W. LITTLE

TYPICAL HALF ELEVATION

Note: Working force of 30 men for 3 spans, 2, 4 & 5 spans for 1100 kips. For spans 2, 4 & 5, 30 days for erection. For spans 2, 4 & 5, 28 days for erection. For spans 2, 4 & 5, 28 days for erection.

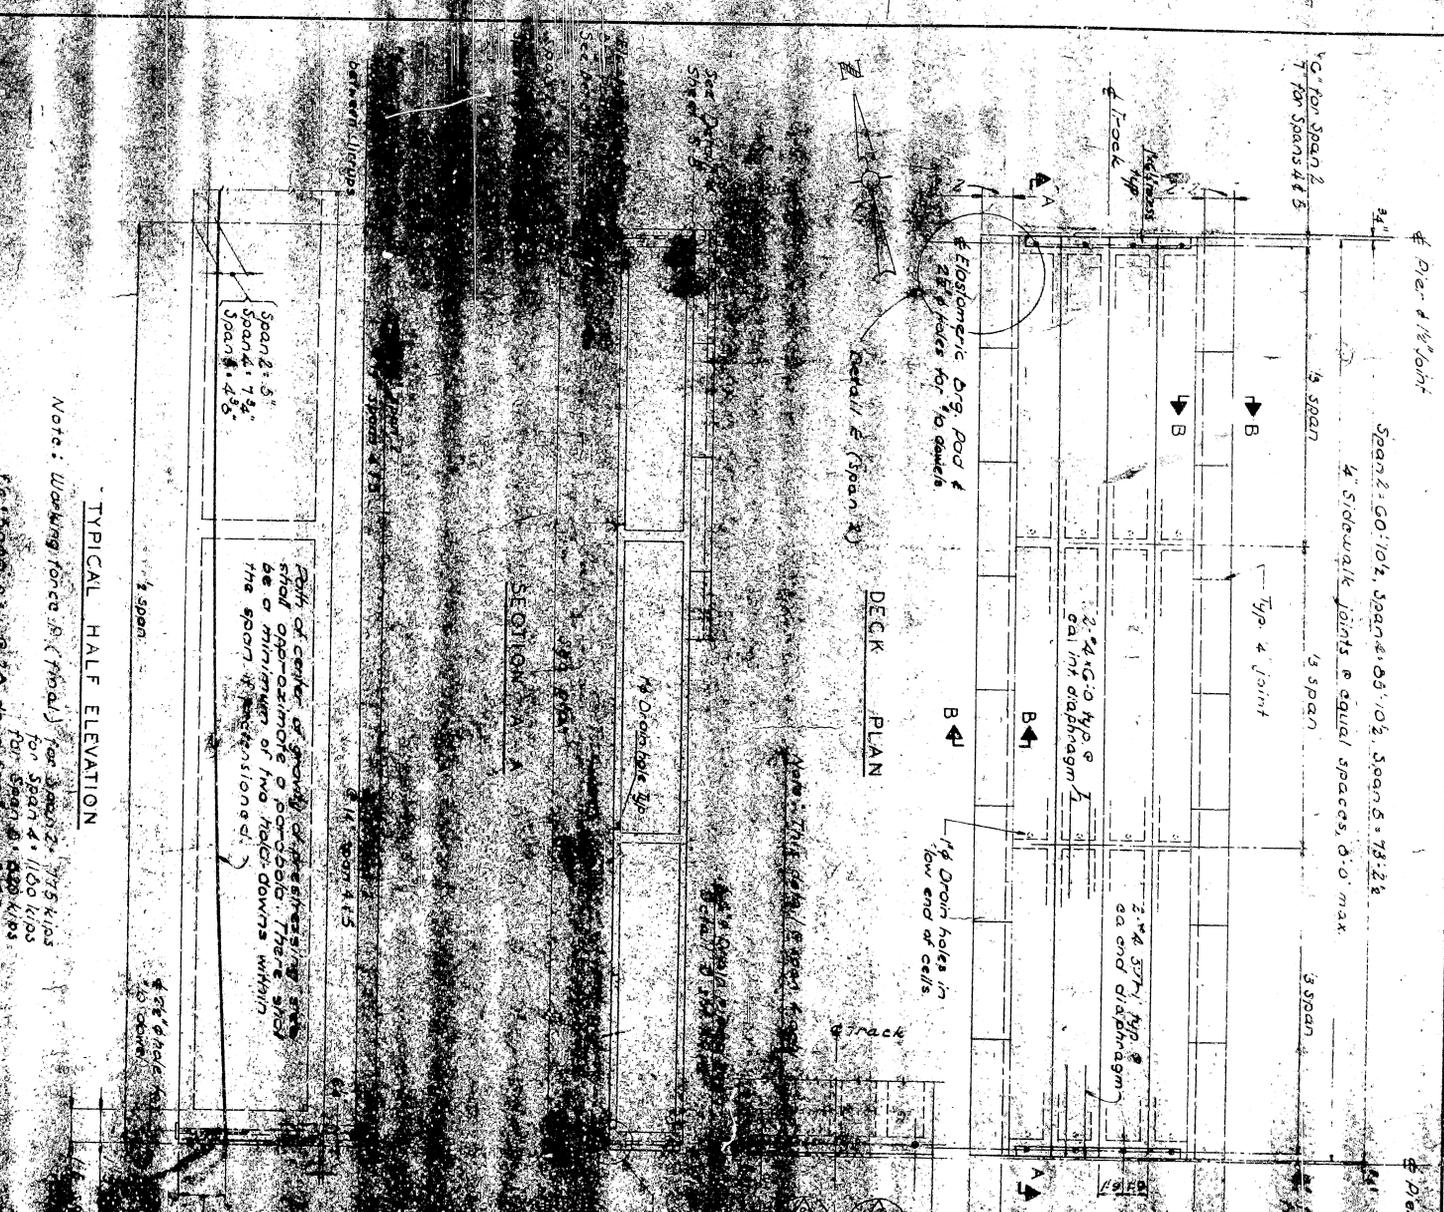

AS BUILT

GOLTON CUT-OFF
 SPANS 2, 4 & 5
 SOUTHERN PACIFIC COMPANY
 PACIFIC LINES

CITY OF SAN BERNARDINO
 ARROW ROUTE-RIALTO AVE UNDERPASS
 BRIDGE # M 113000
 PRESTRESSED CONCRETE GIRDER DETAILS

DE LEUW, CATHERS & COMPANY
 ENGINEERS
 SAN FRANCISCO, CALIFORNIA

SHEET NO. 1
 OF 9