



145  
106  
274.80  
525.80

**PLAN**  
Scale 1" = 40'

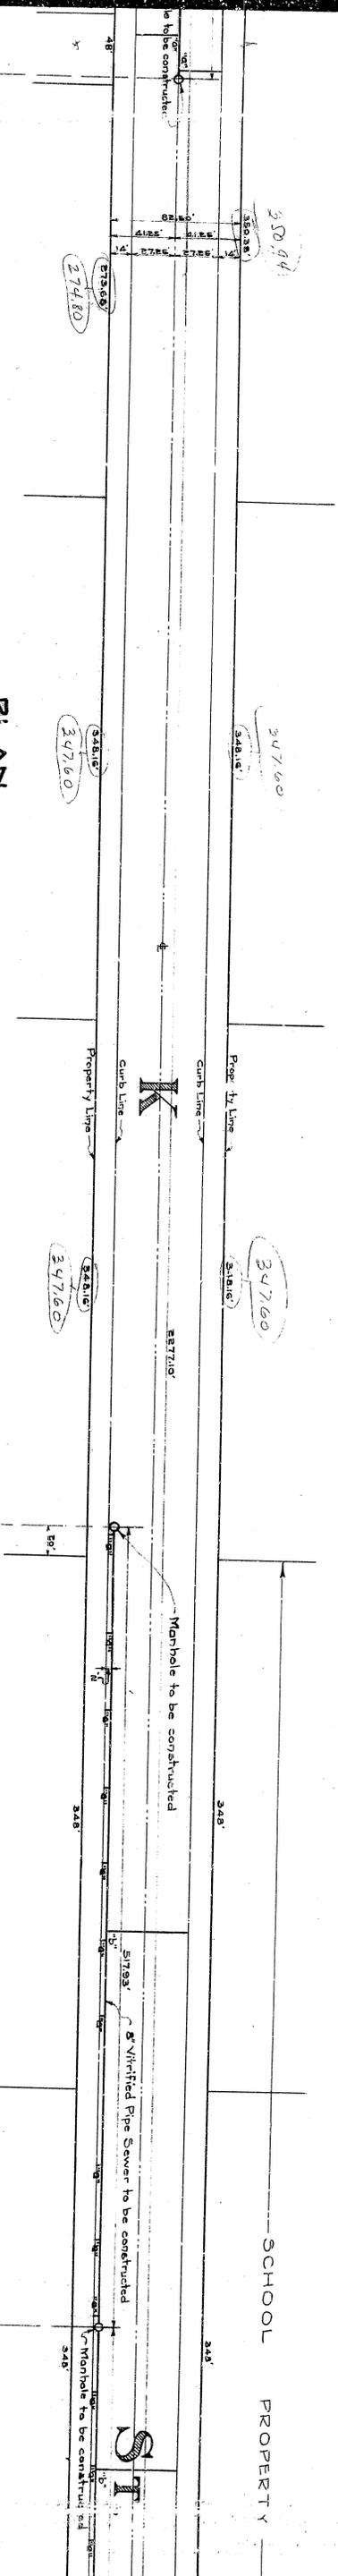

**PROFILE LEGEND**  
Black line shows present approximate surface of ground.  
Red line shows flow line of sewer to be constructed.

**PROFILE**  
Scale: Horizontal 1" = 40'  
Vertical 1" = 4'

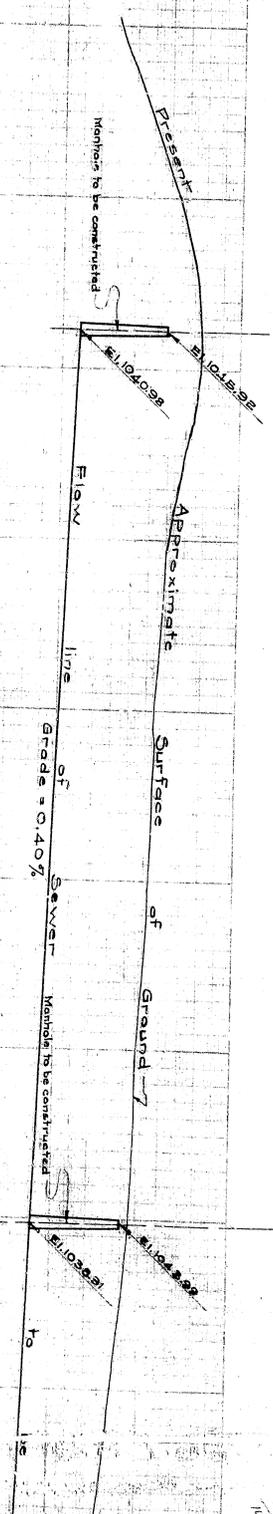

**NOTE:**  
All elevations shown in Red ink are in feet and are above a plane which is 1045.28 feet below the City Bench Mark as established by Ordinance No. 385, City of San Bernardino, California.


**NOTE:**  
All connecting sewers shall be constructed from the main sewer to the property line and shall be at right angles to the main sewer. All connecting sewers shall be laid on an upward grade of 2 percent from the main sewer.

**NOTE:**  
Grade at 'K' Street's  
603 and 1163, Grad  
by Ord. No. 385, No.  
City of San Bernar  
don

314  
184.4  
182.2  
181.7  
181.3


145  
106  
274.80  
525.80

**PLAN**  
Scale 1" = 40'

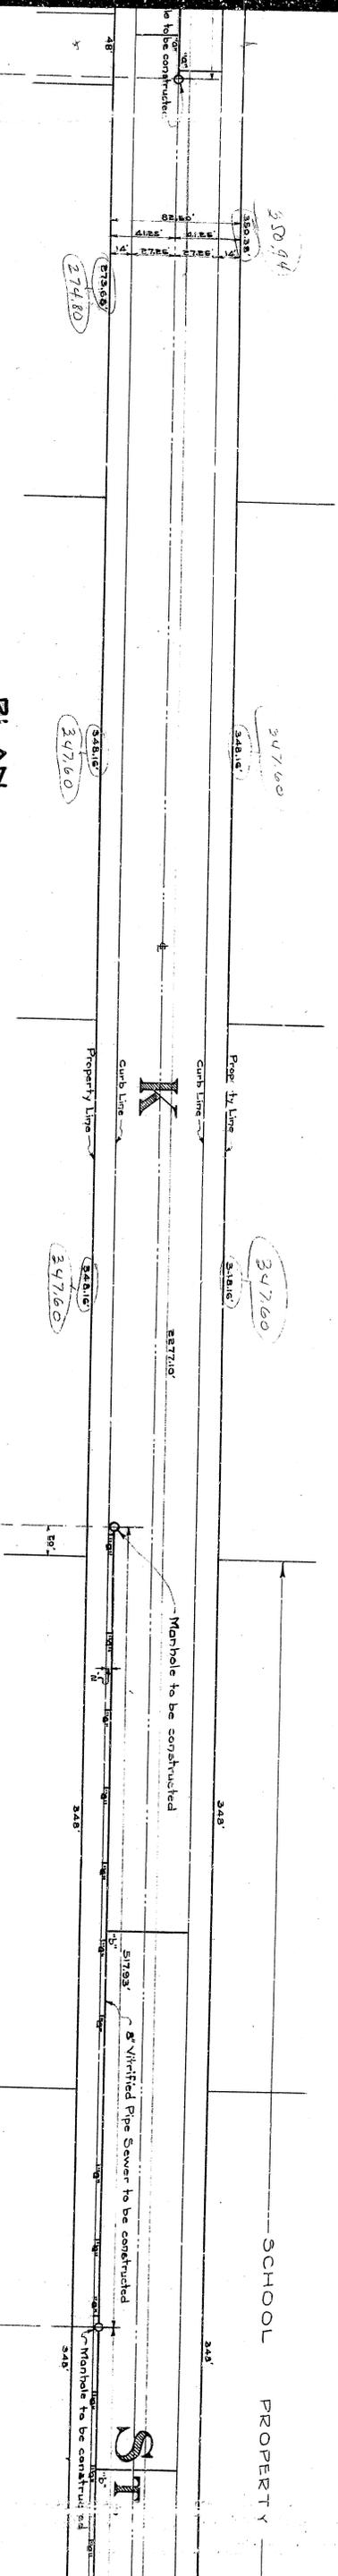

**PROFILE LEGEND**  
Black line shows present approximate surface of ground.  
Red line shows flow line of sewer to be constructed.

**PROFILE**  
Scale: Horizontal 1" = 40'  
Vertical 1" = 4'

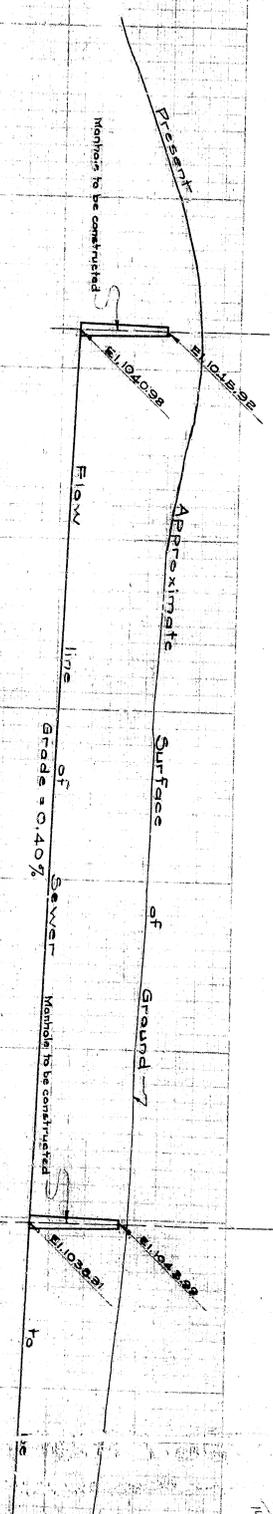

**NOTE:**  
All elevations shown in Red ink are in feet and are above a plane which is 1045.28 feet below the City Bench Mark as established by Ordinance No. 385, City of San Bernardino, California.



**NOTE:**  
All connecting sewers shall be constructed from the main sewer to the property line and shall be at right angles to the main sewer. All connecting sewers shall be laid on an upward grade of 2 percent from the main sewer.

**NOTE:**  
Grade at 'K' Street's  
603 and 1163, Grad  
by Ordinance No.  
City of San Bernar

314  
184.4  
182.2  
181.7  
181.3


145  
106  
274.80  
525.80

**PLAN**  
Scale 1" = 40'

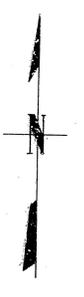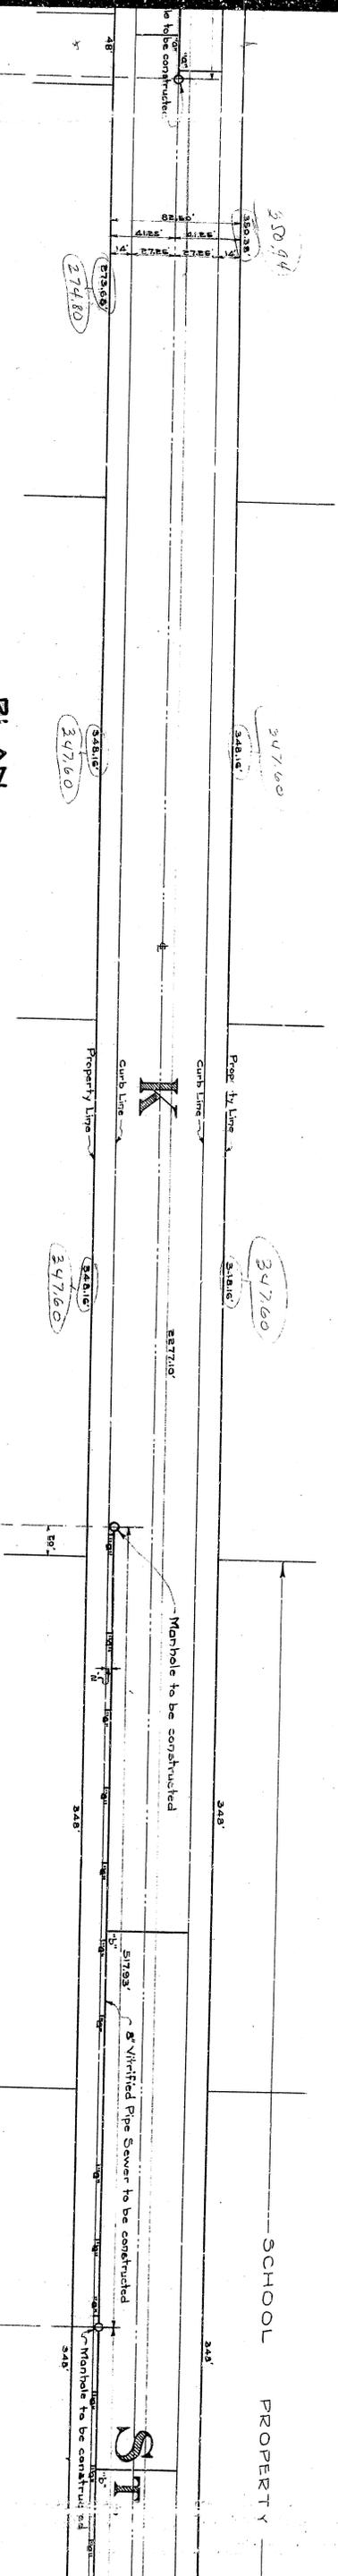

**PROFILE LEGEND**  
Black line shows present approximate surface of ground.  
Red line shows flow line of sewer to be constructed.

**PROFILE**  
Scale: Horizontal 1" = 40'  
Vertical 1" = 4'

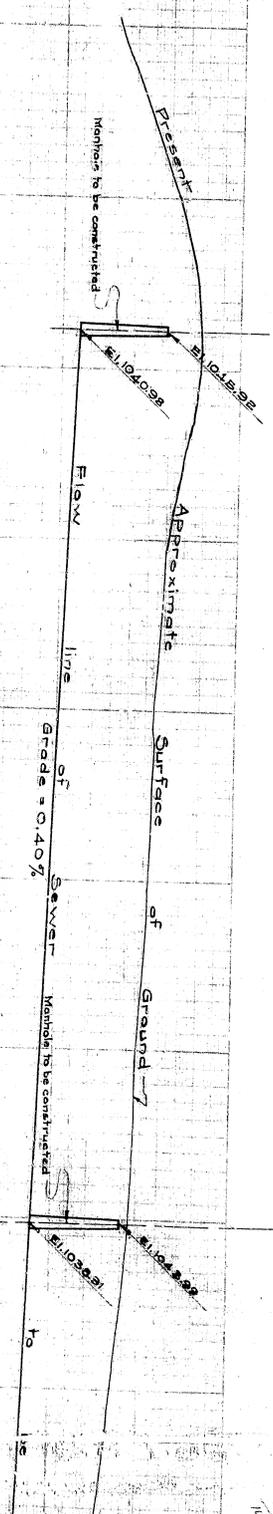

**NOTE:**  
All elevations shown in Red ink are in feet and are above a plane which is 1045.28 feet below the City Bench Mark as established by Ordinance No. 385, City of San Bernardino, California.

**NOTE:**  
All connecting sewers shall be constructed from the main sewer to the property line and shall be at right angles to the main sewer. All connecting sewers shall be laid on an upward grade of 2 percent from the main sewer.

**NOTE:**  
Grade at 'K' Street's  
603 and 1163, Grad  
by Ordinance No.  
City of San Bernar

314  
184.4  
182.2  
181.7  
181.3