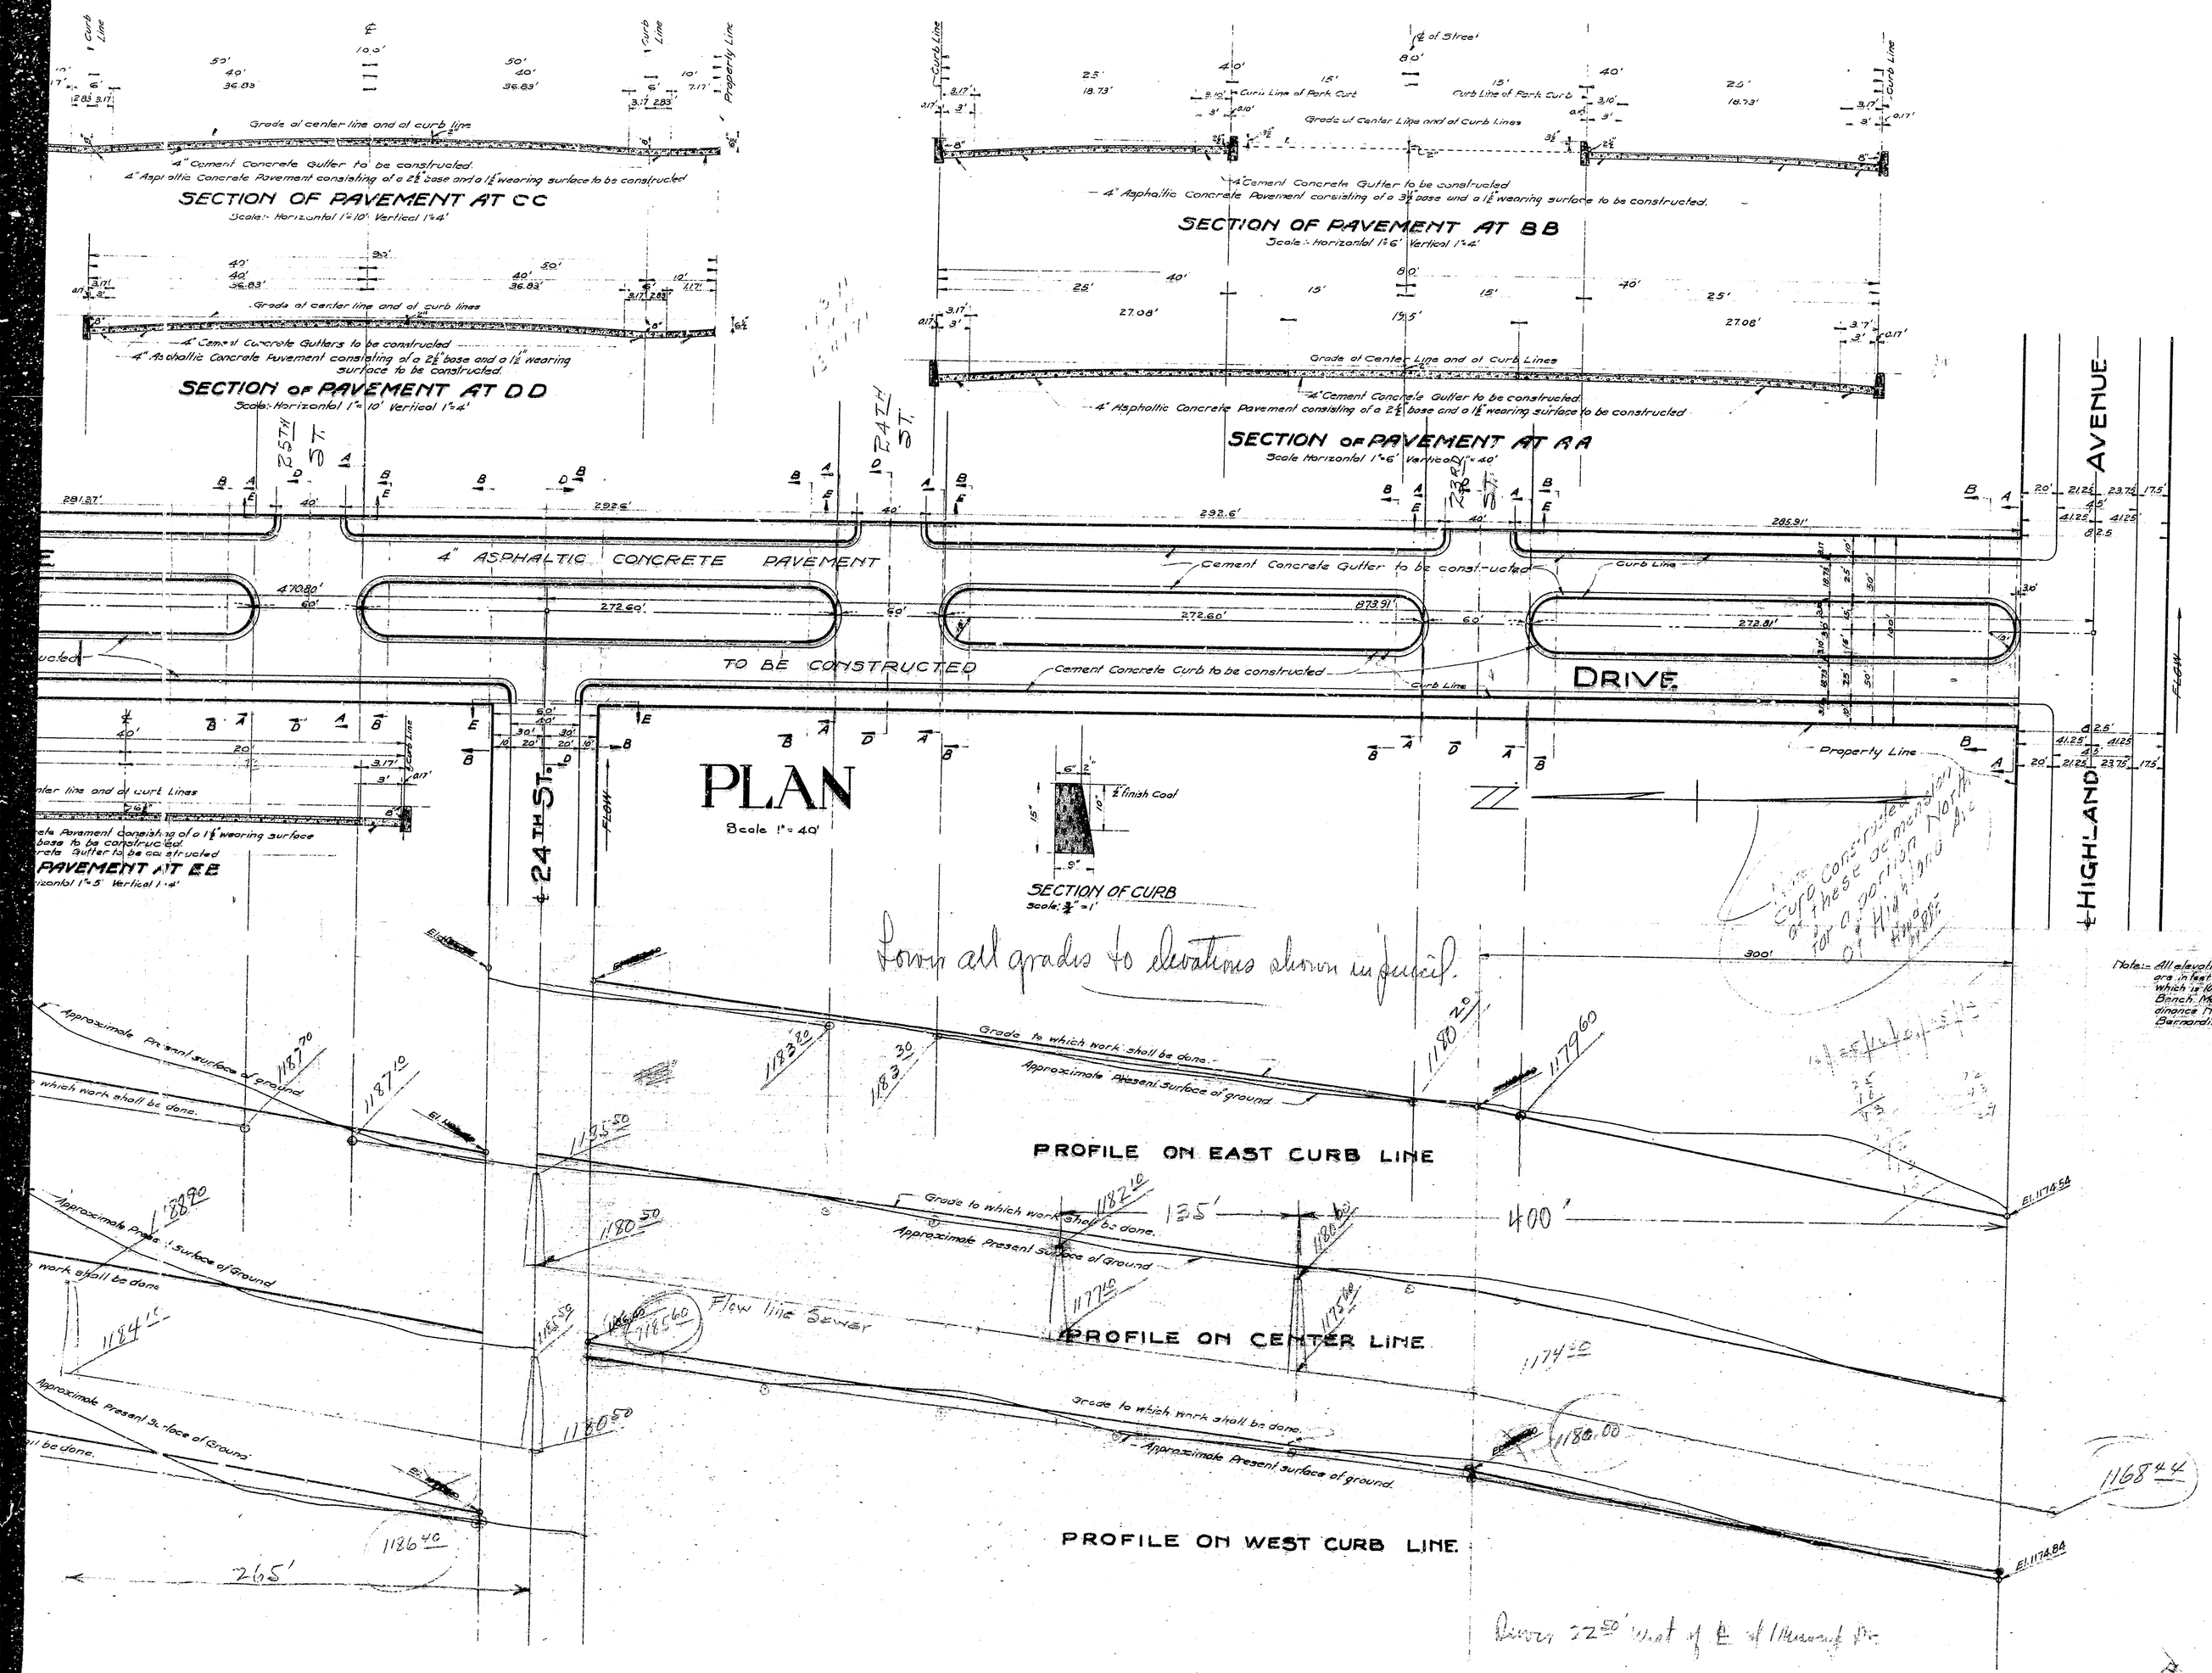

SHEET No 1

PLAN No 1007

FOR THE IMPROVEMENT OF

MUSCUPIABE DRIVE

BETWEEN

HIGHLAND AVENUE AND TWENTY SEVENTH STREET

IN THE

CITY OF SAN BERNARDINO, CALIFORNIA

MAY 1929

GORDON H FERNALD
CITY ENGINEER.

PLAN ADOPTED _____

TITLE TO STREET

Title of the City of San Bernardino to Muscupiabe Drive was given by deed recorded in Book 888 of Deeds at Page 228 Records San Bernardino County California.

GRADE ESTABLISHED

Grade of Muscupiabe Drive was established by Resolution No dated

Note:- All elevations shown in Red figures are in feet and are above a plane which is 1045.28 feet below the City Bench Mark as established by ordinance No 383 of the City of San Bernardino, California.

LEGEND

"or in means inch or inches.
' or ft. means foot or feet.
℄ means center line
St means Street.
No means number.
El means elevation
Cement Concrete Curb to be constructed shown thus in plan ___ thus in section
Cement Concrete Gutter to be constructed shown thus in plan ___ thus in section
Asphaltic Concrete Pavement consisting of a 3½" base and a 1½" wearing surface to be constructed shown thus in plan ___ thus in section

Note A ¾" Expansion Joint shall be constructed at intervals of approximately 75 thru all cement concrete curb and gutter ordered constructed on this plan.

PROFILE LEGEND

Approximate Present Surface of ground shown by Black Lines thus ___
Grade to which work shall be done shown by red lines thus ___
Scale:- Horizontal 1"=40' Vertical 1"=4'

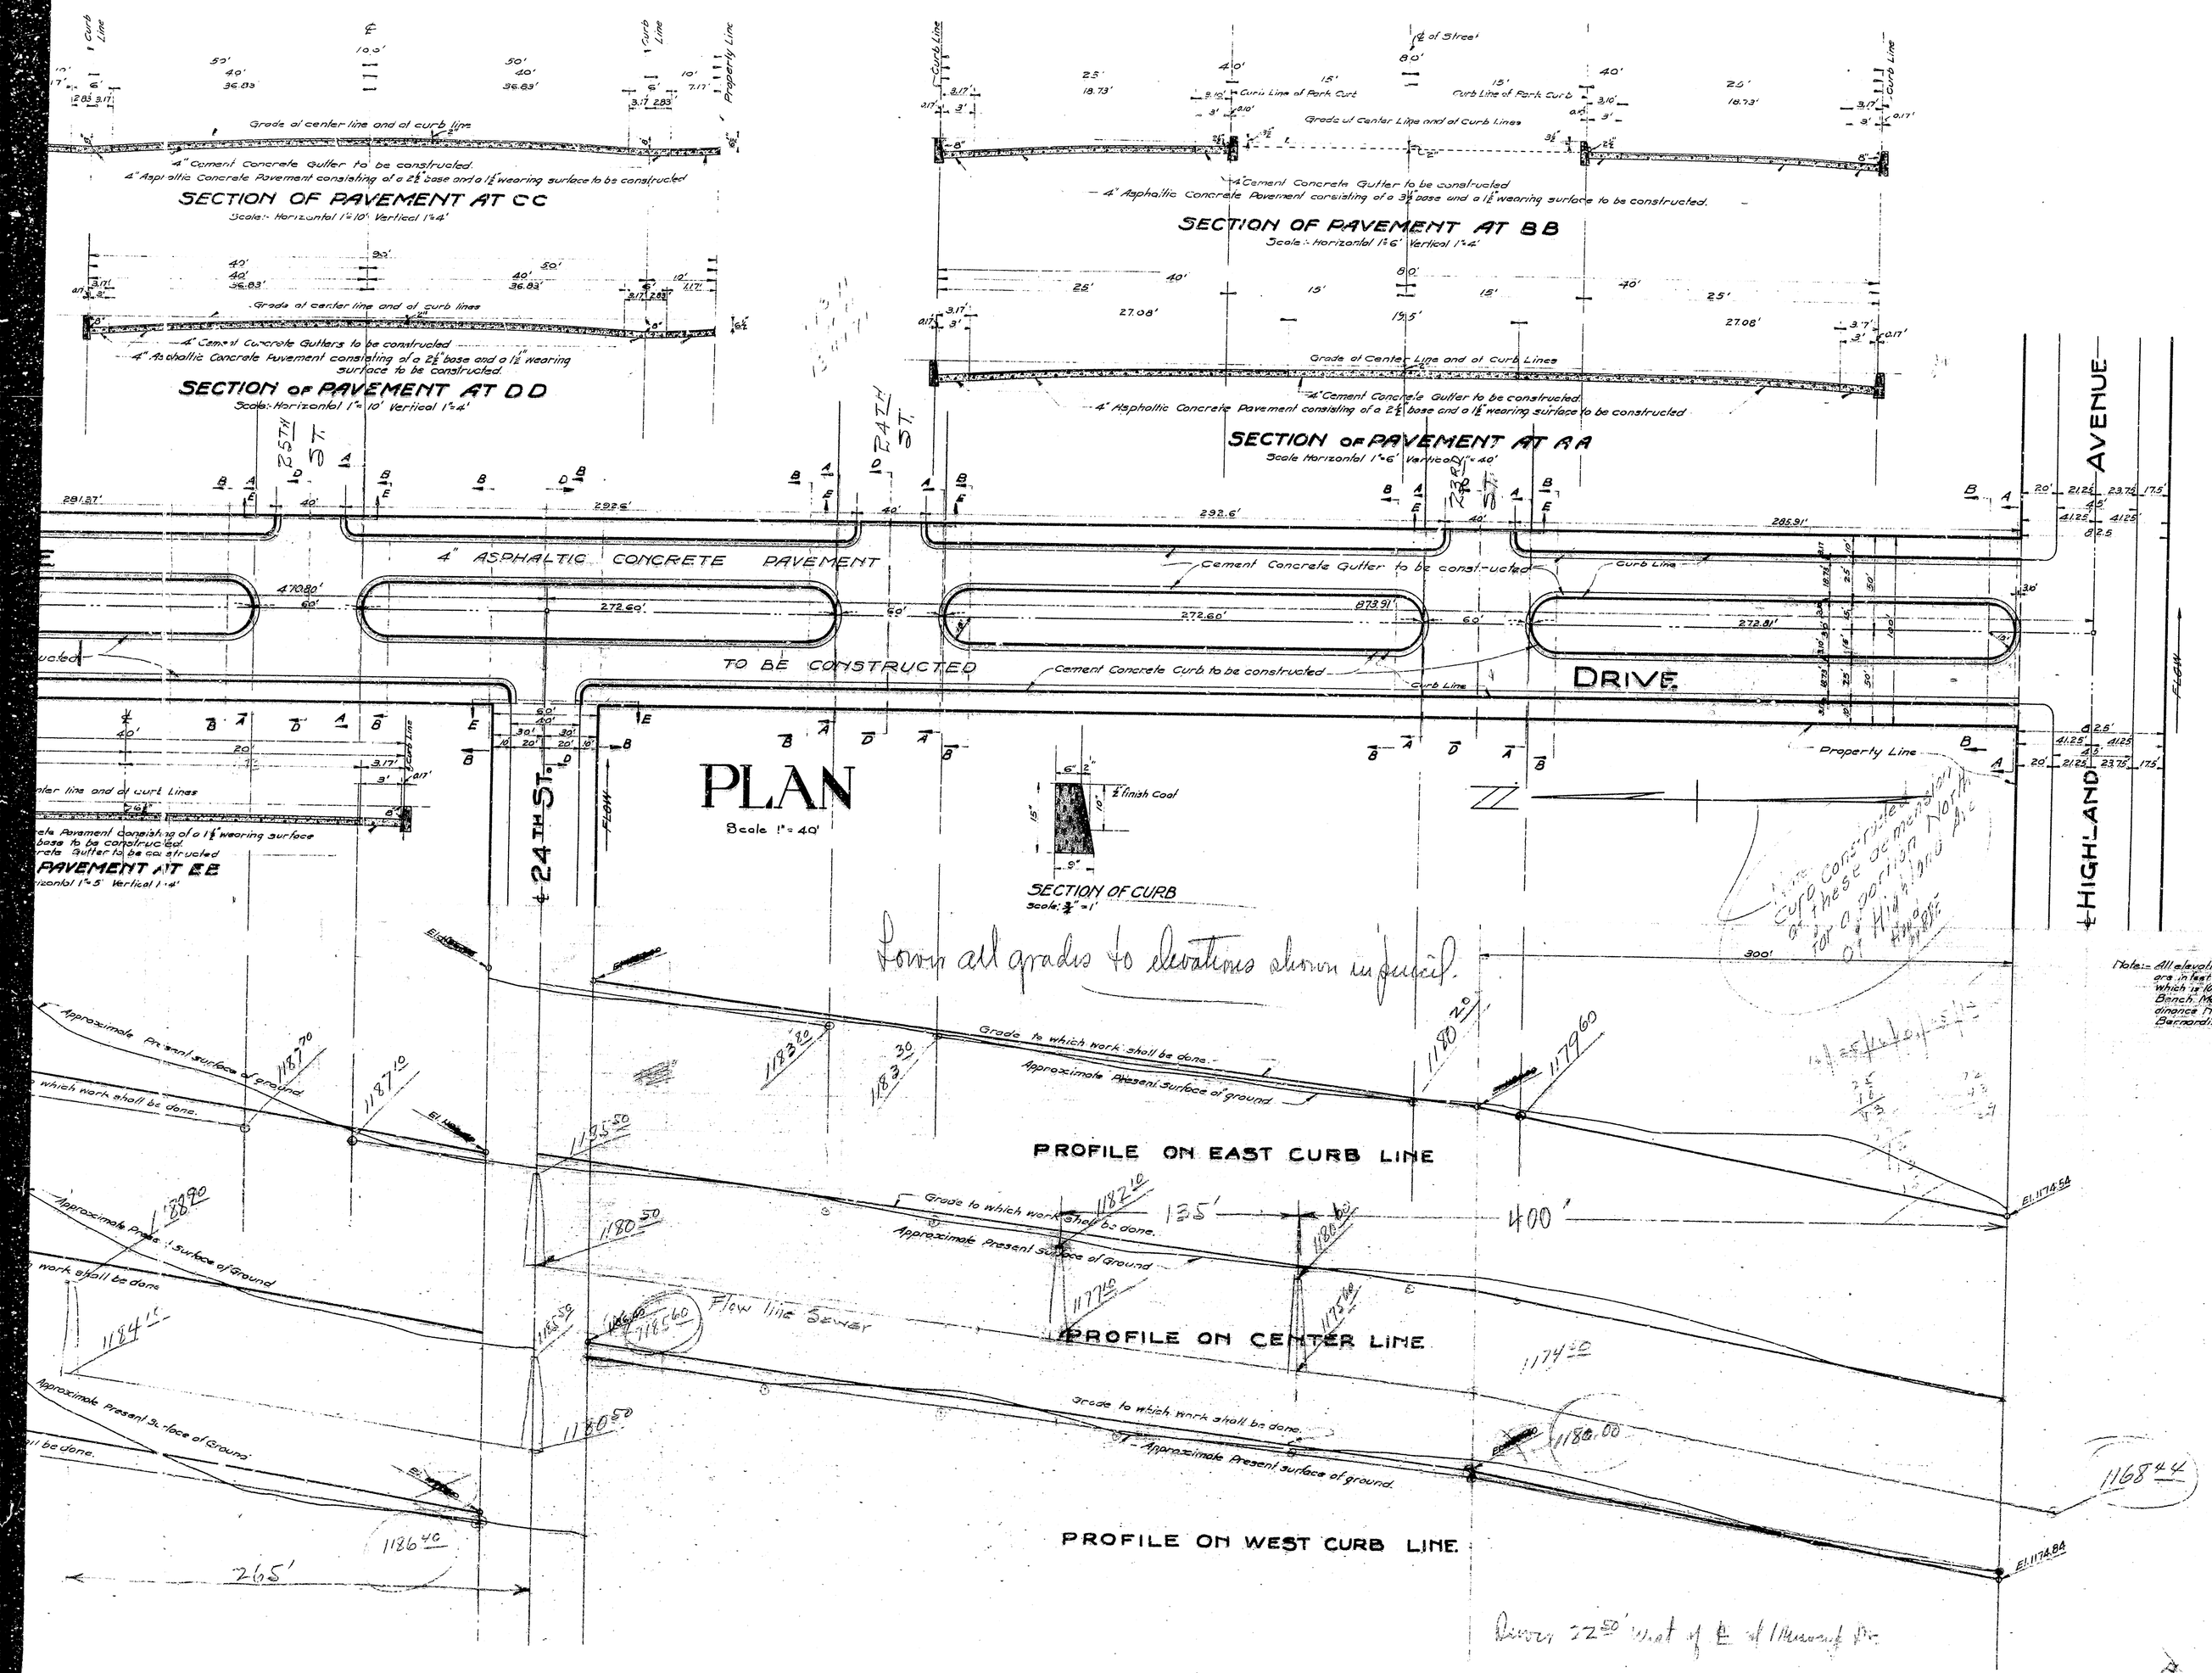

SHEET No 1

PLAN No 1007

FOR THE IMPROVEMENT OF

MUSCUPIABE DRIVE

BETWEEN

HIGHLAND AVENUE AND TWENTY SEVENTH STREET

IN THE

CITY OF SAN BERNARDINO, CALIFORNIA

MAY 1929

GORDON H. FERNALD
CITY ENGINEER.

PLAN ADOPTED _____

TITLE TO STREET

Title of the City of San Bernardino to Muscupiabe Drive was given by deed recorded in Book 888 of Deeds at Page 228 Records San Bernardino County California.

GRADE ESTABLISHED

Grade of Muscupiabe Drive was established by Resolution No dated

Note:- All elevations shown in Red figures are in feet and are above a plane which is 1045.28 feet below the City Bench Mark as established by ordinance No 383 of the City of San Bernardino, California.

LEGEND

" or in means inch or inches.
' or ft. means foot or feet.
℄ means center line
St. means Street.
No means number.
El. means elevation
Cement Concrete Curb to be constructed shown thus in plan ___ thus in section
Cement Concrete Gutter to be constructed shown thus in plan ___ thus in section
Asphaltic Concrete Pavement consisting of a 2½" base and a 1½" wearing surface to be constructed shown thus in plan ___ thus in section

Note A ¾" Expansion Joint shall be constructed at intervals of approximately 75 thru all cement concrete curb and gutter ordered constructed on this plan.

PROFILE LEGEND

Approximate Present Surface of ground shown by Black Lines thus ___
Grade to which work shall be done shown by red lines thus ___
Scale:- Horizontal 1"=40' Vertical 1"=4'