


14+00
13+00
12+00
11+00
10+00
9+00
8+00
7+00
6+00
5+00
4+00
3+00
2+00
1+00
0+00

 

DETAILS OF QUANTITIES
 3028 LINES EXCEPT 12 INCH VENTILATED PIPE INCLUDING WYES
 2 1/2 MANHOLES (2 WAY)
 2 FLUSH TANK FOR 12" SEWER


**KINGMAN STREET
SEWER**

PLAN AND PROFILE
 No. 156


FROM 1 STREET TO MOUNT VERNON AVENUE.
 SCALE: VERTICAL 1" = 4 FEET.
 HORIZONTAL 1" = 40 FEET.
 Aug, 1911 K. E. TUTTLE, C.E.
 Lewis B. 36 P. 23-24

ABBREVIATIONS:
 THE MARK () MEANS FEET OR FOOT
 THE MARK (') MEANS INCH OR INCHES.
 ELEV. MEANS ELEVATION.
 RED LINES ON PLAN SHOW CENTER
 LINES OF SEWER.
 SHORT RED LINES ON PLAN MARKED '0'
 SHOW LOCATION OF WYES.
 RED LINE ON PROFILE SHOWS GRADE
 OF BOTTOM OF SEWER.
 BLACK LINES ON PLAN SHOW PROPERTY LINES


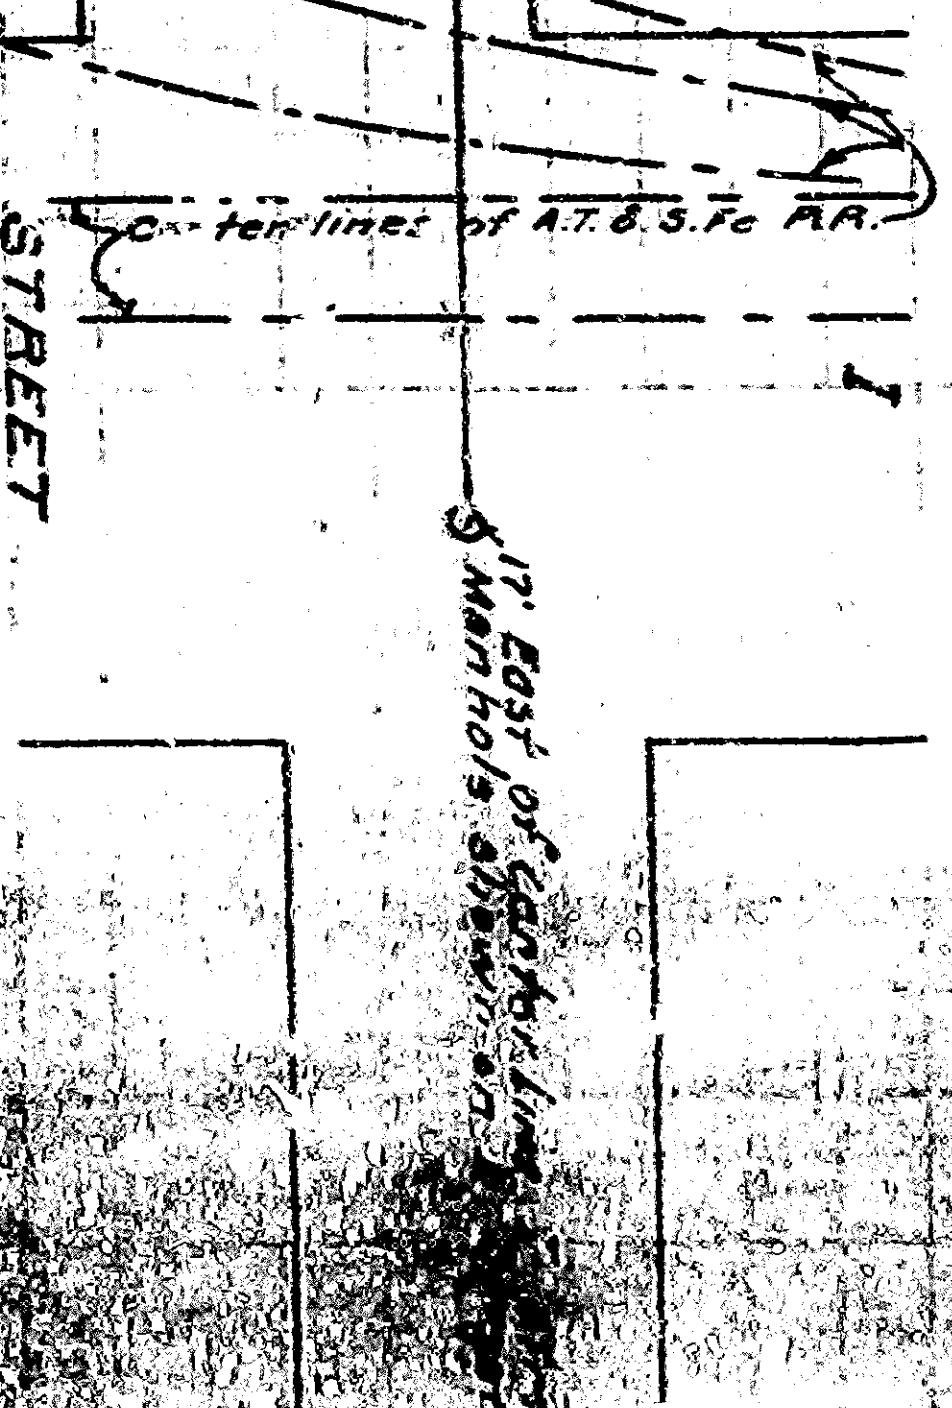

14+00
13+00
12+00
11+00
11+05.45
11+00
10+00
9+00
8+00
7+00
6+00
5+00
4+00
3+00
2+00
1+00
0+00

 

DETAILS OF QUANTITIES
 308 LINES EXCEPT 12 INCH VENTRILED PIPE INCLUDING WYES
 2 1/2 MANHOLES (2 WAY)
 2 FLUSH TANK FOR 12" SEWER

**KINGMAN STREET
SEWER**

PLAN AND PROFILE
 No. 156

FROM 1 STREET TO MOUNT VERNON AVENUE
 SCALE (VERTICAL) 1" = 4 FEET
 (HORIZONTAL) 1" = 40 FEET
 Aug, 1911 K. E. TUTTLE, C.E.
 Lewis B. 36 P. 23-24

ABBREVIATIONS
 THE MARK () MEANS FEET OR FOOT
 THE MARK (') MEANS INCH OR INCHES
 ELEV. MEANS ELEVATION
 RED LINES ON PLAN SHOW CENTER
 LINES OF SEWER
 SHORT RED LINES ON PLAN MARKED '0'
 SHOW LOCATION OF WYES
 RED LINE ON PROFILE SHOWS GRADE
 OF BOTTOM OF SEWER
 BLACK LINES ON PLAN SHOW PROPERTY LINES



