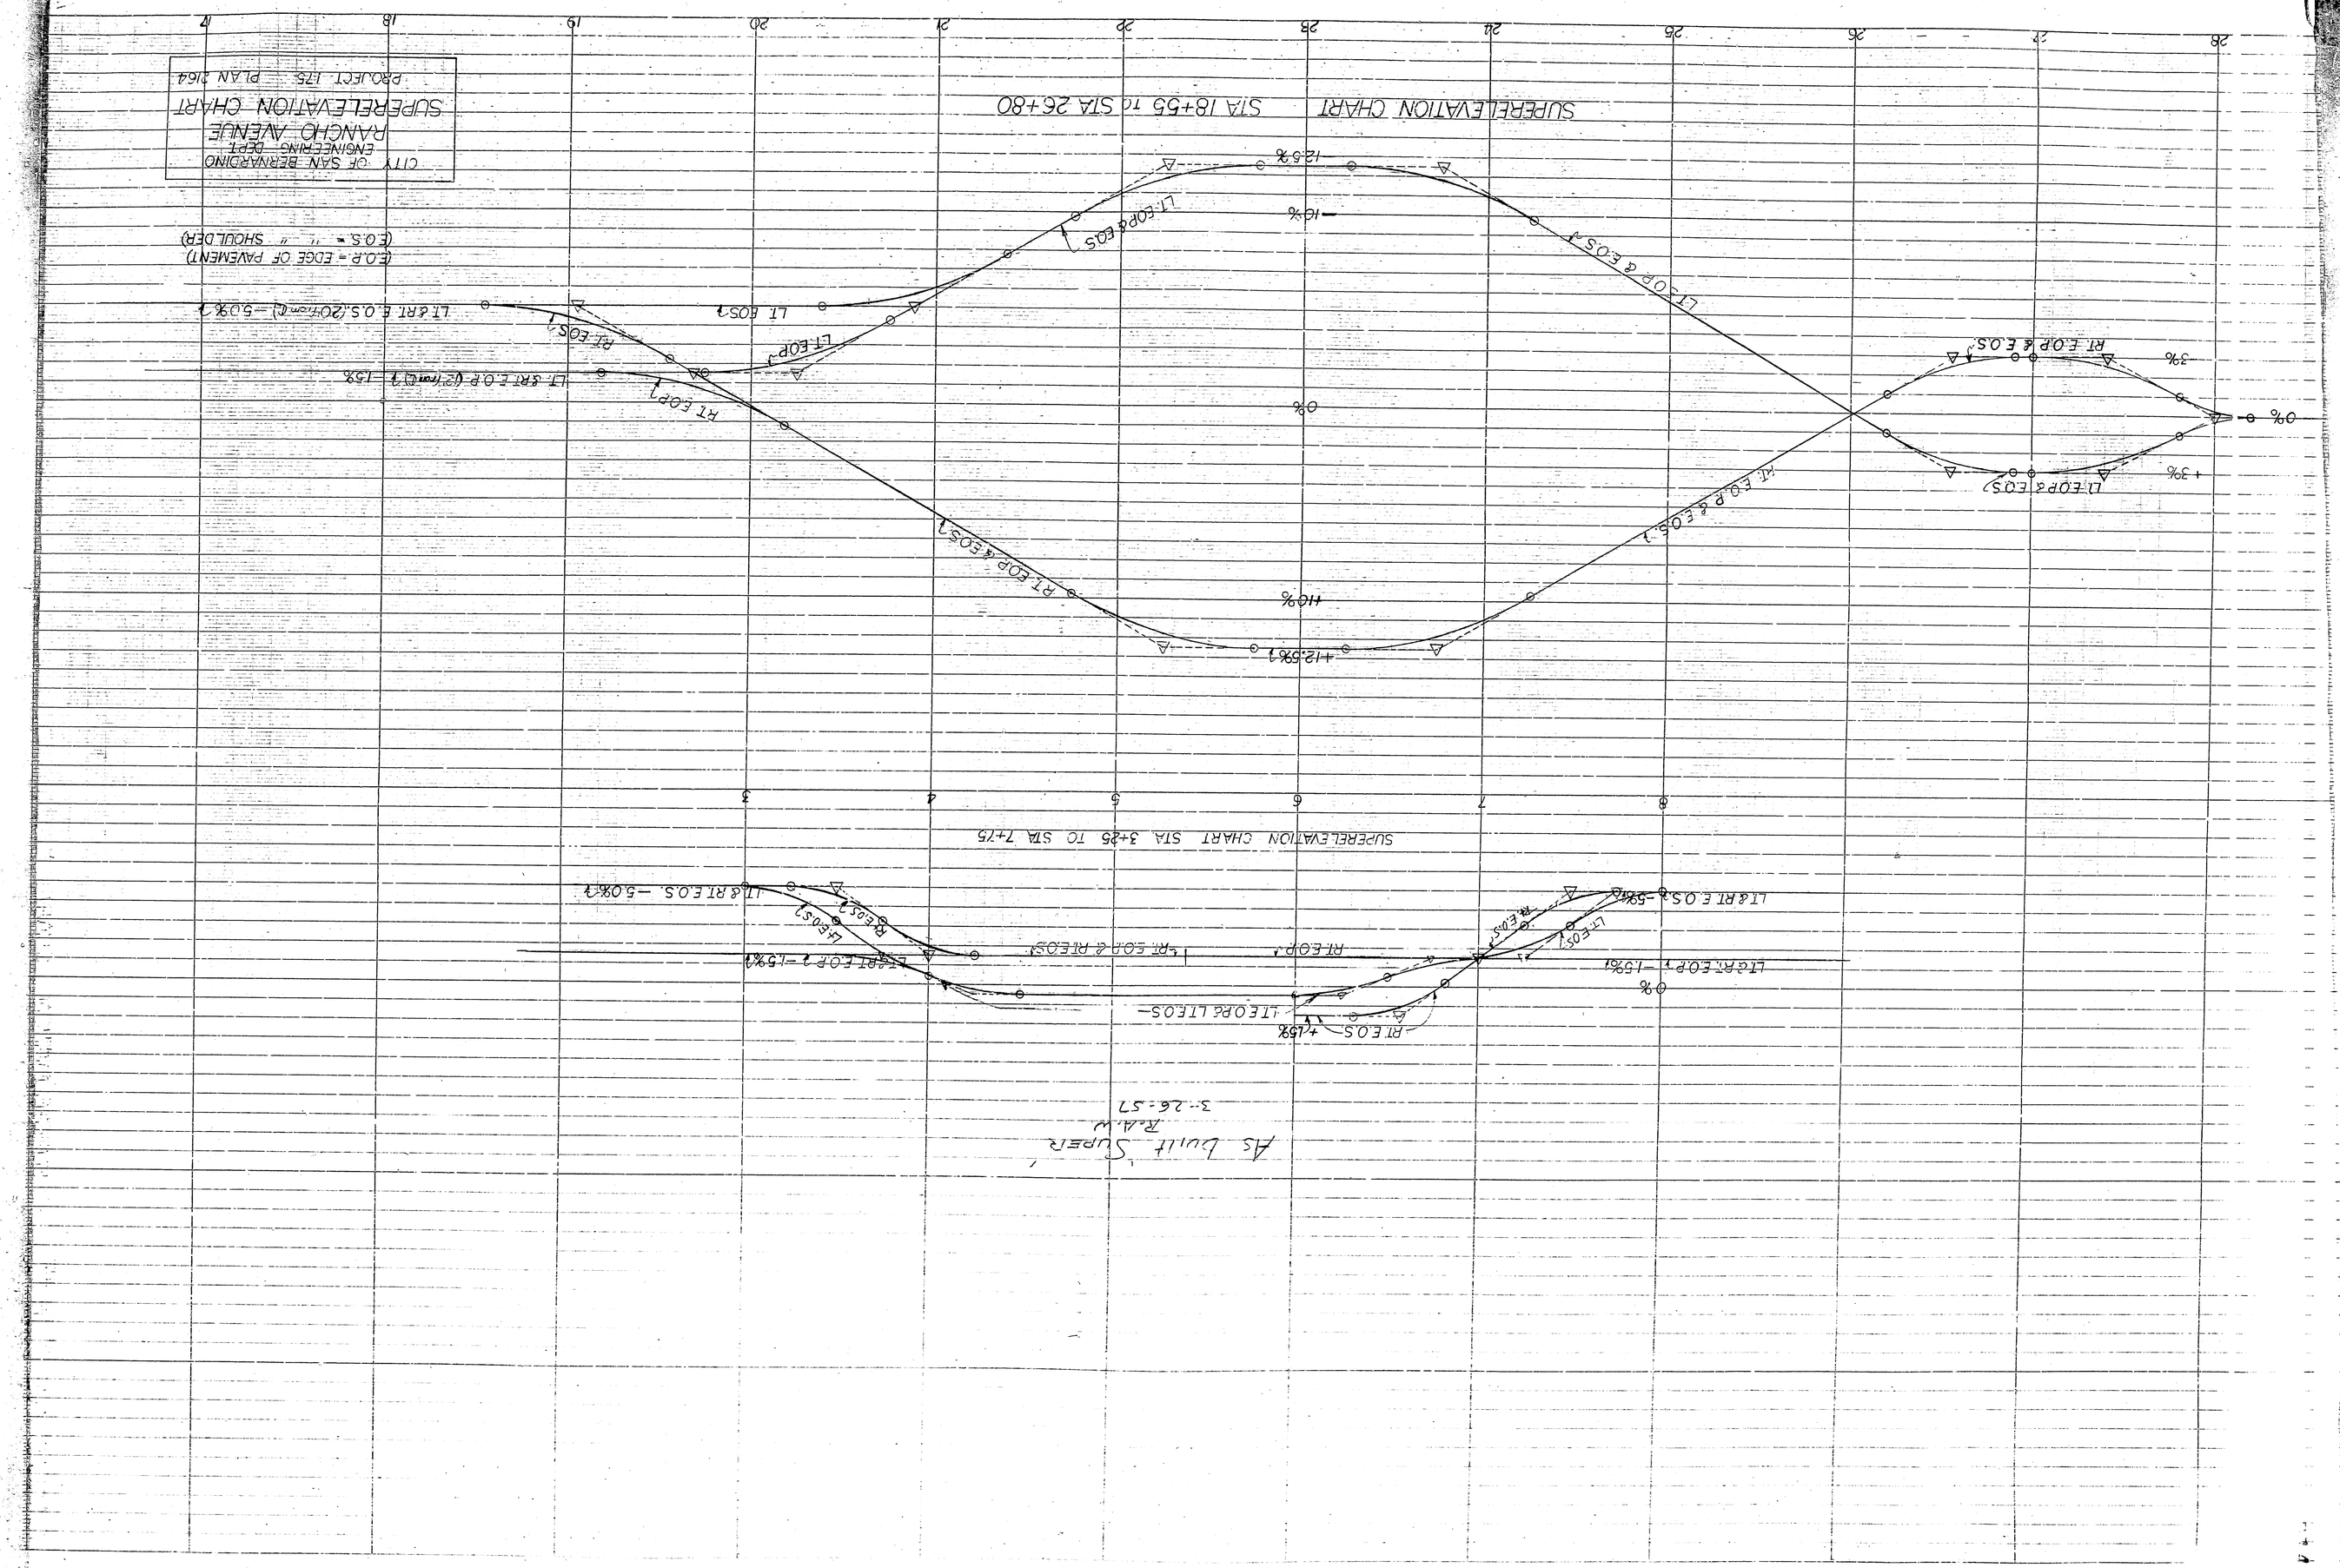
As built Super
R.A.W.
3-26-57
SUPERELEVATION CHART STA 3+25 TO STA 7+75
SUPERELEVATION CHART STA 18+55 TO STA 26+80
CITY OF SAN BERNARDINO
ENGINEERING DEPT.
RANCHO AVENUE
SUPERELEVATION CHART
PROJECT 125 PLAN 2164

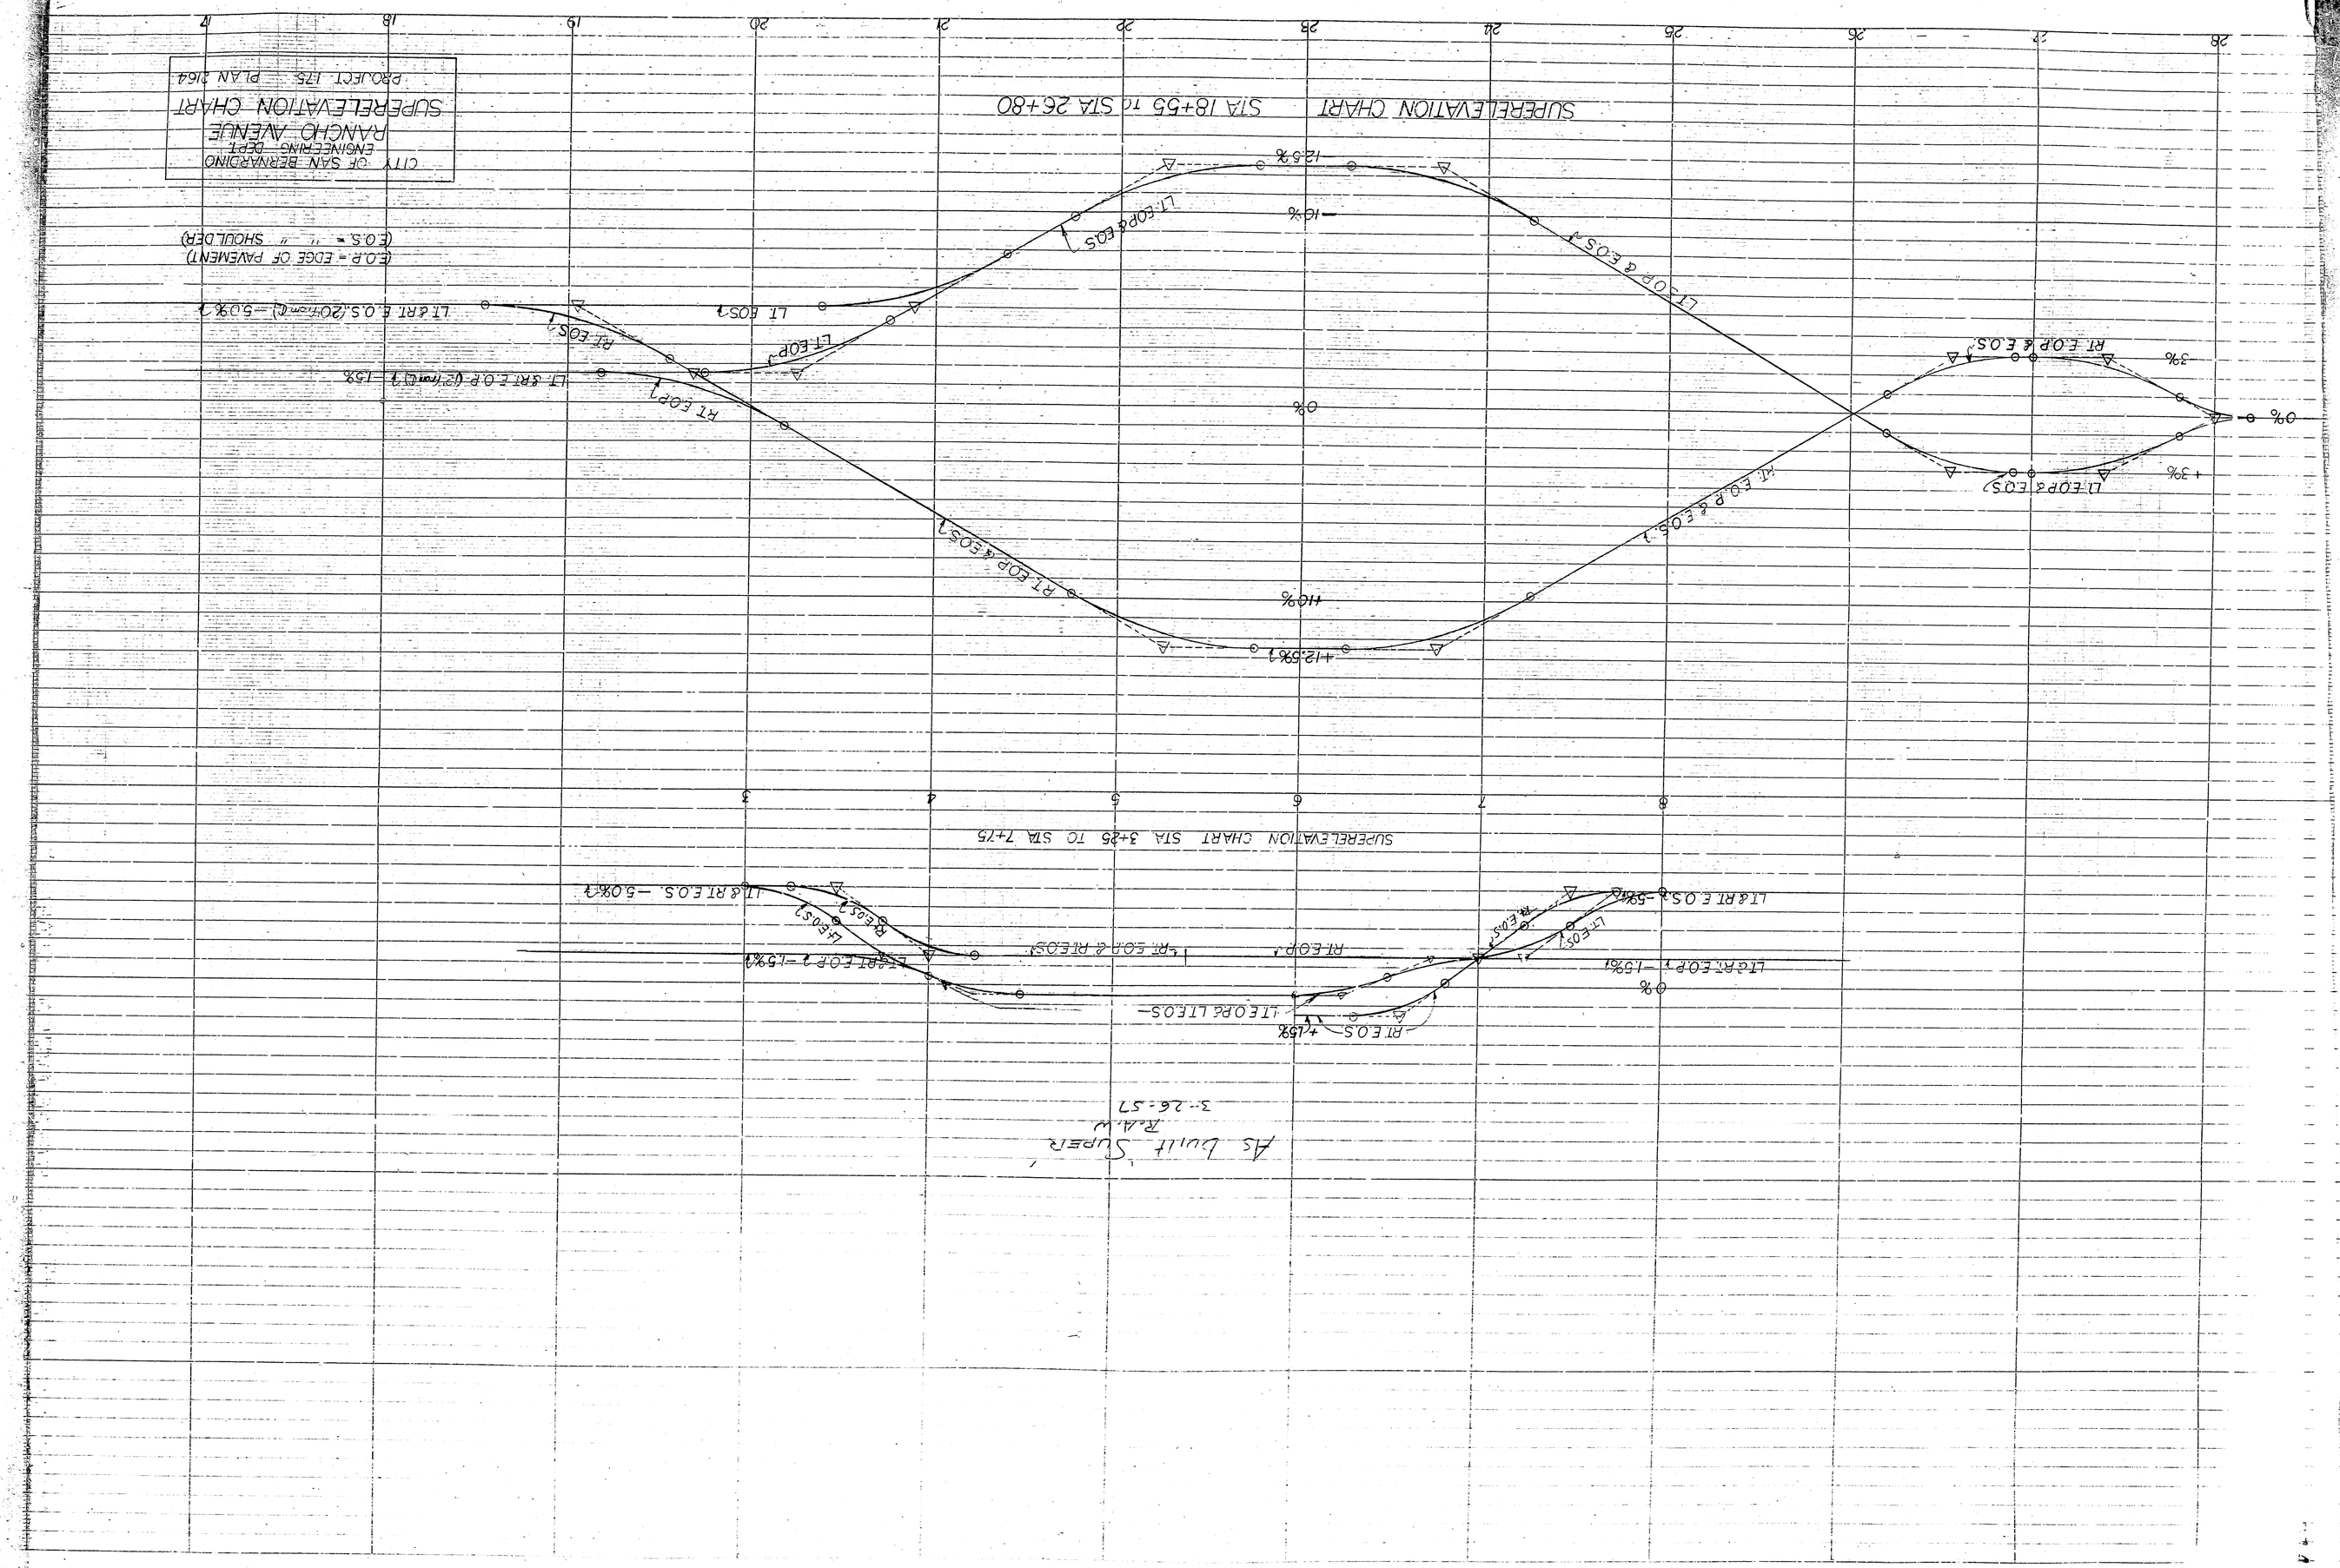
As built Super
R.A.W.
3-26-57
SUPERELEVATION CHART STA 3+25 TO STA 7+75
SUPERELEVATION CHART STA 18+55 TO STA 26+80
CITY OF SAN BERNARDINO
ENGINEERING DEPT.
RANCHO AVENUE
SUPERELEVATION CHART
PROJECT 125 PLAN 2164