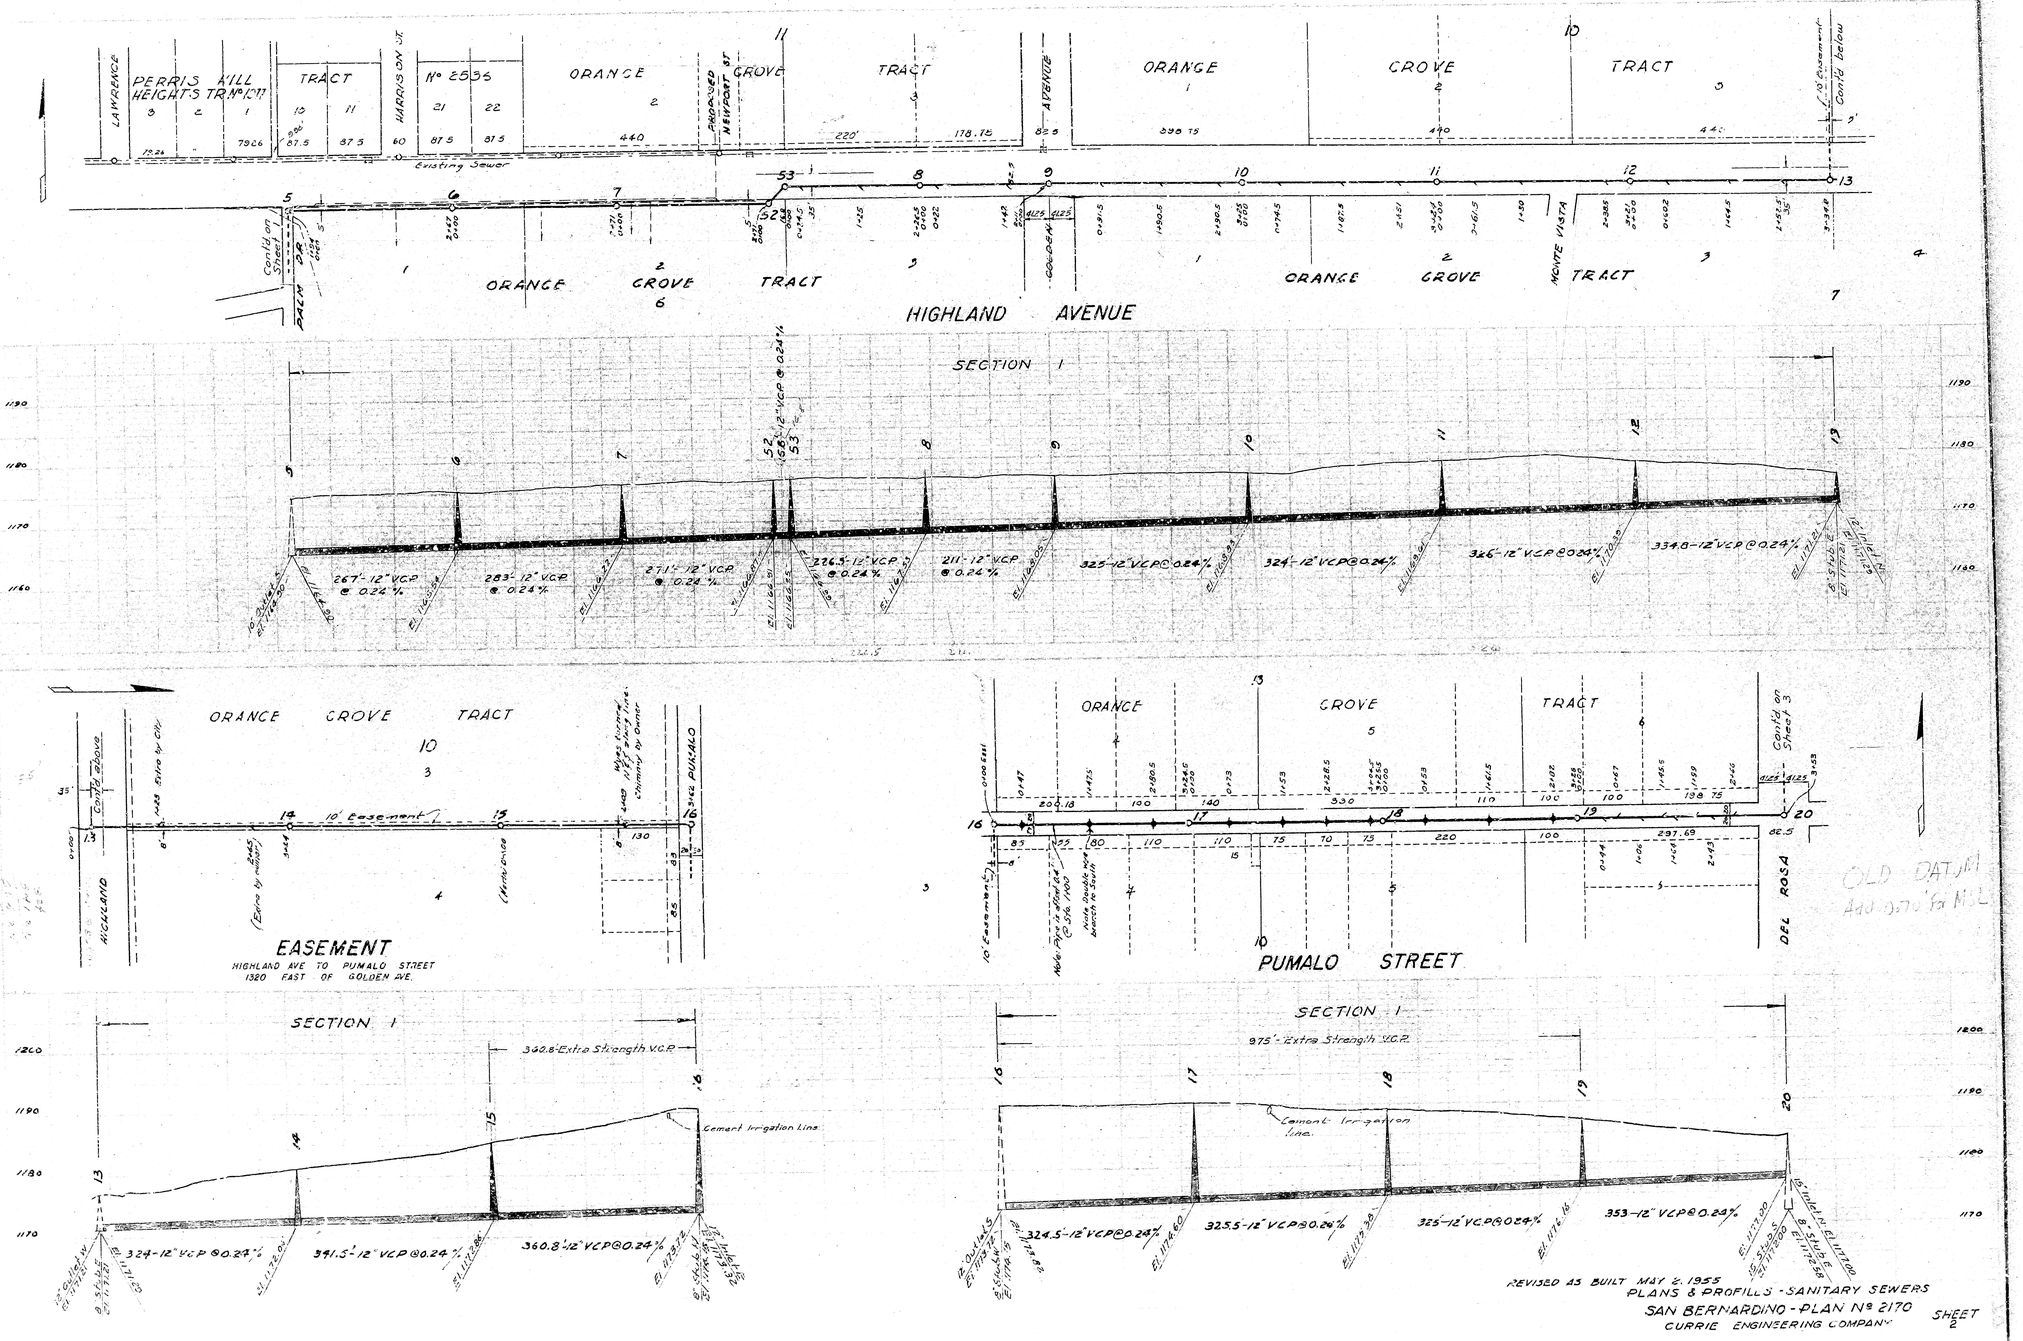

REVISED AS BUILT MAY 2, 1955
PLANS & PROFILES - SANITARY SEWERS
SAN BERNARDINO - PLAN No 2170
CURRIE ENGINEERING COMPANY

SHEET 2

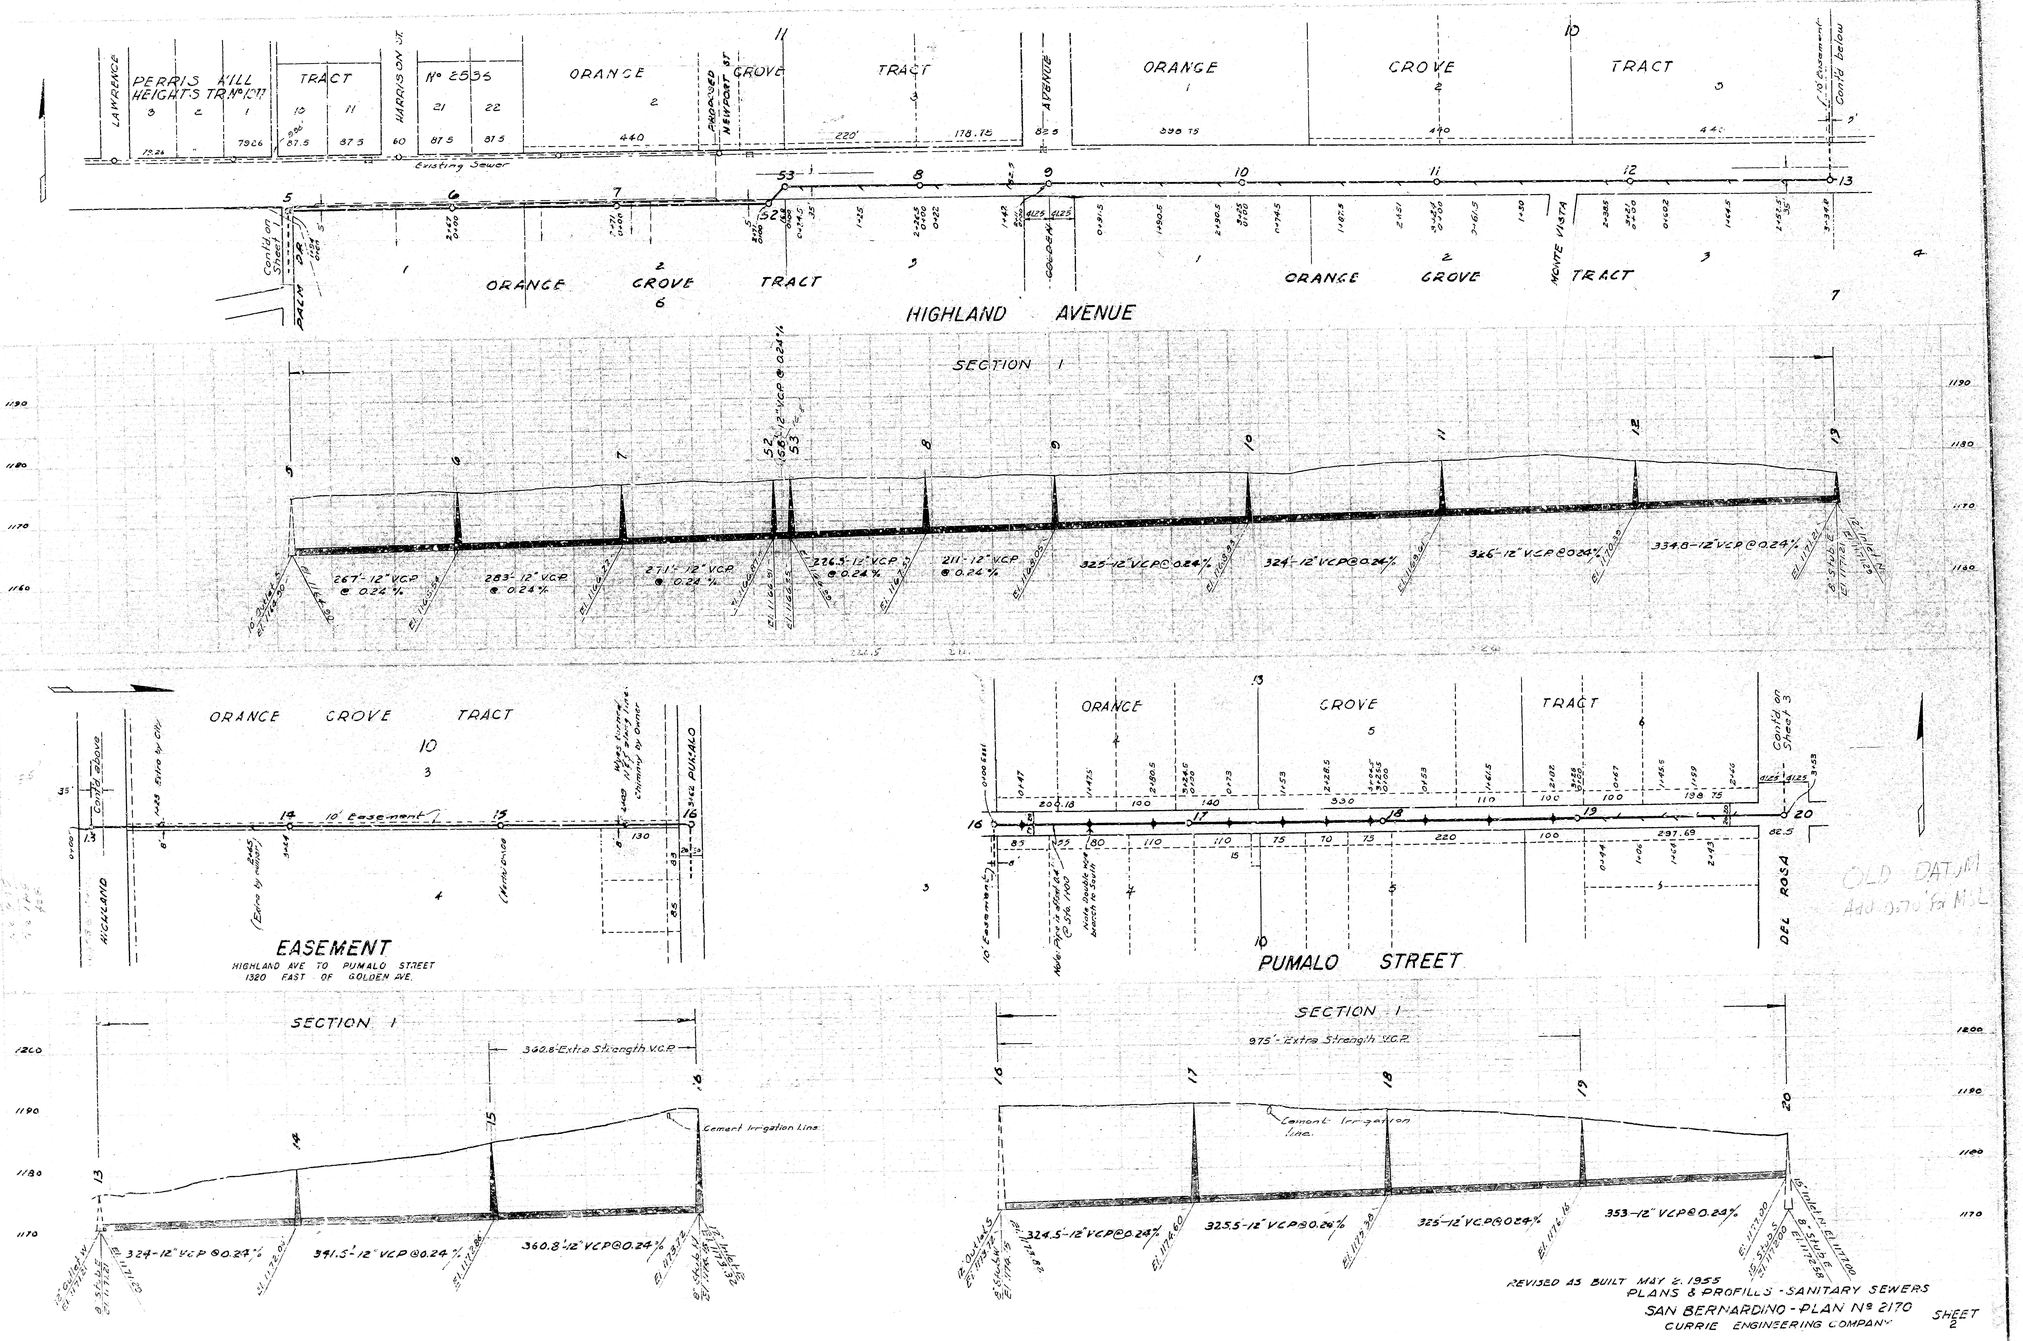

REVISED AS BUILT MAY 2, 1955
PLANS & PROFILES - SANITARY SEWERS
SAN BERNARDINO - PLAN No 2170
CURRIE ENGINEERING COMPANY

SHEET 2

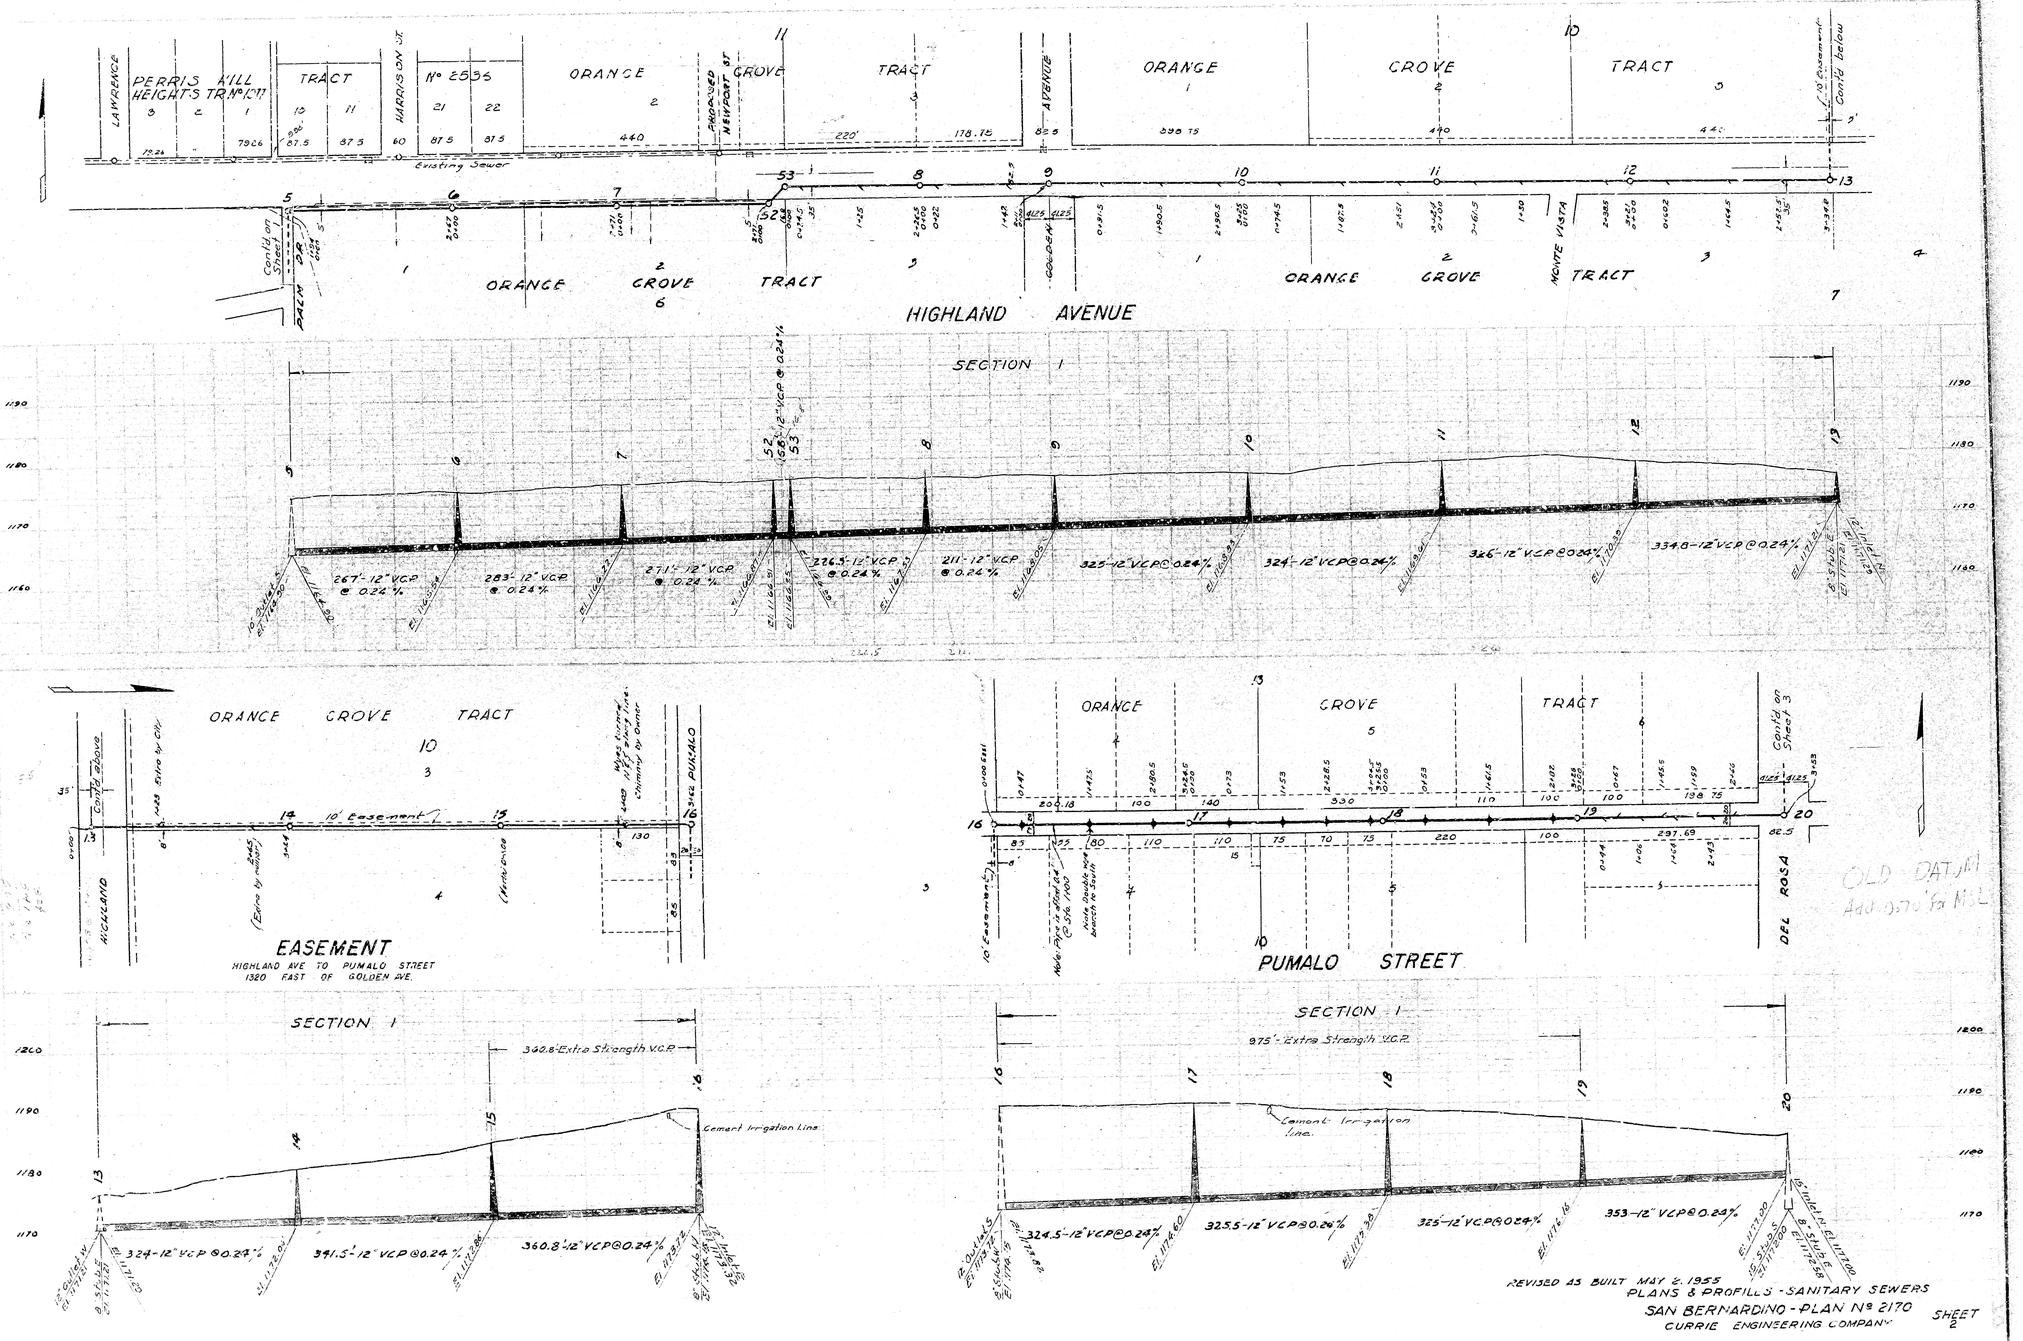

REVISED AS BUILT MAY 2, 1955
PLANS & PROFILES - SANITARY SEWERS
SAN BERNARDINO - PLAN No 2170
CURRIE ENGINEERING COMPANY

SHEET 2

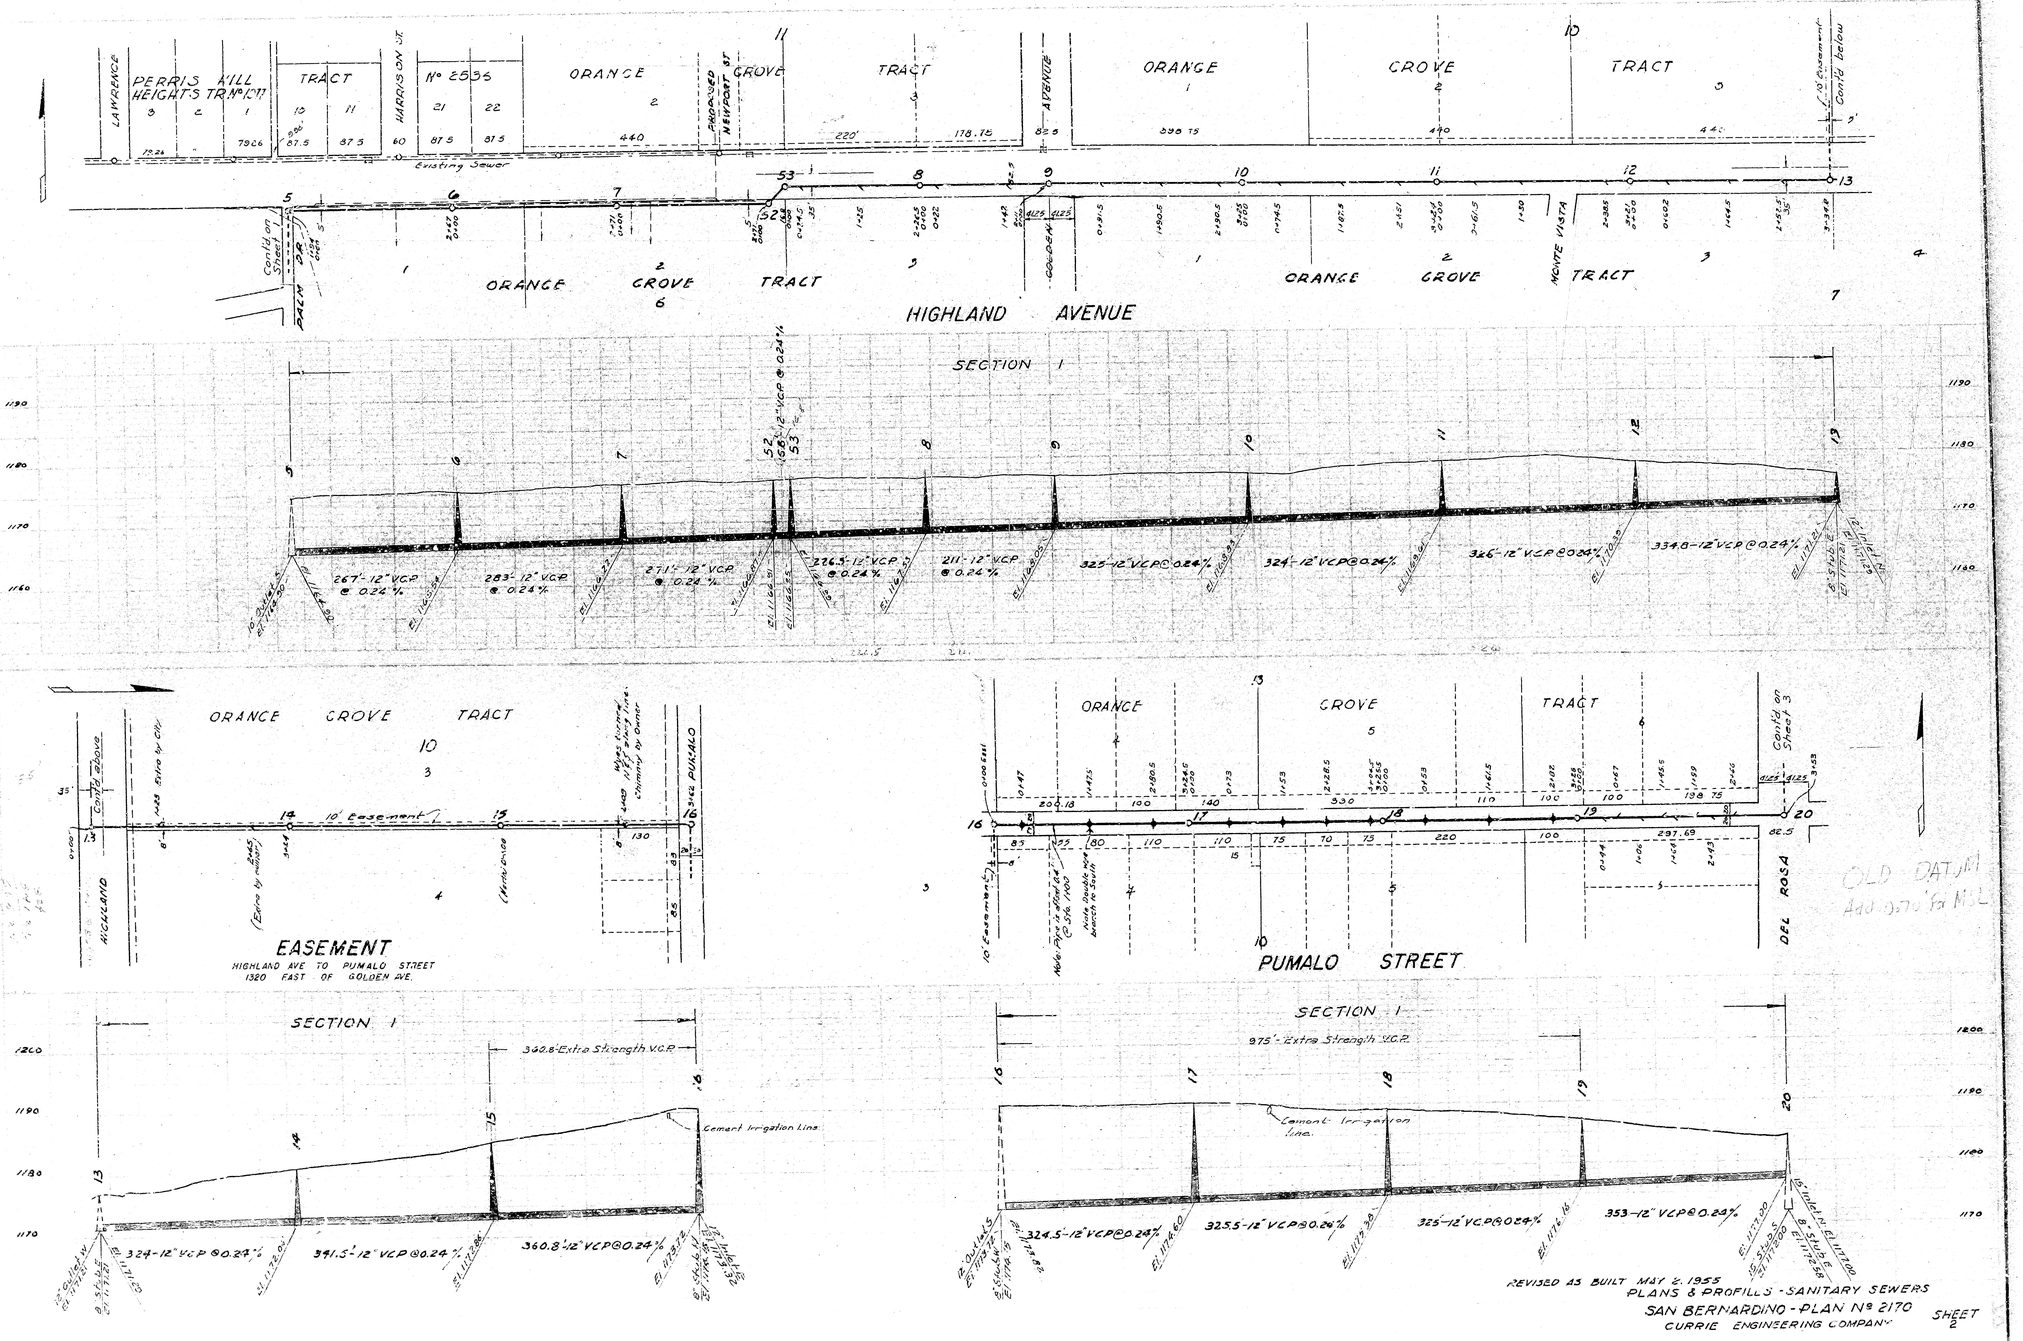

REVISED AS BUILT MAY 2, 1955
PLANS & PROFILES - SANITARY SEWERS
SAN BERNARDINO - PLAN No 2170
CURRIE ENGINEERING COMPANY

SHEET 2