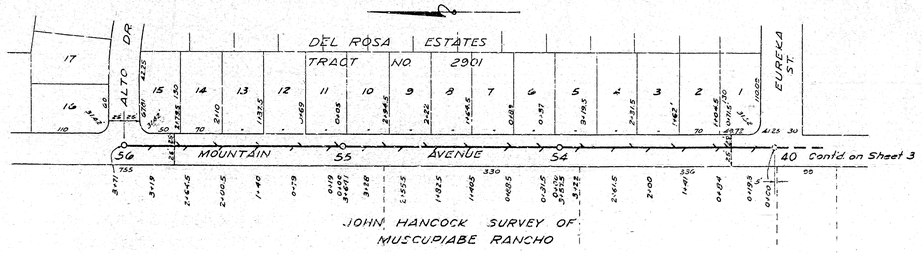

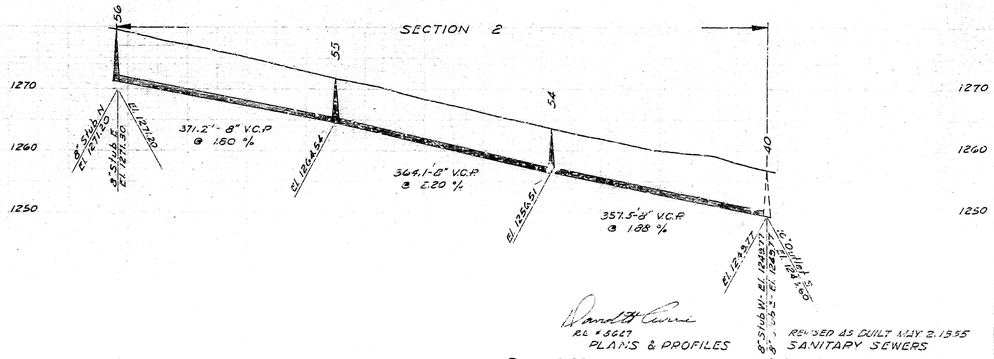

Donald H. Currie
R.E. # 3627

PLANS & PROFILES

REVISED AS BUILT MAY 2, 1935

SANITARY SEWERS

SAN BERNARDINO - PLAN Nº 2170 - CHANGE ORDER Nº 1

CURRIE ENGINEERING COMPANY

SHEET 4

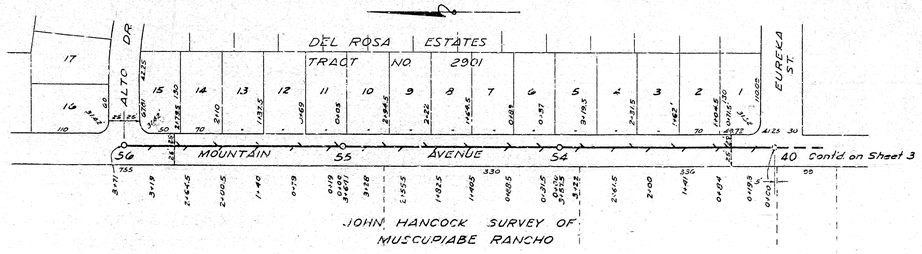

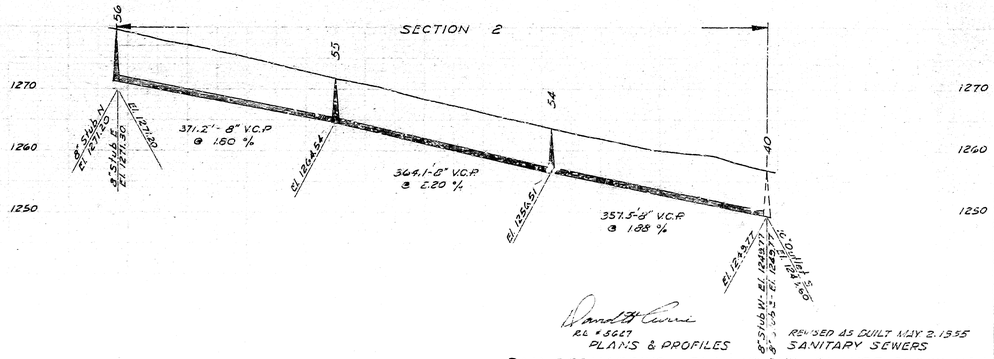

Donald H. Currie
R.E. # 3627

PLANS & PROFILES

REVISED AS BUILT MAY 2, 1935

SANITARY SEWERS

SAN BERNARDINO - PLAN Nº 2170 - CHANGE ORDER Nº 1

CURRIE ENGINEERING COMPANY

SHEET 4