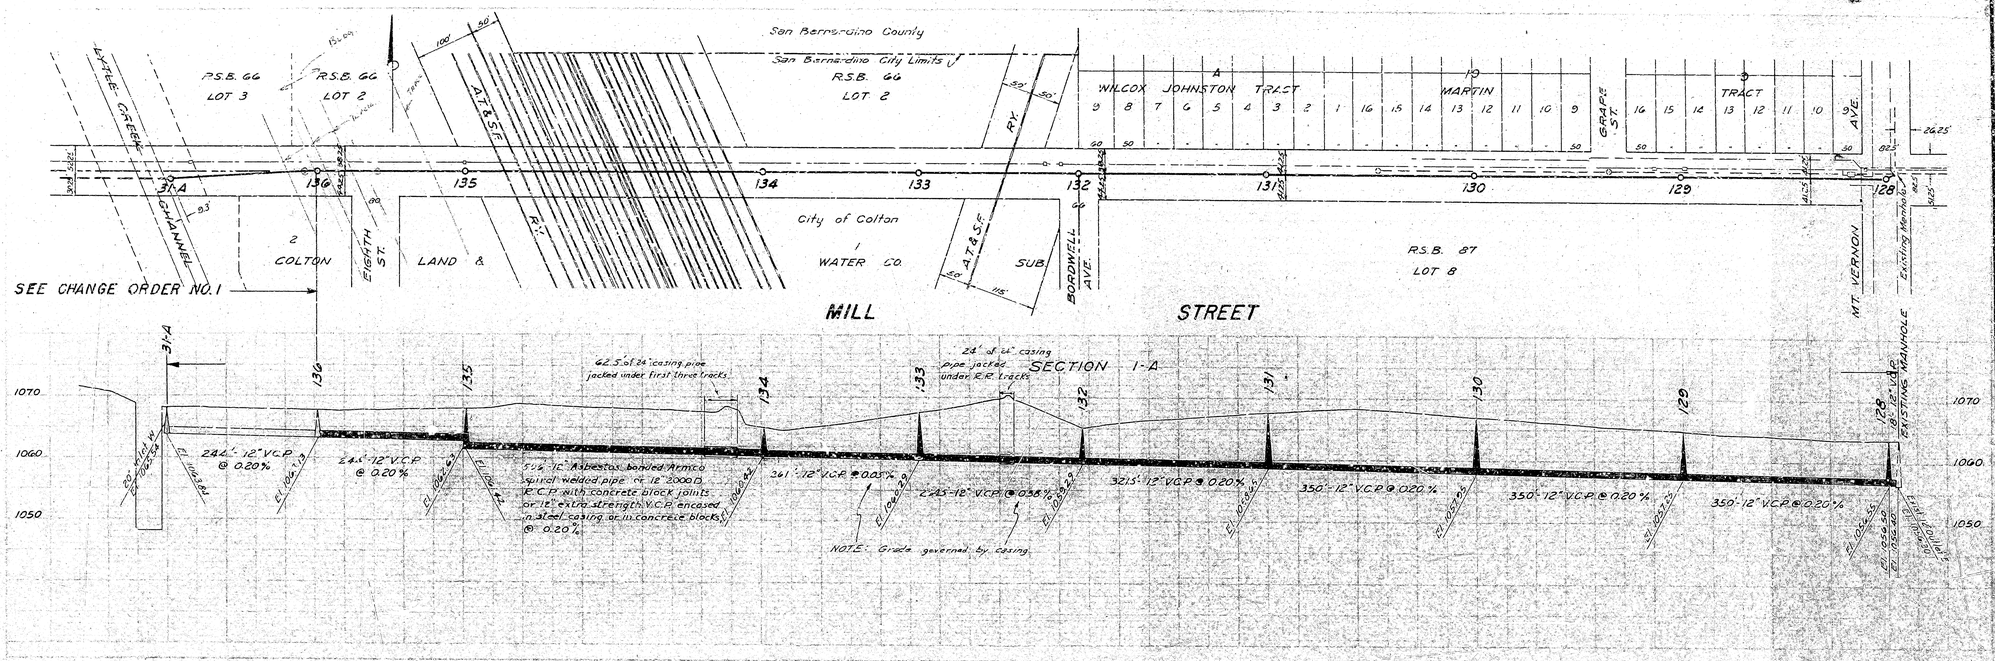

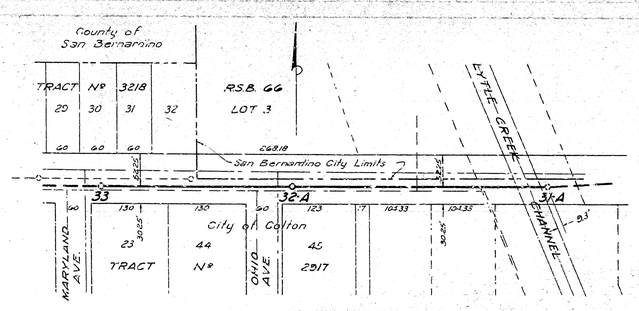

MILL STREET

SEE CHANGE ORDER NO. 1

SECTION 1-A

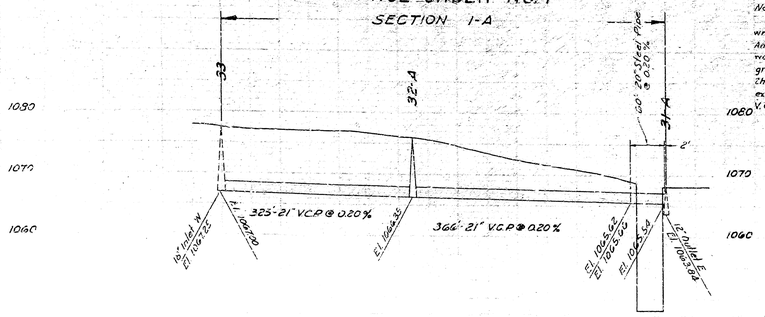

Note:
20" Schedule 20 pipe to be asphalt dipped and wrapped with 15# asphalt impregnated asbestos felt. An opening for the pipe shall be cut in each channel wall and the pipe grouted in place at the line and grade shown. Those portions of the pipe passing through channel or manhole walls shall have two extra plies of felt applied with asphalt. The joint with V.C. pipe shall be made as shown on detail, Sheet 8.

REVISED AS BUILT

PLANS & PROFILES - SANITARY SEWERS
SAN BERNARDINO - PLAN No 2171
CURPIE ENGINEERING COMPANY

SHEET 10

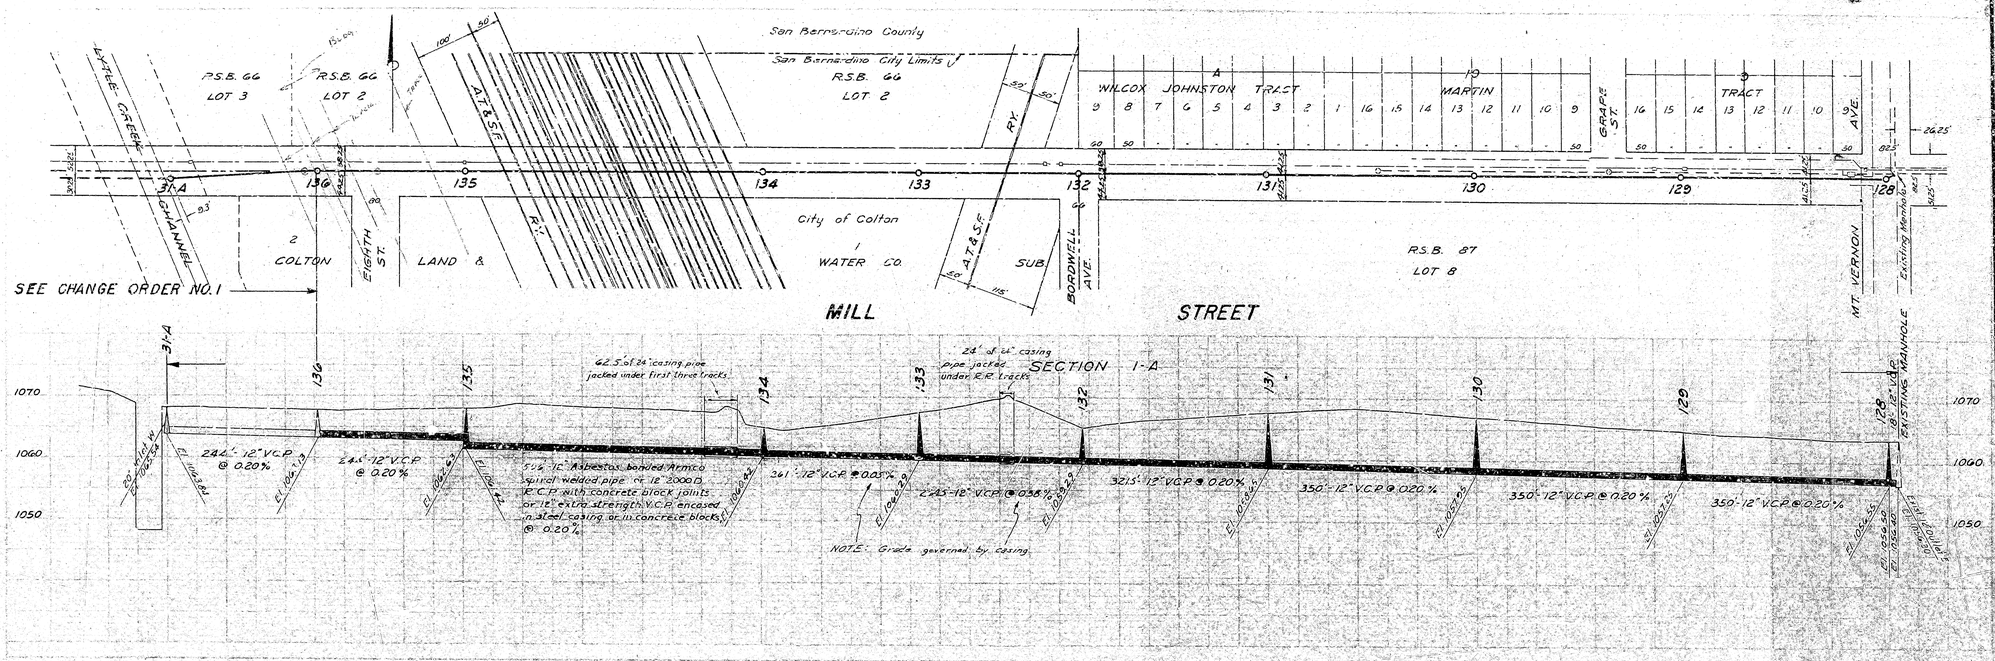

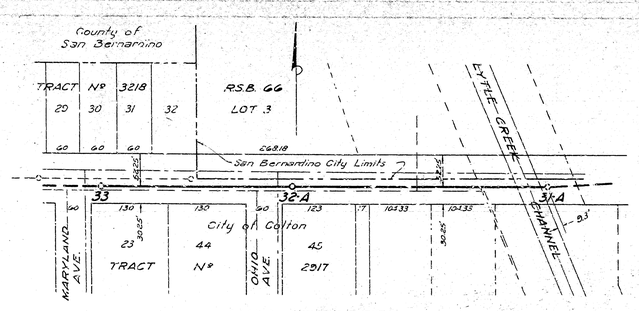

MILL STREET

SEE CHANGE ORDER NO. 1

SECTION 1-A

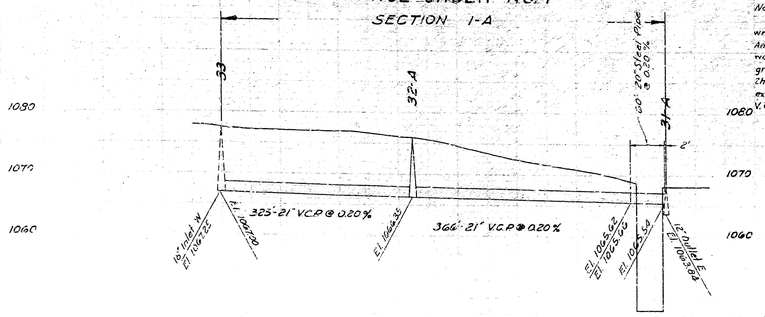

Note:
20" Schedule 20 pipe to be asphalt dipped and wrapped with 15# asphalt impregnated asbestos felt. An opening for the pipe shall be cut in each channel wall and the pipe grouted in place at the line and grade shown. Those portions of the pipe passing through channel or manhole walls shall have two extra plies of felt applied with asphalt. The joint with V.C. pipe shall be made as shown on detail, Sheet 8.

REVISED AS BUILT

PLANS & PROFILES - SANITARY SEWERS
SAN BERNARDINO - PLAN No 2171
CURPIE ENGINEERING COMPANY

SHEET 10