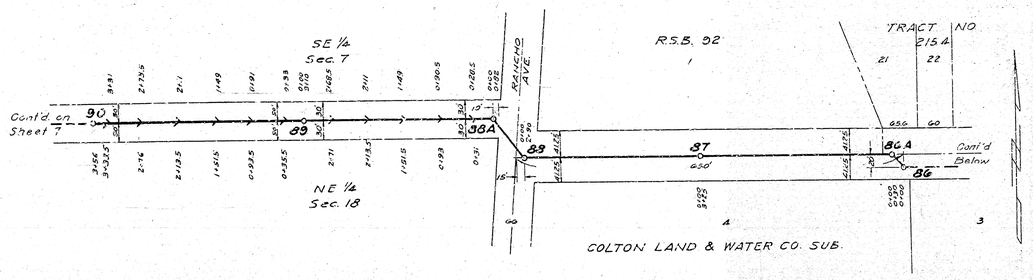

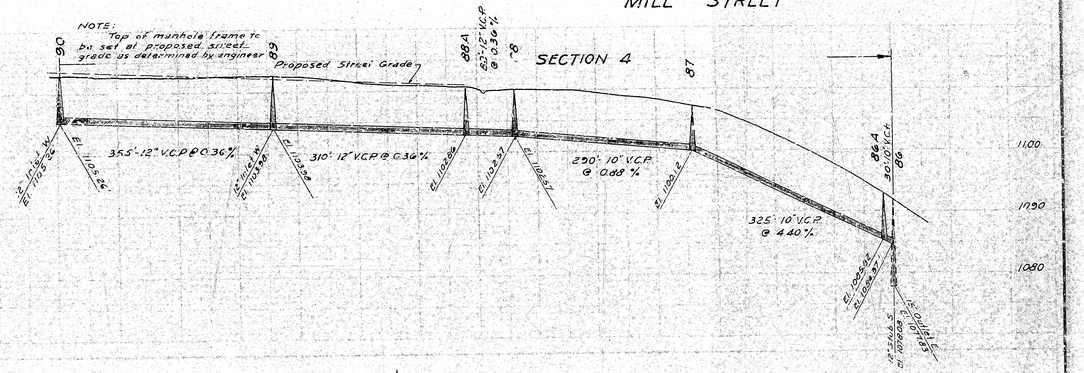

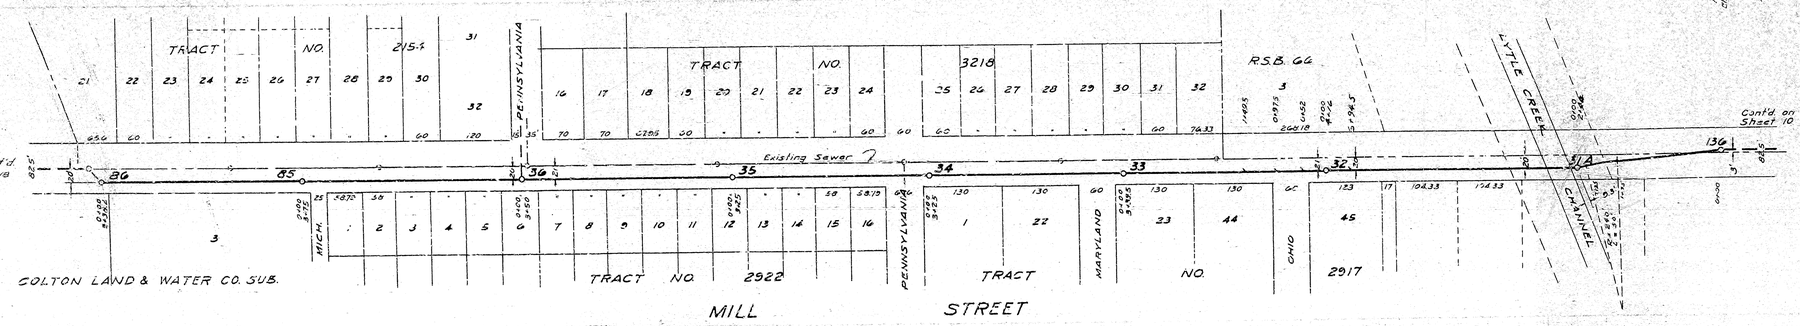

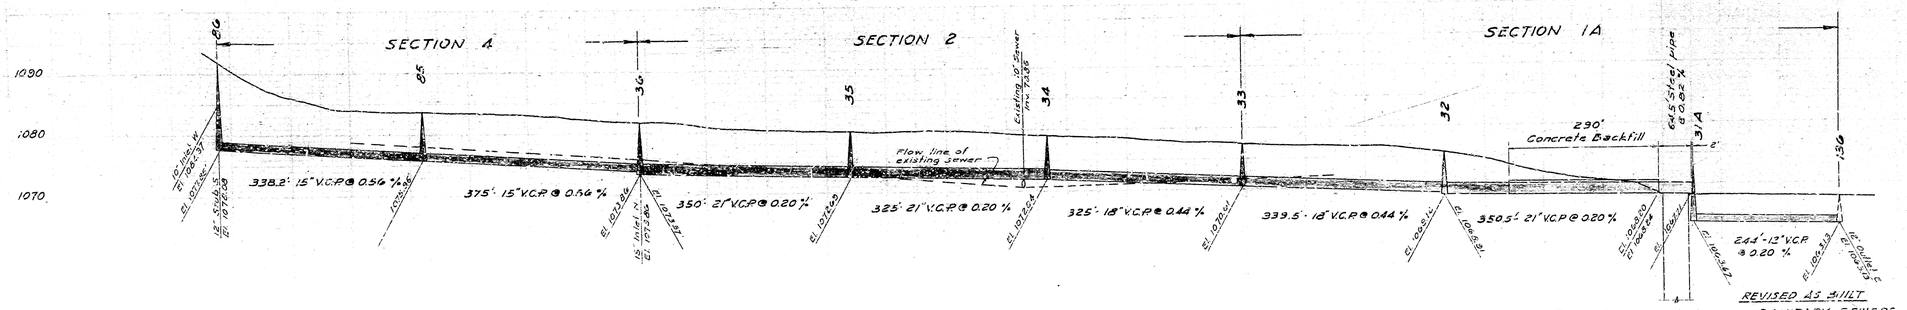

REVISED AS BUILT

PLANS & PROFILES SANITARY SEWERS

SAN BERNARDINO - PLAN Nº 2171 - CHANGE ORDER Nº 2

CURRIE ENGINEERING COMPANY SHEET 13

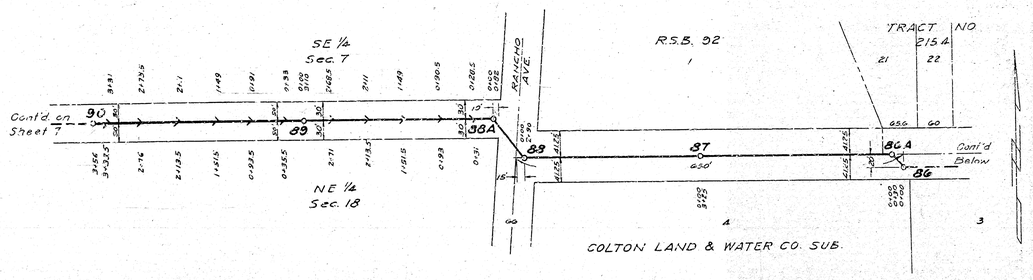

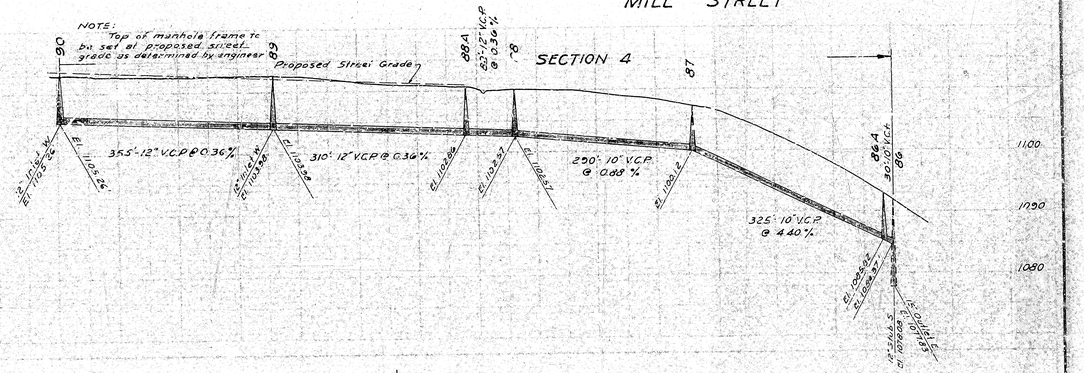

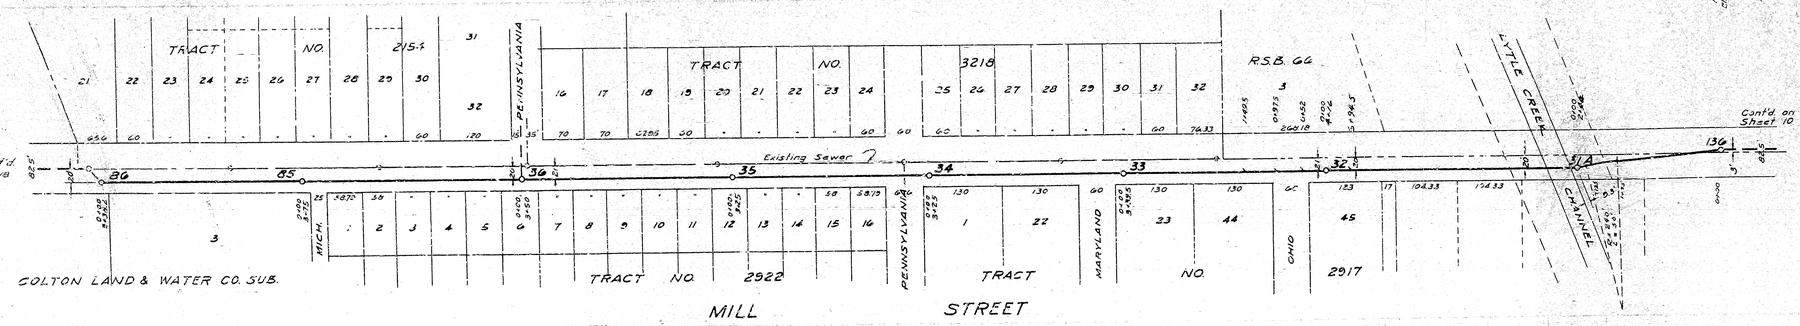

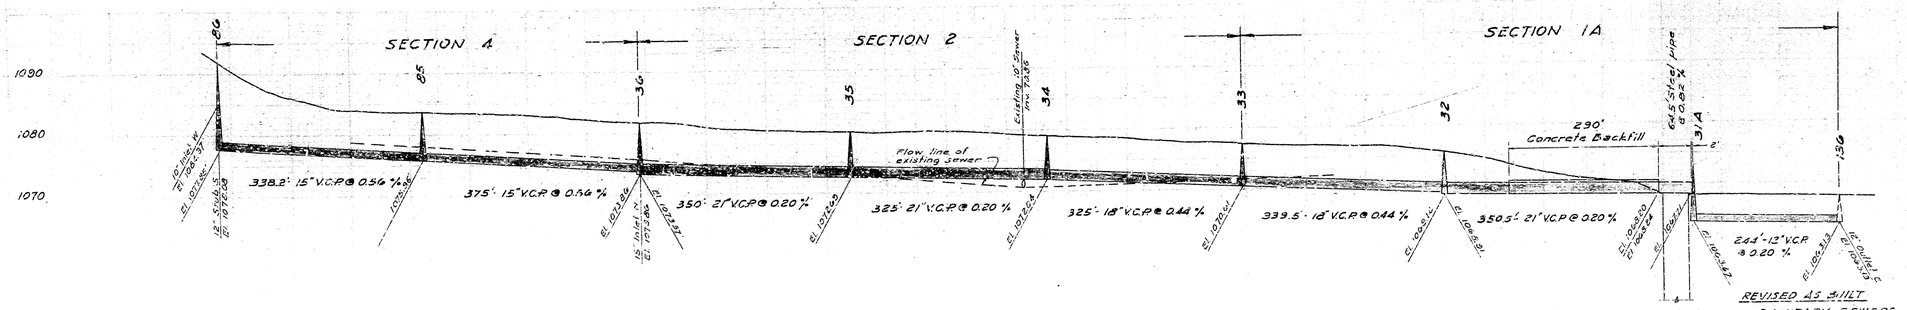

REVISED AS BUILT

PLANS & PROFILES SANITARY SEWERS

SAN BERNARDINO - PLAN Nº 2171 - CHANGE ORDER Nº 2

CURRIE ENGINEERING COMPANY SHEET 13