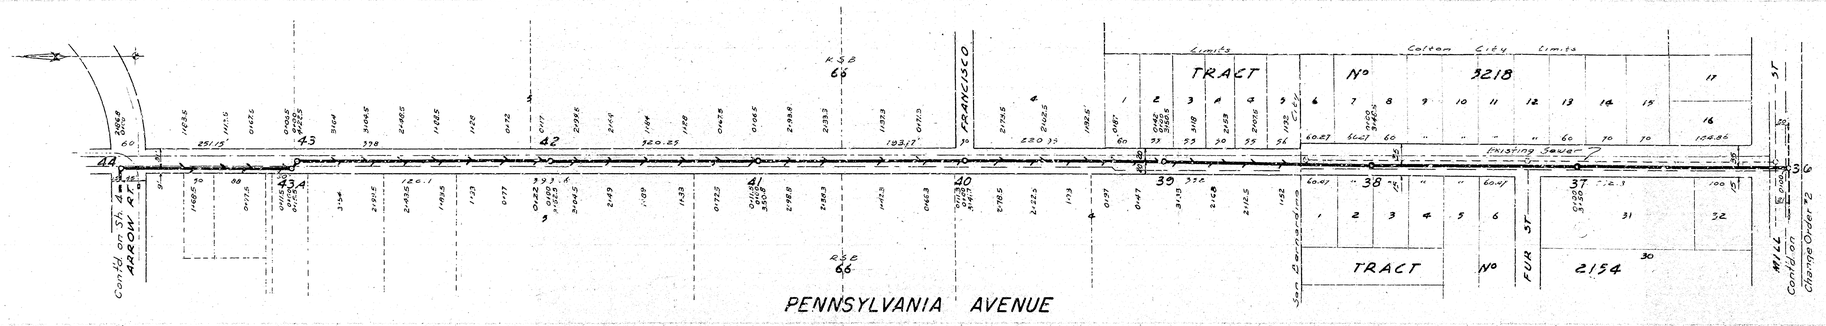

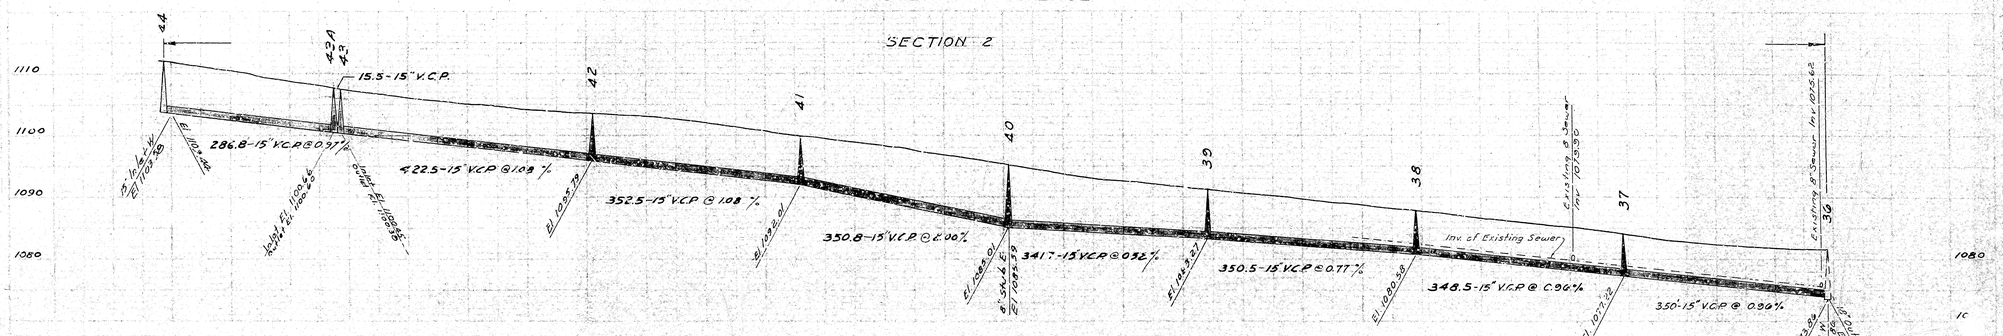

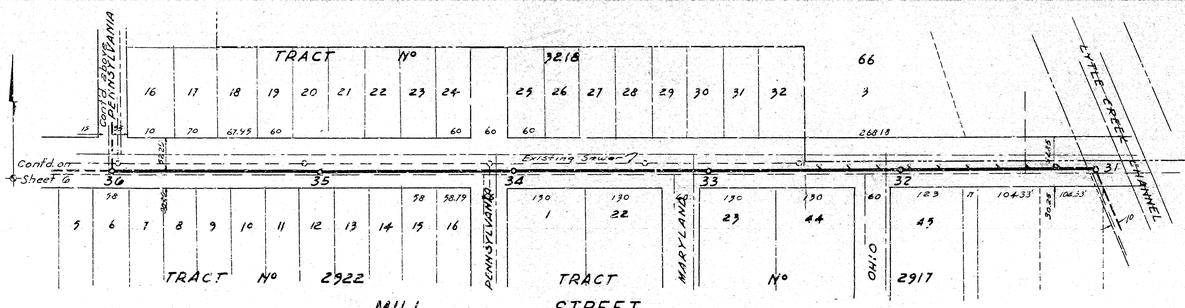

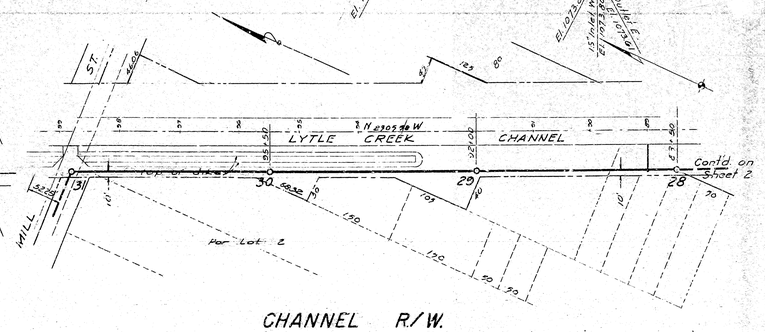

MILL STREET
SEE CHANGE ORDER NO. 2

CHANNEL R/W.
NOT CONSTRUCTED

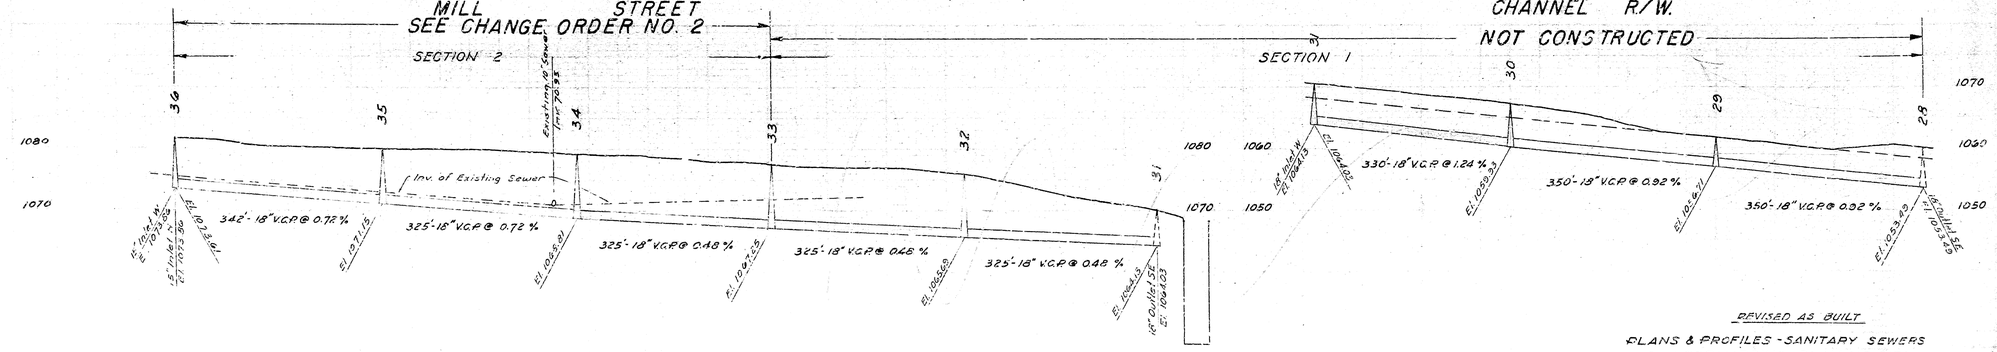

REVISED AS BUILT

PLANS & PROFILES - SANITARY SEWERS
SAN BERNARDINO - PLAN Nº 2171
CURRIE ENGINEERING COMPANY

SHEET 5

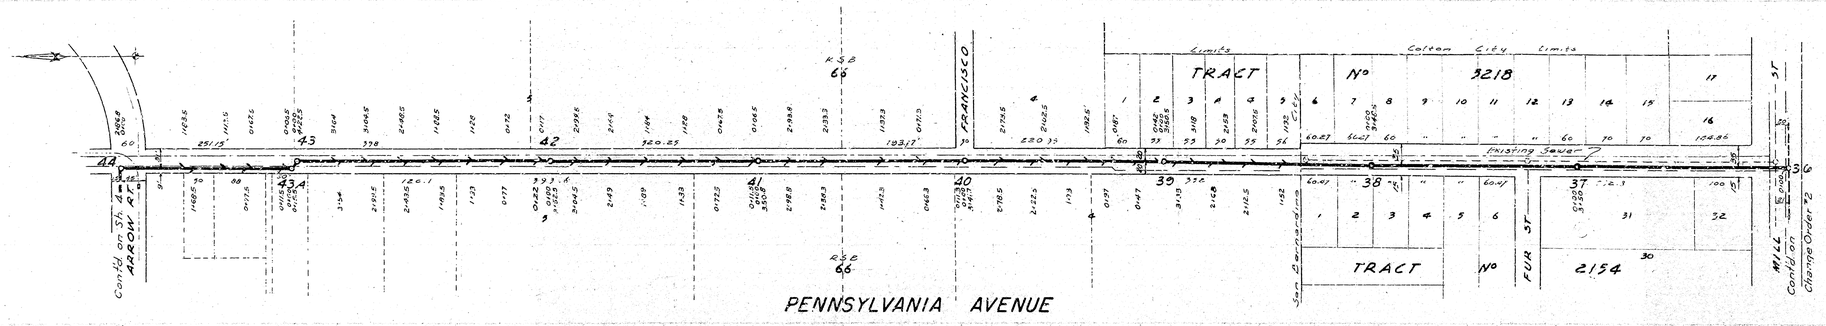

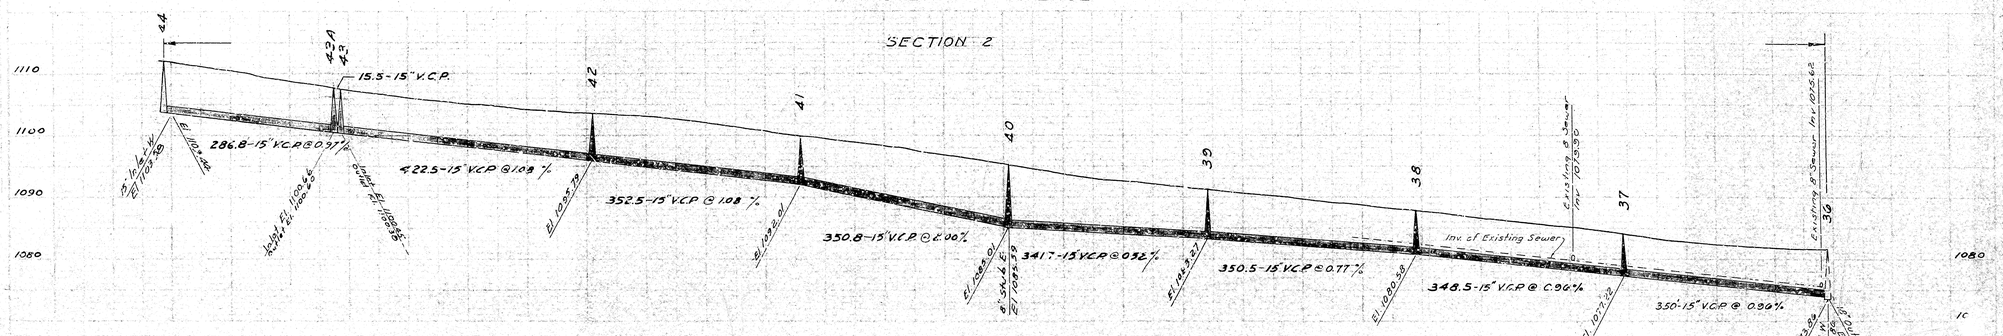

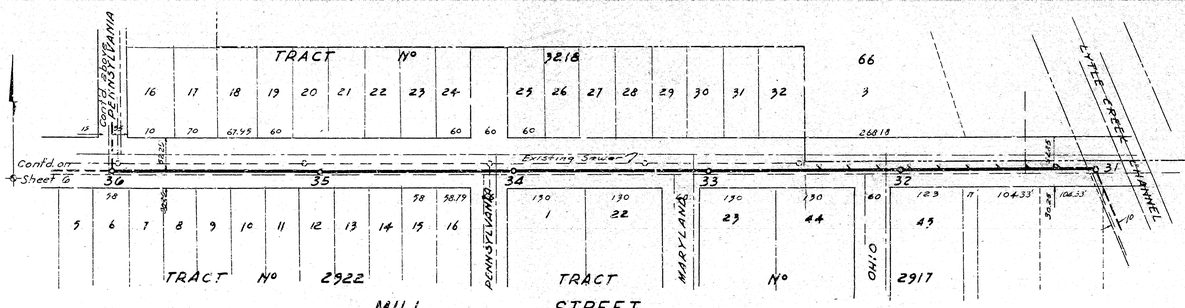

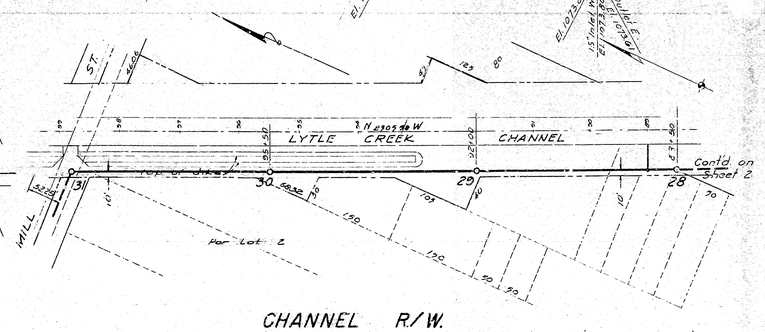

MILL STREET
SEE CHANGE ORDER NO. 2

CHANNEL R/W.
NOT CONSTRUCTED

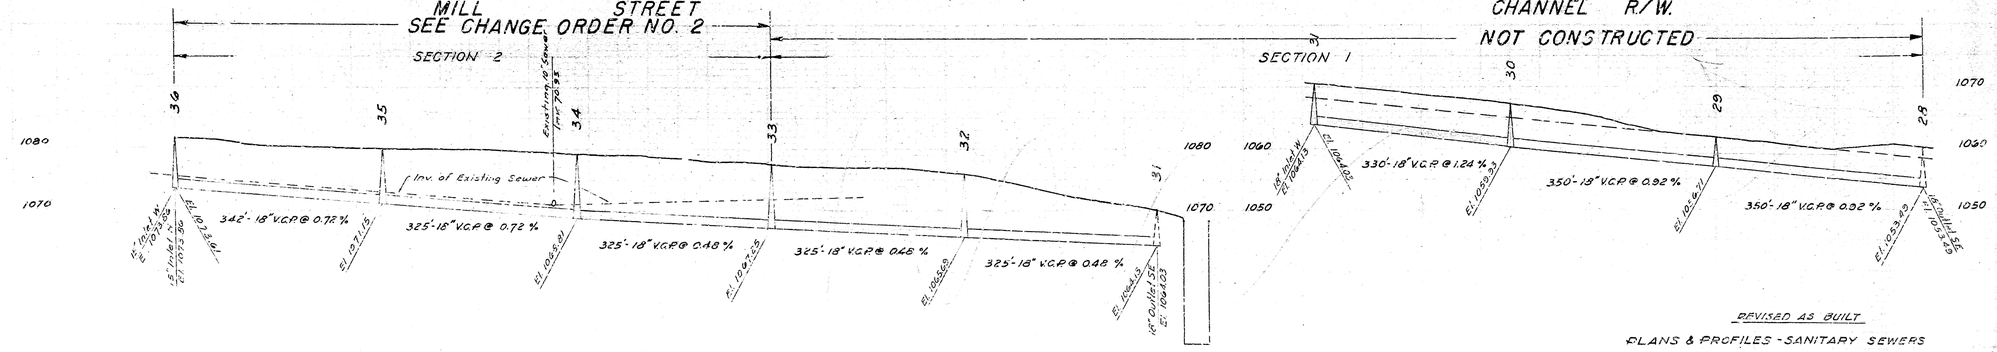

REVISED AS BUILT

PLANS & PROFILES - SANITARY SEWERS
SAN BERNARDINO - PLAN Nº 2171
CURRIE ENGINEERING COMPANY

SHEET 5