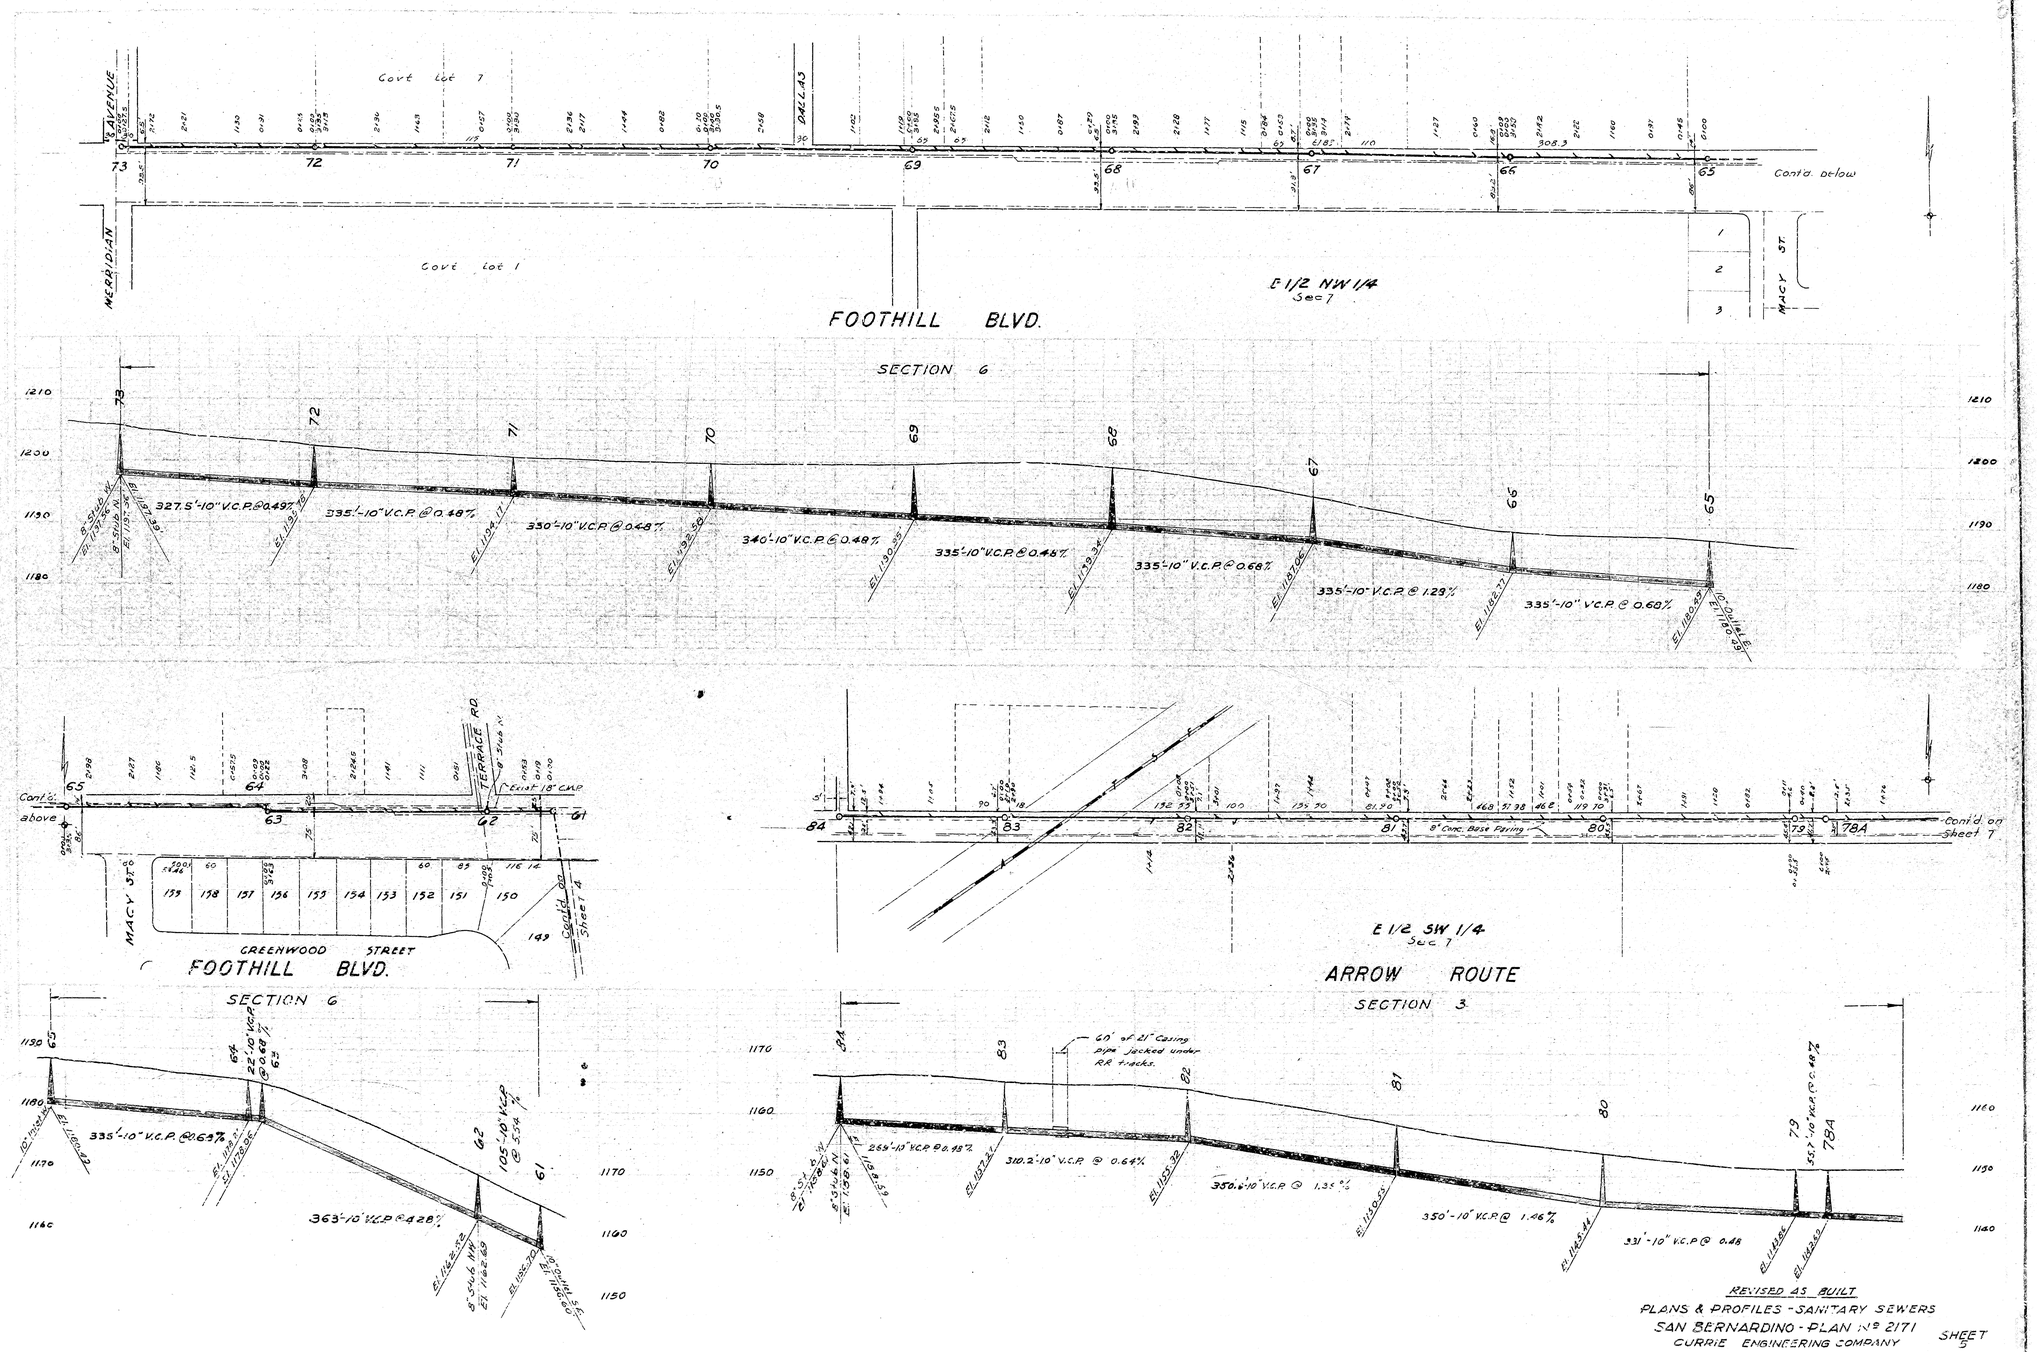

REVISED AS BUILT

PLANS & PROFILES - SANITARY SEWERS

SAN BERNARDINO - PLAN No 2171

CURRIE ENGINEERING COMPANY

SHEET 5

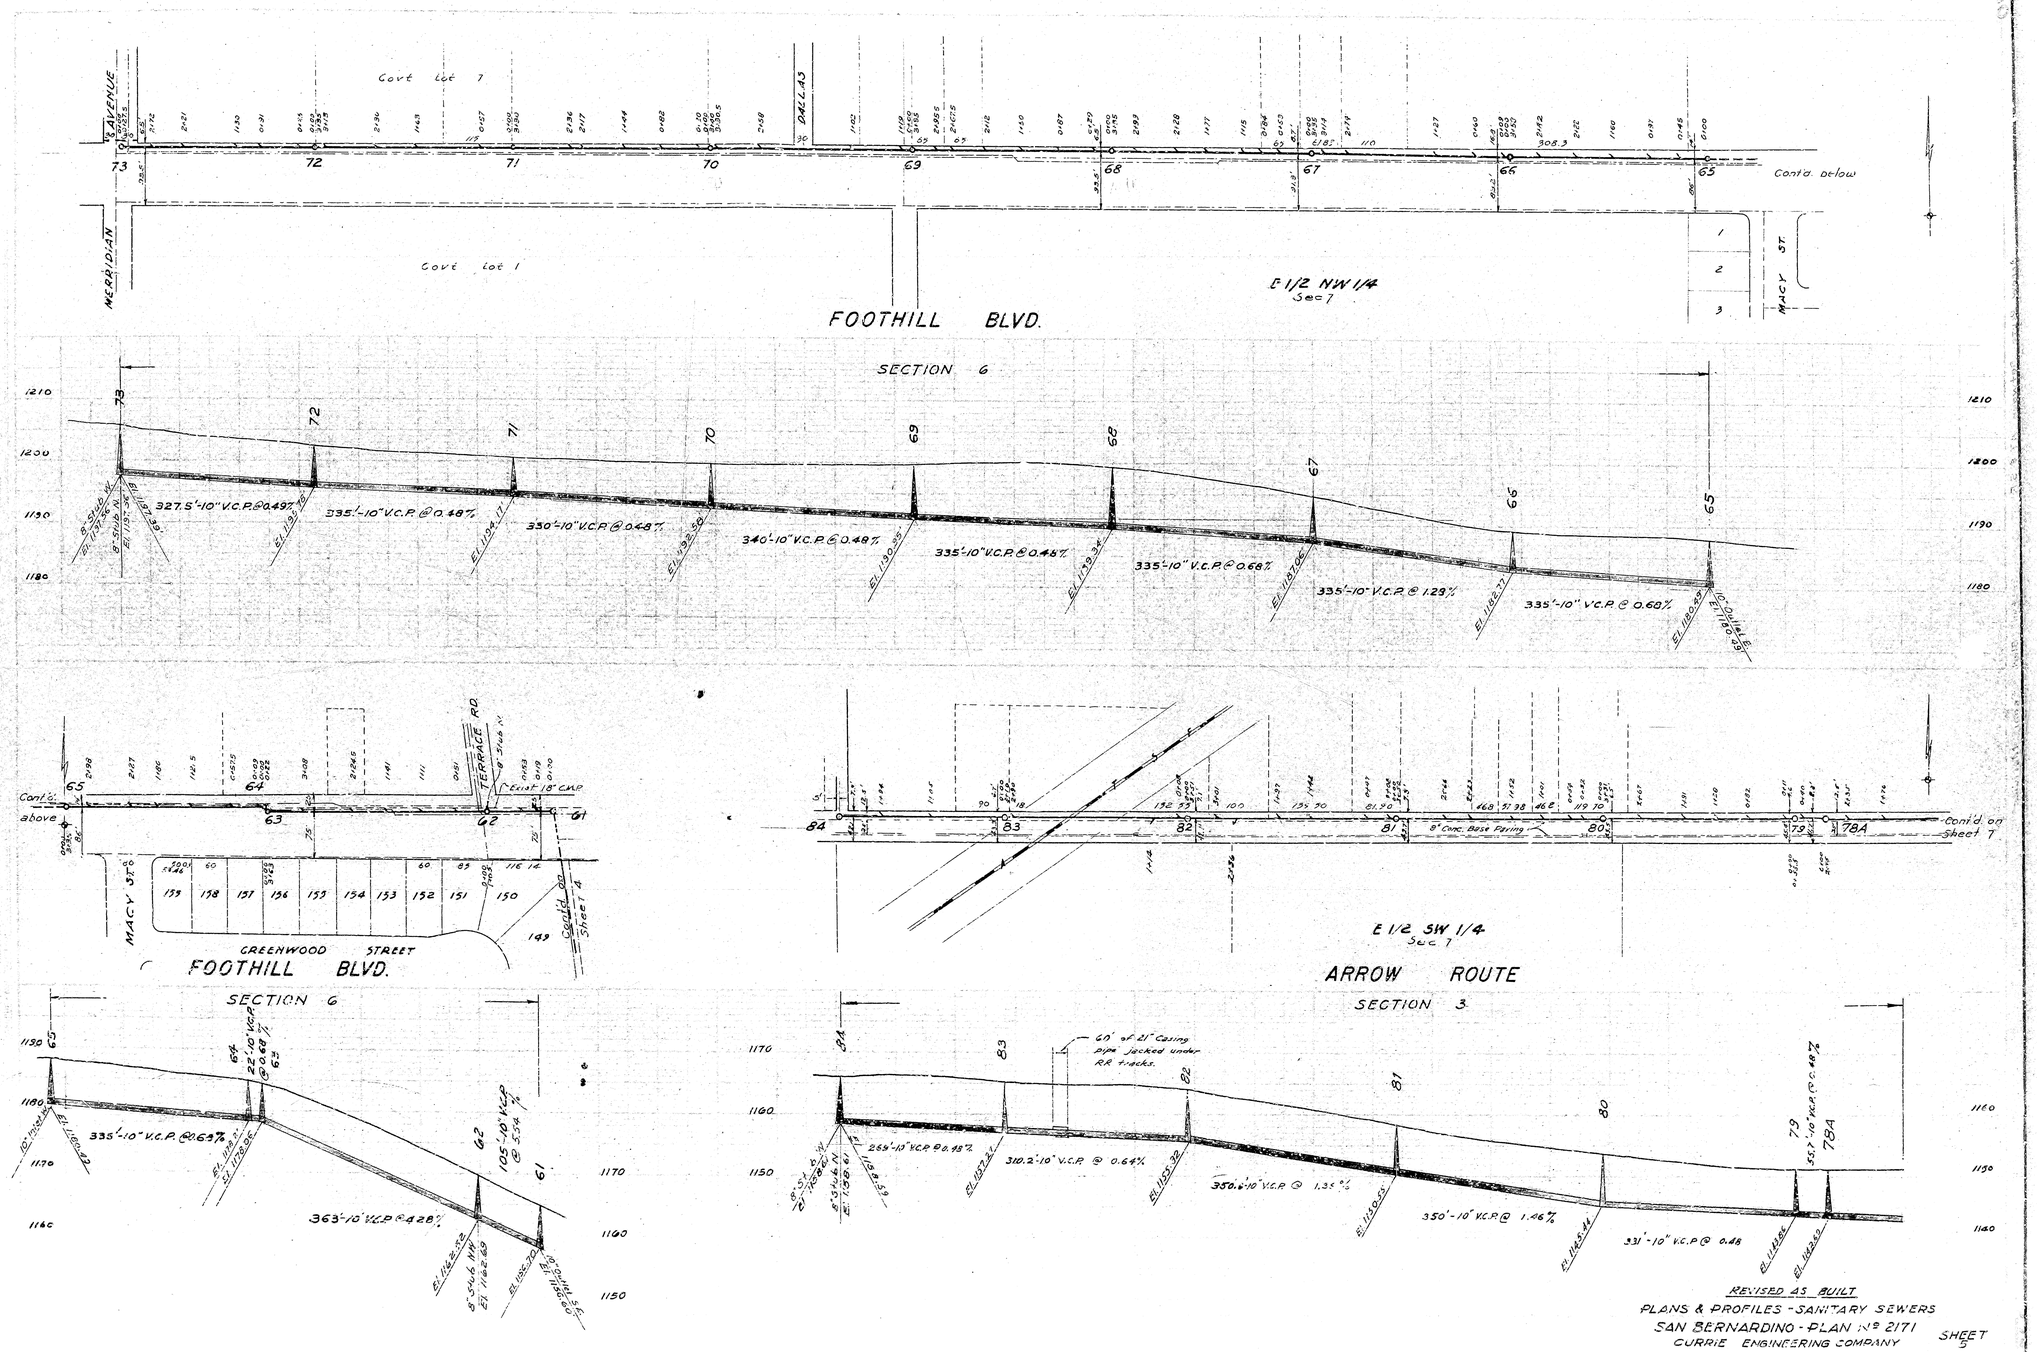

REVISED AS BUILT

PLANS & PROFILES - SANITARY SEWERS

SAN BERNARDINO - PLAN No 2171

CURRIE ENGINEERING COMPANY

SHEET 5