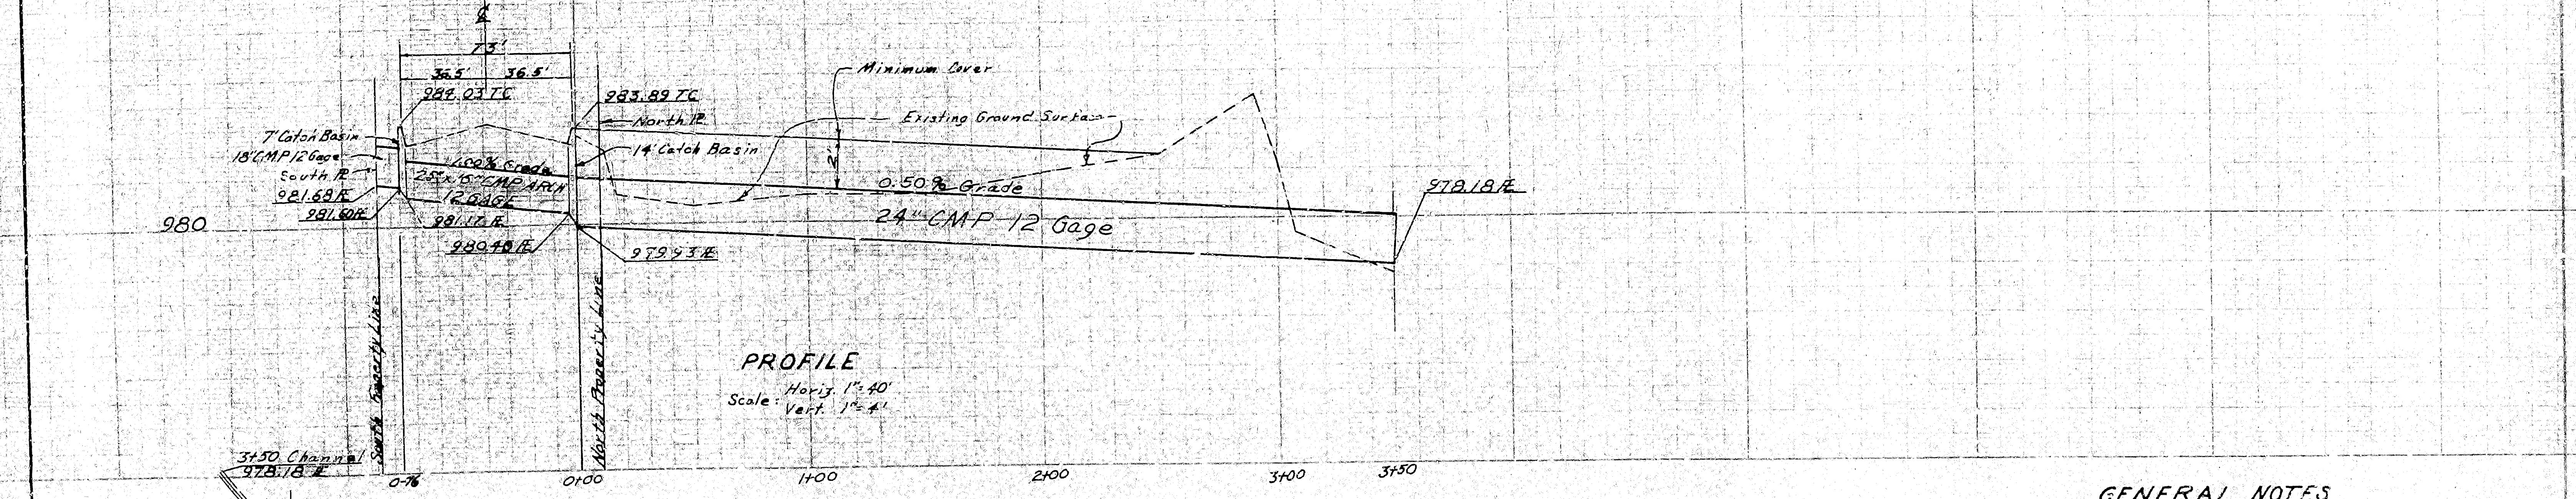
℄
73'
36.5'
36.5'
984.03 TC
983.89 TC
North ℞
Minimum Cover
Existing Ground Surface
7' Catch Basin
18" CMP 12 Gage
South ℞
981.68 IE
981.60 IE
1.00% Grade
25"x16" CMP ARCH 12 GAGE
14' Catch Basin
981.17 IE
980.40 IE
979.93 IE
0.50% Grade
24" CMP 12 Gage
978.18 IE
980
South Property Line
North Property Line
3+50 Channel
978.18 IE
0-76
0+00
1+00
2+00
3+00
3+50

PROFILE

Scale: Horiz. 1"=40'
Vert. 1"=4'

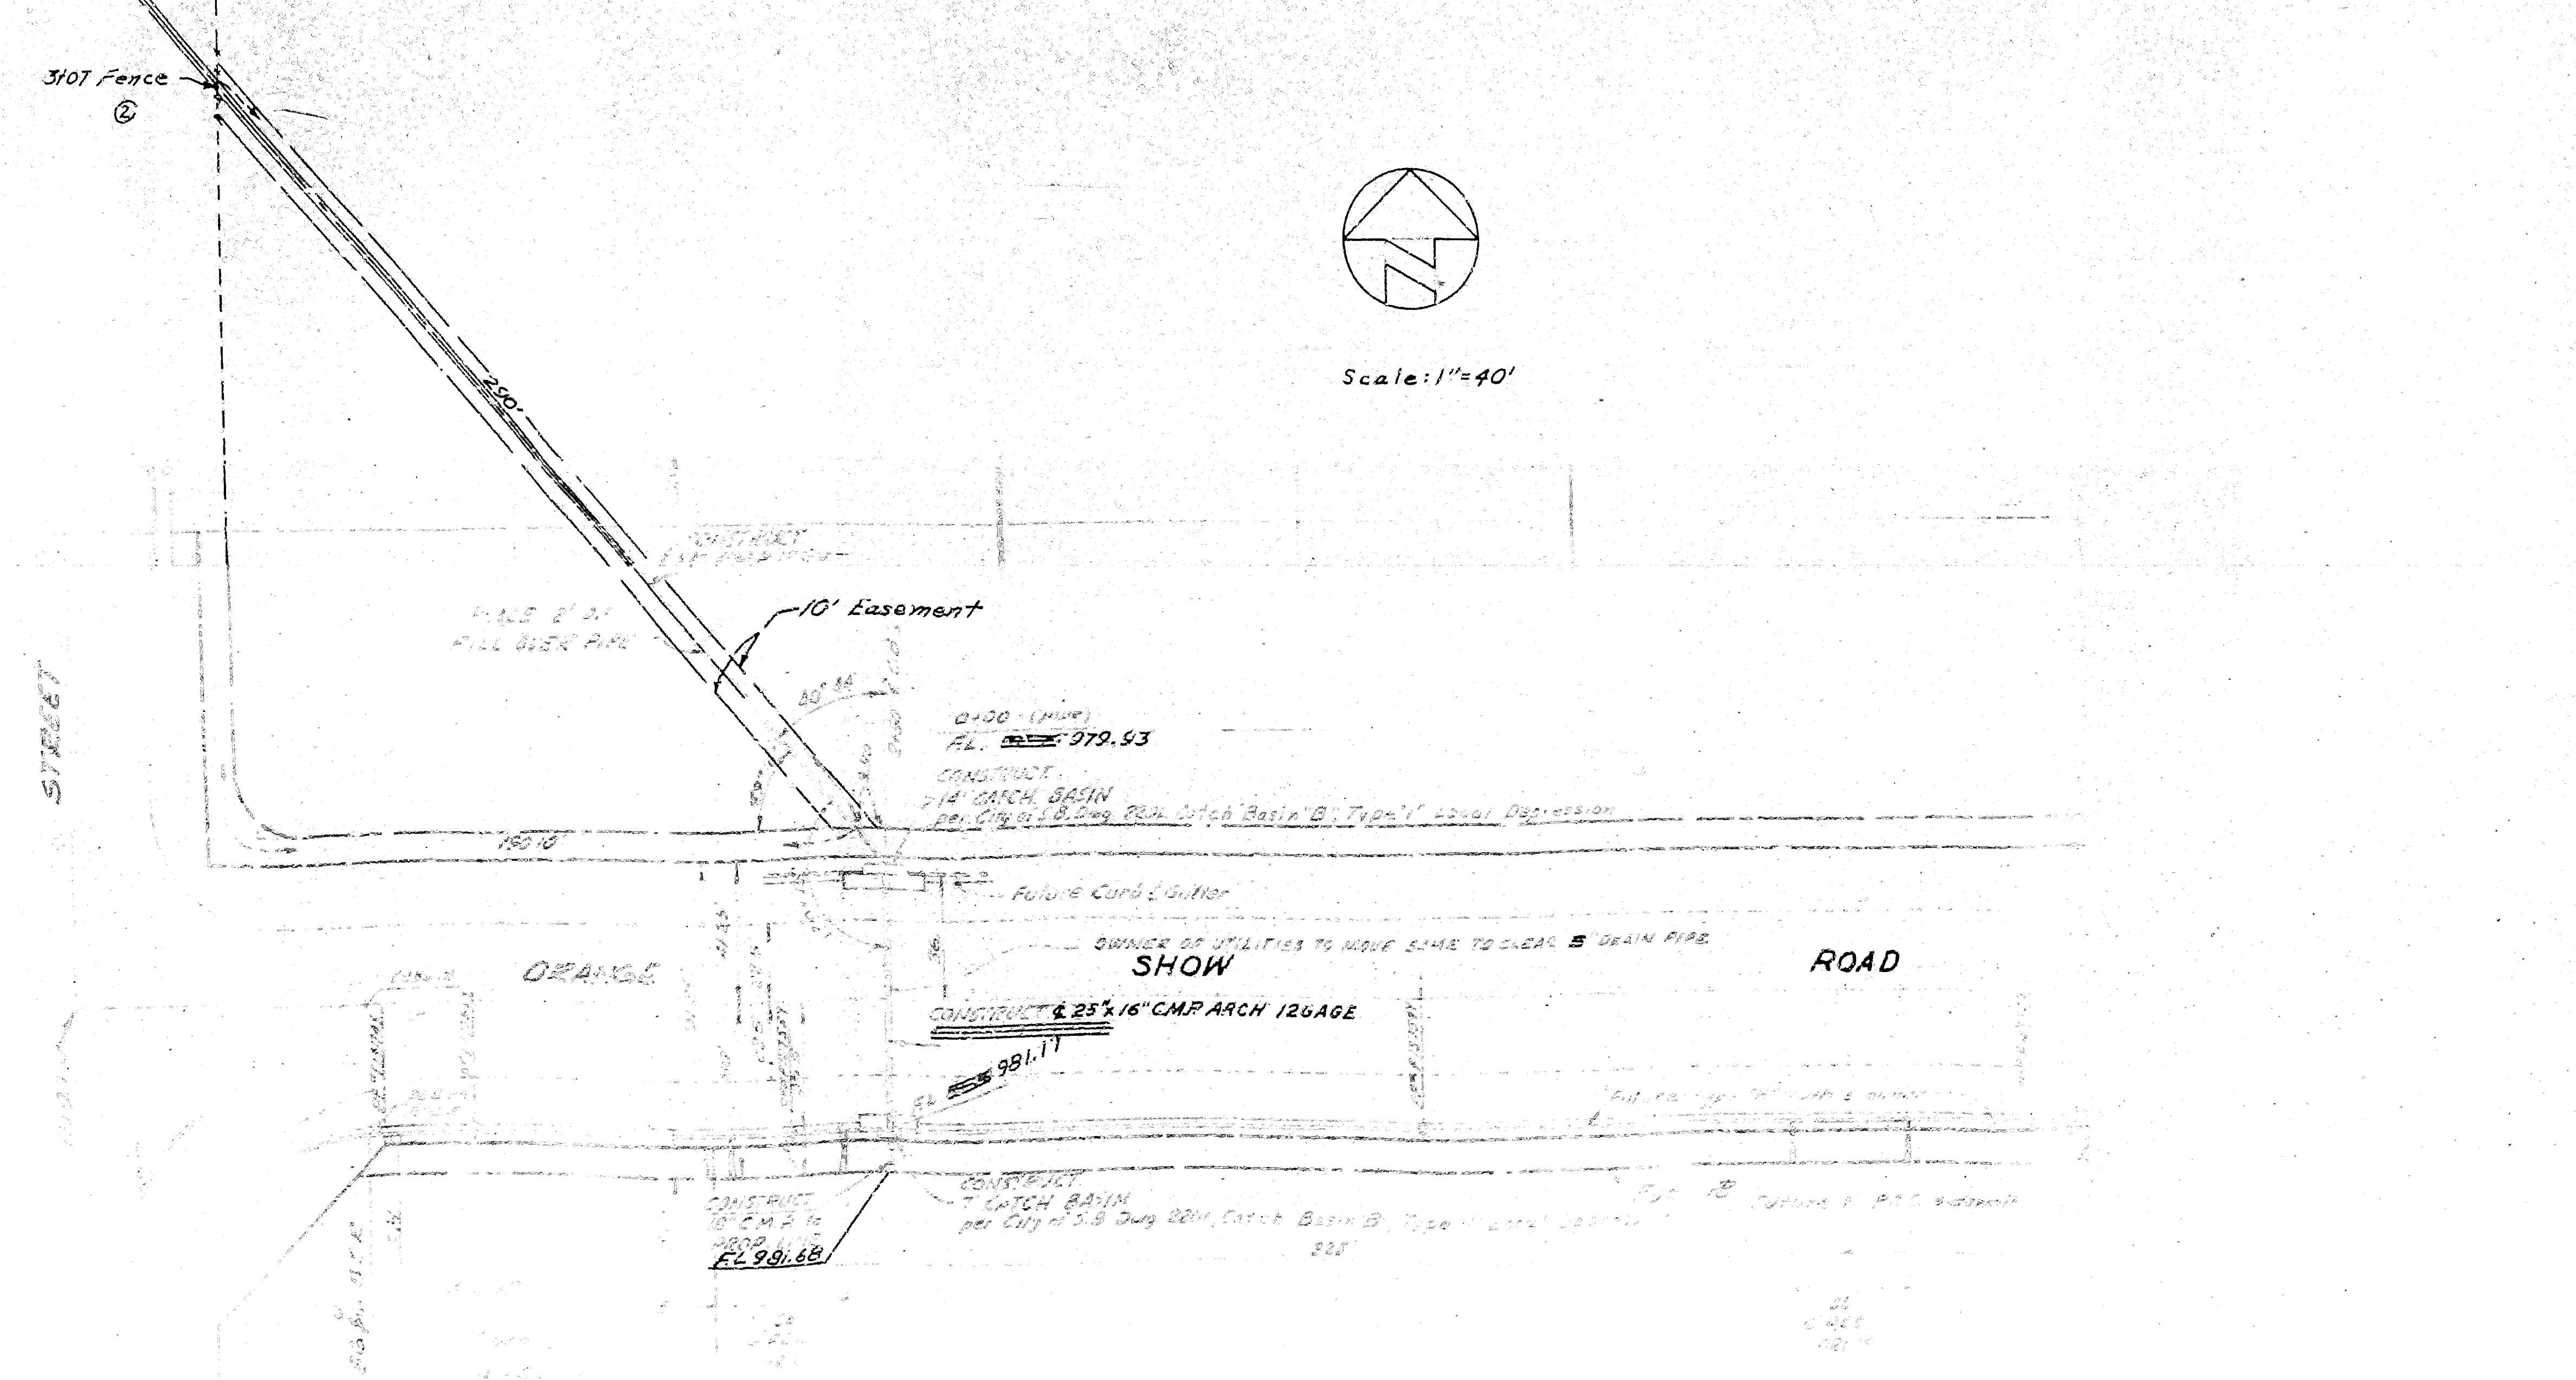
3+07 Fence
②
250'
10' Easement
0+00 (pipe)
FL 979.93
CONSTRUCT 14' CATCH BASIN per City of S.B. Dwg 2201 Catch Basin "B" Type "I" Local Depression
Future Curb & Gutter
OWNER OF UTILITIES TO MOVE SAME TO CLEAR DRAIN PIPE
STREET
ORANGE
SHOW
ROAD
CONSTRUCT 25"x16" CMP ARCH 12 GAGE
FL 981.17
CONSTRUCT 18" C.M.P. to PROP. LINE
FL 981.68
CONSTRUCT 7' CATCH BASIN per City of S.B. Dwg 2201 Catch Basin "B" Type "I" Local Depression

Scale: 1"=40'

GENERAL NOTES

1. All work embodied on these plans shall be done in conformity with applicable provisions of Standard Specifications No. 2271 and Standard Drawing No. 2201 on file in the office of the City Engineer.

2. Payment for all removals, earthwork and watering shall be included in prices paid for other contract items and no additional compensation will be allowed therefor

3. Obstructions (markings on plans) as directed by Engineer.
   1. To be removed under this contract.
   2. To be removed and relocated under this contract (footings on street signs shall be Class "B" concrete, same as orginal installation.)
   3. To be removed and relocated by others.
   4. To be removed and deposited on adjacent property.

4. Location of underground utilities as shown on these plans are not to be assumed as either exact or complete and the City assumes no responsibility for errors or omissions in showing such locations. The Contractor should verify or ascertain the location of all underground utilities and he must assume all liability for damages caused by his operations.

5. Corrugated Metal Pipe shall conform to the State of California, Division of Highways, Standard Specifications.

June 12 62
Robert A. M
Acting
10480
Del
2960

CITY OF SAN BERNARDINO

STORM DRAIN and CATCH BASINS

Orange Show Road and South E Street

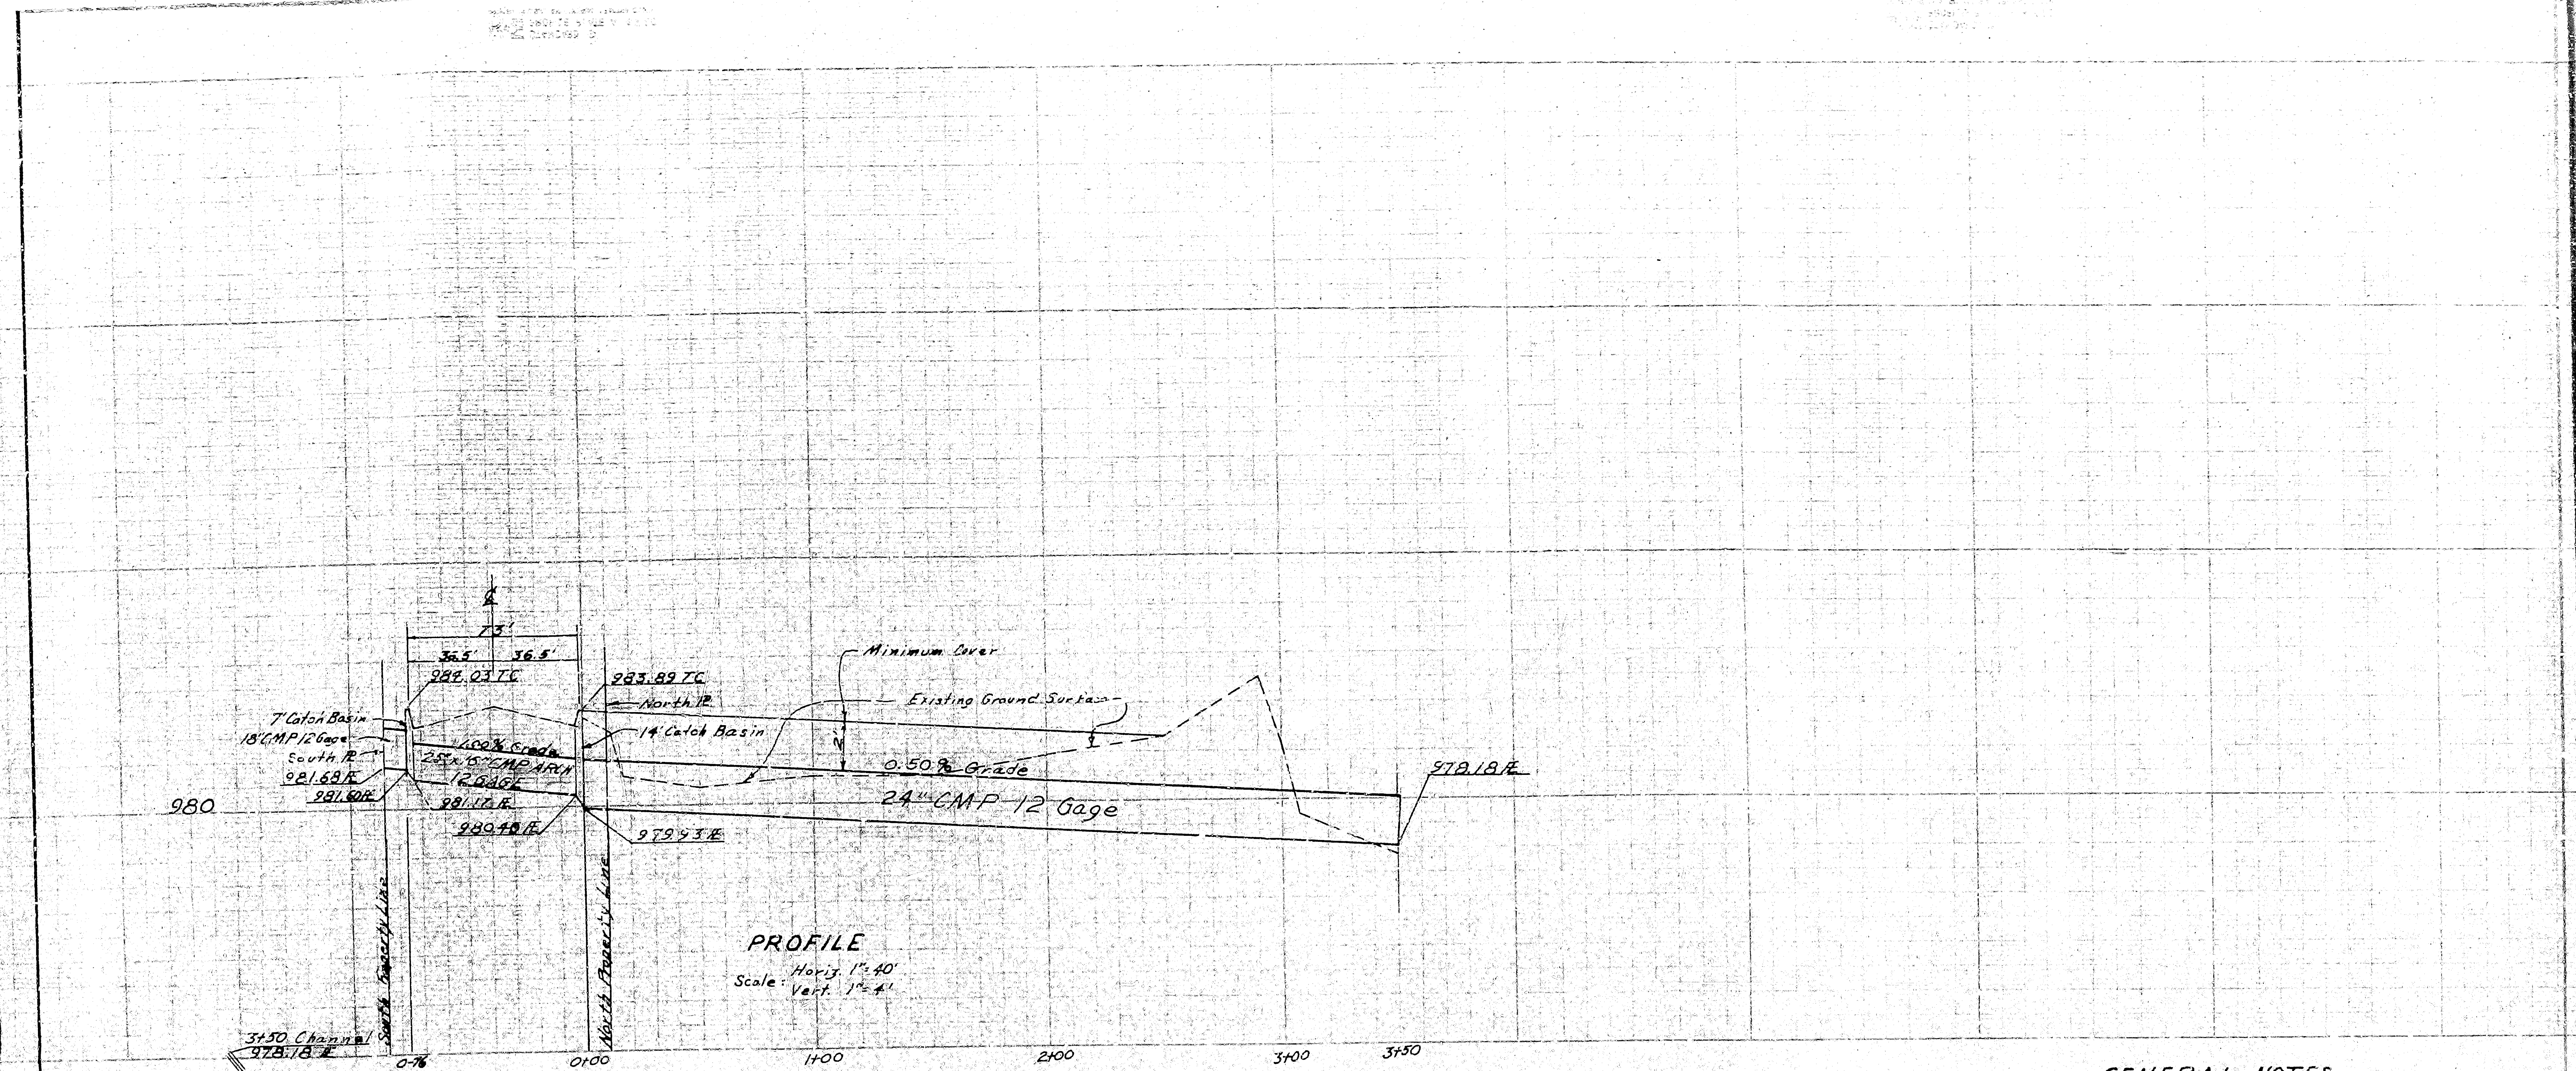
PROFILE

Scale: Horiz. 1"=40'
Vert. 1"=4'

℄
73'
36.5'
36.5'
984.03 TC
983.89 TC
North ℞
Minimum Cover
Existing Ground Surface
7' Catch Basin
18" CMP 12 Gage
South ℞
981.68 IE
981.60 IE
1.00% Grade
25"x16" CMP ARCH 12 GAGE
981.17 IE
980.40 IE
14' Catch Basin
0.50% Grade
24" CMP 12 Gage
979.93 IE
978.18 IE
980
South Property Line
North Property Line
3+50 Channel
978.18 IE
0-76
0+00
1+00
2+00
3+00
3+50

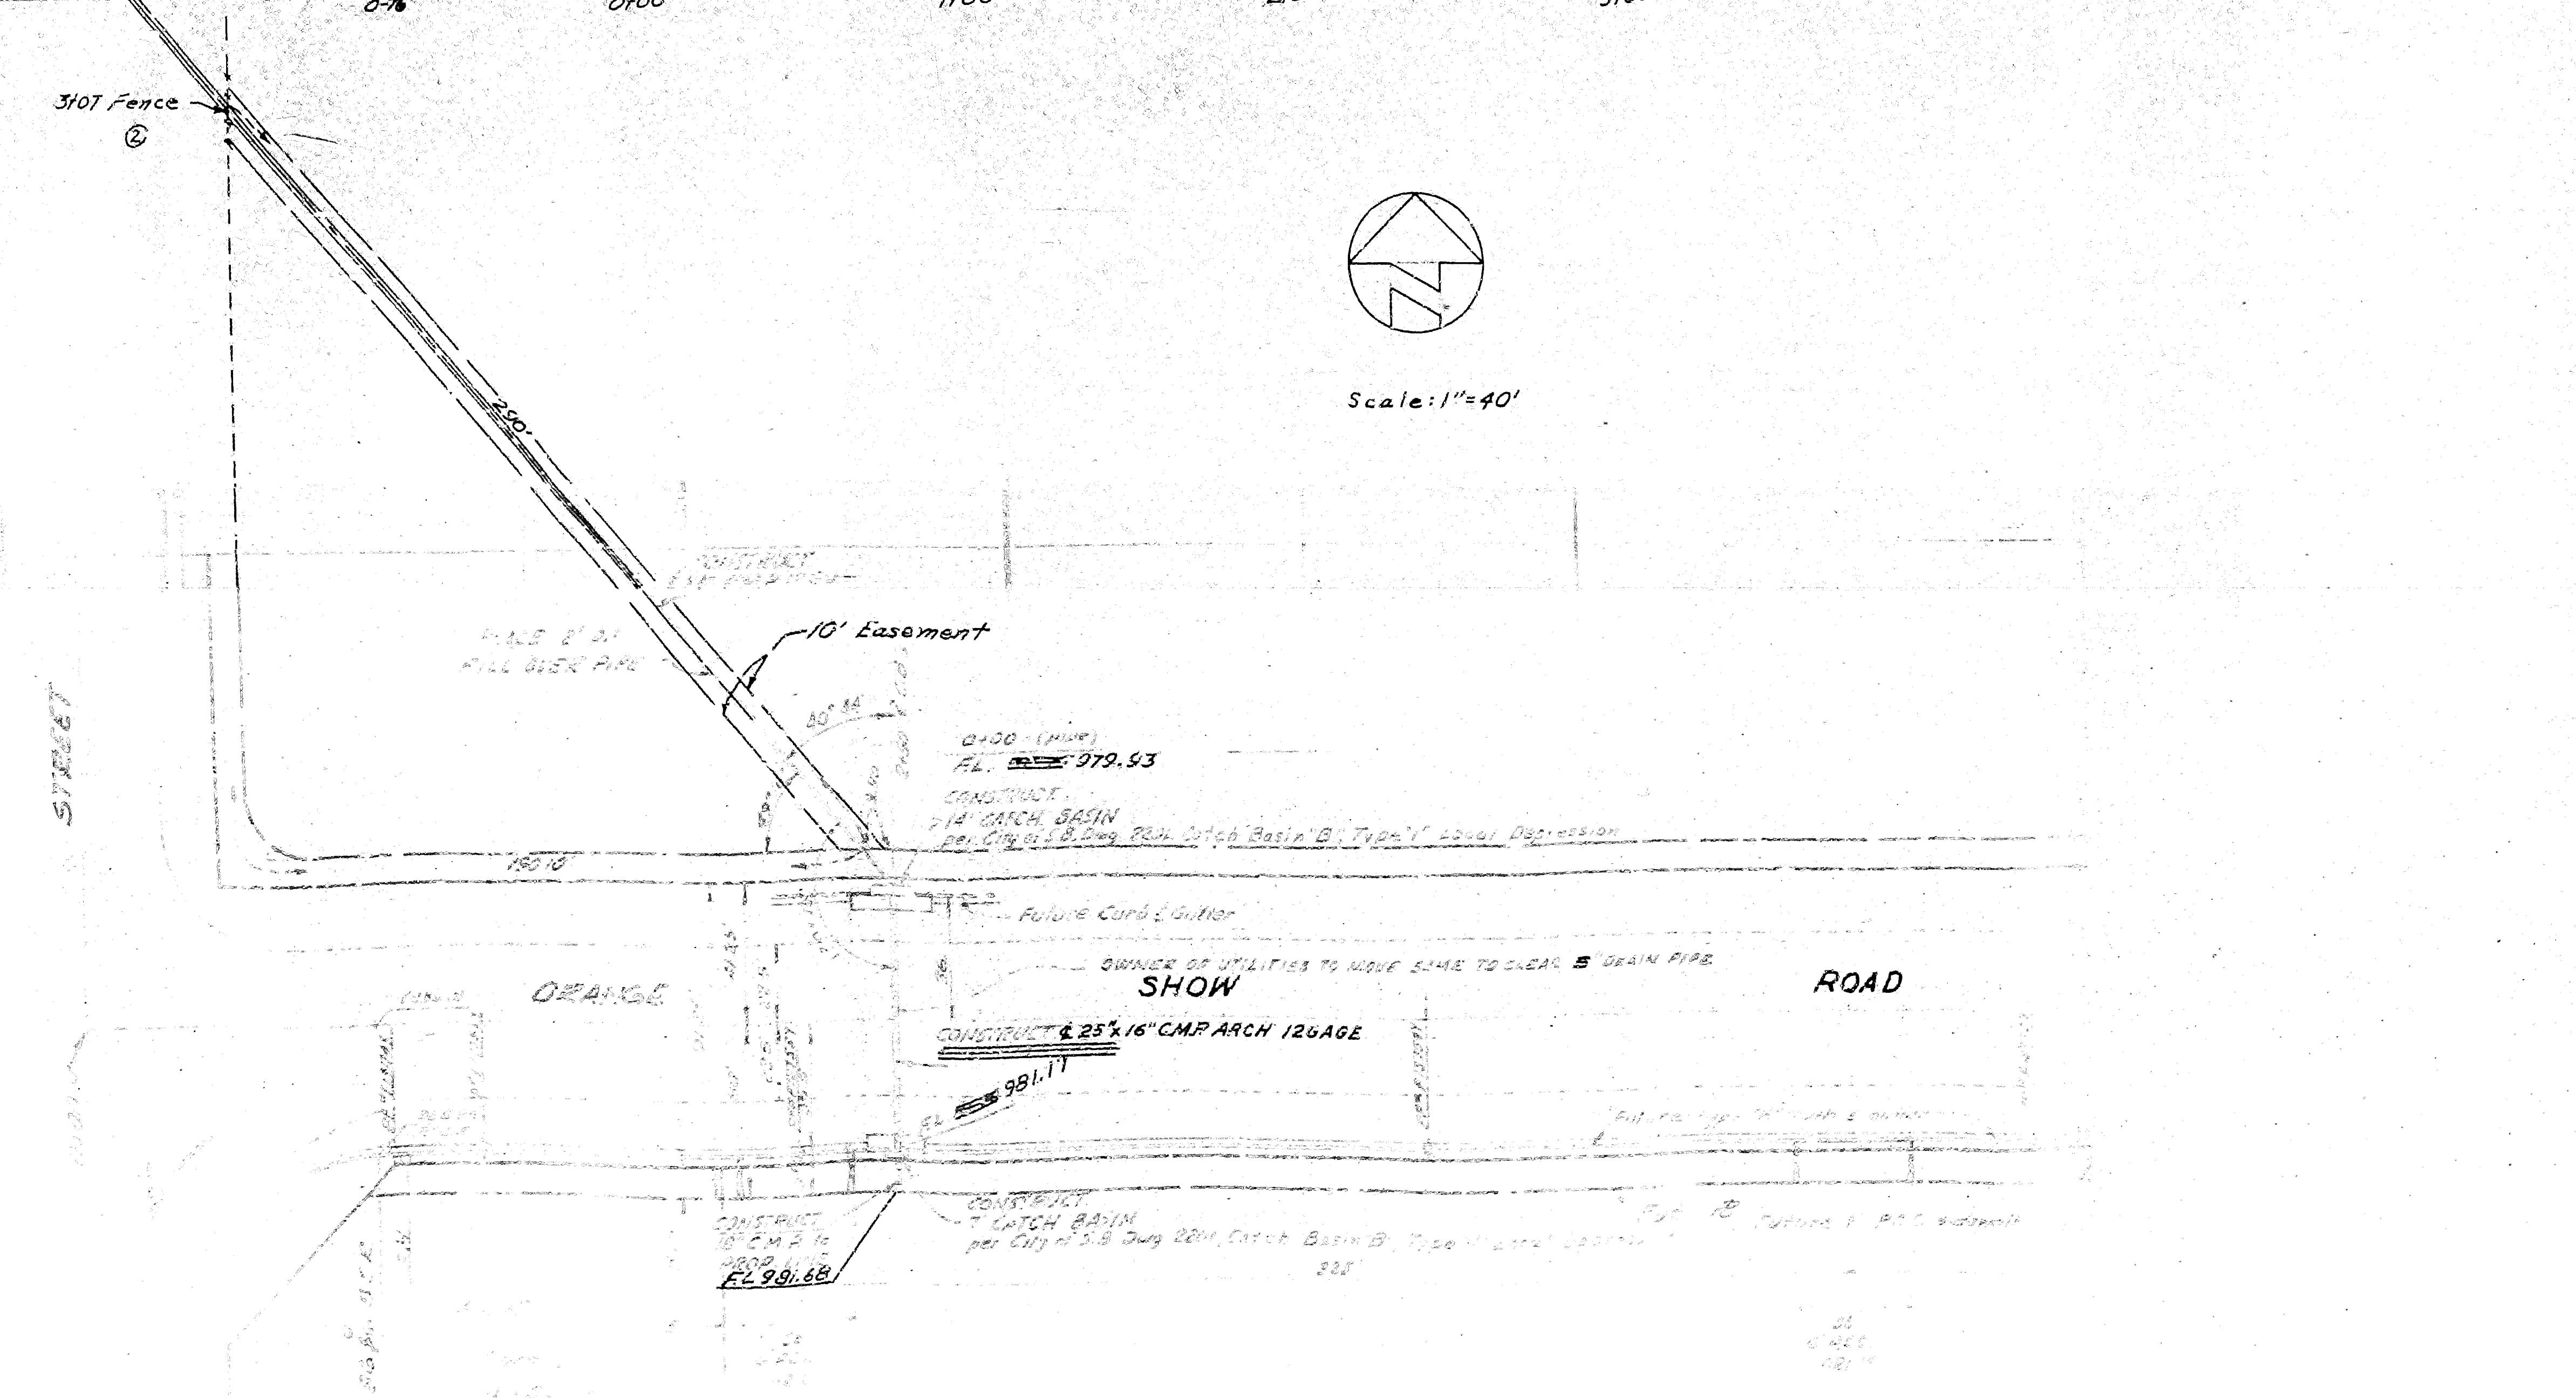
Scale: 1"=40'

3+07 Fence
②
290'
10' Easement
0+00 (pipe)
FL 979.93
CONSTRUCT
14' CATCH BASIN
per City of S.B. Dwg. 2214 Catch Basin "B" Type "I" Local Depression
Future Curb & Gutter
OWNER OF UTILITIES TO MOVE SAME TO CLEAR S. DRAIN PIPE
ORANGE
SHOW
ROAD
STREET
CONSTRUCT ℄ 25"x16" CMP ARCH 12 GAGE
FL 981.17
CONSTRUCT
7' CATCH BASIN
per City of S.B. Dwg. 2214 Catch Basin "B" Type "I" Local Depression
CONSTRUCT
18" CMP to PROP. LINE
FL 981.68

GENERAL NOTES

1. All work embodied on these plans shall be done in conformity with applicable provisions of Standard Specifications No. 2271 and Standard Drawing No. 2201 on file in the office of the City Engineer.

2. Payment for all removals, earthwork and watering shall be included in prices paid for other contract items and no additional compensation will be allowed therefor

3. Obstructions (markings on plans) as directed by Engineer.
    1. To be removed under this contract.
    2. To be removed and relocated under this contract (footings on street signs shall be Class "B" concrete, same as orginal installation.)
    3. To be removed and relocated by others.
    4. To be removed and deposited on adjacent property.

4. Location of underground utilities as shown on these plans are not to be assumed as either exact or complete and the City assumes no responsibility for errors or omissions in showing such locations. The Contractor should verify or ascertain the location of all underground utilities and he must assume all liability for damages caused by his operations.

5. Corrugated Metal Pipe shall conform to the State of California, Division of Highways, Standard Specifications.

June 12 62
Acting
10486
2960
Del

CITY OF SAN BERNARDINO

STORM DRAIN and CATCH BASINS

Orange Show Road and South E Street