72-235

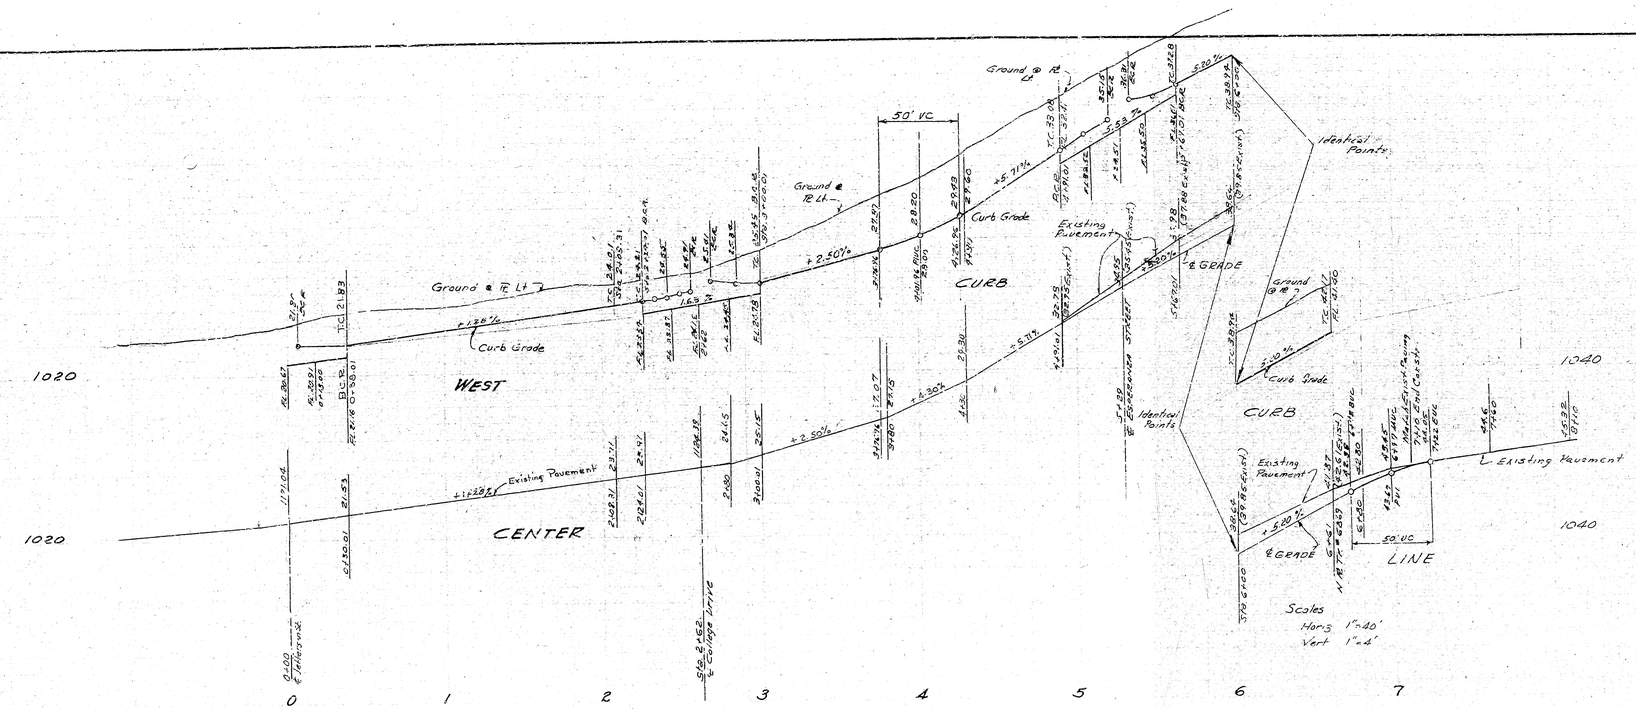

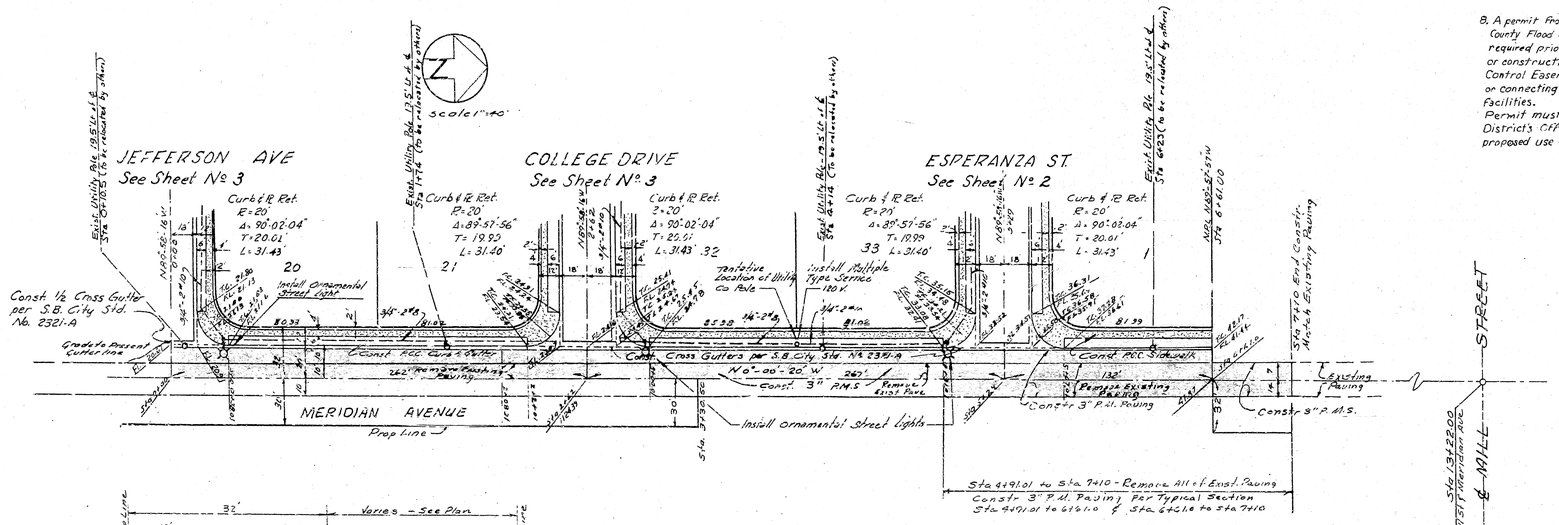

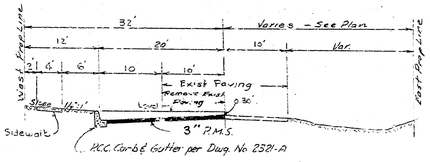

TYPICAL SECTION
Meridian Avenue
Sta 4+91.01 to Sta 4+71.01

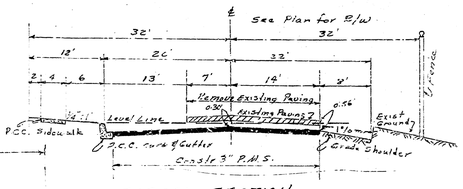

TYPICAL SECTION
MERIDIAN AVENUE
Sta 4+71.01 to Sta 6+61.00

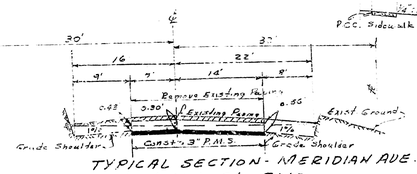

TYPICAL SECTION - MERIDIAN AVE.
Sta 6+61 to Sta 7+10

8. A permit from the San Bernardino County Flood Control District will be required prior to any encroachment or construction within any Flood Control Easement or Right-of-Way or connecting to any existing F.C.D. facilities.
Permit must be applied for at the District's Office 30 days prior to proposed use for actual work.

NOTES:

1.- All work embodied on these Plans shall be done in conformity with applicable provisions of Specifications No. 2371.

2- All standard cross sections of curb, gutter, pavement are as per City of San Berno Dept of Engineering Std Drawings No 21.

3- B.M. End of Curb N.E. corner Mill & Meridian Elev. 1040.46

4. Sufficient soil tests by recognized soil testing laboratory shall be required to determine the adequacy of the indicated street sections. If the results of these tests show the existing sub-grade to be inferior sufficient base material shall be placed to support the indicated surfacing and or the surfacing thickness shall be increased.

5 All irrigation lines within street right of way to be removed or encased with a minimum of 4" on top and sides.

6 Construct chain link fence ℄ high along the north and westerly lines of subdivision adjoining County Flood Control property as indicated by detail on Sheet 3.

7. Install Ornamental Street lighting System conforming to Ordinance #1948.

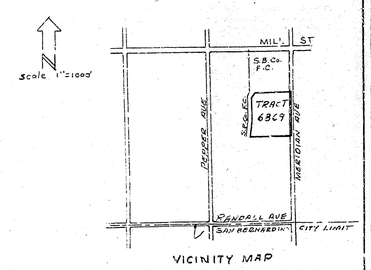

VICINITY MAP

AS BUILT REVISIONS					
REV.	BY	DESCRIPTION	APPROVED	DATE
1	1/30/64 R. Stone	BELDEN ST. (Street Grade) Sta 0+00 to Sta 7+15	R.J. Hecker	1-29-64
2	R. Stone	ESPERANZA ST. (Street Grade) Sta 0+00 to Sta 0+28.82	R.J. Hecker	1-29-64
3	R. Stone	COLLEGE DRIVE (Street Grade) Sta 0+00 to Sta 2+05	R.J. Hecker	1-29-64
4	R. Stone	JEFFERSON AVE (Street Grade) Sta 0+00 to Sta 2+02	R.J. Hecker	1-29-64
5	M. Villian	Add Flood Control Note #8	R.J. Hecker	4-9-64
6	R. Stone	MERIDIAN AVENUE - ℄ GRADE Sta 4+91.01 to Sta 7+10	R.J. Hecker	3-7-64

Ralph L. Stone R.C.E. No. 12620
DEPARTMENT OF ENGINEERING
CITY OF SAN BERNARDINO

STREET IMPROVEMENT PLANS
TRACT No 6869

SUBMITTED BY JOHNSON & STONE
APPROVED January 9 64
R.J. Hecker A.C.G.
REGISTERED ENGINEER 13613
DRAWING 3037
SHEET 1 OF 3

72-235

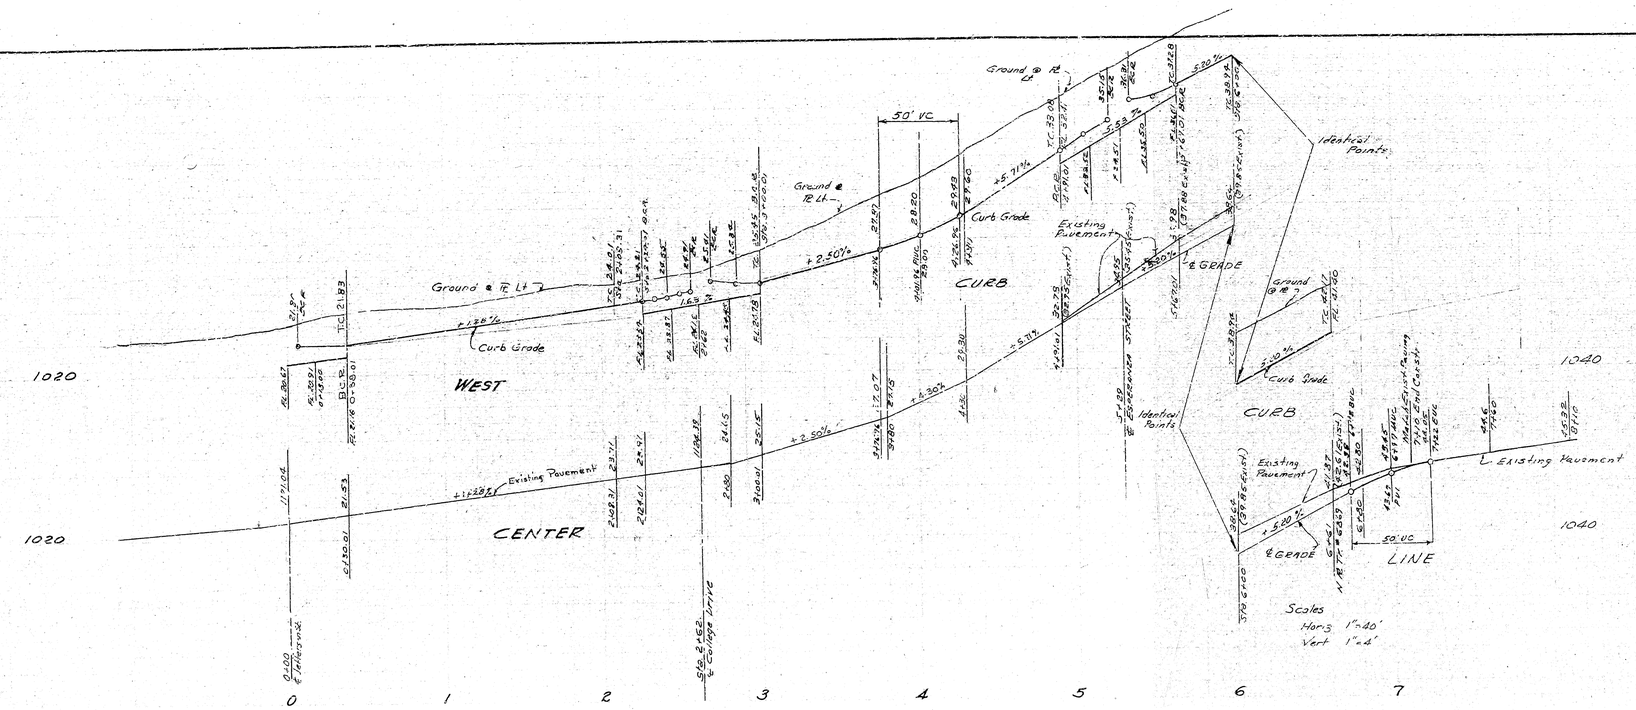

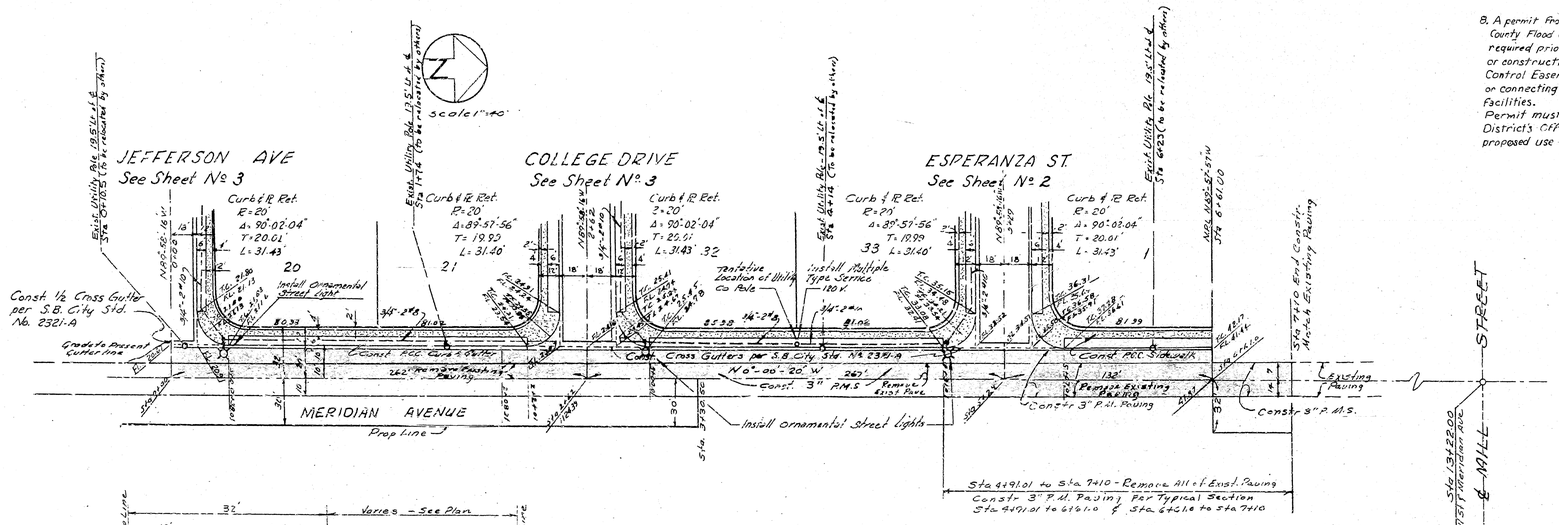

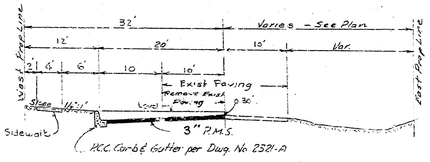

TYPICAL SECTION
Meridian Avenue
Sta 4+91.01 to Sta 4+71.01

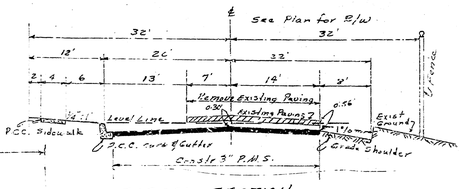

TYPICAL SECTION
MERIDIAN AVENUE
Sta 4+71.01 to Sta 6+61.00

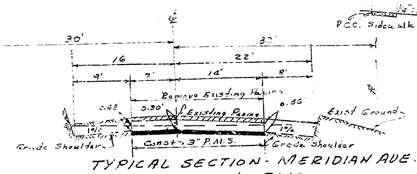

TYPICAL SECTION - MERIDIAN AVE.
Sta 6+61 to Sta 7+10

8. A permit from the San Bernardino County Flood Control District will be required prior to any encroachment or construction within any Flood Control Easement or Right-of-Way or connecting to any existing F.C.D. facilities.
Permit must be applied for at the District's Office 30 days prior to proposed use for actual work.

NOTES:

1.- All work embodied on these Plans shall be done in conformity with applicable provisions of Specifications No. 2371.

2- All standard cross sections of curb, gutter, pavement are as per City of San Berno Dept of Engineering Std Drawings No 21.

3- B.M. End of Curb N.E. corner Mill & Meridian Elev. 1040.46

4. Sufficient soil tests by recognized soil testing laboratory shall be required to determine the adequacy of the indicated street sections. If the results of these tests show the existing sub-grade to be inferior sufficient base material shall be placed to support the indicated surfacing and or the surfacing thickness shall be increased.

5 All irrigation lines within street right of way to be removed or encased with a minimum of 4" on top and sides.

6 Construct chain link fence ℄ high along the north and westerly lines of subdivision adjoining County Flood Control property as indicated by detail on Sheet 3.

7. Install Ornamental Street lighting System conforming to Ordinance #1948.

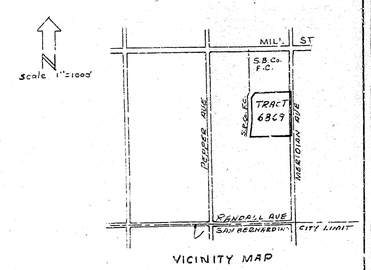

VICINITY MAP

AS BUILT REVISIONS					
REV.	BY	DESCRIPTION	APPROVED	DATE
1	1/30/64 R. Stone	BELDEN ST. (Street Grade) Sta 0+00 to Sta 7+15	R.J. Hecker	1-29-64
2	R. Stone	ESPERANZA ST. (Street Grade) Sta 0+00 to Sta 0+28.82	R.J. Hecker	1-29-64
3	R. Stone	COLLEGE DRIVE (Street Grade) Sta 0+00 to Sta 2+05	R.J. Hecker	1-29-64
4	R. Stone	JEFFERSON AVE (Street Grade) Sta 0+00 to Sta 2+02	R.J. Hecker	1-29-64
5	M. Villian	Add Flood Control Note #8	R.J. Hecker	4-9-64
6	R. Stone	MERIDIAN AVENUE - ℄ GRADE Sta 4+91.01 to Sta 7+10	R.J. Hecker	3-7-64

Ralph L. Stone R.C.E. No. 12620
DEPARTMENT OF ENGINEERING
CITY OF SAN BERNARDINO

STREET IMPROVEMENT PLANS
TRACT No 6869

SUBMITTED BY JOHNSON & STONE
APPROVED January 9 64
R.J. Hecker A.C.G.
REGISTERED ENGINEER 13613
DRAWING 3037
SHEET 1 OF 3