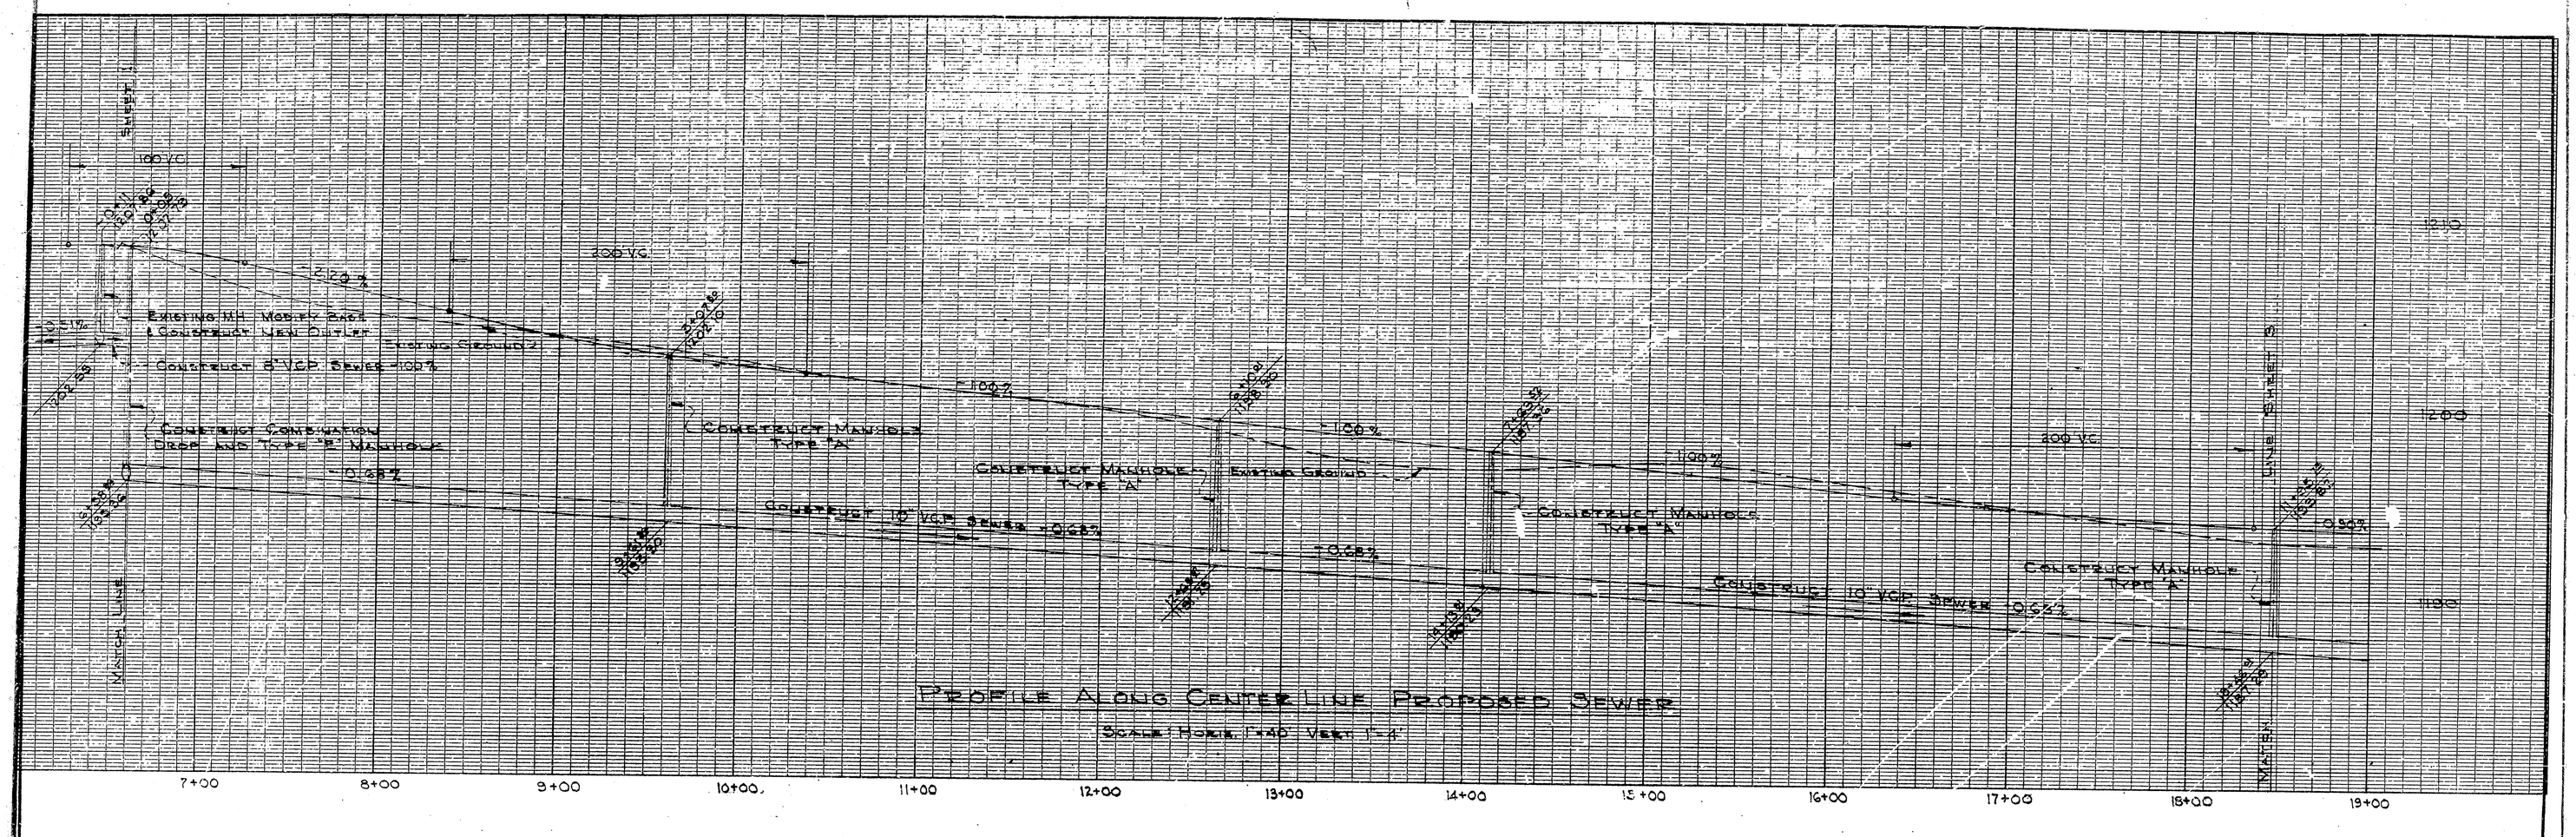

"AS-BUILT"		TRG	7/27/66
REVISION		APPROVED	DATE
DRAWING No. 3429	APPROVED April 7, 1966		
SHEET 2 of 5	CITY ENGINEER 13653 RCE.		
5 SHEETS	CITY OF SAN BERNARDINO		

SOUTHERN PACIFIC COMPANY
PACIFIC LINES

PALMDALE - COLTON CUT OFF
SEWER LINE CONSTRUCTION BETWEEN
TERRACE ROAD & RIALTO AVENUE
SCALE: AS SHOWN JANUARY 12, 1966
REV. FEB. 21, 1966
REV. MARCH 24, 1966

C.E.
DWG. 34657
SH. NO. 2

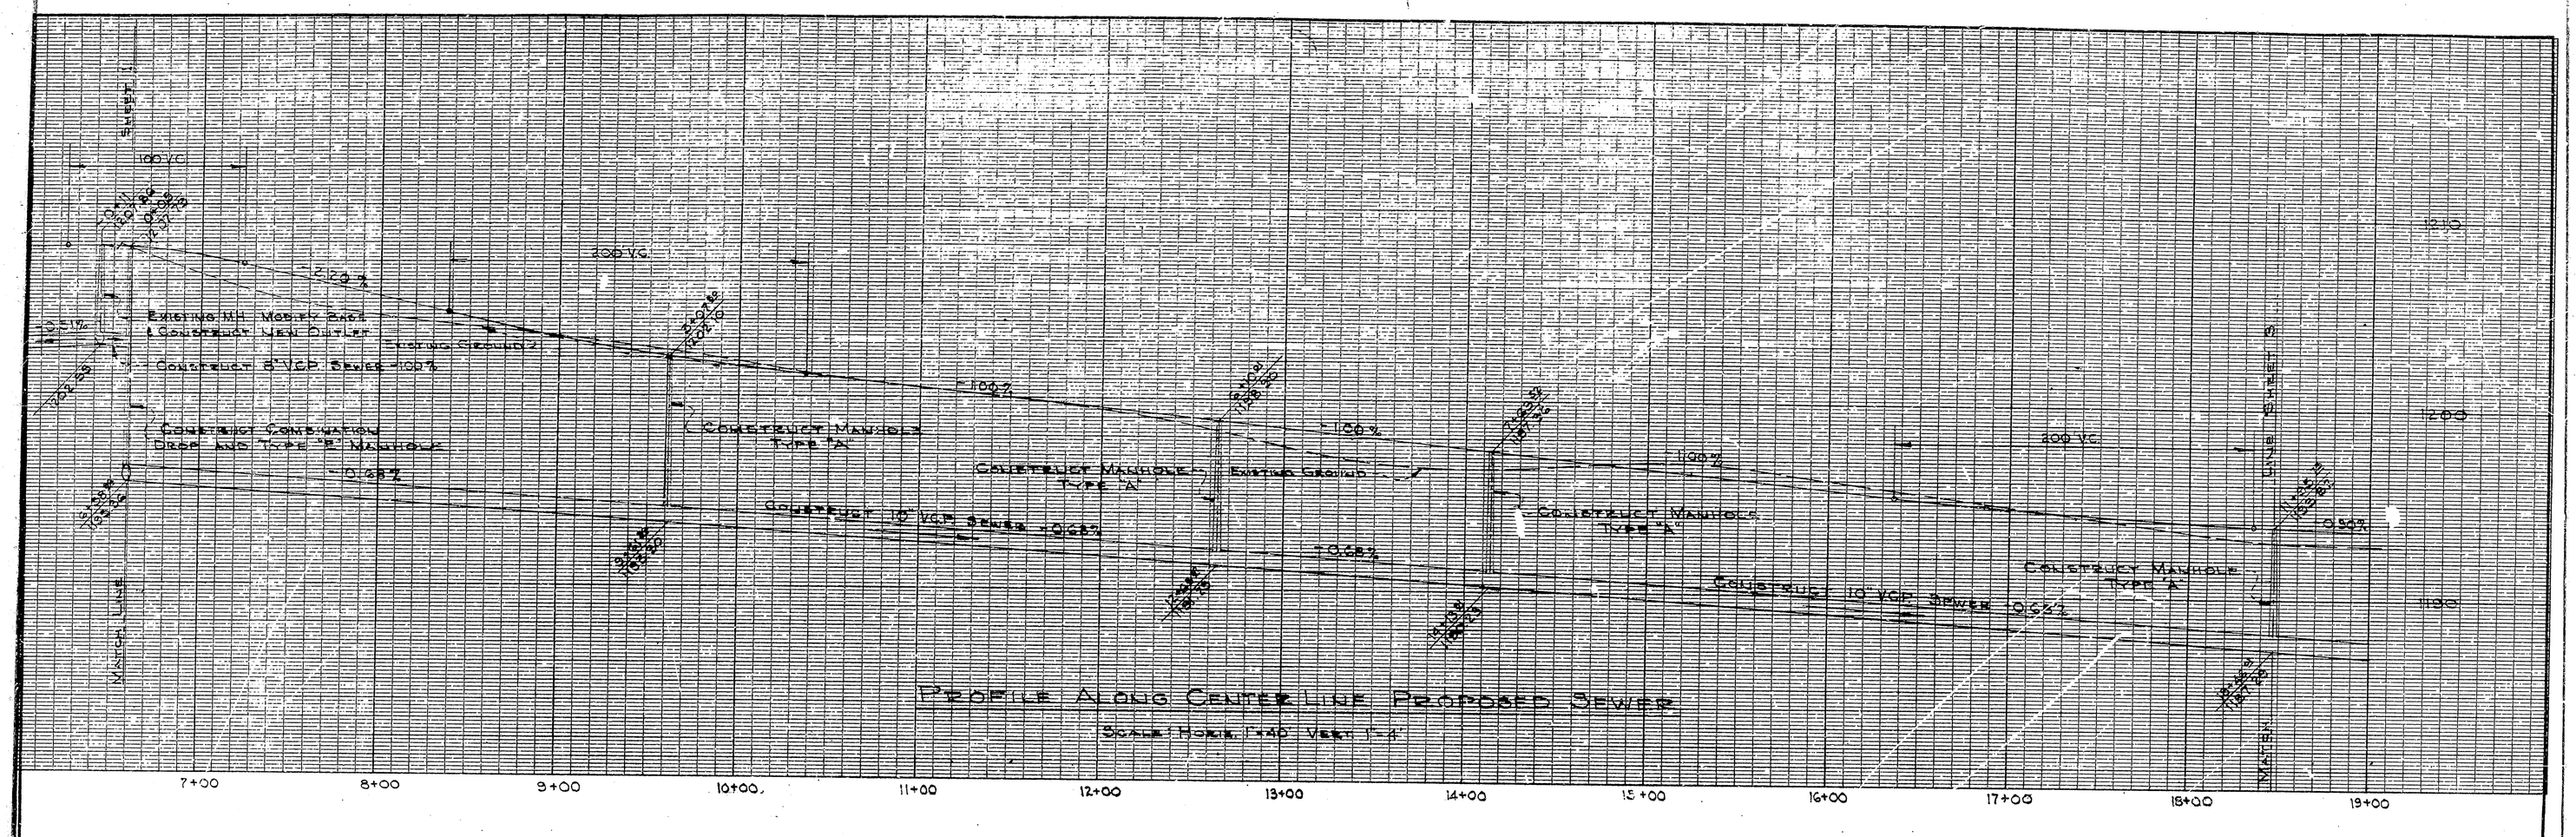

"AS-BUILT"		TRG	7/27/66
REVISION		APPROVED	DATE
DRAWING No. 3429	APPROVED April 7, 1966		
SHEET 2 of 5	CITY ENGINEER 13653 RCE.		
5 SHEETS	CITY OF SAN BERNARDINO		

SOUTHERN PACIFIC COMPANY
PACIFIC LINES

PALMDALE - COLTON CUT OFF
SEWER LINE CONSTRUCTION BETWEEN
TERRACE ROAD & RIALTO AVENUE
SCALE: AS SHOWN JANUARY 12, 1966
REV. FEB. 21, 1966
REV. MARCH 24, 1966

C.E.
DWG. 34657
SH. NO. 2

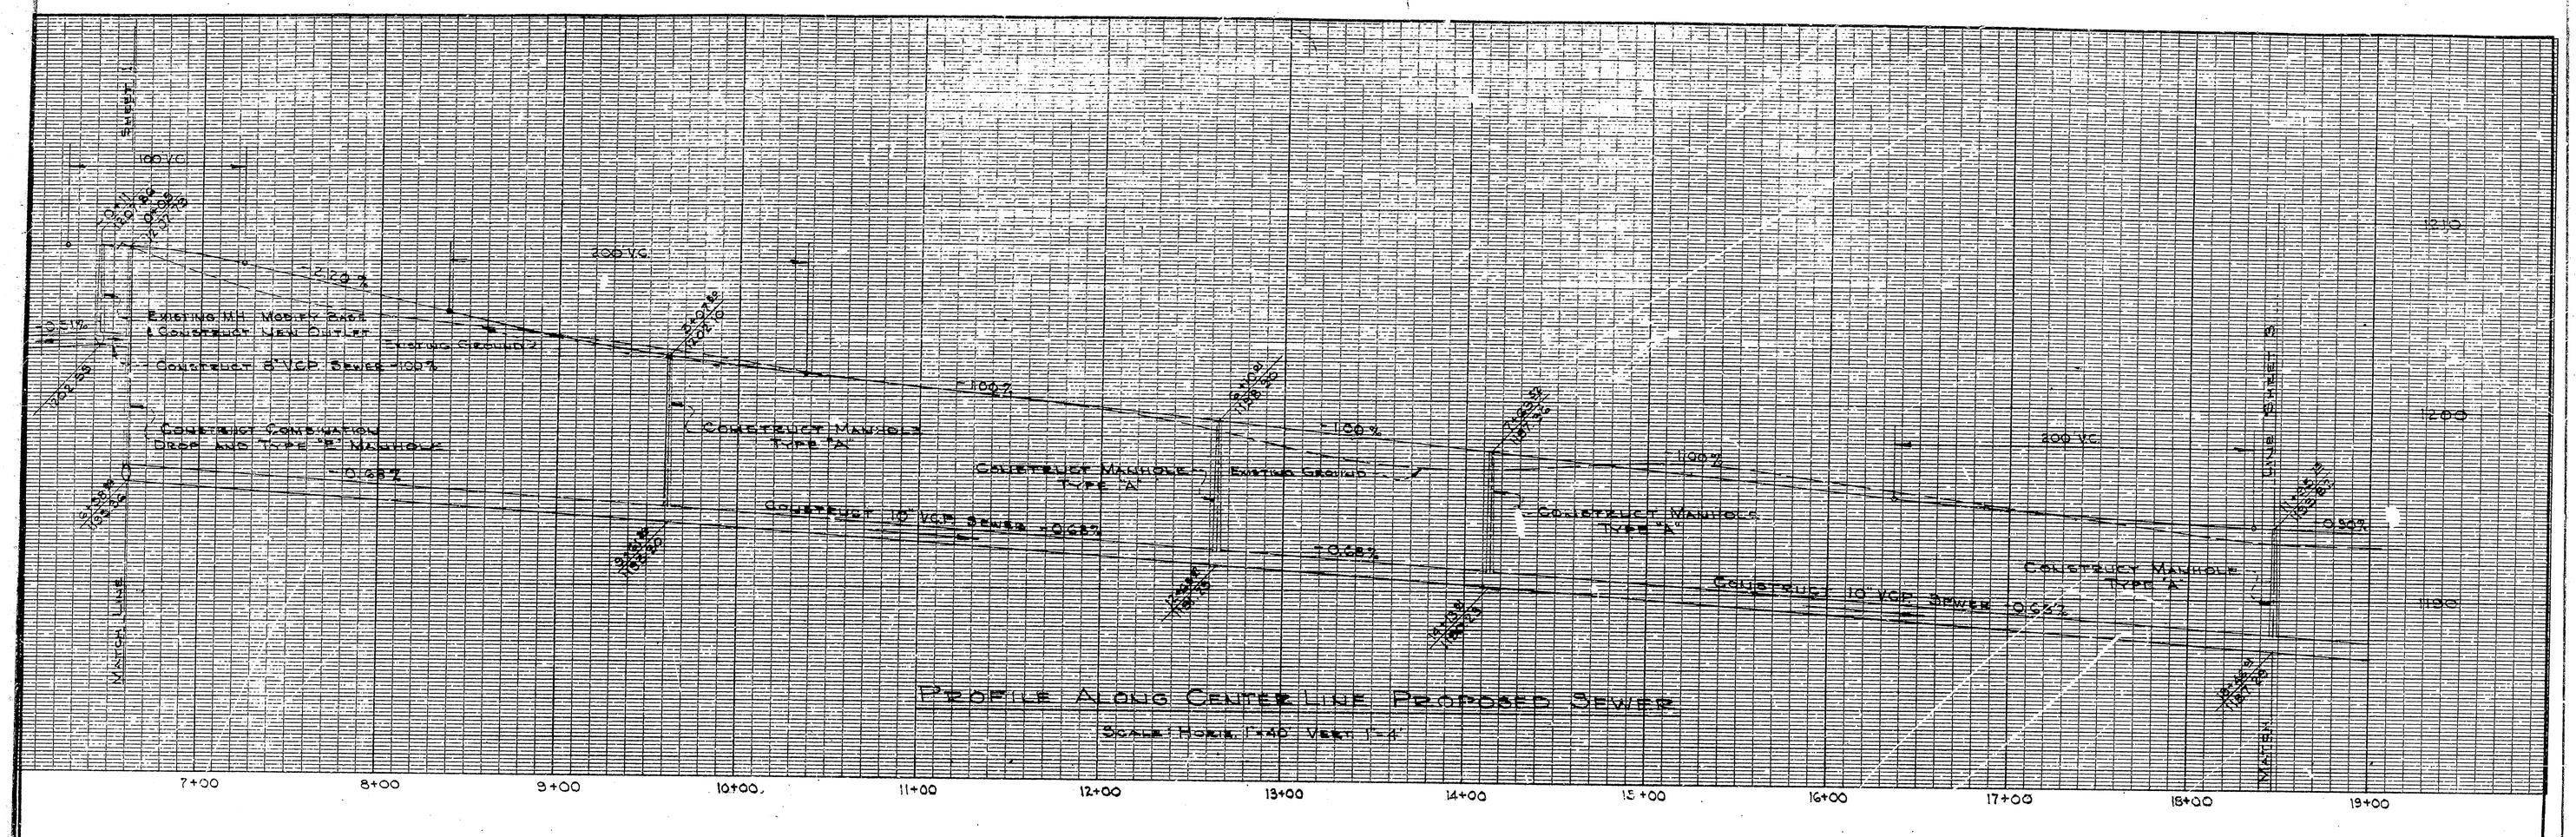

"AS-BUILT"		TRG	7/27/66
REVISION		APPROVED	DATE
DRAWING No. 3429	APPROVED April 7, 1966		
SHEET 2 of 5	CITY ENGINEER 13653 RCE.		
5 SHEETS	CITY OF SAN BERNARDINO		

SOUTHERN PACIFIC COMPANY
PACIFIC LINES

PALMDALE - COLTON CUT OFF
SEWER LINE CONSTRUCTION BETWEEN
TERRACE ROAD & RIALTO AVENUE
SCALE: AS SHOWN JANUARY 12, 1966
REV. FEB. 21, 1966
REV. MARCH 24, 1966

C.E.
DWG. 34657
SH. NO. 2