SHEET-No 10
PART-No 1
PLAN No 785
FOR
OUTFALL SEWER
ALONG
COLTON AVENUE
AND
ACROSS LOTS 4-5 BLOCK 29 R.S.B.
BETWEEN
POINTS SHOWN HEREON
IN THE CITY OF
SAN BERNARDINO CALIFORNIA
JAN 1928
C.E. Johnson
City Engineer
Scale as Shown

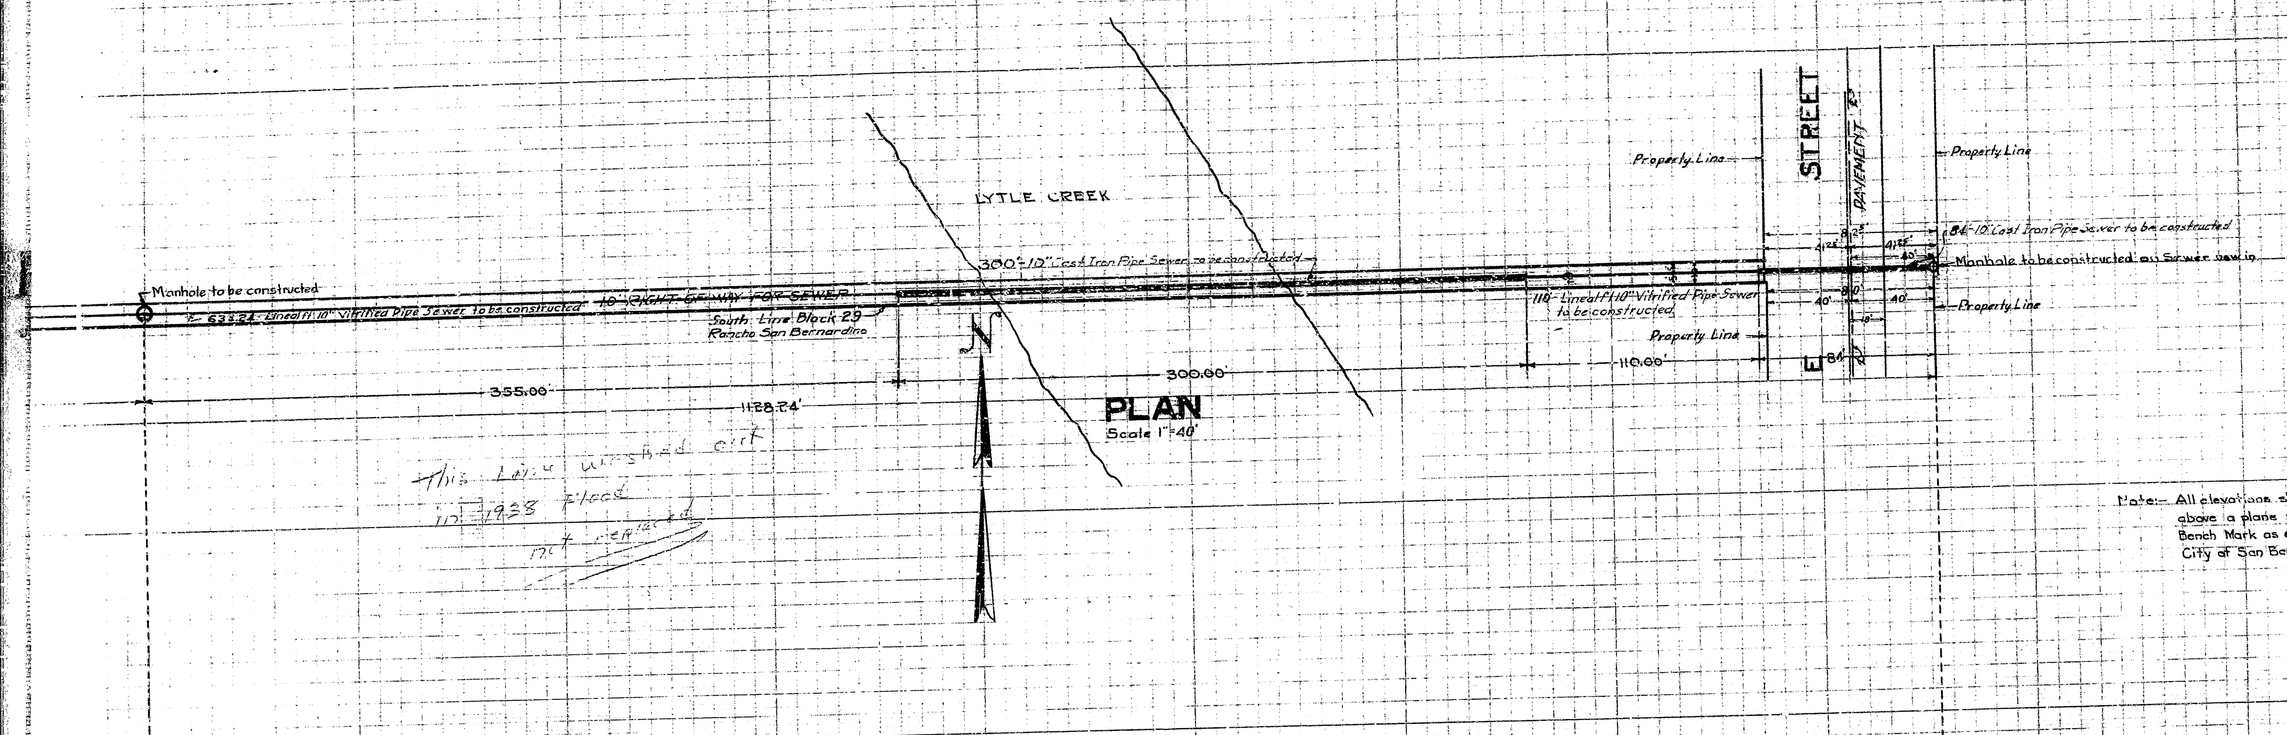

This Land washed out in 1938 flood not restored

Note:- All elevations shown in red ink are in feet and are above a plane which is 1045.86 feet below the City Bench Mark as established by Ordinance No. 383 of City of San Bernardino, California.

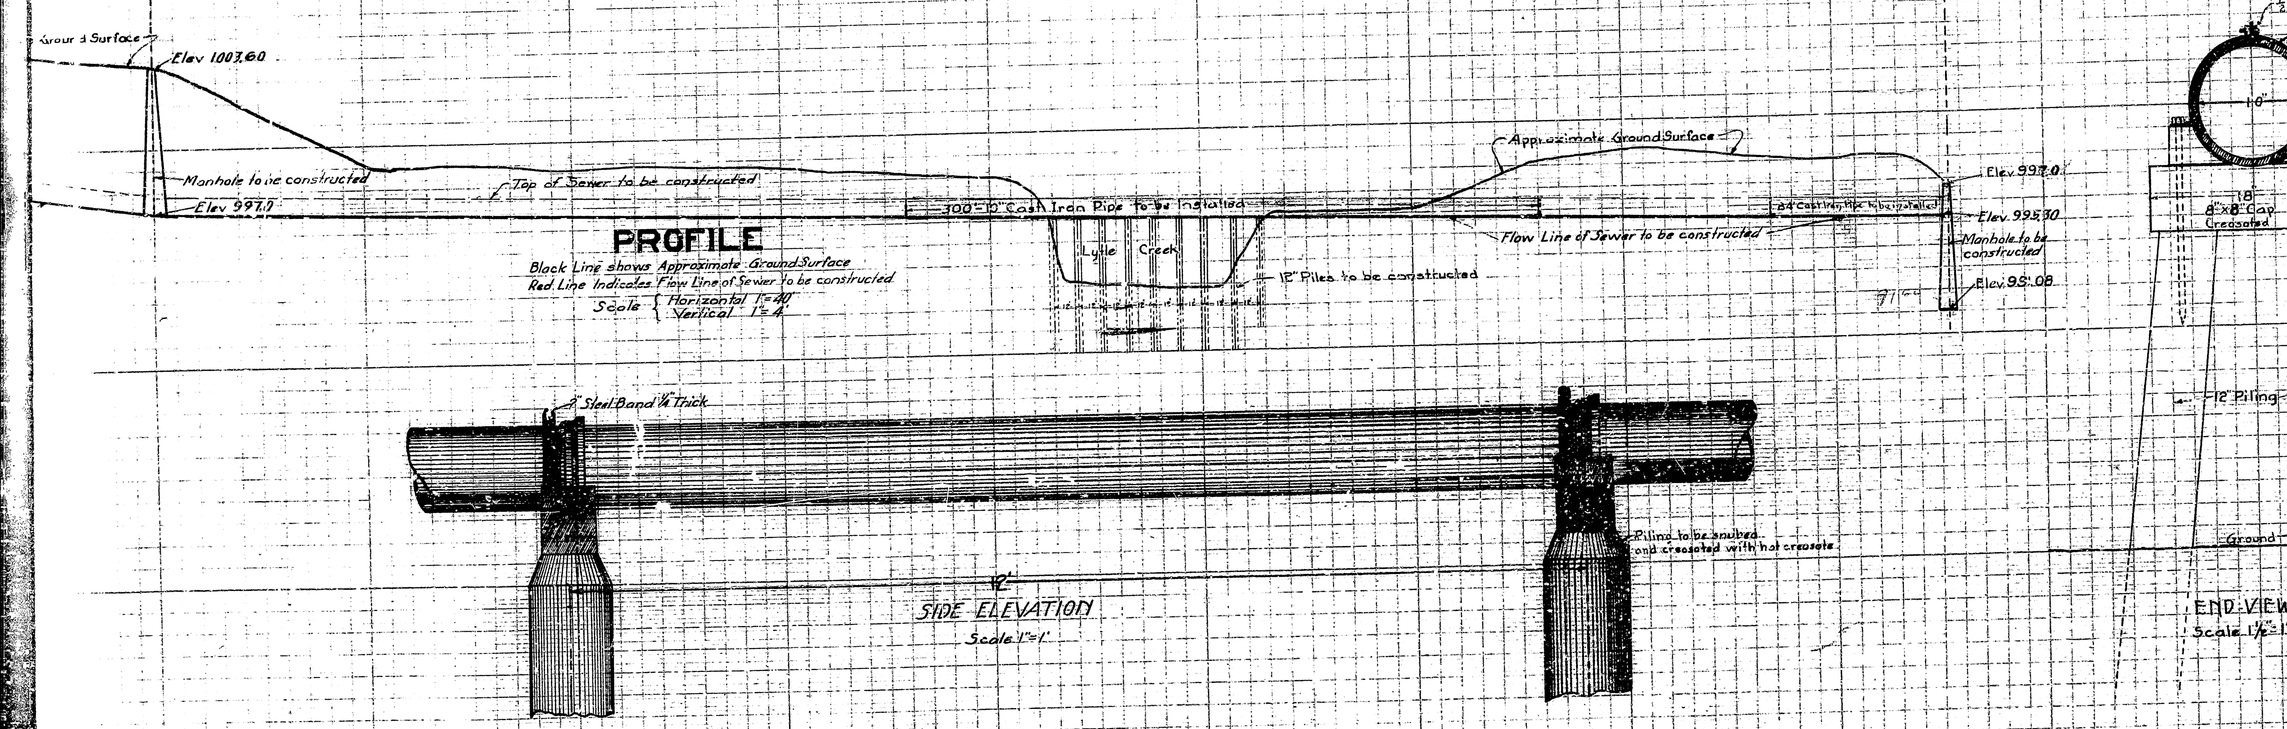

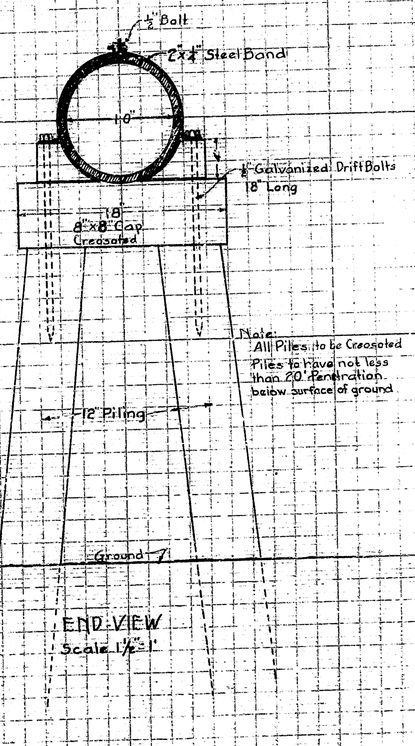

LEGEND

" or in means inch or inches
' or ft means foot or feet
Ave means Avenue
R.S.B. means Rancho San Bernardino
Elev means Elevation
℄ means Center Line
10" Vitrified Pipe Sewer to be constructed shown thus
10" Cast Iron Pipe Sewer to be constructed shown thus
Manholes to be constructed shown thus ○

DETAIL OF SEWER SHEET NO. 10

Lineal ft 10" Vitrified Pipe Sewer to be constructed	1535.48
Lineal ft 10" Cast Iron Pipe Sewer to be constructed	355.00
No of Manholes to be constructed	3
Lineal ft Pile Trestle to be constructed	96

Title to COLTON AVE shown on Sheet No 1 of this plan

Grade Ordinance Shown on Sheet No 1 of this plan

Sheet No. 10 of 18 Sheets

SHEET-No 10
PART-No 1
PLAN No 785
FOR
OUTFALL SEWER
ALONG
COLTON AVENUE
AND
ACROSS LOTS 4-5 BLOCK 29 R.S.B.
BETWEEN
POINTS SHOWN HEREON
IN THE CITY OF
SAN BERNARDINO CALIFORNIA
JAN 1928
C.E. Johnson
City Engineer
Scale as Shown

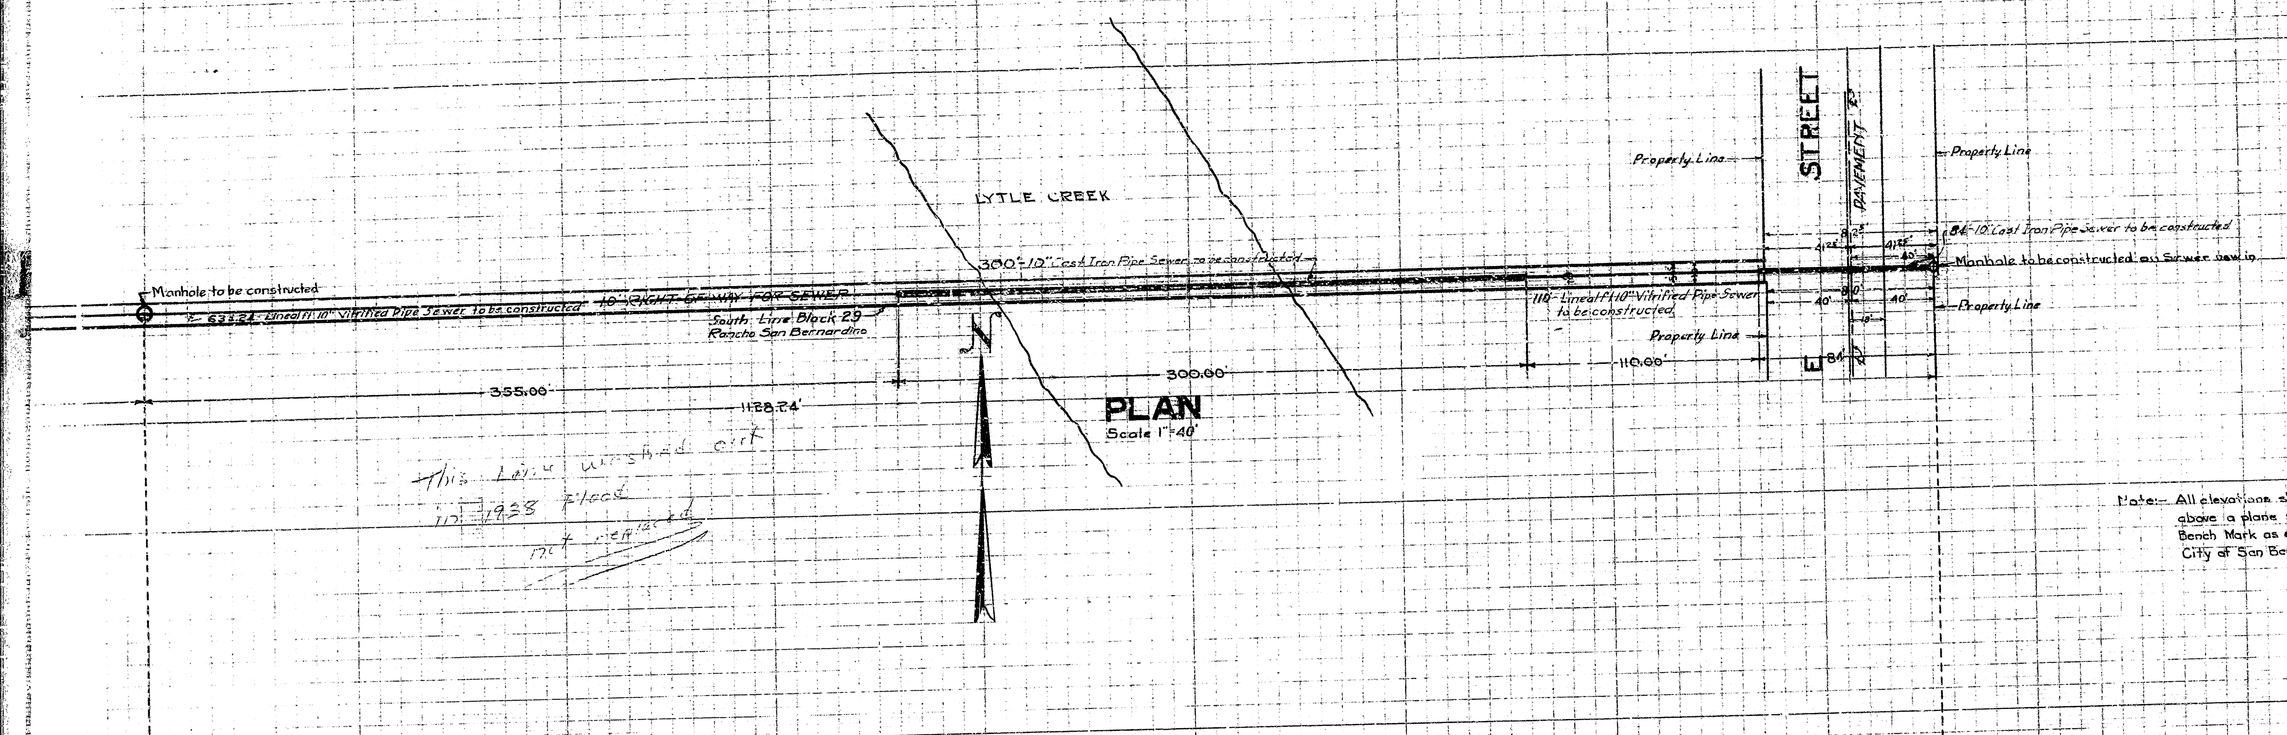

This Land washed out in 1938 flood not restored

Note:- All elevations shown in red ink are in feet and are above a plane which is 1045.86 feet below the City Bench Mark as established by Ordinance No. 383 of City of San Bernardino, California.

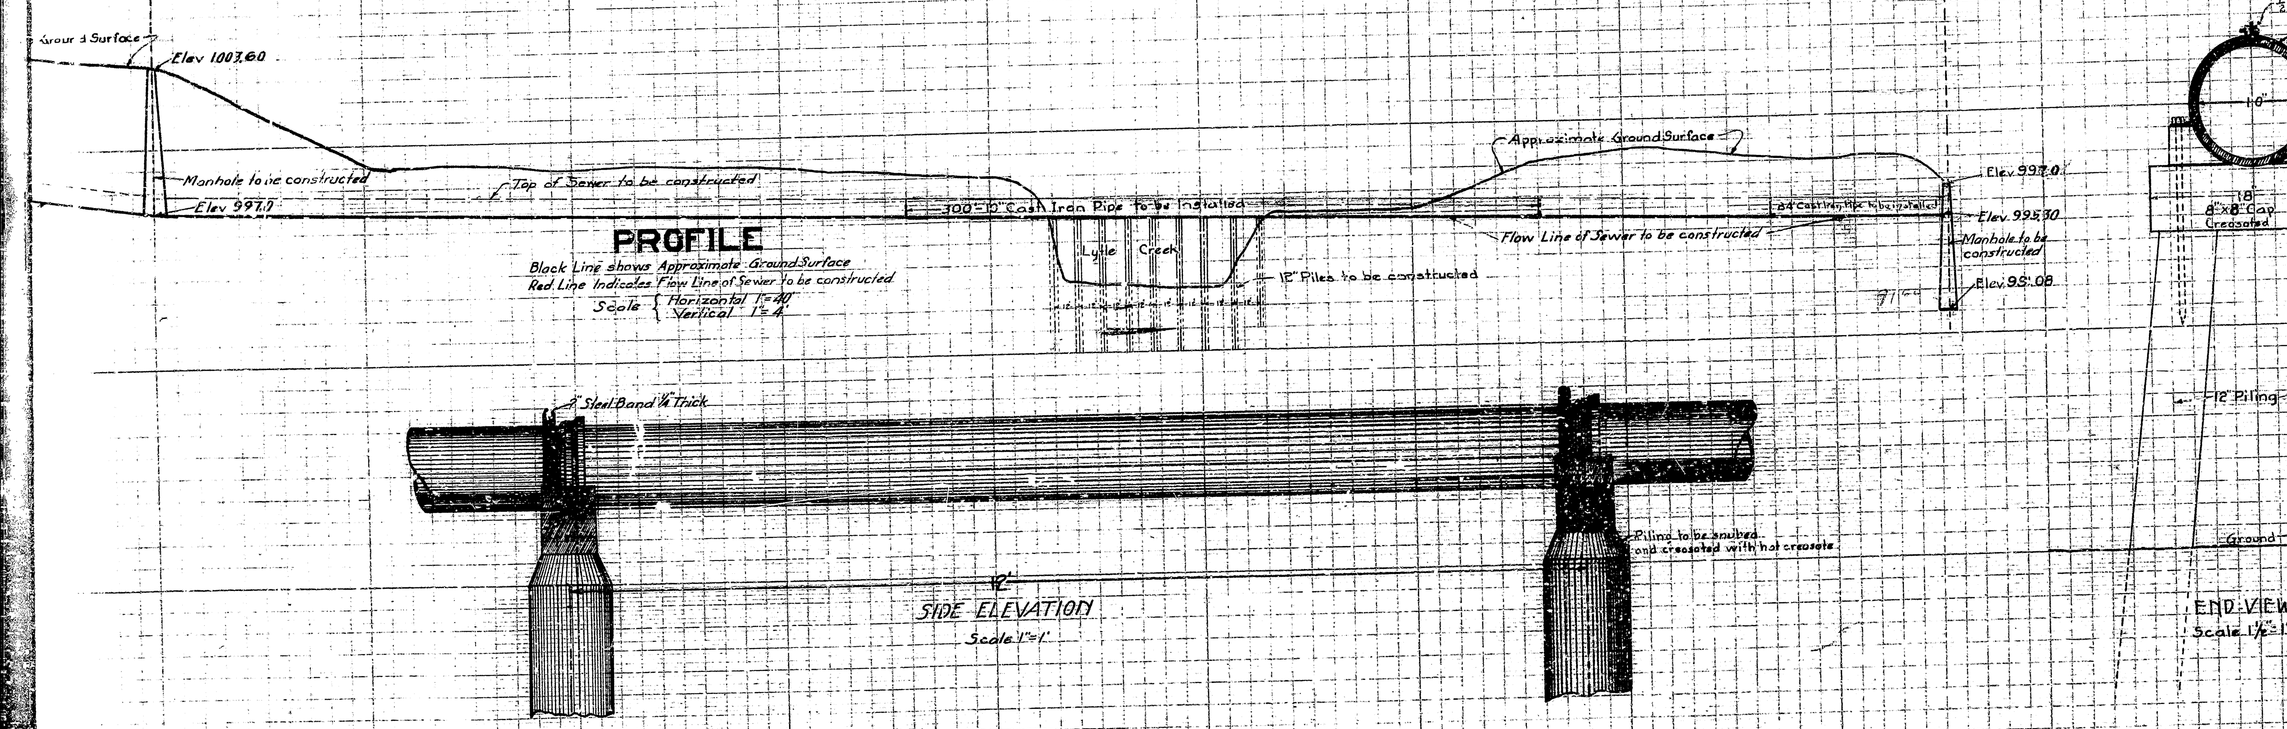

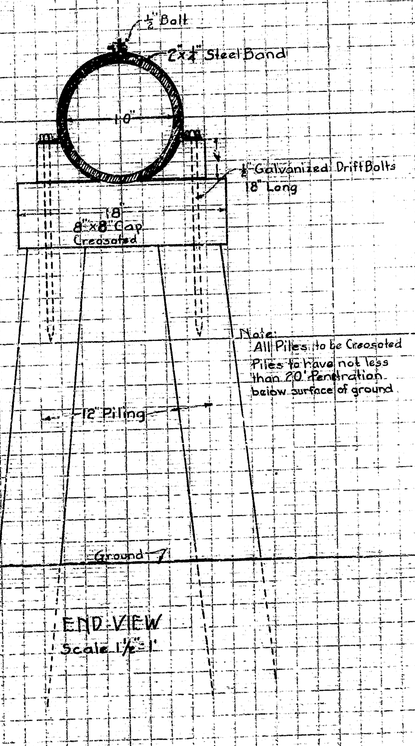

LEGEND

" or in means inch or inches
' or ft means foot or feet
Ave means Avenue
R.S.B. means Rancho San Bernardino
Elev means Elevation
℄ means Center Line
10" Vitrified Pipe Sewer to be constructed shown thus
10" Cast Iron Pipe Sewer to be constructed shown thus
Manholes to be constructed shown thus ○

DETAIL OF SEWER SHEET NO. 10

Lineal ft 10" Vitrified Pipe Sewer to be constructed	1535.48
Lineal ft 10" Cast Iron Pipe Sewer to be constructed	355.00
No of Manholes to be constructed	3
Lineal ft Pile Trestle to be constructed	96

Title to COLTON AVE shown on Sheet No 1 of this plan

Grade Ordinance Shown on Sheet No 1 of this plan

Sheet No. 10 of 18 Sheets