# RECORD SURVEY

OF A PORTION OF SECTIONS 19, 20 AND 29,
T. 1 N., R. 3 W., S.B.B.& M., MADE AT THE REQUEST
OF THE BEAR VALLEY MUTUAL WATER CO.

SCALE 1 INCH = 100 FEET

P.E. HICKS, CIVIL ENGINEER, REDLANDS CALIF.

JANUARY, 1940.

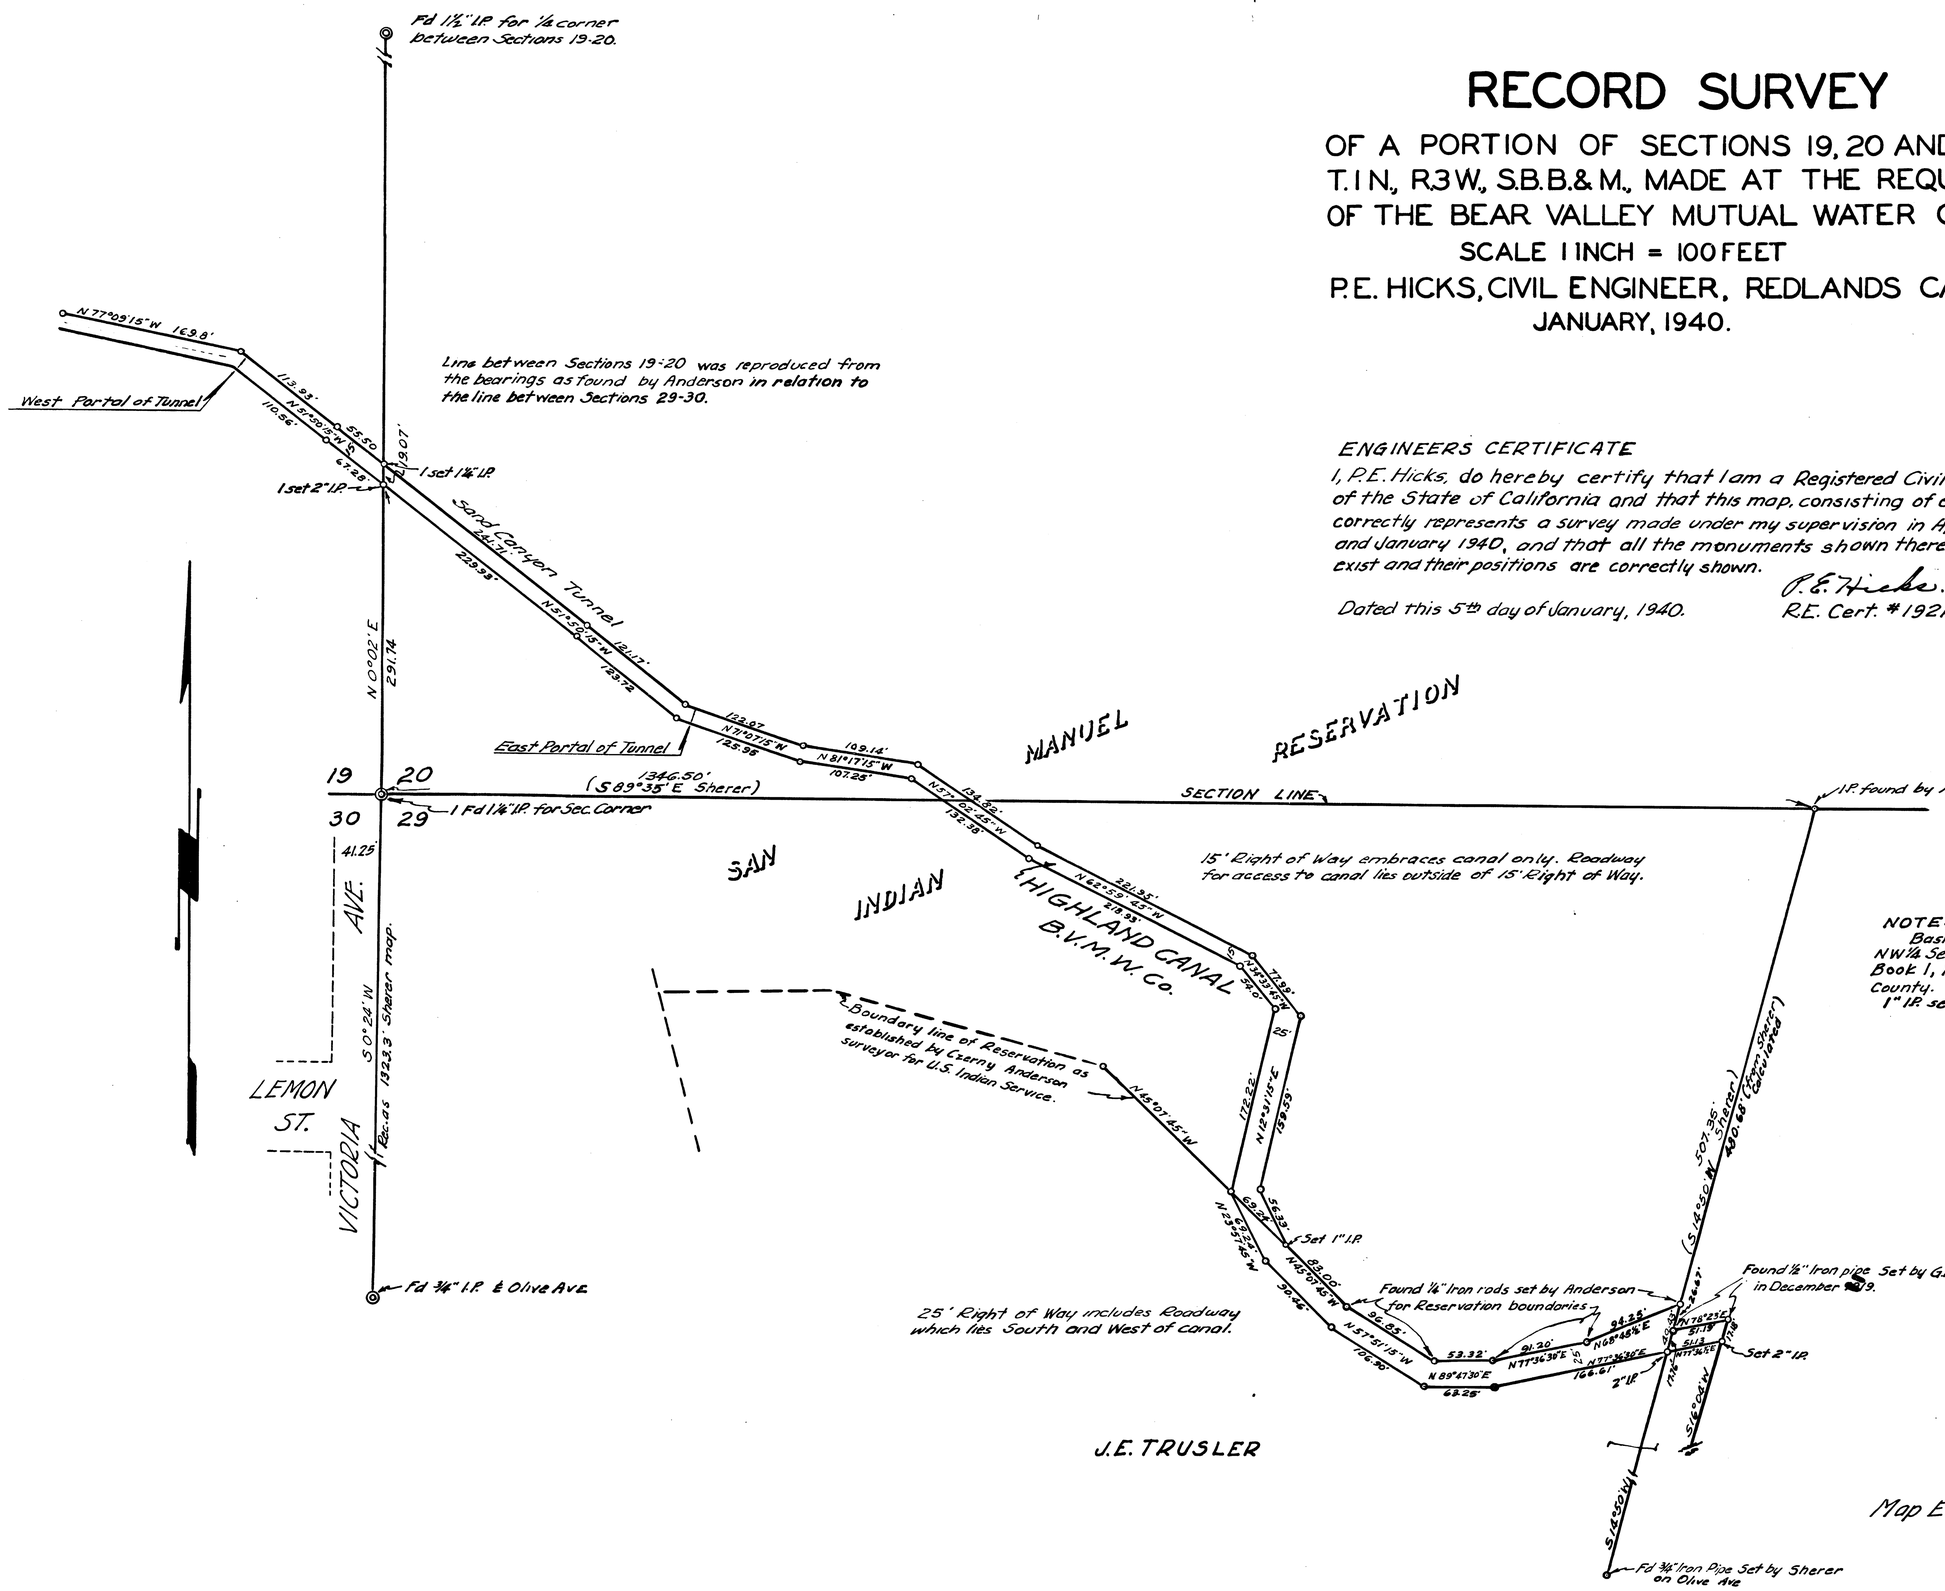


NOTE:-
Basis of bearings from the West line of the NW¼ NW¼ Sec. 29, as shown upon Plat as recorded in Book 1, Page 96, Record of Surveys, San Bernardino County.
1" I.P. set at all points marked o unless otherwise denoted.

ENGINEERS CERTIFICATE

I, P.E. Hicks, do hereby certify that I am a Registered Civil Engineer of the State of California and that this map, consisting of one sheet correctly represents a survey made under my supervision in April 1939 and January 1940, and that all the monuments shown thereon actually exist and their positions are correctly shown.

Dated this 5th day of January, 1940.

P.E. Hicks.
R.E. Cert. #1921

County Surveyor
Feby 28-1940
4:38 P
4 R.S.
4

A R Schultz
1st

Map Examined H. W. Way FEB. 28, 1940
County Surveyor