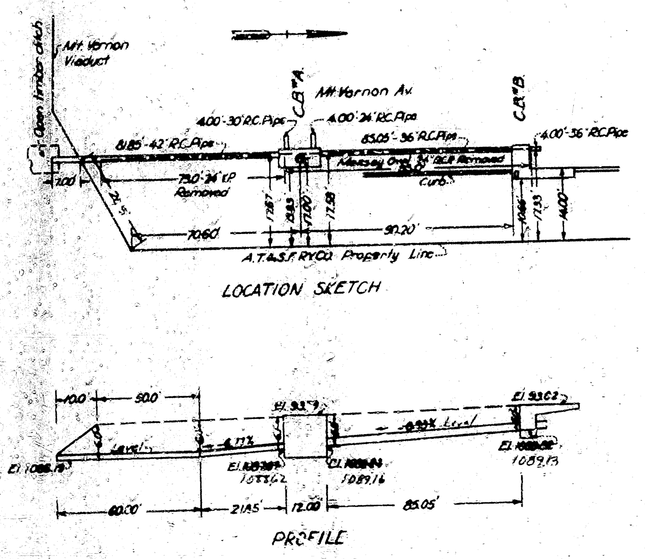

LOCATION SKETCH

PROFILE

As Built Plans Manhole & C.B. "B" on Mt. Vernon Ave.

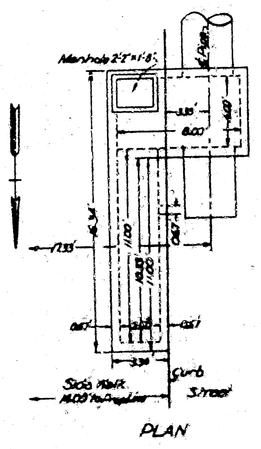

PLAN

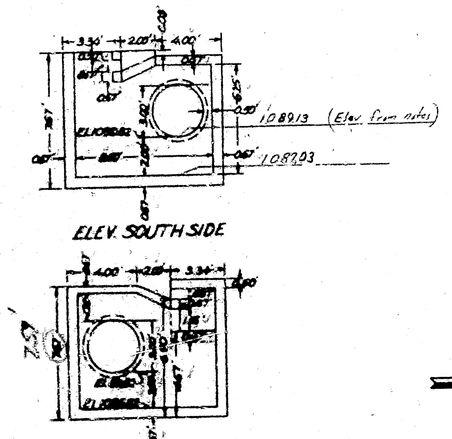

ELEV. SOUTH SIDE

ELEV. NORTH SIDE

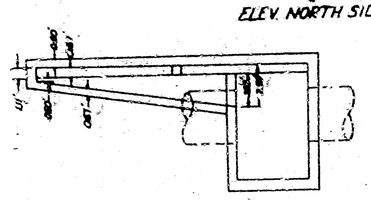

ELEV. EAST SIDE

As Built Plans Manhole & C.B. "A" on Mt. Vernon Ave.

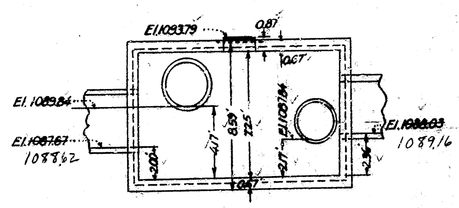

ELEV. WEST SIDE

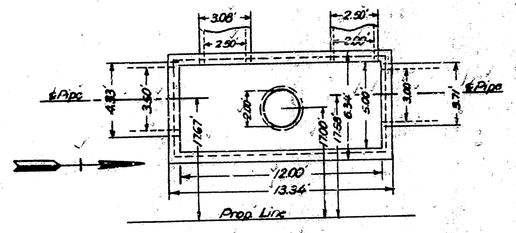

PLAN

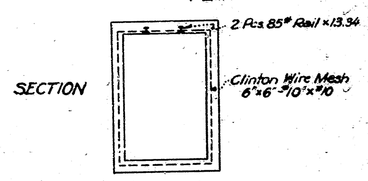

SECTION

CONSTRUCTION DETAILS
STORM DRAINAGE SYSTEM

Mt Vernon Av. & 4th St.
San Bernardino.

Designed & Constructed by AT&SF Ry.
under A.F.E. O-469-23.

Traced from A.T.&S.F.Ry. Plans
by L.S.M. Feb. 8 1933