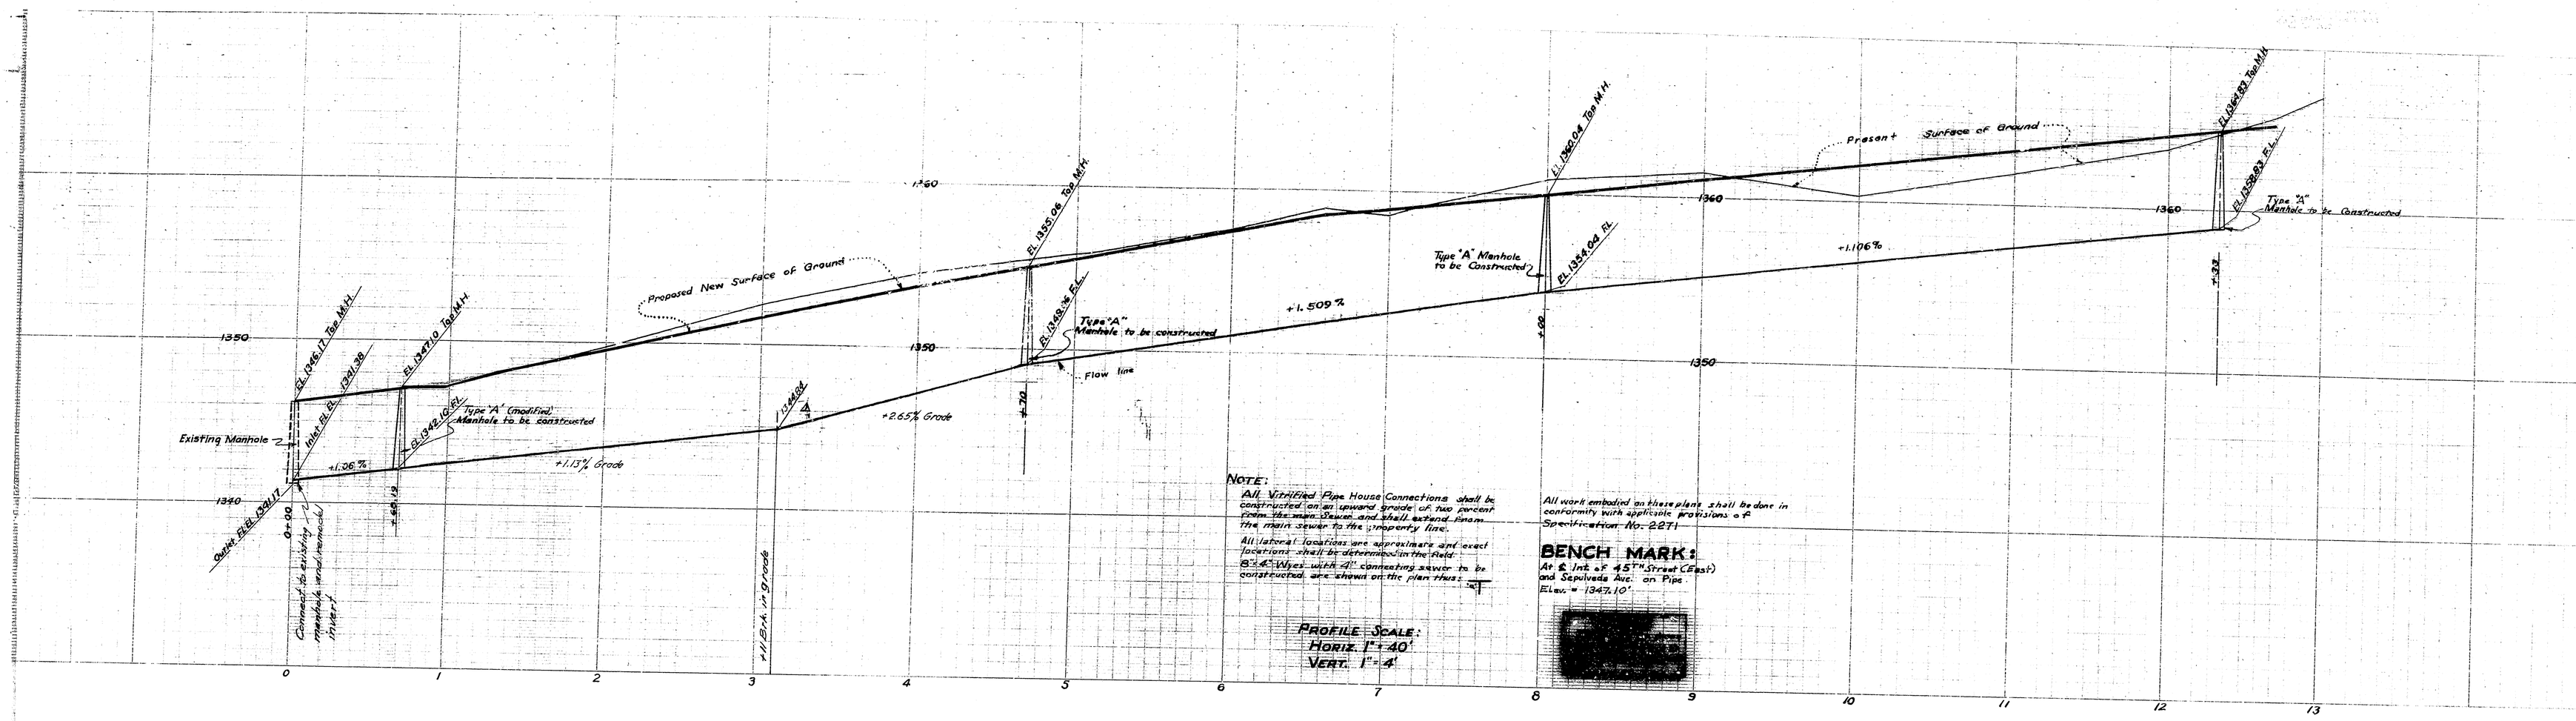

NOTE:

All Vitrified Pipe House Connections shall be constructed on an upward grade of two percent from the main Sewer and shall extend from the main sewer to the property line.

All lateral locations are approximate and exact locations shall be determined in the field.

8"x4" Wyes with 4" connecting sewer to be constructed, are shown on the plan thus: ⊥

All work embodied on these plans shall be done in conformity with applicable provisions of Specification No. 2271

BENCH MARK:

At ℄ Int. of 45TH Street (East) and Sepulveda Ave. on Pipe
Elev. = 1347.10'

PROFILE SCALE:
HORIZ. 1" = 40'
VERT. 1" = 4'

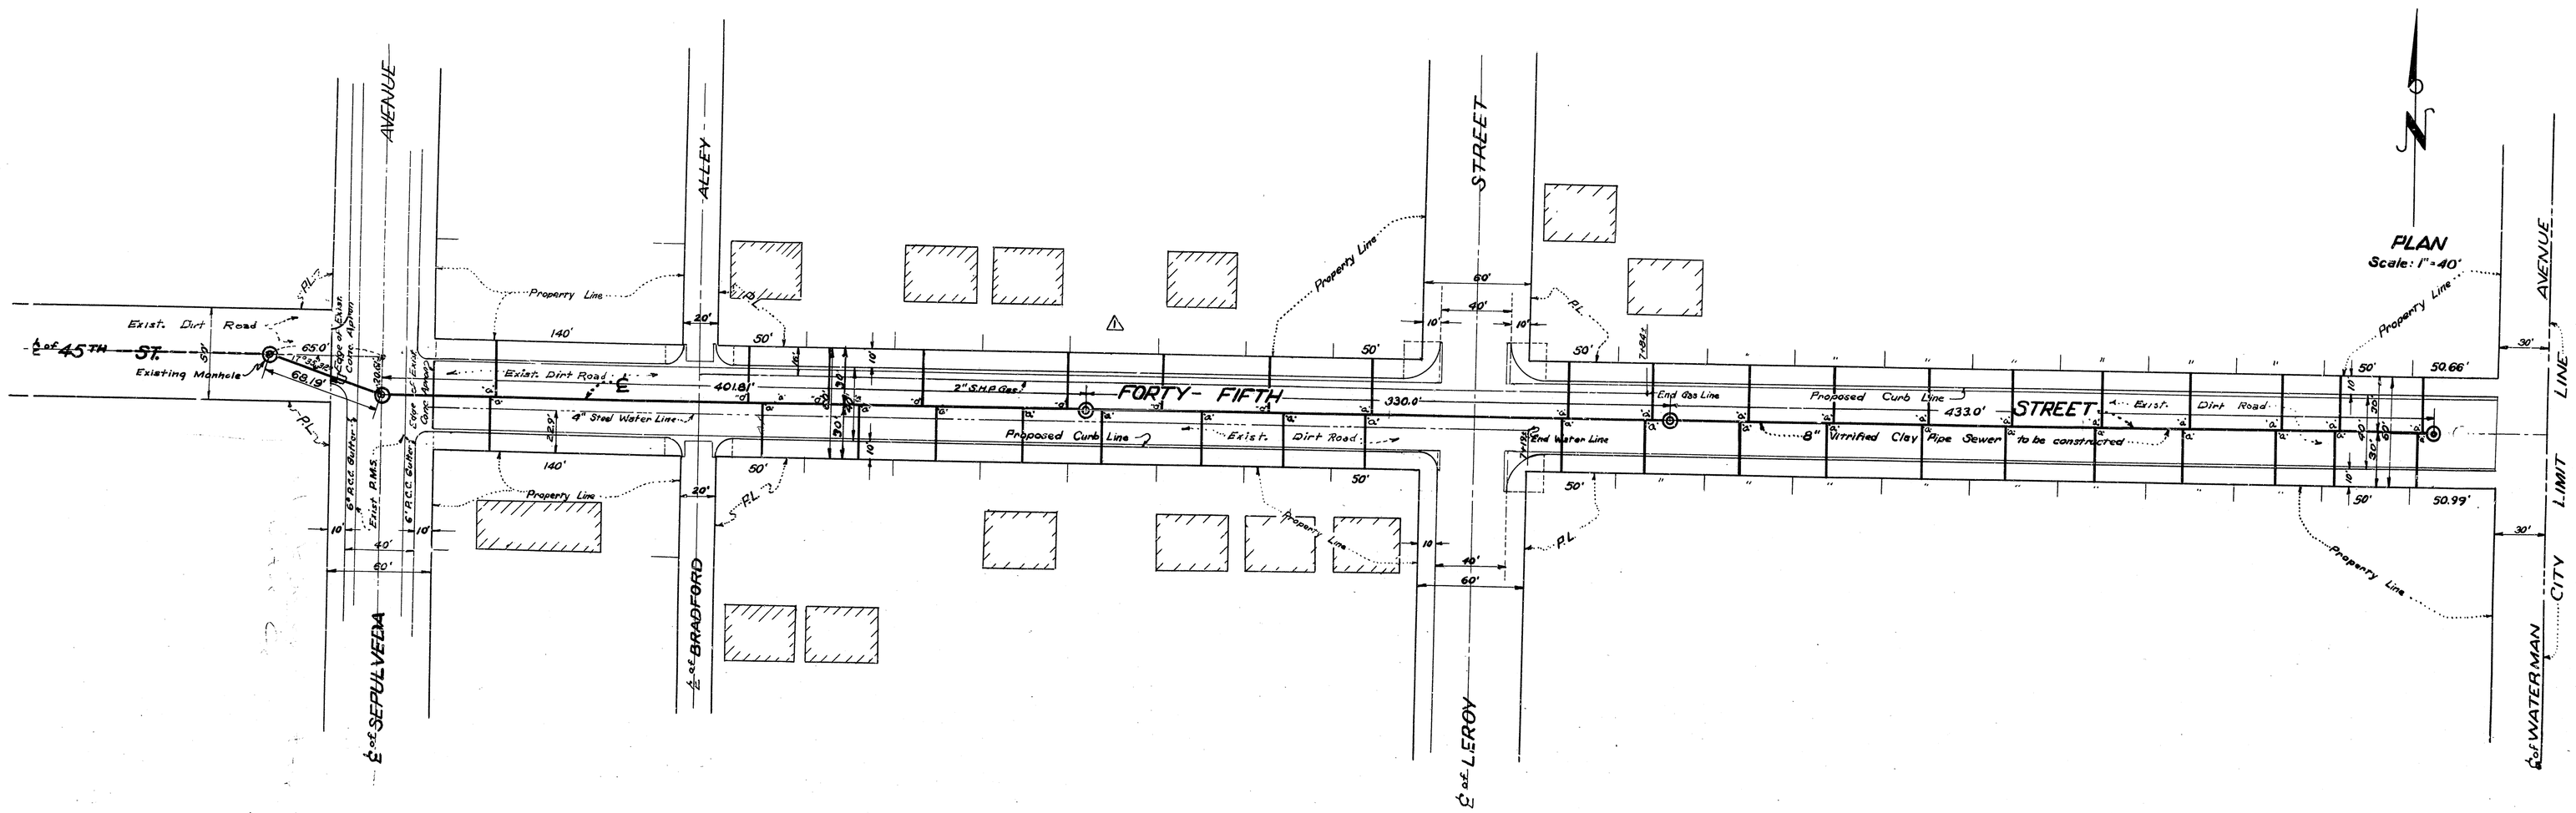

⚠	As Constructed	C.L.C.	8-1
Nº	REVISION	BY	DA

DEPARTMENT OF ENGINEERING
CITY OF SAN BERNARDINO

PLAN 2158
FORTY-FIFTH ST
SEPULVEDA AVE. TO WATER
SEWER INSTALLAT

SUBMITTED BY _____ SUPERVISOR
APPROVED Dec. 17, 1954 DRAWN D
CITY ENGINEER
REGISTERED CIVIL ENGINEER No. 7065 CHECKED

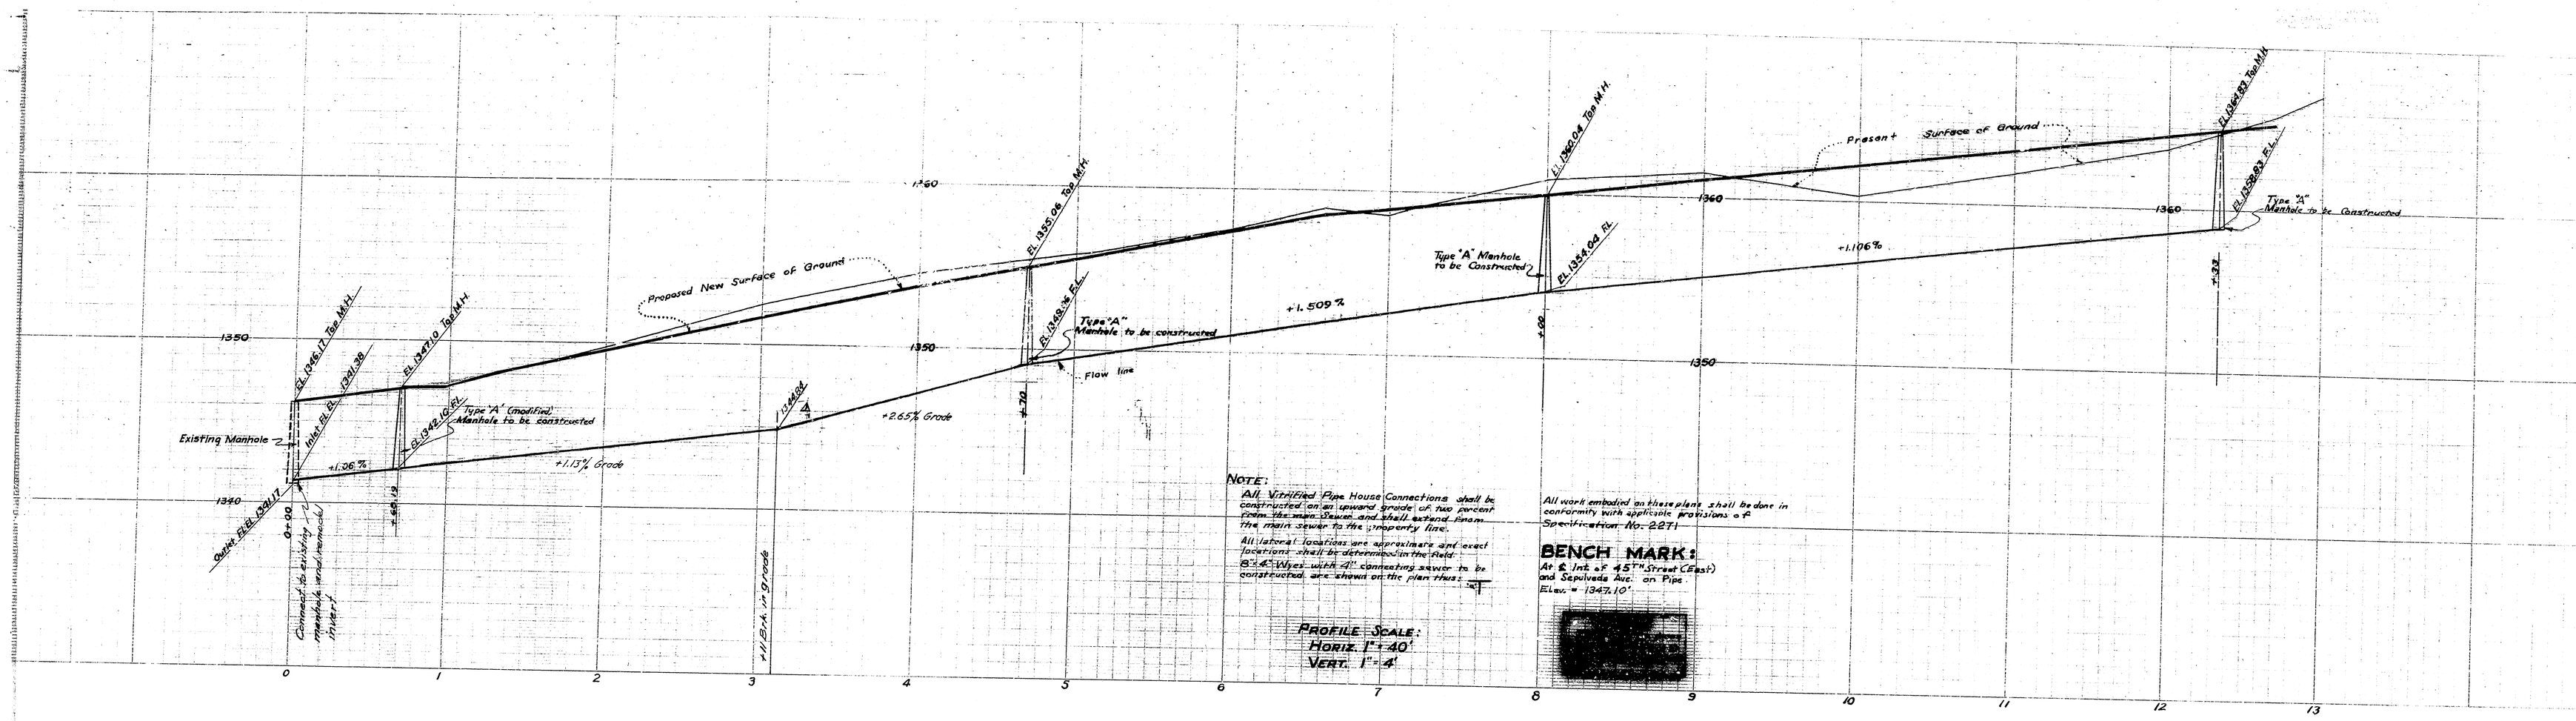

NOTE:

All Vitrified Pipe House Connections shall be constructed on an upward grade of two percent from the main Sewer and shall extend from the main sewer to the property line.

All lateral locations are approximate and exact locations shall be determined in the field.

8"x4" Wyes with 4" connecting sewer to be constructed, are shown on the plan thus: ⊥

All work embodied on these plans shall be done in conformity with applicable provisions of Specification No. 2271

BENCH MARK:

At ℄ Int. of 45TH Street (East) and Sepulveda Ave. on Pipe
Elev. = 1347.10'

PROFILE SCALE:
HORIZ. 1" = 40'
VERT. 1" = 4'

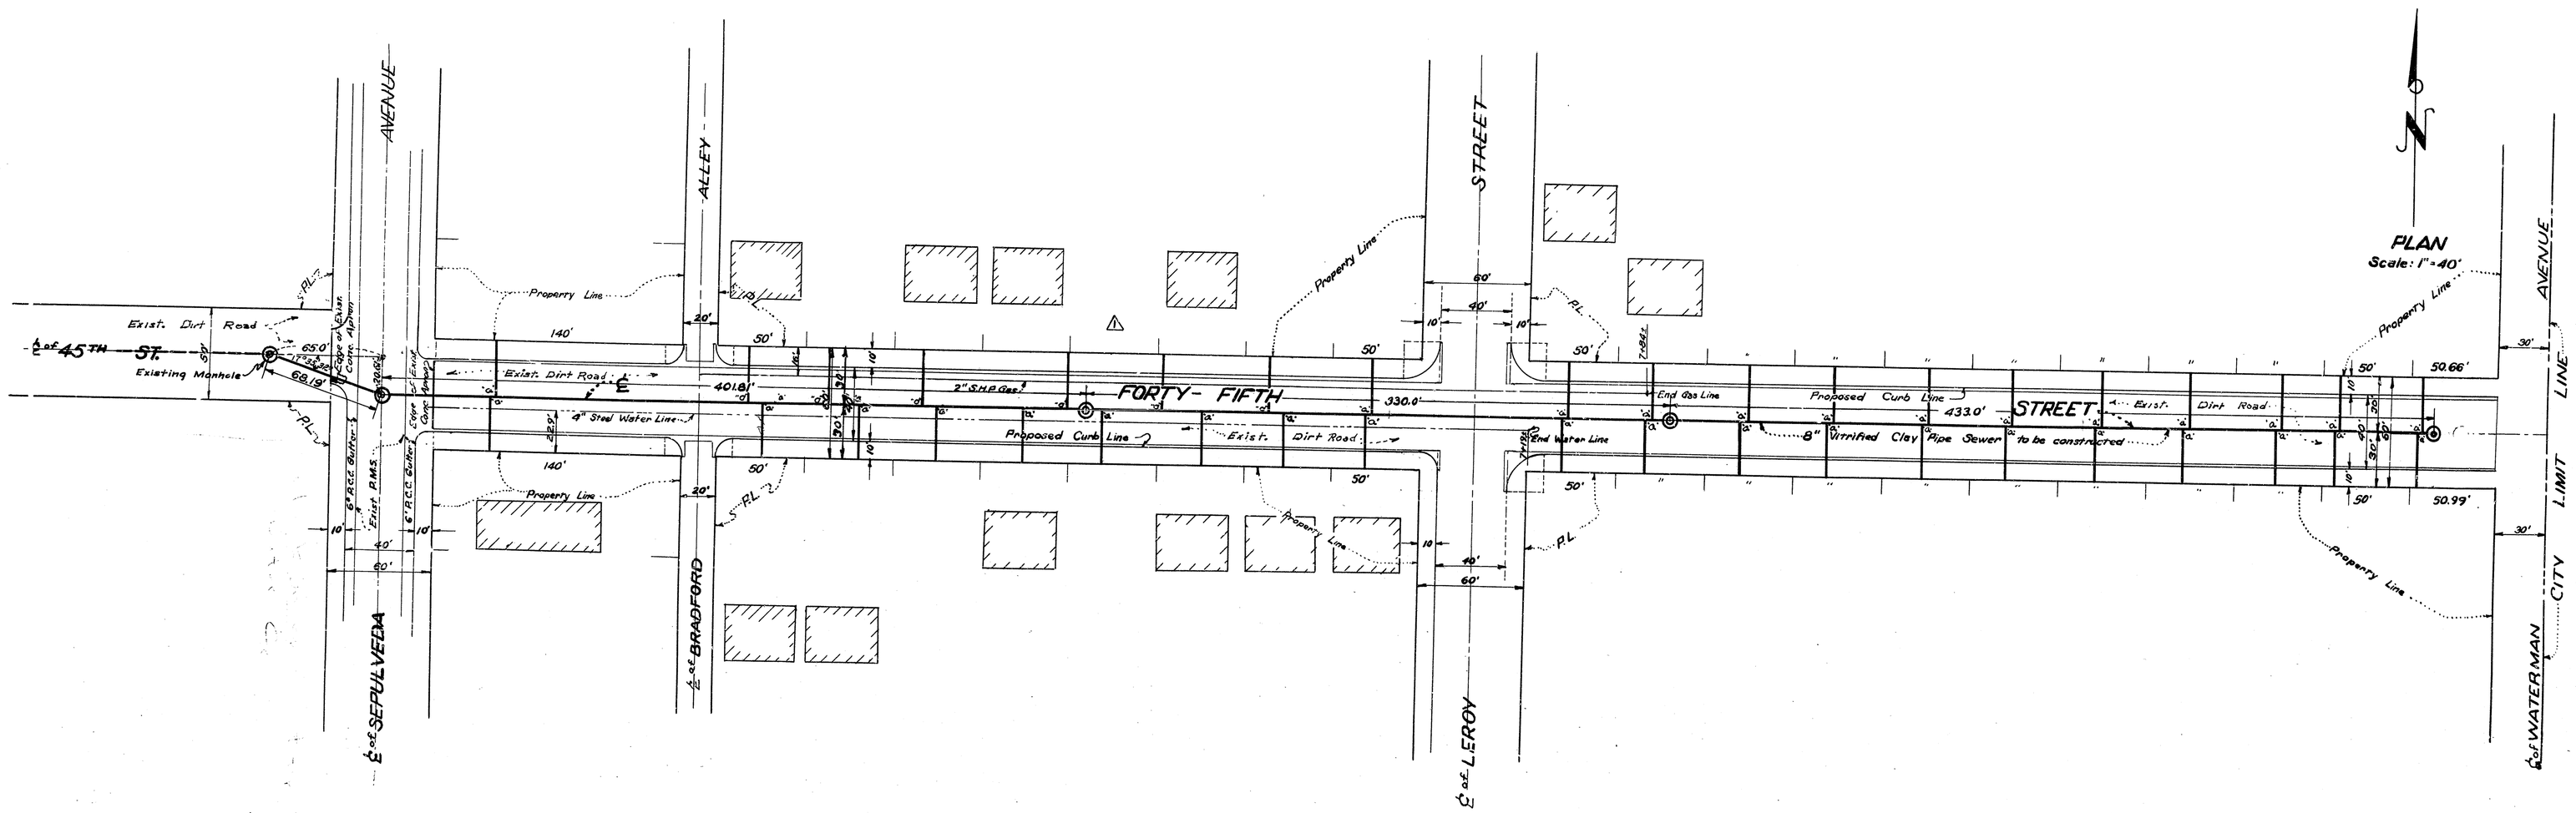

⚠	As Constructed	C.L.C.	8-1
Nº	REVISION	BY	DA

DEPARTMENT OF ENGINEERING
CITY OF SAN BERNARDINO

PLAN 2158
FORTY-FIFTH ST
SEPULVEDA AVE. TO WATER
SEWER INSTALLAT

SUBMITTED BY _____ SUPERVISOR
APPROVED Dec. 17, 1954 DRAWN D
CITY ENGINEER
REGISTERED CIVIL ENGINEER No. 7065 CHECKED