LOS ANGELES - SAN BERNARDINO

RIALTO AVE.

FROM SYCAMORE AV.
TO EUCALYPTUS AV.
SAN BERNARDINO, CALIF.
RIALTO, CALIF.

THE PACIFIC TEL. & TEL. CO.

CONDUIT RECORD

SCALE 1" = 100'

SAN BER'DO. CO.

ACCT. CLASS - TOLL

MANHOLES

CU. FT.	M. H.	SUPT. M. H. TO GROUND	INSIDE DIM. LENGTH	INSIDE DIM. WIDTH	MIN. OF CON.	SHAPE	INCREASE IN SHAPE	INSIDE DIM. FRONT	WALLS	REAR	FLOOR	OUTER COVER SHAPE	OUTER COVER WT.	WT. MH. CAPACITY	WT. FRAME	BRAND	DATE	SPECIAL CONSTRUCTION
120	516		6'	4'	8"	RECT.	4/6	7.5'	6" CON	7" CON	2" CON	RD.	230		380	SUMP	9-28	
120	517		6'	4'	8"	RECT.	4/6	7.5'	6" CON	7" CON	2" CON	RD.	230		320	SUMP	9-28	
120	518		6'	4'	8"	RECT.	4/6	7.5'	6" CON	7" CON	2" CON	RD.	230		380	SUMP	9-28	
120	519		6'	4'	8"	RECT.	4/6	7.5'	6" CON	7" CON	2" CON	RD.	230		380	SUMP	9-2	
120	521		6'	4'	8"	RECT.	4/6	7.2'	6" CON	7" CON	2" CON	RD.	230		380	SUMP	9-28	
360	520		11'	8.5'	8"	RECT.	4/6	8.8'	6" CON	8" CON	8" CON	RD.	2 200		2 450	MAINS	11-28	

MAIN CONDUIT

FROM M. H.	TO M. H.	ORIGINAL PAVEMENT SURF.	ORIGINAL PAVEMENT BASE	ORIGINAL PAVEMENT LENGTH	SUBSURFACE TYPE	SUBSURFACE LENGTH	DATE	REMARKS
515	516	4" MAC. DIRT	2" ROCK	50' 313'	ADOBE	363'	9-28	
516	517	DIRT		708'	ADOBE	708	9-28	
517	518	4" MAC. DIRT	2" ROCK	10' 676'	ADOBE	686'	9-28	
518	519	DIRT		726'	ADOBE	726'	9-28	
~~519~~	~~521~~	~~4" MAC. DIRT~~	~~2" ROCK~~	~~10'~~ ~~636'~~	~~ADOBE~~	~~636'~~	~~9-28~~	
519	520	4" MAC. DIRT	2" ROCK	10' 465.5'	ADOBE	455.5'	9-28	
520	521	DIRT		146.5'	ADOBE	146.5'	9-28	

LATERALS

NO.	DEPTH AT M. H.	ORIGINAL PAVEMENT SURF.	ORIGINAL PAVEMENT BASE	ORIGINAL PAVEMENT LENGTH	SUBSURFACE TYPE	SUBSURFACE LENGTH	DATE	REMARKS
1	3'	10'	WITH	MAIN	COND.		9-28	
				20'		20'	11-54	

LATERALS

NO.	DEPTH AT M. H.	ORIGINAL PAVEMENT SURF.	ORIGINAL PAVEMENT BASE	ORIGINAL PAVEMENT LENGTH	SUBSURFACE TYPE	SUBSURFACE LENGTH	DATE	REMARKS

IN EFFECT 7-20-29

CORRECTED	
EST. OR J. O. NO.	DATE
6295	9-2-28
6608	1-31-30
R.G.71566	10-10-30
WINTON	2-1-36
BATTUGO	11-15-56
FIELD CHECK	5-7-46
TAB. BASF	TOLL
1-31-51	INV.
547-14-3	11-54
ABBS 640-2.67	12-54

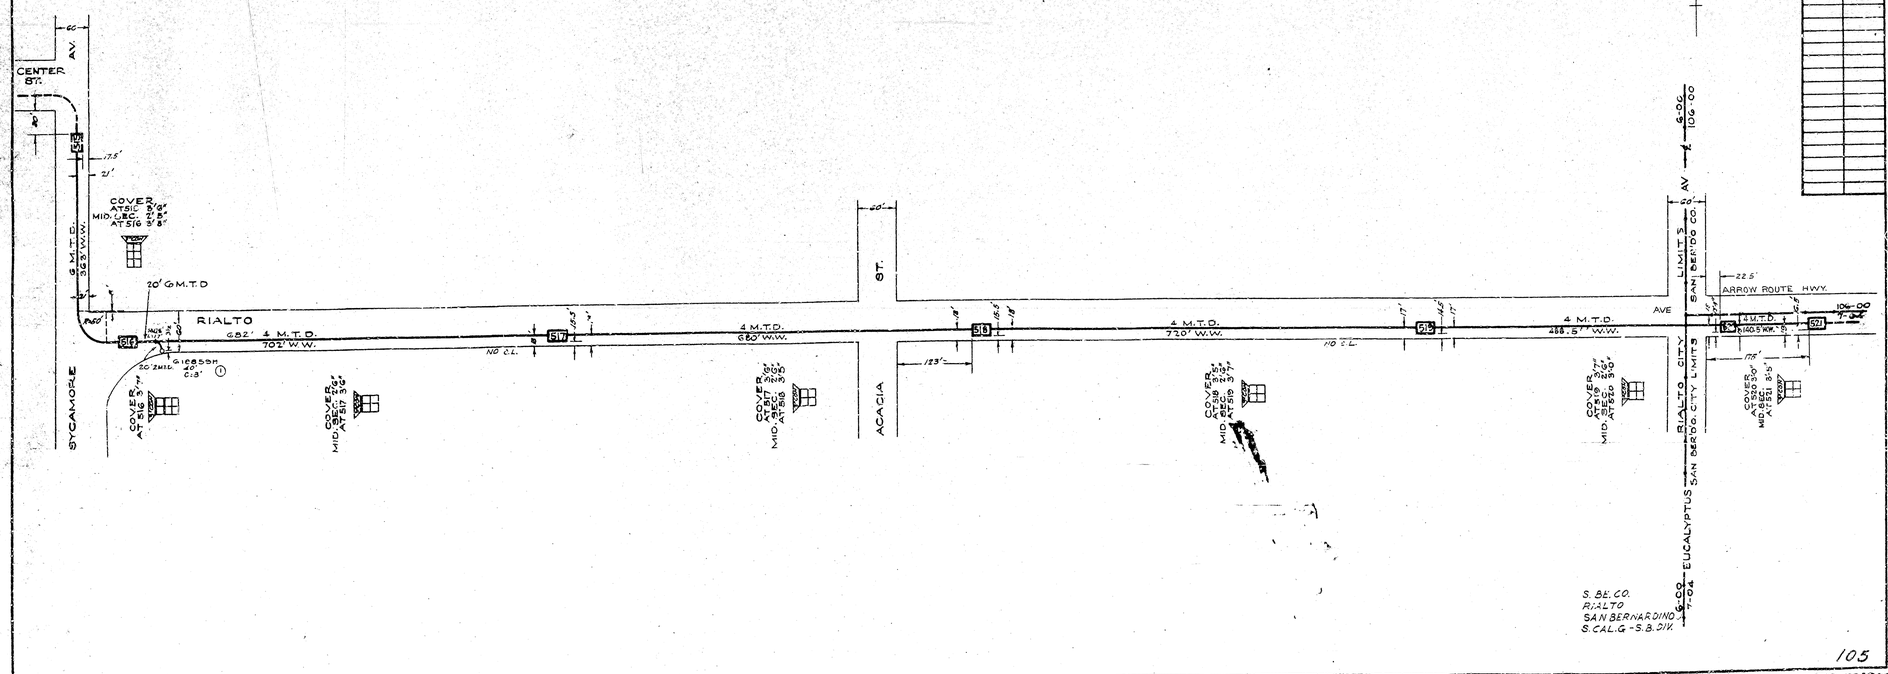

105

RIALTO EXCH.

LOS ANGELES - SAN BERNARDINO

RIALTO AVE.

FROM SYCAMORE AV.
TO EUCALYPTUS AV.
SAN BERNARDINO, CALIF.
RIALTO, CALIF.

THE PACIFIC TEL. & TEL. CO.

CONDUIT RECORD

SCALE 1" = 100'

SAN BER'DO. CO.

ACCT. CLASS - TOLL

MANHOLES

CU. FT.	M. H.	SUPT. M. H. TO GROUND	INSIDE DIM. LENGTH	INSIDE DIM. WIDTH	MIN. OF CON.	SHAPE	INCREASE IN SHAPE	INSIDE DIM. FRONT	WALLS	REAR	FLOOR	OUTER COVER SHAPE	OUTER COVER WT.	WT. MH. CAPACITY	WT. FRAME	BRAND	DATE	SPECIAL CONSTRUCTION
120	516		6'	4'	8"	RECT.	4/6	7.5'	6" CON	7" CON	2" CON	RD.	230		380	SUMP	9-28	
120	517		6'	4'	8"	RECT.	4/6	7.5'	6" CON	7" CON	2" CON	RD.	230		320	SUMP	9-28	
120	518		6'	4'	8"	RECT.	4/6	7.5'	6" CON	7" CON	2" CON	RD.	230		380	SUMP	9-28	
120	519		6'	4'	8"	RECT.	4/6	7.5'	6" CON	7" CON	2" CON	RD.	230		380	SUMP	9-2	
120	521		6'	4'	8"	RECT.	4/6	7.2'	6" CON	7" CON	2" CON	RD.	230		380	SUMP	9-28	
360	520		11'	8.5'	8"	RECT.	4/6	8.8'	6" CON	8" CON	8" CON	RD.	2 200		2 450	MAINS	11-28	

MAIN CONDUIT

FROM M. H.	TO M. H.	ORIGINAL PAVEMENT SURF.	ORIGINAL PAVEMENT BASE	ORIGINAL PAVEMENT LENGTH	SUBSURFACE TYPE	SUBSURFACE LENGTH	DATE	REMARKS
515	516	4" MAC. DIRT	2" ROCK	50' 313'	ADOBE	363'	9-28	
516	517	DIRT		708'	ADOBE	708	9-28	
517	518	4" MAC. DIRT	2" ROCK	10' 676'	ADOBE	686'	9-28	
518	519	DIRT		726'	ADOBE	726'	9-28	
~~519~~	~~521~~	~~4" MAC. DIRT~~	~~2" ROCK~~	~~10'~~ ~~636'~~	~~ADOBE~~	~~636'~~	~~9-28~~	
519	520	4" MAC. DIRT	2" ROCK	10' 465.5'	ADOBE	455.5'	9-28	
520	521	DIRT		146.5'	ADOBE	146.5'	9-28	

LATERALS

NO.	DEPTH AT M. H.	ORIGINAL PAVEMENT SURF.	ORIGINAL PAVEMENT BASE	ORIGINAL PAVEMENT LENGTH	SUBSURFACE TYPE	SUBSURFACE LENGTH	DATE	REMARKS
1	3'	10'	WITH	MAIN	COND.		9-28	
				20'		20'	11-54	

LATERALS

NO.	DEPTH AT M. H.	ORIGINAL PAVEMENT SURF.	ORIGINAL PAVEMENT BASE	ORIGINAL PAVEMENT LENGTH	SUBSURFACE TYPE	SUBSURFACE LENGTH	DATE	REMARKS

IN EFFECT 7-20-29

CORRECTED	
EST. OR J. O. NO.	DATE
6295	9-2-28
6608	1-31-30
R.G.71566	10-10-30
WINTON	2-1-36
BATTUGO	11-15-56
FIELD CHECK	5-7-46
TAB. BASF	TOLL
1-31-51	INV.
547-14-3	11-54
ABBS 640-2.67	12-54

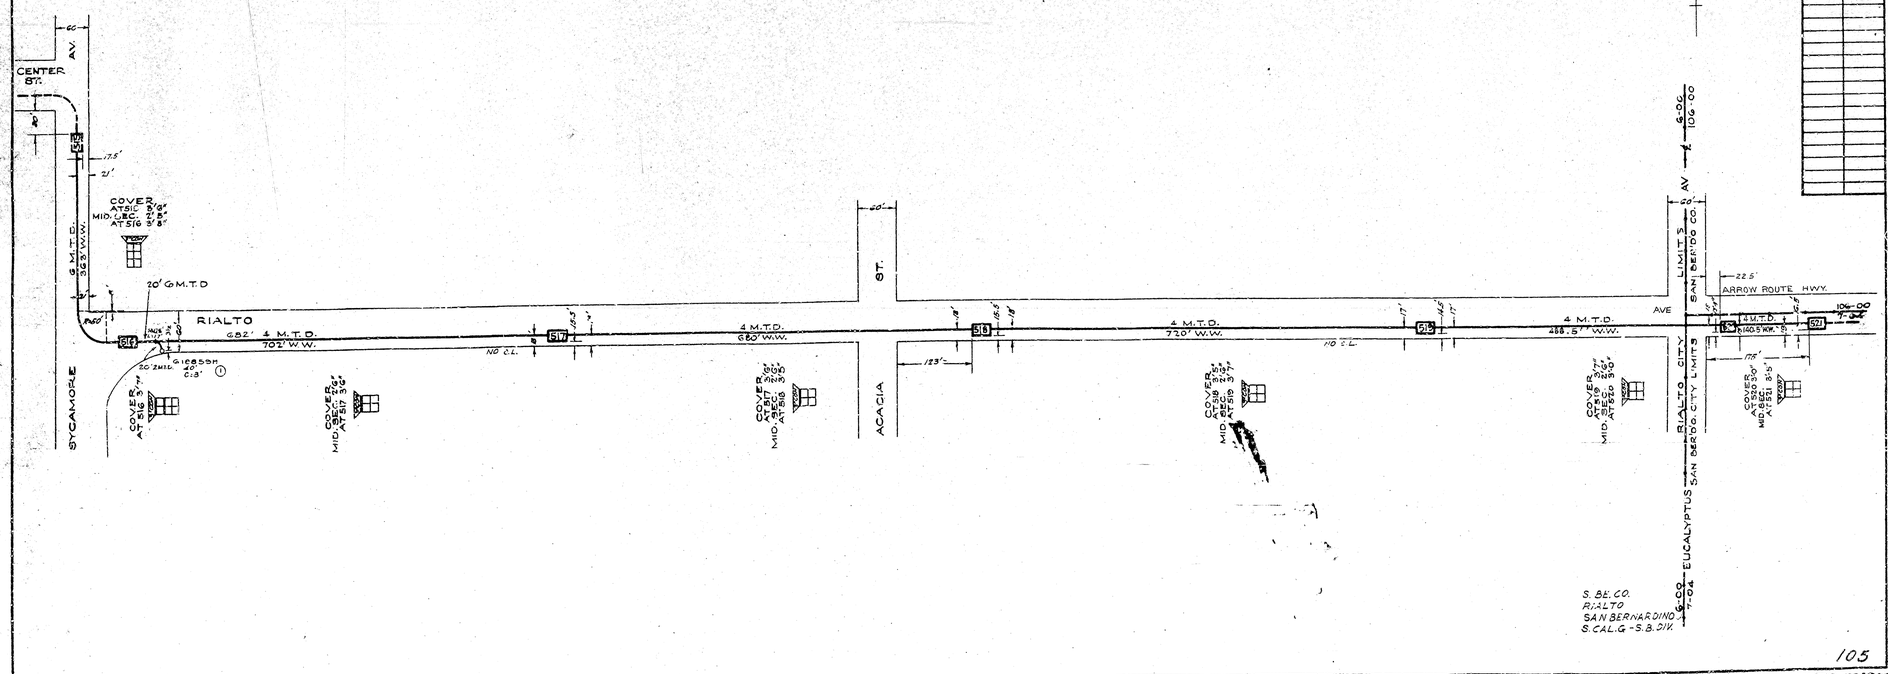

105

RIALTO EXCH.