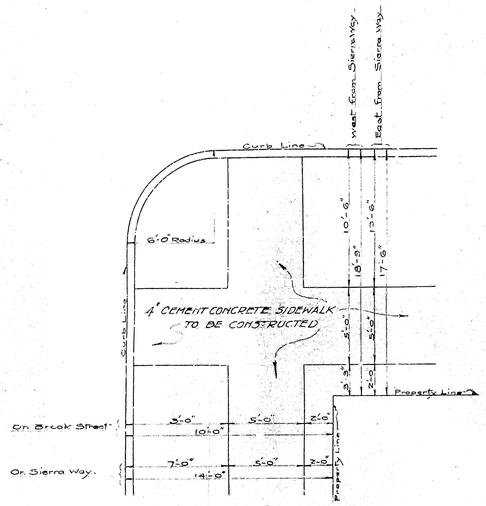

PLAN OF SIDE-WALK
Scale:— 1" = 4'

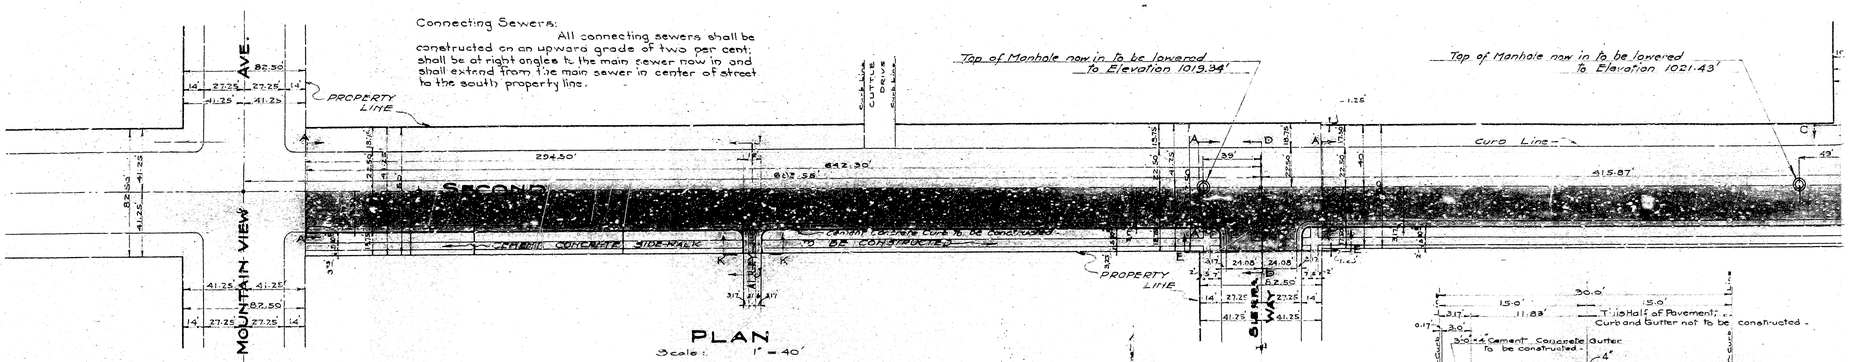

PLAN
Scale: 1" = 40'

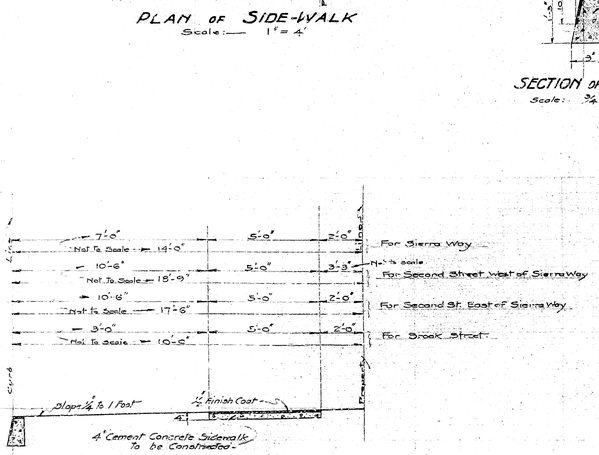

SECTION OF CURB
Scale: 3/4" = 1 Foot

SECTION OF SIDE-WALK
Scale:— 3/8" = 1 Foot.

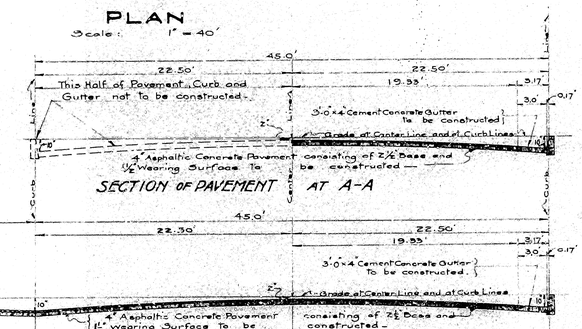

SECTION OF PAVEMENT AT A-A

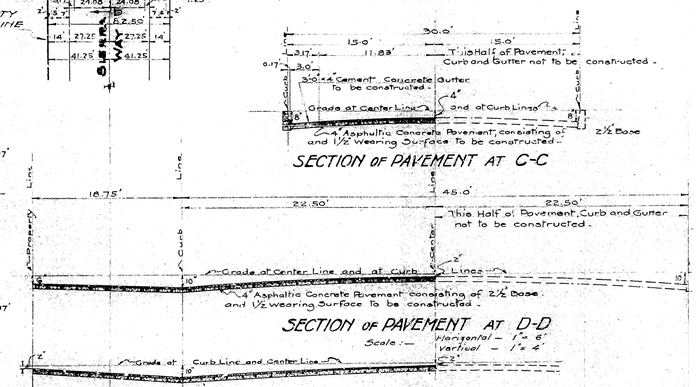

SECTION OF PAVEMENT AT C-C

SECTION OF PAVEMENT AT B-B
Scale:— Horizontal — 1" = 6'
Vertical — 1" = 4'

SECTION OF PAVEMENT AT D-D
Scale:— Horizontal — 1" = 6'
Vertical — 1" = 4'

SECTION OF SIDE-WALK
Scale:— 3/8" = 1 Foot.

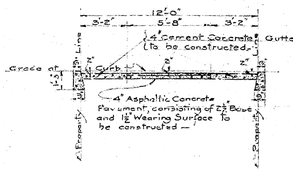

SECTION K-K AT ALLEY
Scale:— 1" = 4 Feet

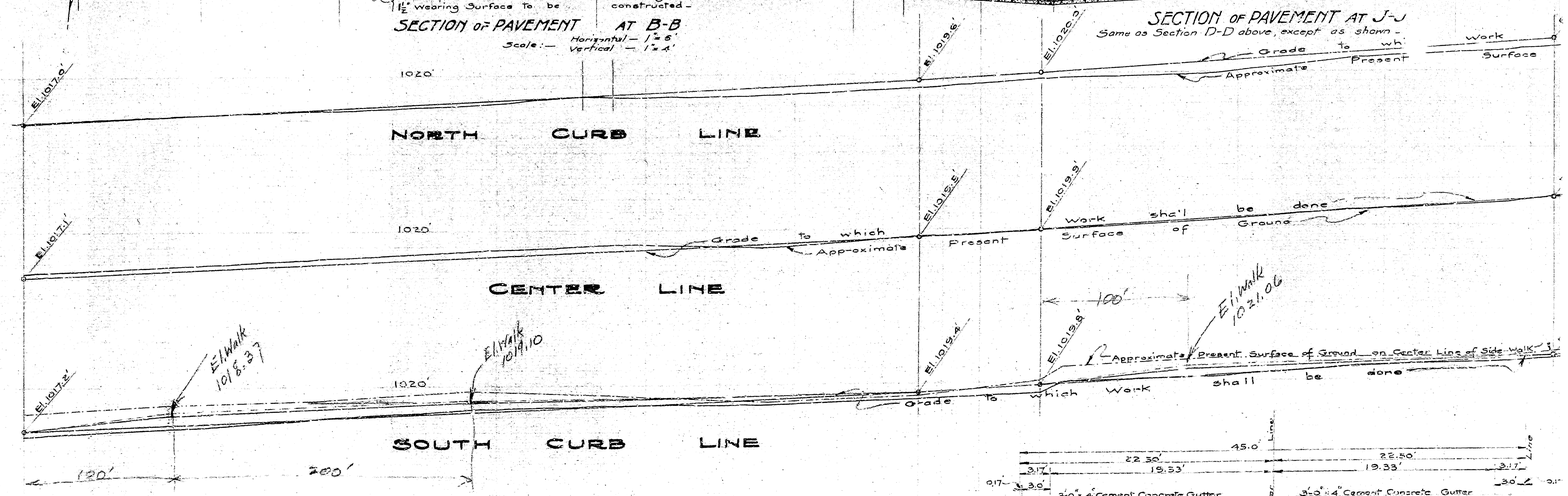

PROFILE
Scale:— Horizontal, 1" = 40'
Vertical, 1" = 4'

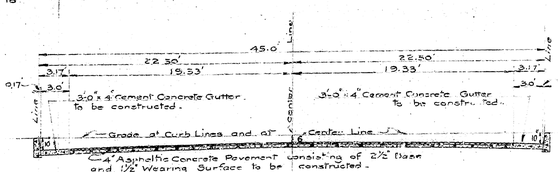

SECTION OF PAVEMENT AT G-G
Scale:— Horizontal — 1" = 6'
Vertical — 1" = 4'

PROFILE LEGEND

Black Line shows "Approximate Present Surface of Ground" on Curb Lines and Street Center Line.

Dash and Dot Black Line shows "Approximate Present Surface of Ground" on Center Line of Side-Walk.

Red Line thus,— shows Grade To which Work shall be done.