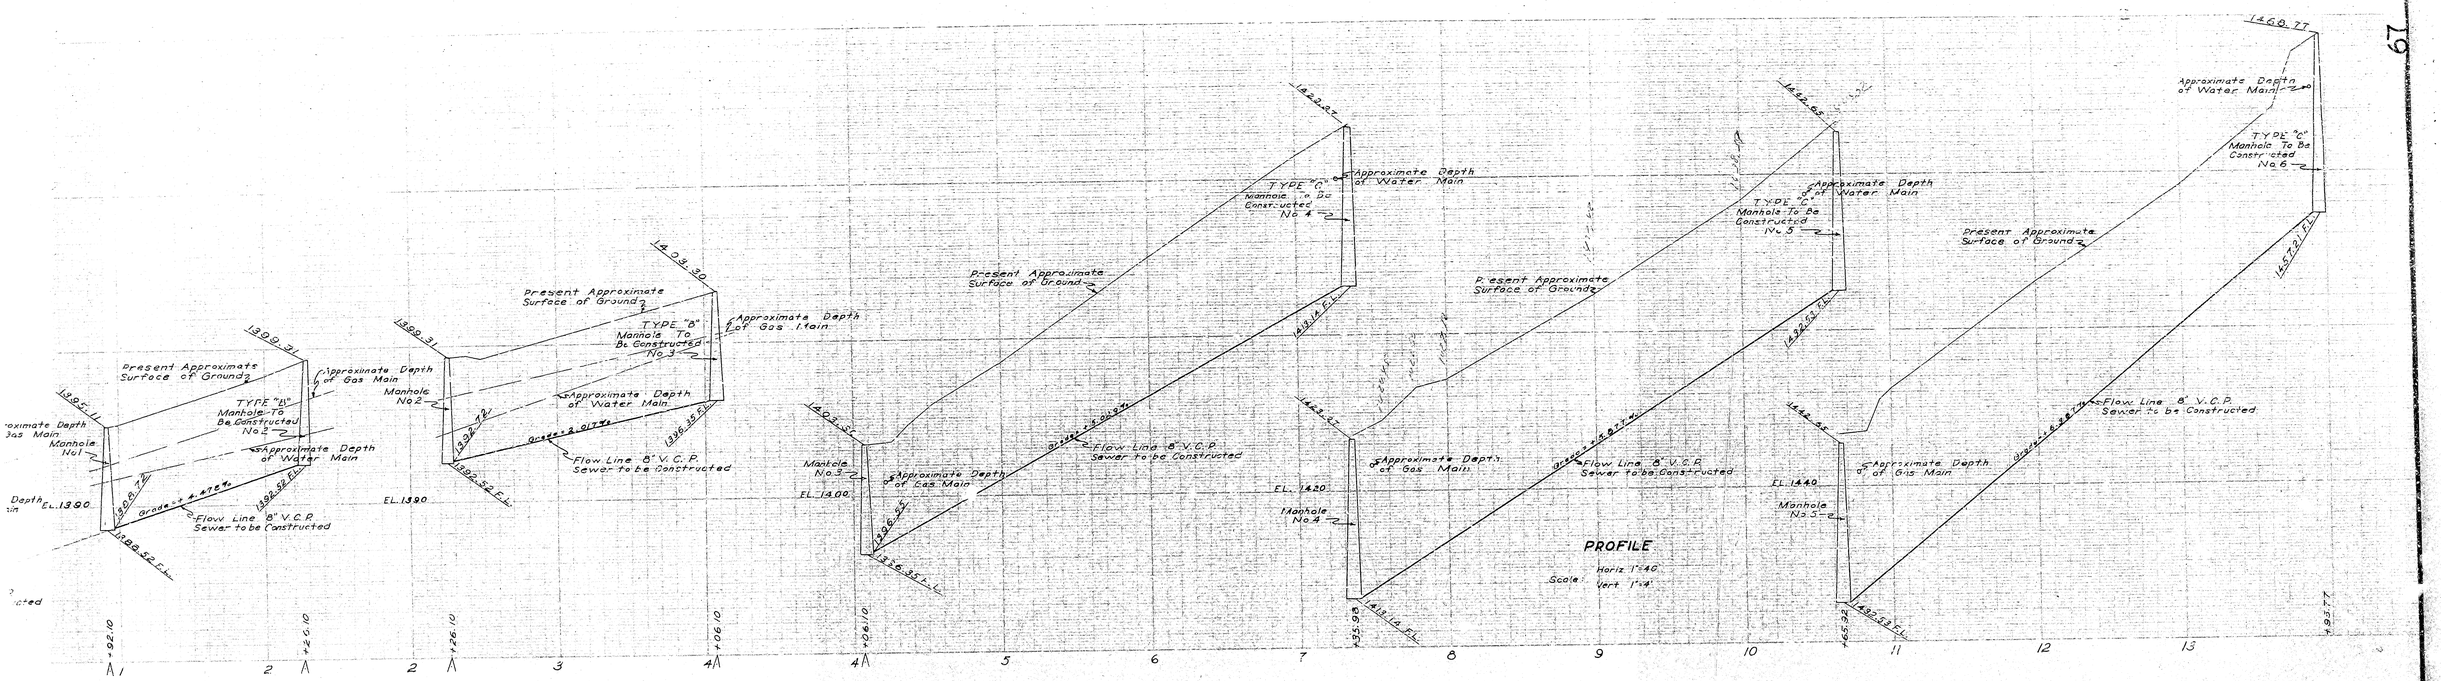

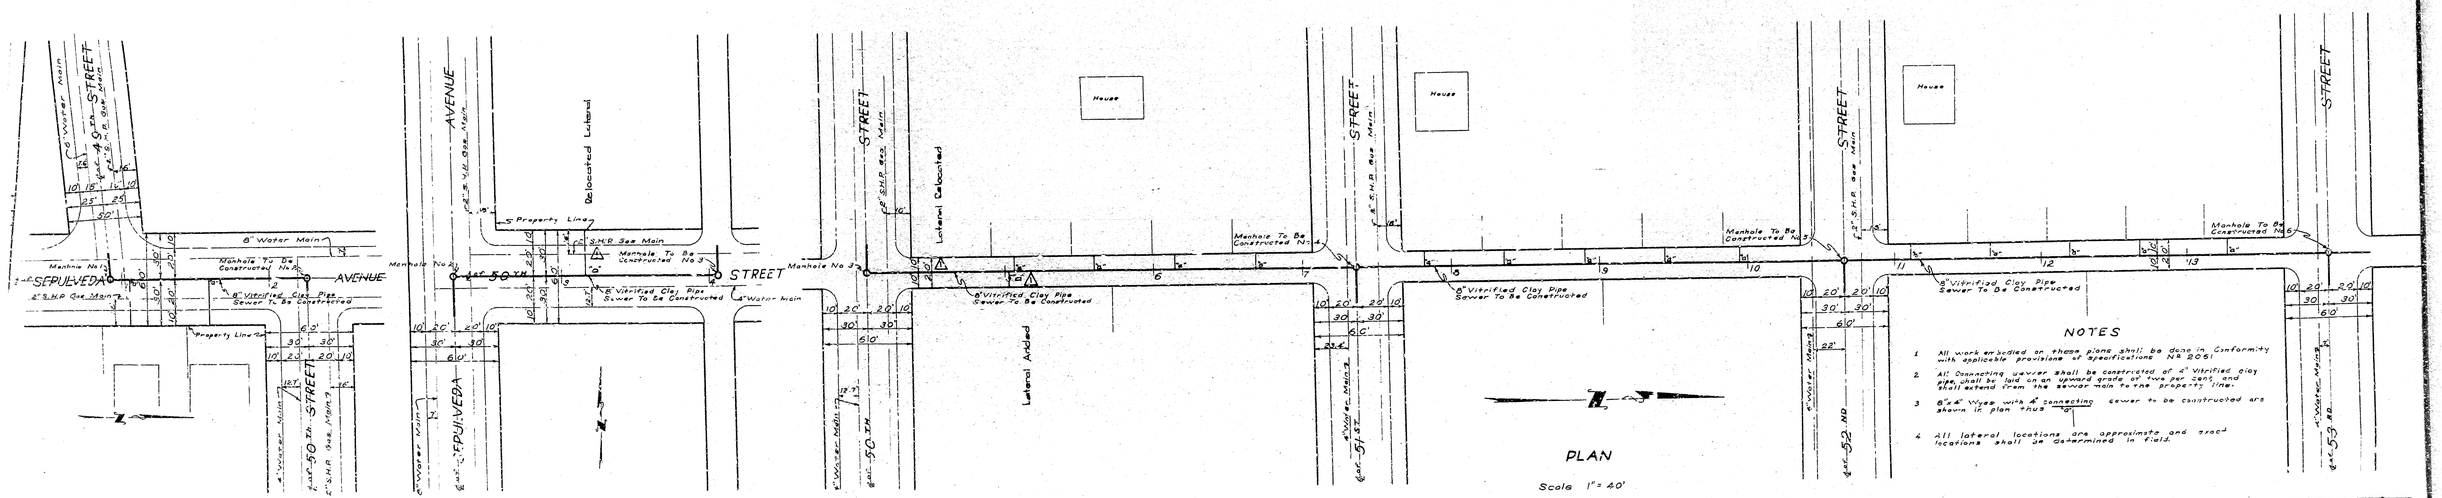

NOTES

1. All work embodied on these plans shall be done in Conformity with applicable provisions of Specifications No. 2061
2. All Connecting sewer shall be constructed of 8" Vitrified clay pipe, shall be laid on an upward grade of two per cent, and shall extend from the sewer main to the property line.
3. 8"x8" Wyes with 8" connecting sewer to be constructed are shown in plan thus "0"
4. All lateral locations are approximate and exact locations shall be determined in field.

1	2	As Constructed	8-10-58
No.	BY	DESIGN	APPROVAL 10-15

DEPARTMENT OF PUBLIC WORKS
CITY OF SAN BERNARDINO

SEWER

49TH ST. SEPULVEDA AVE., & 50TH ST.
ALLEY E. of SEPULVEDA AVE. ~ 50TH St. to Hill Dr.
51ST ST, 52ND ST. & 53RD ST. ~ Alley to 375 E.

Aug 27, '58 W.N.P. 2220

7065 2 1