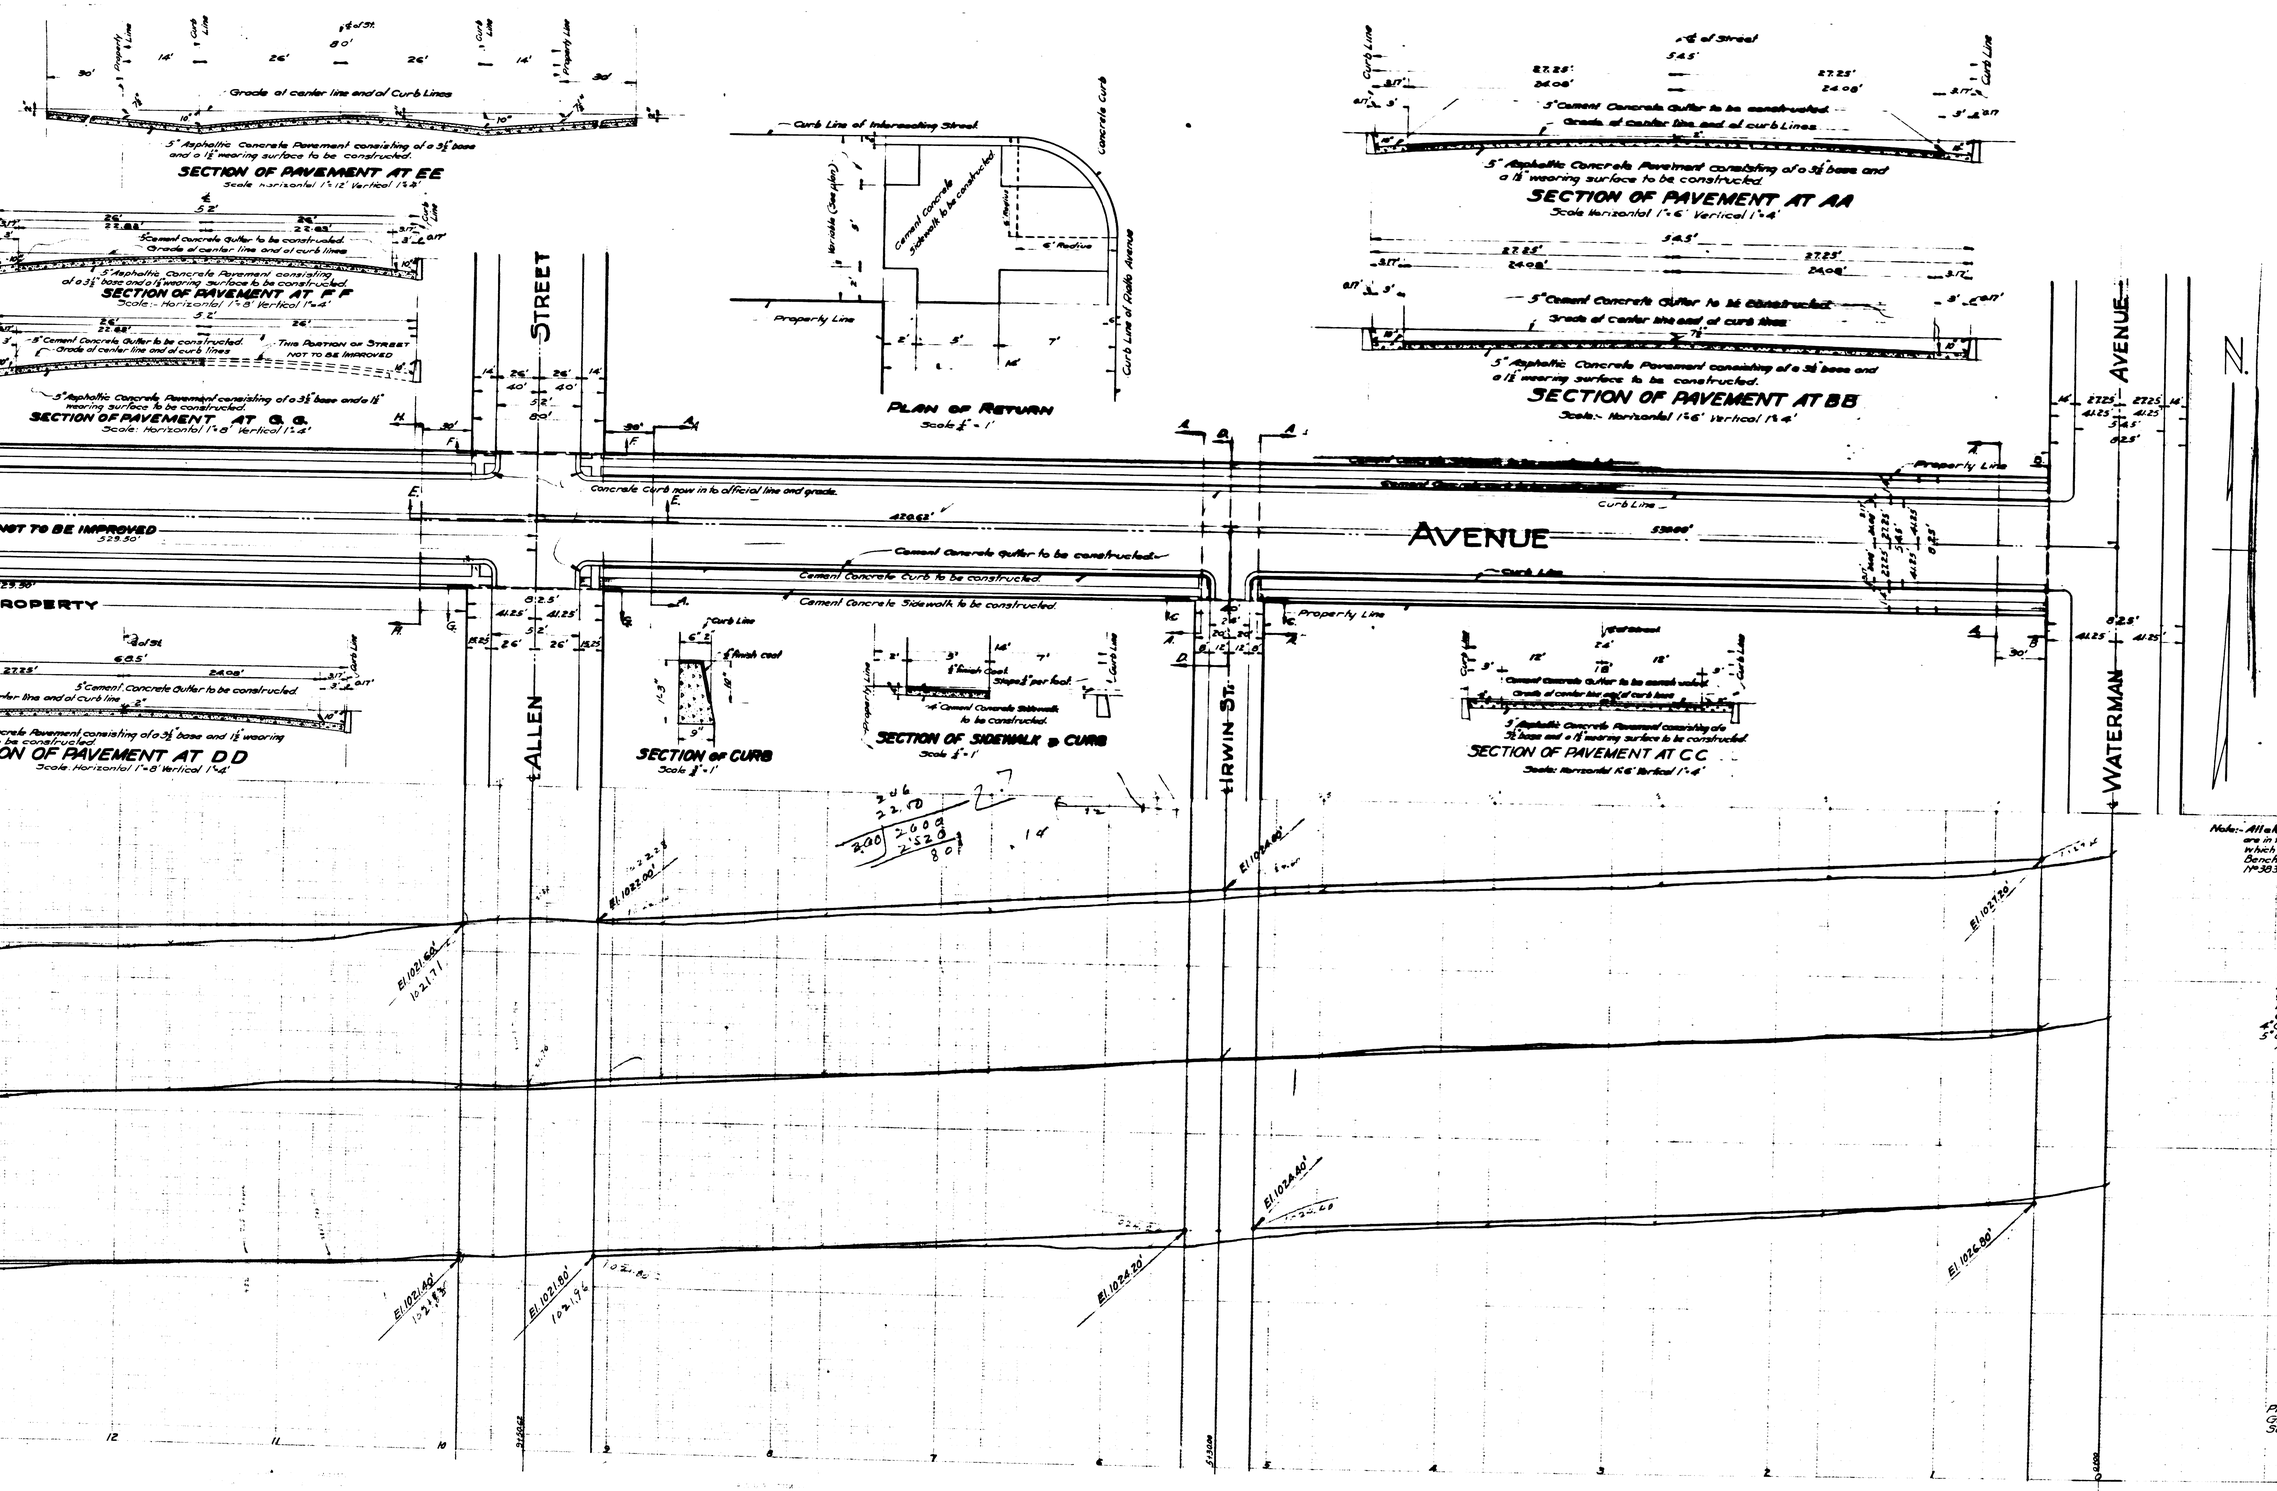
SECTION OF PAVEMENT AT EE
Scale horizontal 1"=12' Vertical 1"=4'
Grade of center line and of Curb Lines
5" Asphaltic Concrete Pavement consisting of a 3½" base and a 1½" wearing surface to be constructed.
SECTION OF PAVEMENT AT FF
Scale:- Horizontal 1"=8' Vertical 1"=4'
5" Cement Concrete Gutter to be constructed.
Grade of center line and of curb lines
THIS PORTION OF STREET NOT TO BE IMPROVED
SECTION OF PAVEMENT AT GG
Scale: Horizontal 1"=8' Vertical 1"=4'
PLAN OF RETURN
Scale ¼" = 1'
Curb Line of Intersecting Street
Concrete Curb
Cement Concrete Sidewalk to be constructed
Property Line
Curb Line of Rialto Avenue
SECTION OF PAVEMENT AT AA
Scale Horizontal 1"=6' Vertical 1"=4'
5" Cement Concrete Gutter to be constructed
SECTION OF PAVEMENT AT BB
Scale:- Horizontal 1"=6' Vertical 1"=4'
STREET
ALLEN
IRWIN ST.
WATERMAN
AVENUE
Concrete Curb now in to official line and grade.
Cement Concrete Gutter to be constructed.
Cement Concrete Curb to be constructed.
Cement Concrete Sidewalk to be constructed.
Property Line
Curb Line
NOT TO BE IMPROVED
PROPERTY
SECTION OF CURB
Scale ¼" = 1'
SECTION OF SIDEWALK & CURB
Scale ¼" = 1'
SECTION OF PAVEMENT AT CC
Scale: Horizontal 1"=6' Vertical 1"=4'
SECTION OF PAVEMENT AT DD
Scale: Horizontal 1"=8' Vertical 1"=4'
El. 1022.00'
El. 1024.40'
El. 1022.70'
El. 1021.60'
El. 1021.40'
El. 1021.90'
El. 1024.20'
El. 1024.80'
PLAN ADOPTED
Title of the City of San Be
San Bernardino as reco
County, California.
-GRAD
Grade of Rialto Avenu
of San Bernardino, Cali
and No 1360 dated 12
Note:- All elevations shown in Red Figures are in feet and are above a plane which is 1045.28 ft below the City Bench Mark established by ordinance No 383 City of San Bernardino California.
—LEGEND—
" or in. means inch or inches.
' or ft. means foot or feet.
No. means number.
St. means Street.
Ave. means Avenue.
℄ means center line.
El. means elevation.
Cement Concrete Curb to be constructed shown
4" Cement Concrete Sidewalk to be constructed shown
5" Cement Concrete Gutter to be constructed shown
Asphaltic Concrete Pavement consisting of a 1½ wea and a 3½" base to be constructed shown thus
—PROFILE LEGEND
Present approximate surface of ground shown
Grade to which work shall be done, shown b
Scale:- Horizontal 1"=40' Vertical 1"=4'

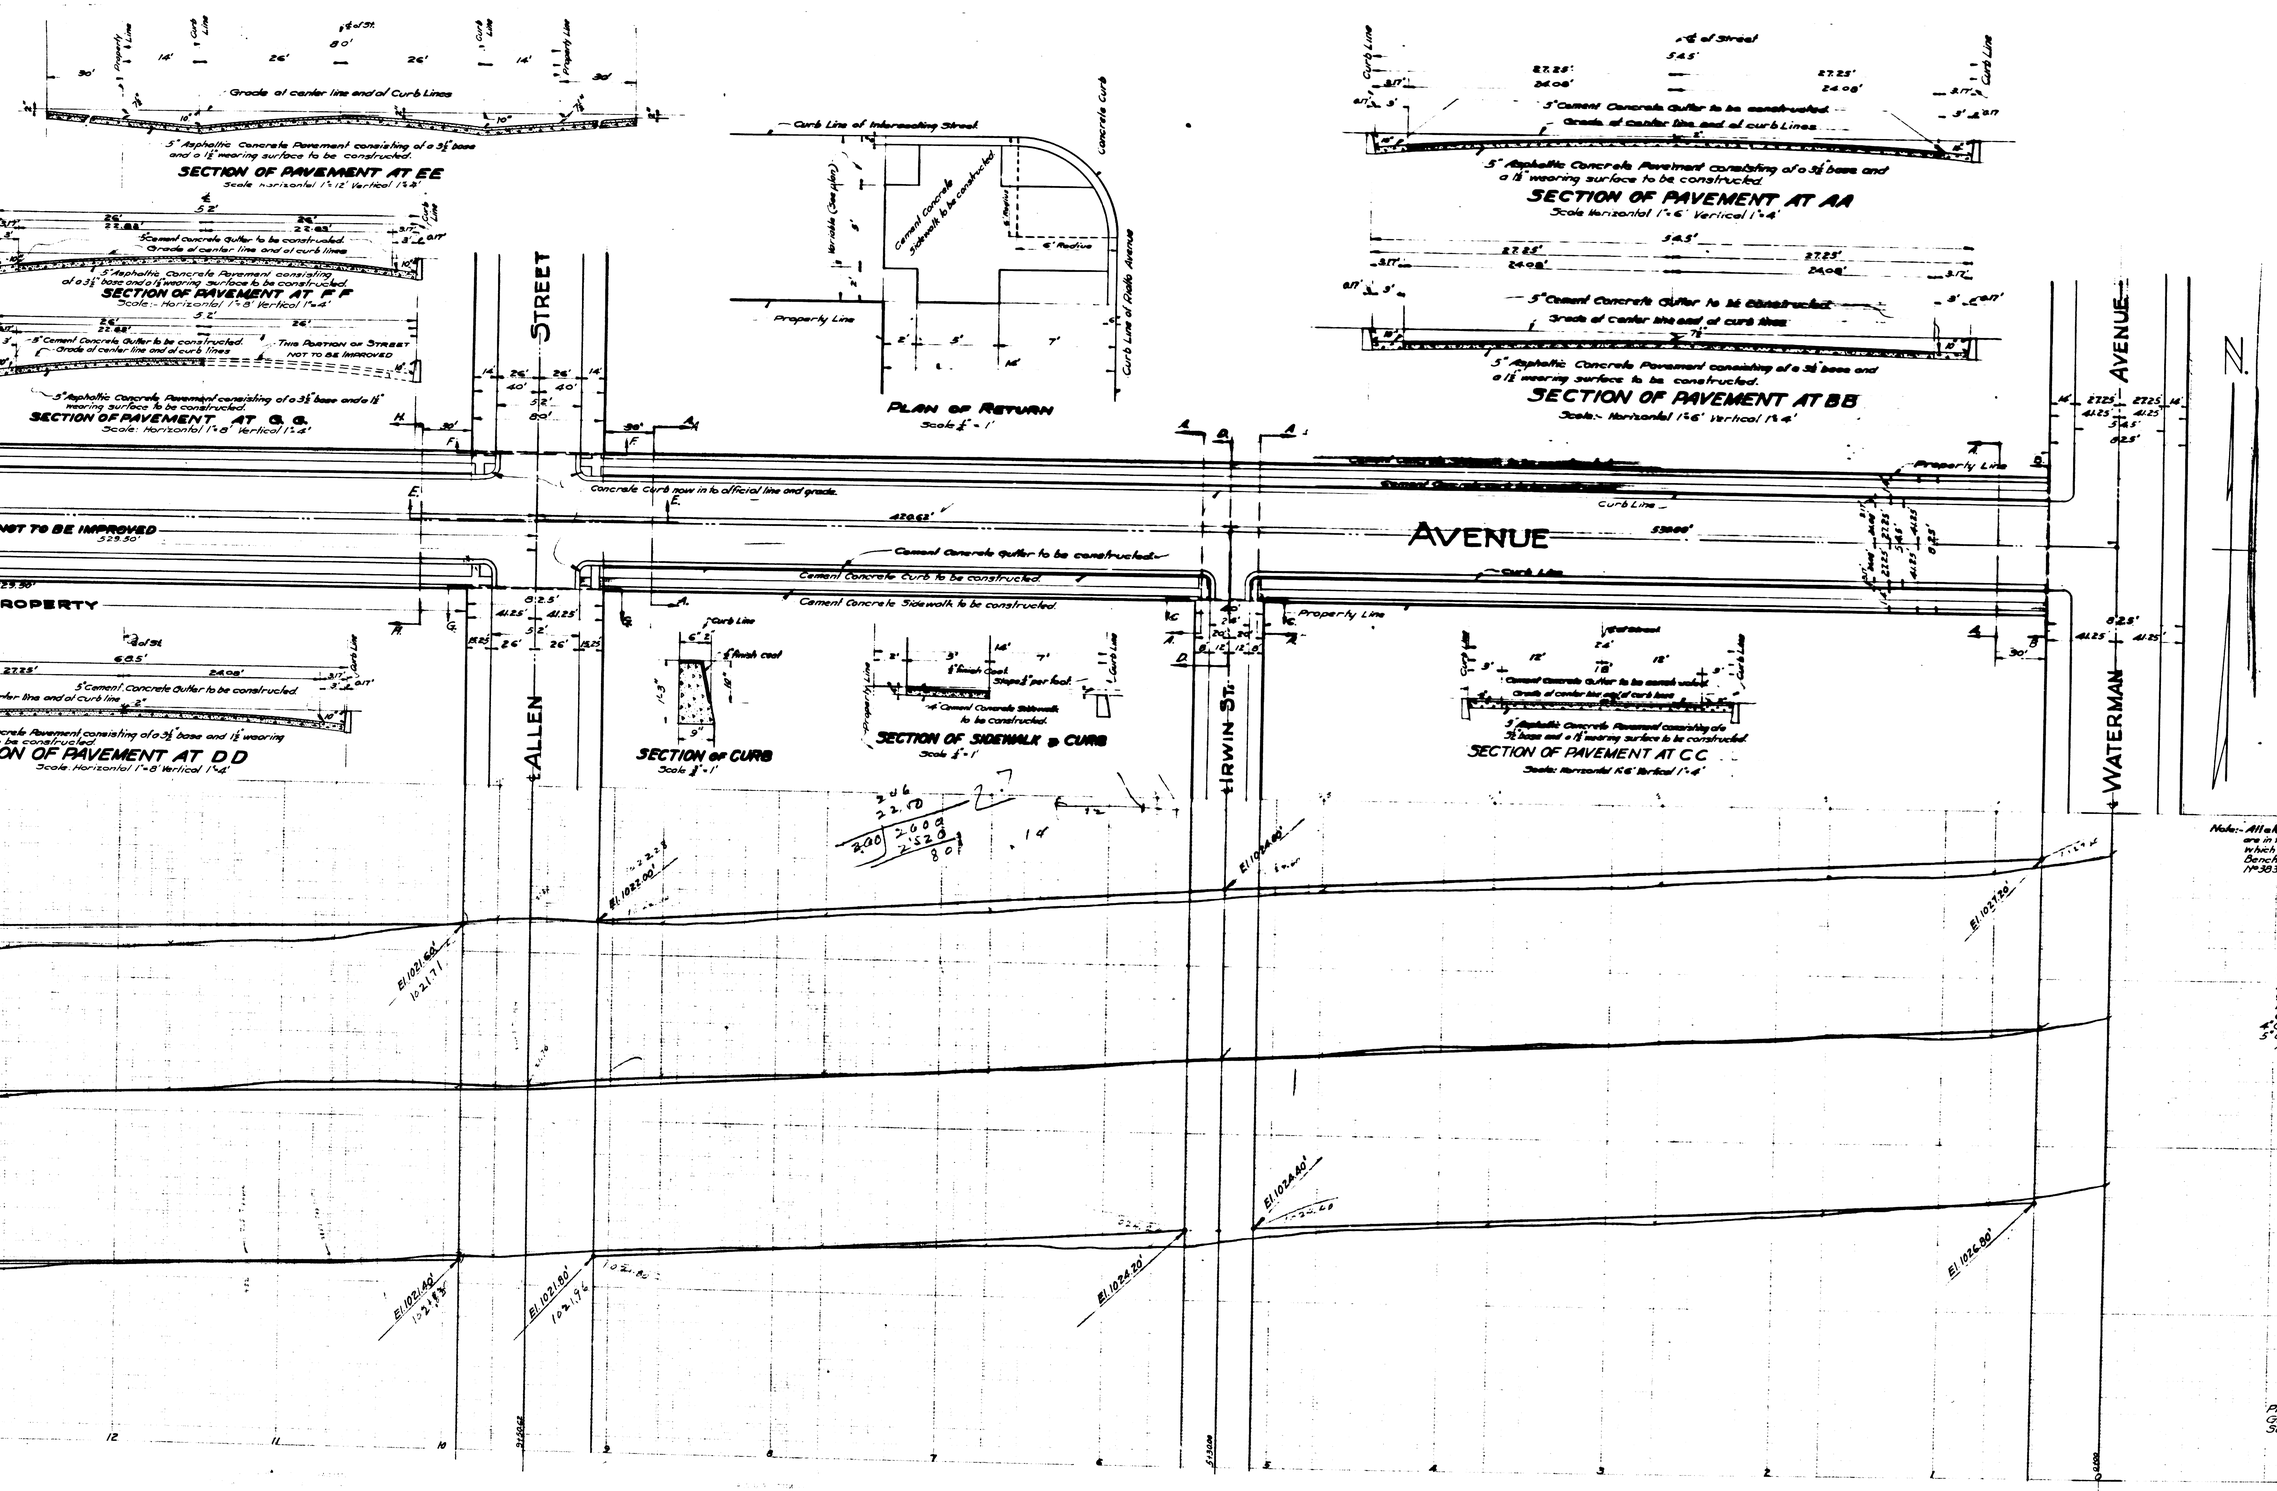
SECTION OF PAVEMENT AT EE
Scale horizontal 1"=12' Vertical 1"=4'
Grade of center line and of Curb Lines
5" Asphaltic Concrete Pavement consisting of a 3½" base and a 1½" wearing surface to be constructed.
SECTION OF PAVEMENT AT FF
Scale:- Horizontal 1"=8' Vertical 1"=4'
5" Cement Concrete Gutter to be constructed.
Grade of center line and of curb lines
THIS PORTION OF STREET NOT TO BE IMPROVED
SECTION OF PAVEMENT AT GG
Scale: Horizontal 1"=8' Vertical 1"=4'
PLAN OF RETURN
Scale ¼" = 1'
Curb Line of Intersecting Street
Concrete Curb
Cement Concrete Sidewalk to be constructed
Property Line
Curb Line of Rialto Avenue
SECTION OF PAVEMENT AT AA
Scale Horizontal 1"=6' Vertical 1"=4'
5" Cement Concrete Gutter to be constructed
SECTION OF PAVEMENT AT BB
Scale:- Horizontal 1"=6' Vertical 1"=4'
STREET
ALLEN
IRWIN ST.
WATERMAN
AVENUE
Concrete Curb now in to official line and grade.
Cement Concrete Gutter to be constructed.
Cement Concrete Curb to be constructed.
Cement Concrete Sidewalk to be constructed.
Property Line
Curb Line
NOT TO BE IMPROVED
PROPERTY
SECTION OF CURB
Scale ¼" = 1'
SECTION OF SIDEWALK & CURB
Scale ¼" = 1'
SECTION OF PAVEMENT AT CC
Scale: Horizontal 1"=6' Vertical 1"=4'
SECTION OF PAVEMENT AT DD
Scale: Horizontal 1"=8' Vertical 1"=4'
El. 1022.00'
El. 1024.40'
El. 1022.70'
El. 1021.60'
El. 1021.40'
El. 1021.90'
El. 1024.20'
El. 1024.80'
PLAN ADOPTED
Title of the City of San Be
San Bernardino as reco
County, California.
-GRAD
Grade of Rialto Avenu
of San Bernardino, Cali
and No 1360 dated 12
Note:- All elevations shown in Red Figures are in feet and are above a plane which is 1045.28 ft below the City Bench Mark established by ordinance No 383 City of San Bernardino California.
—LEGEND—
" or in. means inch or inches.
' or ft. means foot or feet.
No. means number.
St. means Street.
Ave. means Avenue.
℄ means center line.
El. means elevation.
Cement Concrete Curb to be constructed shown
4" Cement Concrete Sidewalk to be constructed shown
5" Cement Concrete Gutter to be constructed shown
Asphaltic Concrete Pavement consisting of a 1½ wea and a 3½" base to be constructed shown thus
—PROFILE LEGEND
Present approximate surface of ground shown
Grade to which work shall be done, shown b
Scale:- Horizontal 1"=40' Vertical 1"=4'