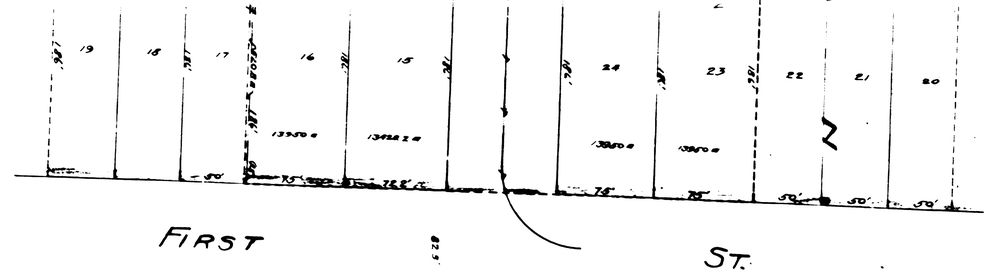


San Bernardino, Cal.
June 20, 1908

Mr. M.P. Conners,
Street Superintendent of the City of San Bernardino.
Dear Sir -

The following is a statement of the amount of sewer work done on H Street by W.G. Ross Company, under Resolution of intention No. 61.

| | | |
|---|---|---|
| 8 inch sewer pipe furnished and laid | 6081 | linear feet |
| 8 inch by 4 inch Wye branches | 192 | |
| 8 inch by 8 inch Wye branch | 1 | |
| Manholes | 8 | |
| Flush tank | 1 | |

I hereby certify that the above work was performed in accordance with lines and grades given by me and that the diagram for the same is correct

A. L. Shaw
City Engineer

| Name | Map No. | Recorded in Book of | at page No. |
|---|---|---|---|
| Diagram of Lots 3, 4, 5 and 6, Block 71 | 3 | | 42 |
| Norton and Hay Subdivision | 16 | | 7 |
| Subdivision of Block 55 | 3 | | 30 |
| Bennetts Subdivision | 3 | | 15 |
| Ward, Courtney and Co. Subdivision | 3 | | 25 |
| The Kingman and Hampson Subdivision | 3 | | 81 |
| J.M. Hurley Subdivision | 13 | | 11 |
| Harris Subdivision | 16 | | 8 |
| Waters Subdivision | 6 | | 47 |
| Plan of the City of San Bernardino | 7 | | 1 |

At the said City of San Bernardino, this 25th day of June, A.D. 1908.

M P Conners
Street Superintendent of the City of San Bernardino.

Recorded

M P Conners
Street Superintendent of the City of San Bernardino.

Diagram

Exhibiting the district declared by the Mayor and Common Council of the City of San Bernardino to be benefited by the construction of a sewer with Wye branches, etc., in H Street, from a manhole in the center line of First Street 20 feet east of the east line of H Street; thence by a curve 94 feet long to a point in the center line of H Street 20 feet north of the north line of First Street; thence north along the center line of H Street to a point forty (40) feet south of the south line of Tenth Street, in the city of San Bernardino as specified in Resolution of Intention No. 61 and to be assessed to pay the cost and expense thereof. Said sewer has been constructed under my official contract as Street Superintendent of said City with W.G. Ross Company dated April 21, 1908, for the construction of a sewer, etc., as more particularly described in said contract, to which reference is hereby made. This diagram shows each separate lot, portion of lot, piece or parcel of land, the area in square feet of each of said lots, portions of lots, pieces or parcels of land, and the relative location of the same to the work done; all within the limits of the assessment district, numbered in red ink to correspond with the red ink numbers in the assessment.

Herein the line of sewer with Wye branches constructed is shown thus ——— Manholes are shown thus O. Flush tanks are shown thus O. The exterior boundary of the district to be assessed is shown thus - - - - - The mark ' means feet. The mark □ means square feet. Figures in black followed by the character □ show the area in square feet of each lot, portion of lot, piece or parcel of land.

The lands covered by the assessment are shown on the maps, recorded in the office of the County Recorder of San Bernardino County, California, in the books, and at the pages indicated, of the following named subdivisions:-

Resolution No. 72

Resolution of the Mayor and Common Council of the City of San Bernardino, approving the diagram of the property benefited by the improvement described in Resolution of Intention No 61

Resolved, By the Mayor and Common Council of the City of San Bernardino in open session on this 25th day of June, 1908, that the diagram made by the City Engineer, of the property benefited by the improvement described in Resolution of Intention No. 61, of the Mayor and Common Council of the City of San Bernardino, pursuant to the Resolution of this Mayor and Common Council, and this day presented, be and the same is hereby approved.

I hereby certify that the foregoing resolution was adopted by the Mayor and Common Council of the City of San Bernardino at a meeting thereof held on the 25th day of June, 1908, by the following vote, to wit:-

Ayes: Wixom, Dungan, Irving & Hagerman

Noes: None.

Harry Allison
City Clerk.

I hereby approve the foregoing resolution this 26th day of June, 1908.

J. Hunton
Mayor of the City of San Bernardino.