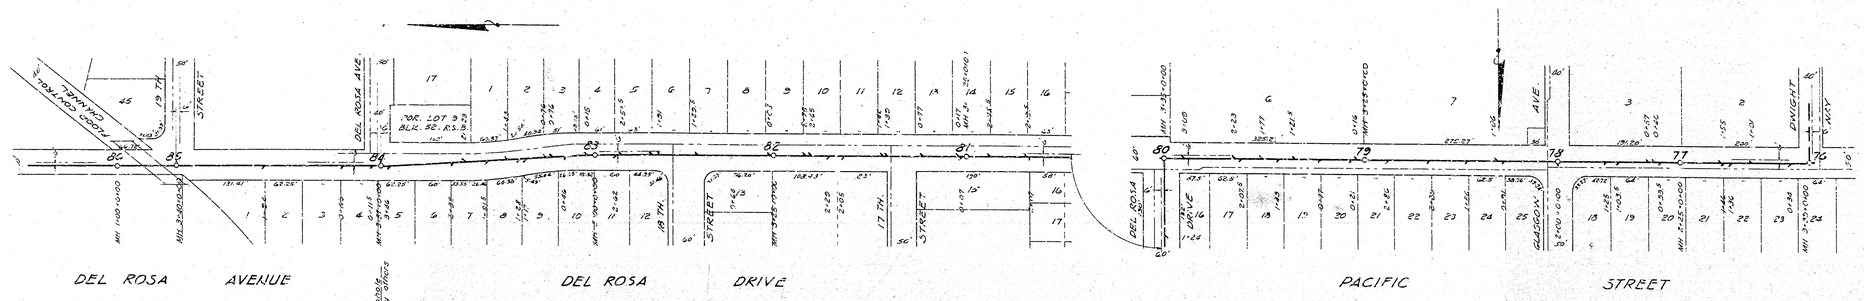

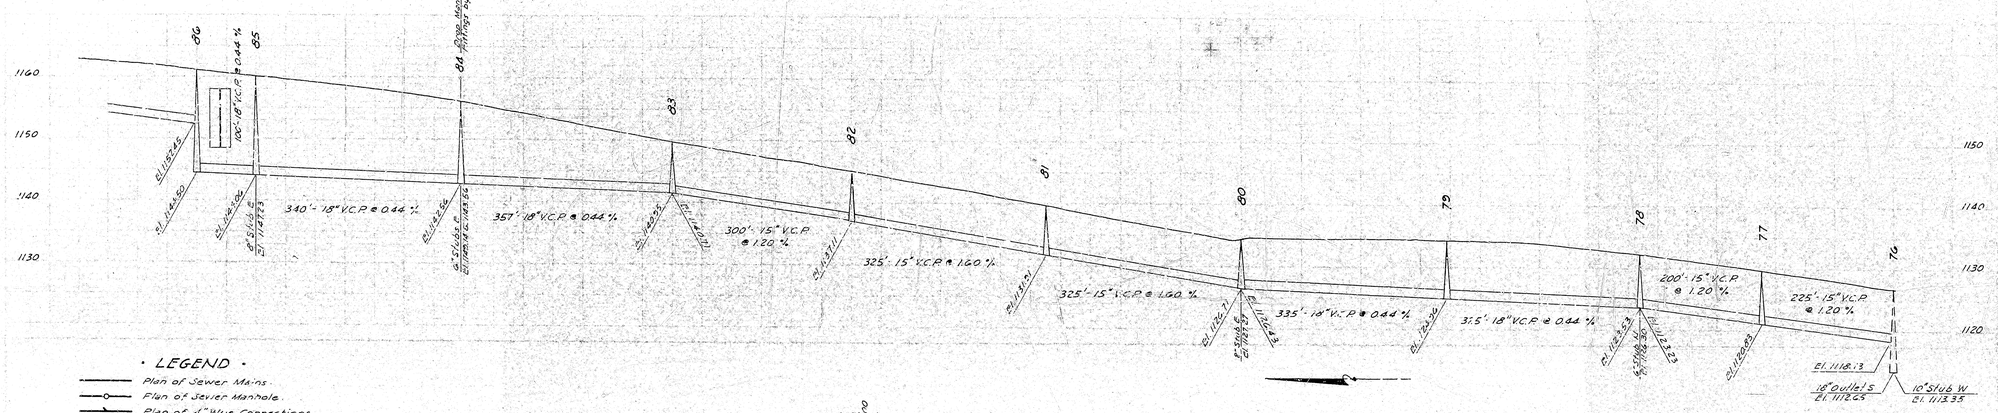

· LEGEND ·

- Plan of Sewer Mains.
- Plan of Sewer Manhole.
- Plan of 6" Wye Connections.
- Plan of Sewer Stub or Drop
- Plan of Existing Sewers.
- Profile of Ground Elevation.
- Profile of Sewer Manhole.
- Profile of Sewer Main.
- El. 1150.20 — Elevation of Sewer Invert.
- V.C.P. — Vitrified Clay Pipe.
- R.C.P. — Reinforced Concrete Pipe.

NOTE –
Where trench excavation is below existing house connection or other sewers, backfill shall be thoroughly compacted beneath the connection before backfill is placed over it.

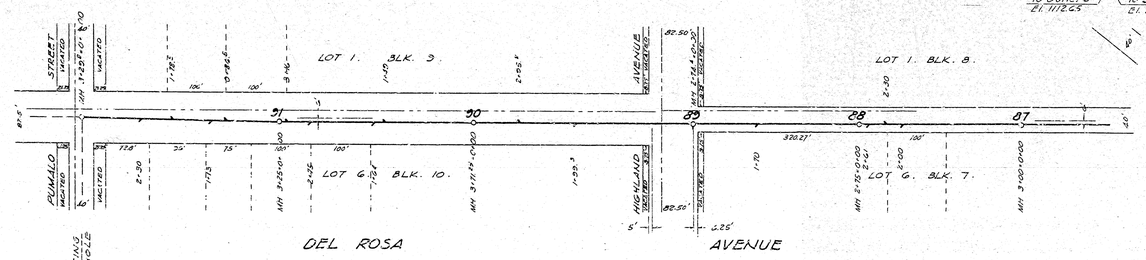

NOTE –
Existing manhole at Pumallo & Del Rosa is a brick drop manhole with a 3" concrete false floor at El. 1177.70. Contractor to remove false floor, sand fill and plug in drop pipe.

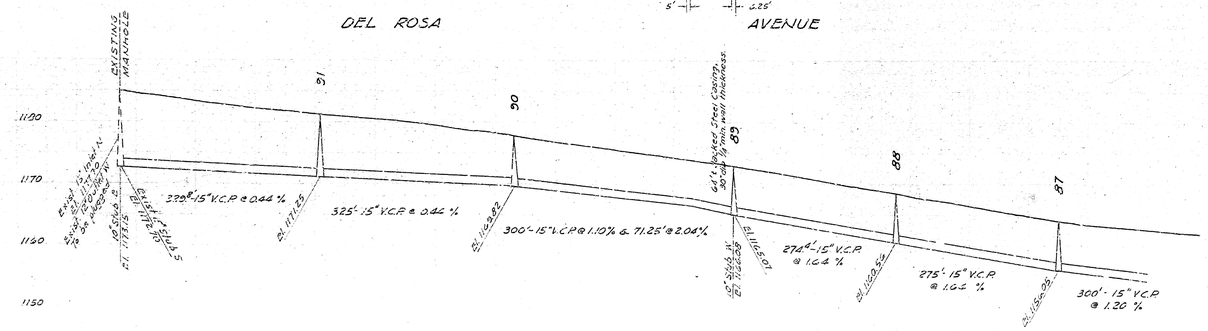

Revised "As Built" Mar. 6, 1952

PLANS & PROFILES – INTERCEPTING SEWERS
SAN BERNARDINO, CALIFORNIA. SHEET 9.
CURRIE ENGINEERING COMPANY

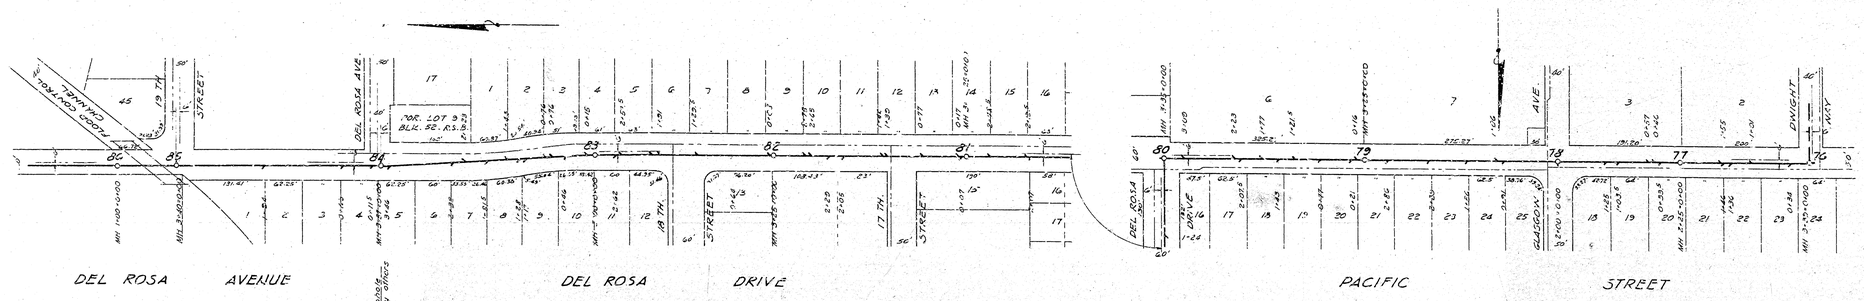

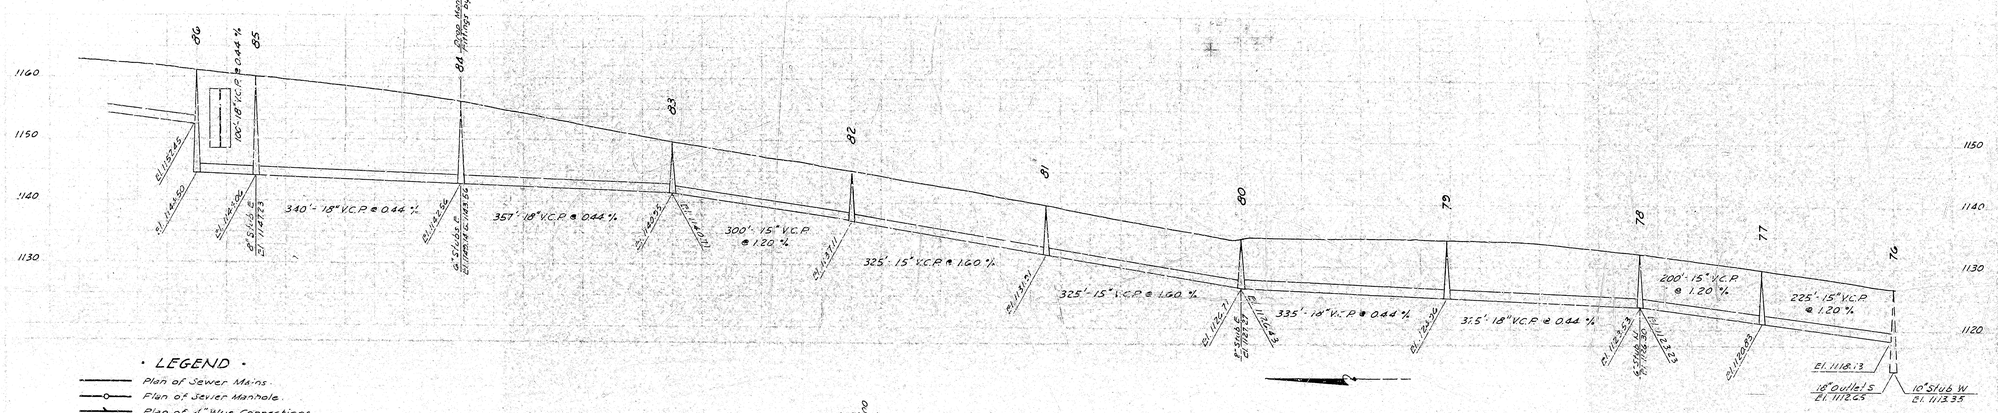

· LEGEND ·

- Plan of Sewer Mains.
- Plan of Sewer Manhole.
- Plan of 6" Wye Connections.
- Plan of Sewer Stub or Drop
- Plan of Existing Sewers.
- Profile of Ground Elevation.
- Profile of Sewer Manhole.
- Profile of Sewer Main.
- El. 1150.20 — Elevation of Sewer Invert.
- V.C.P. — Vitrified Clay Pipe.
- R.C.P. — Reinforced Concrete Pipe.

NOTE –
Where trench excavation is below existing house connection or other sewers, backfill shall be thoroughly compacted beneath the connection before backfill is placed over it.

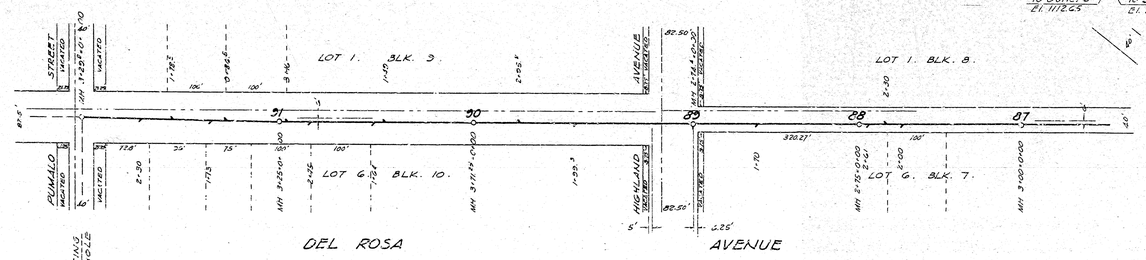

NOTE –
Existing manhole at Pumallo & Del Rosa is a brick drop manhole with a 3" concrete false floor at El. 1177.70. Contractor to remove false floor, sand fill and plug in drop pipe.

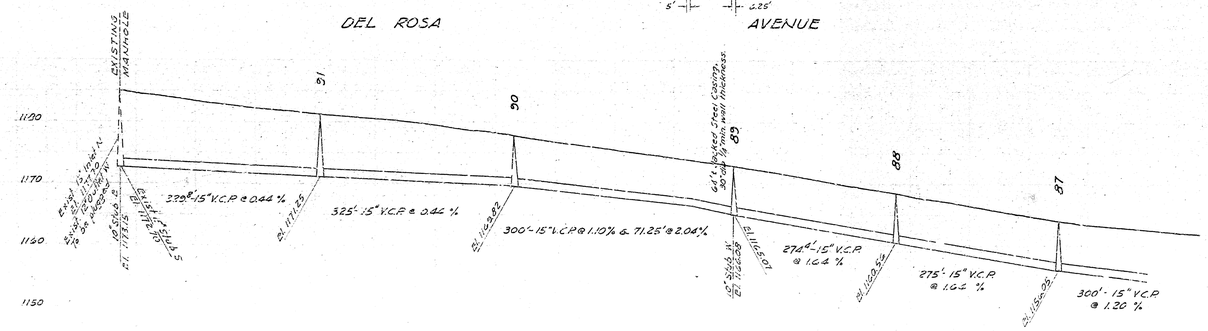

Revised "As Built" Mar. 6, 1952

PLANS & PROFILES – INTERCEPTING SEWERS
SAN BERNARDINO, CALIFORNIA. SHEET 9.
CURRIE ENGINEERING COMPANY