
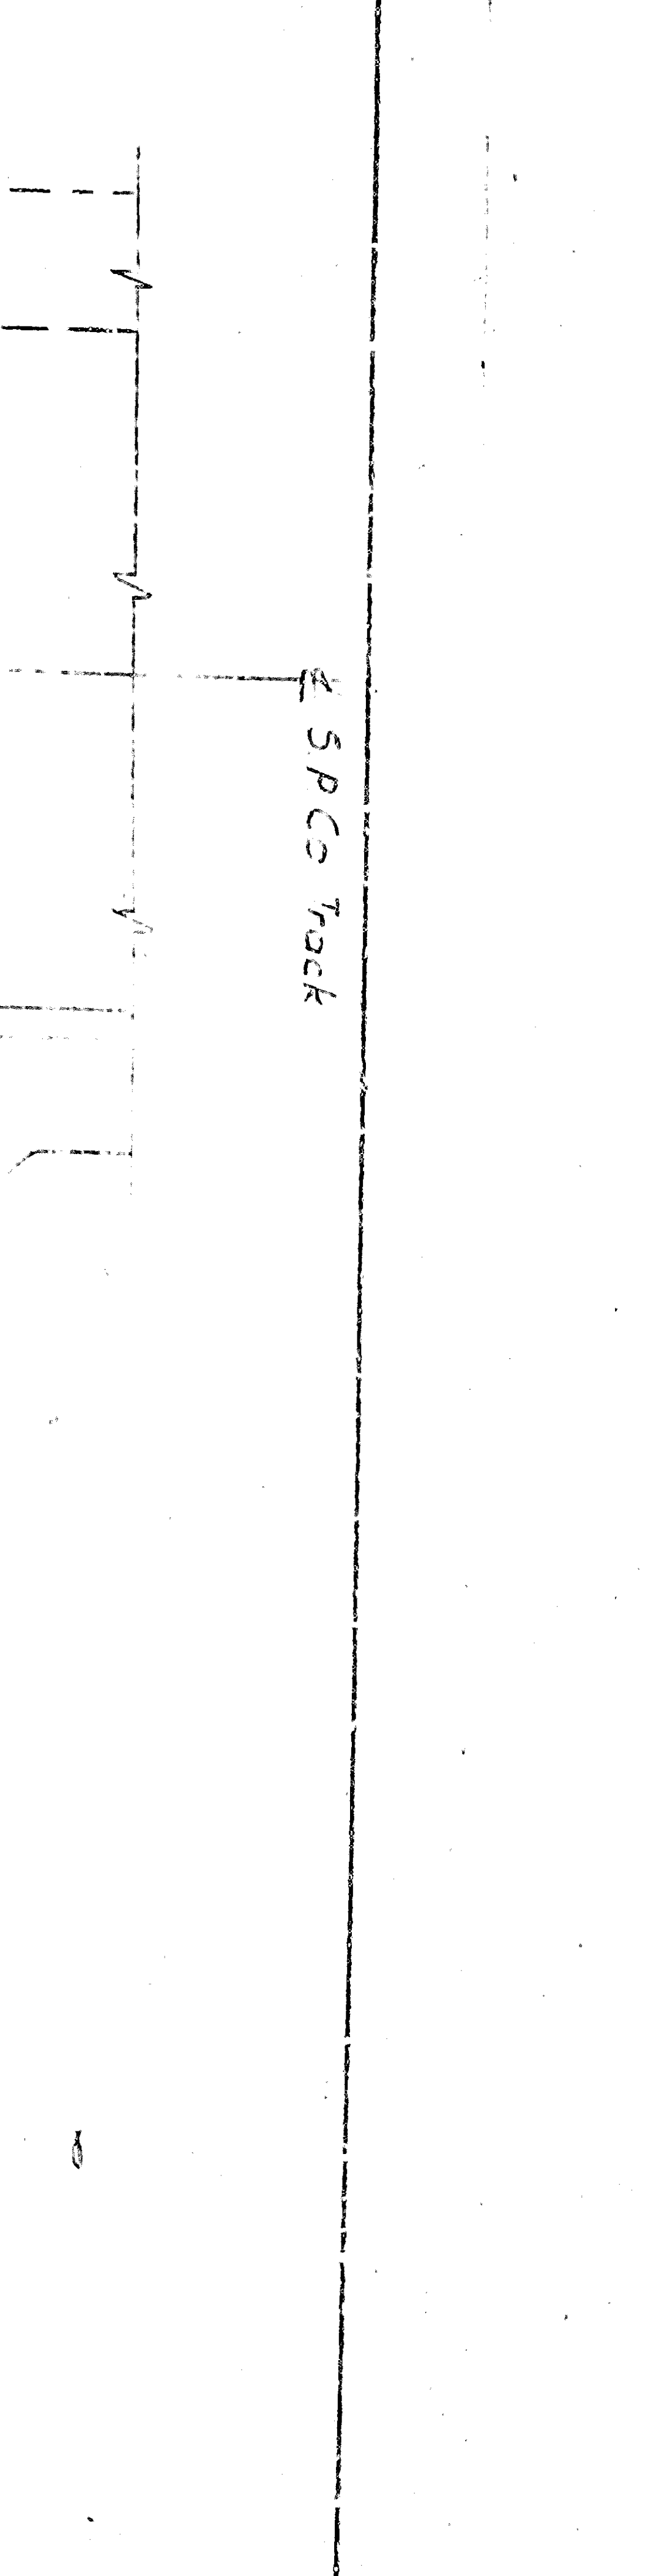
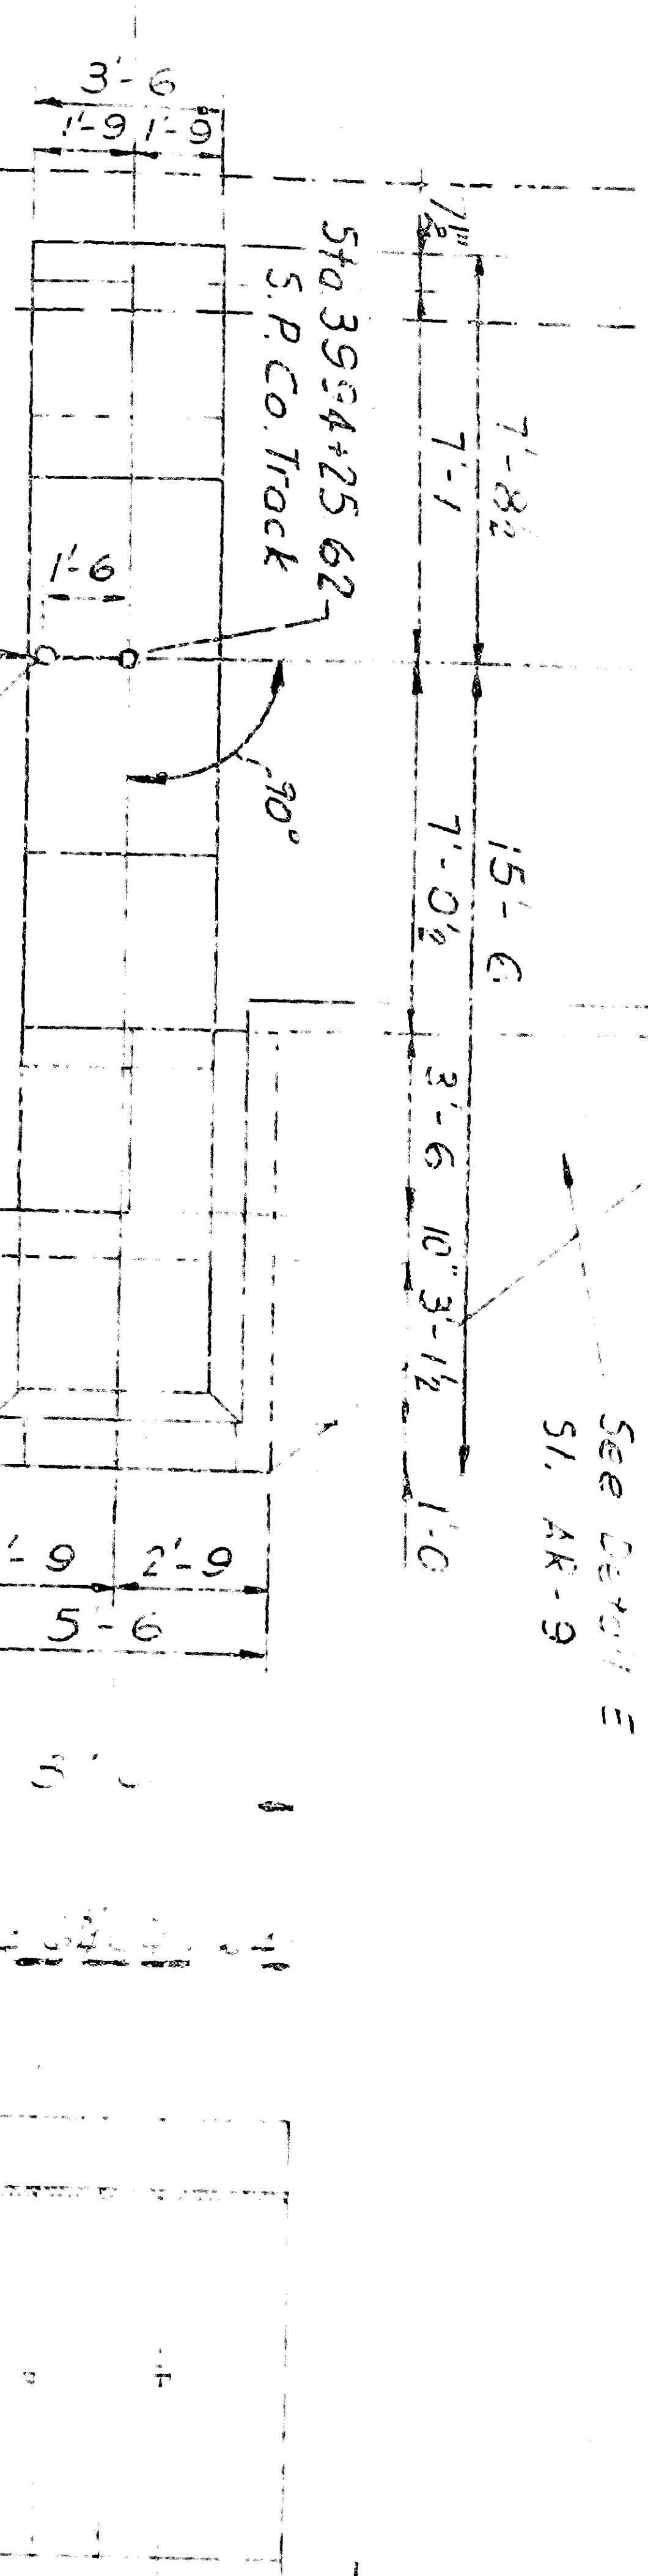
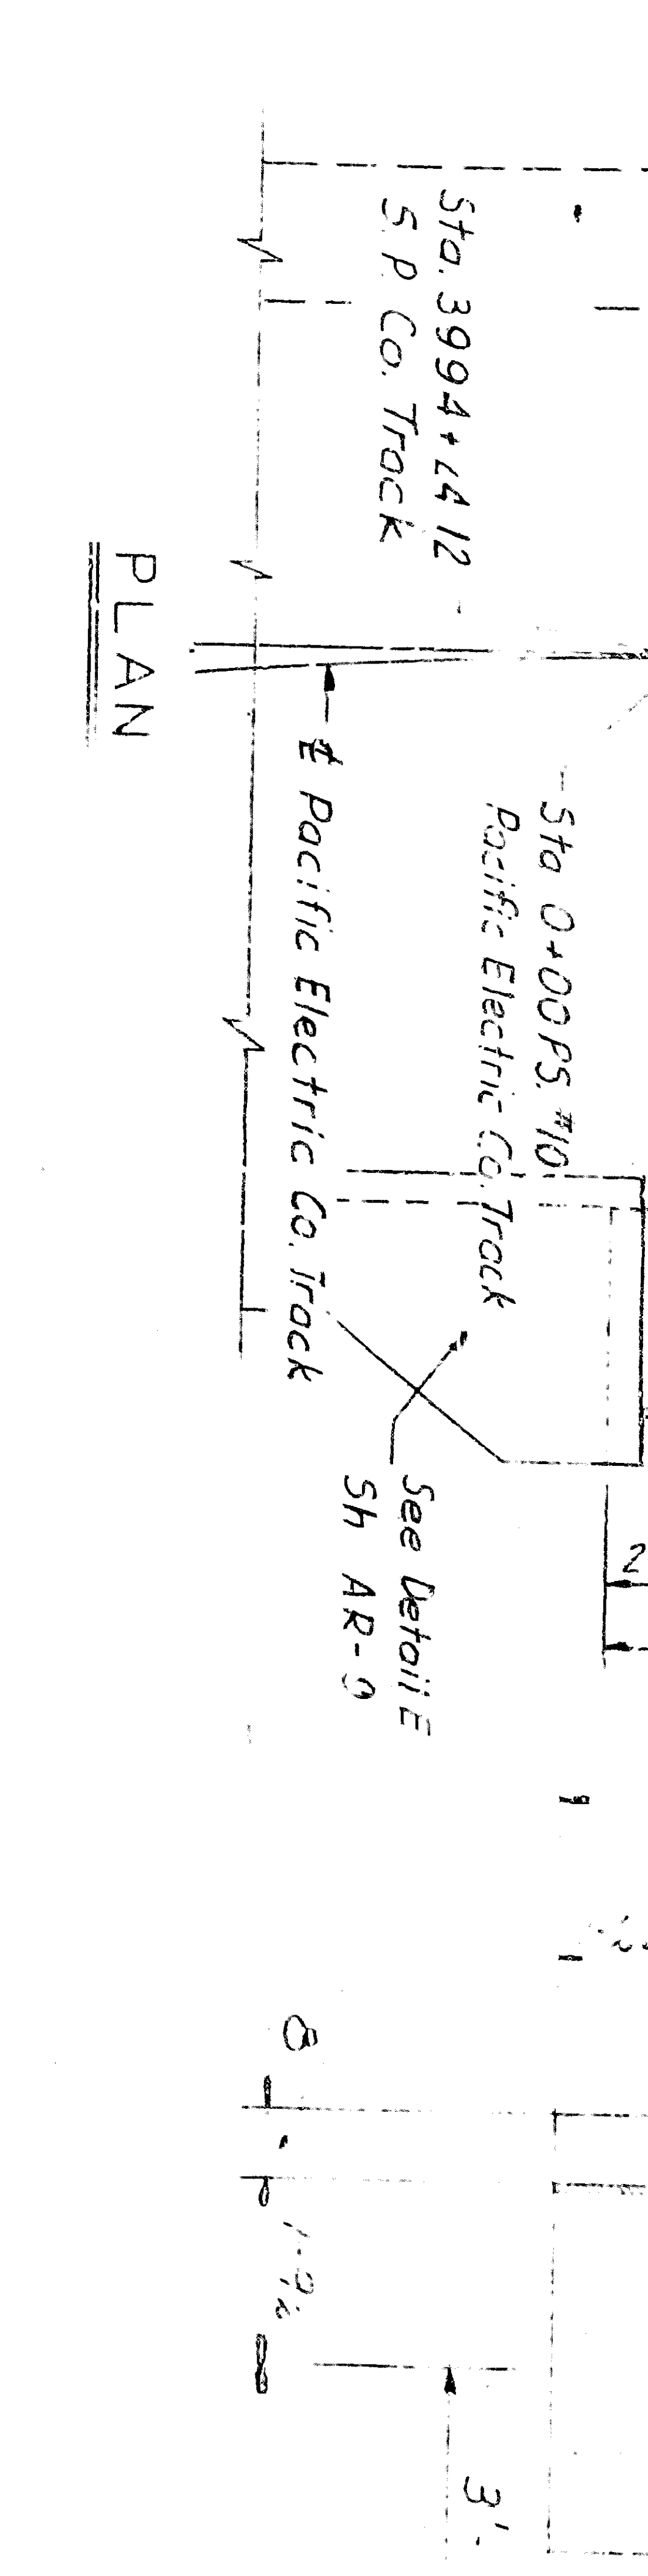
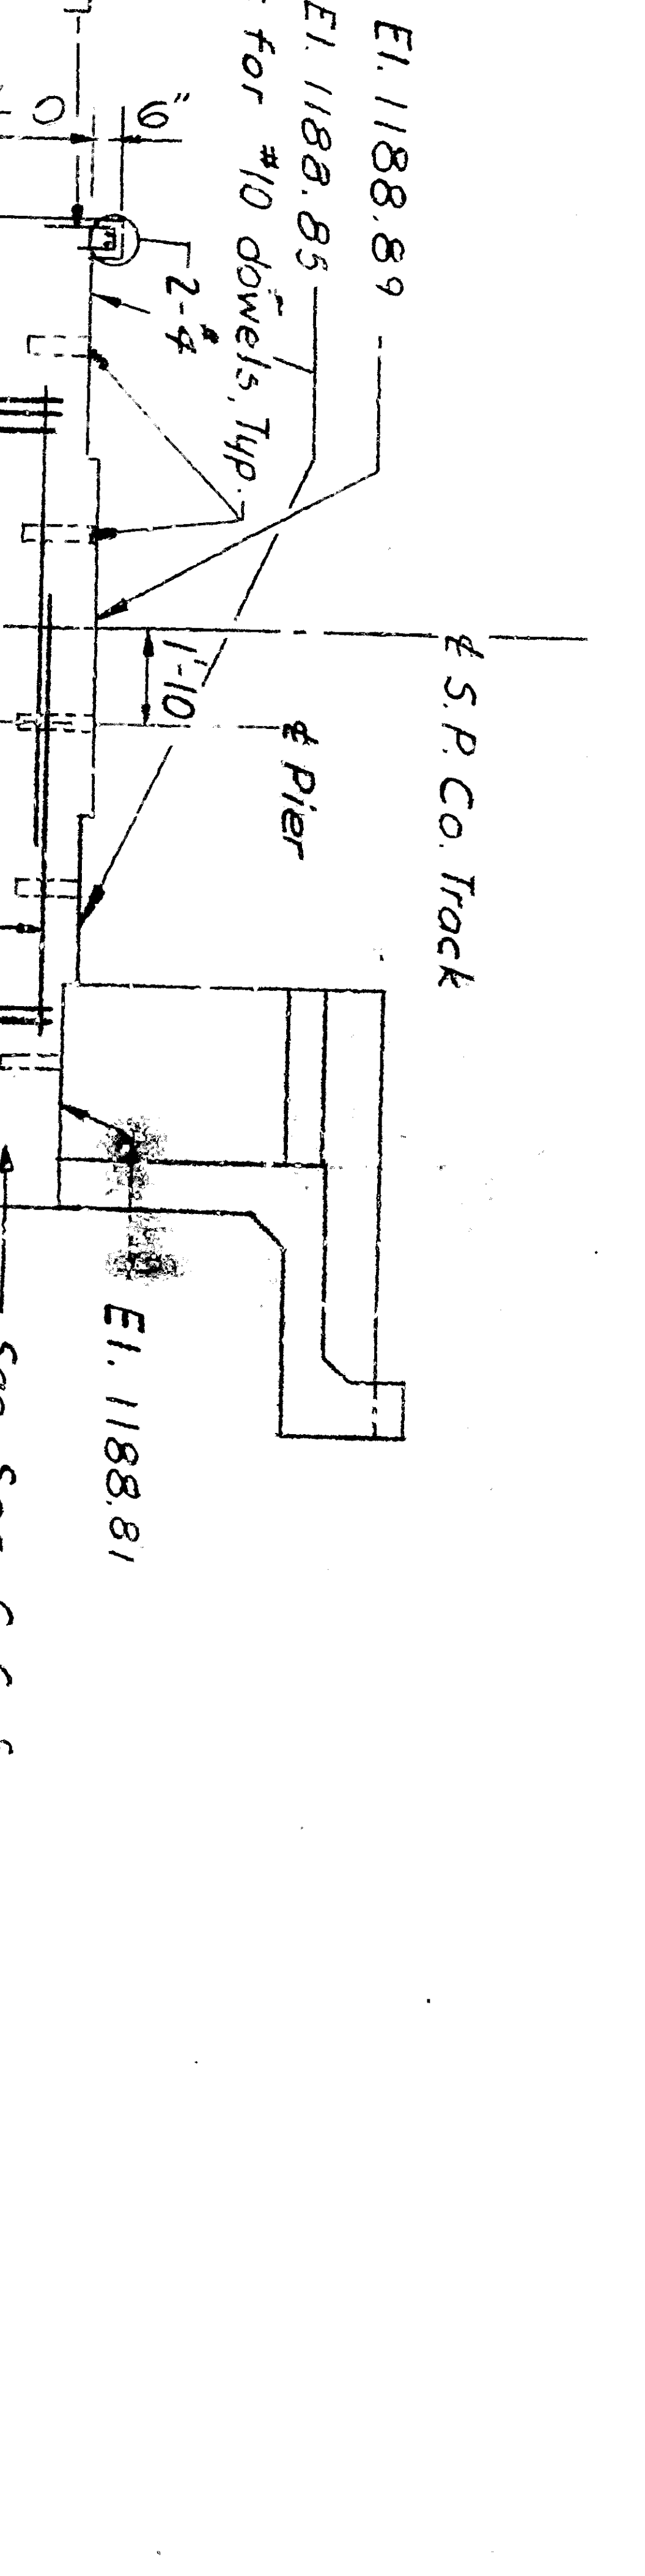
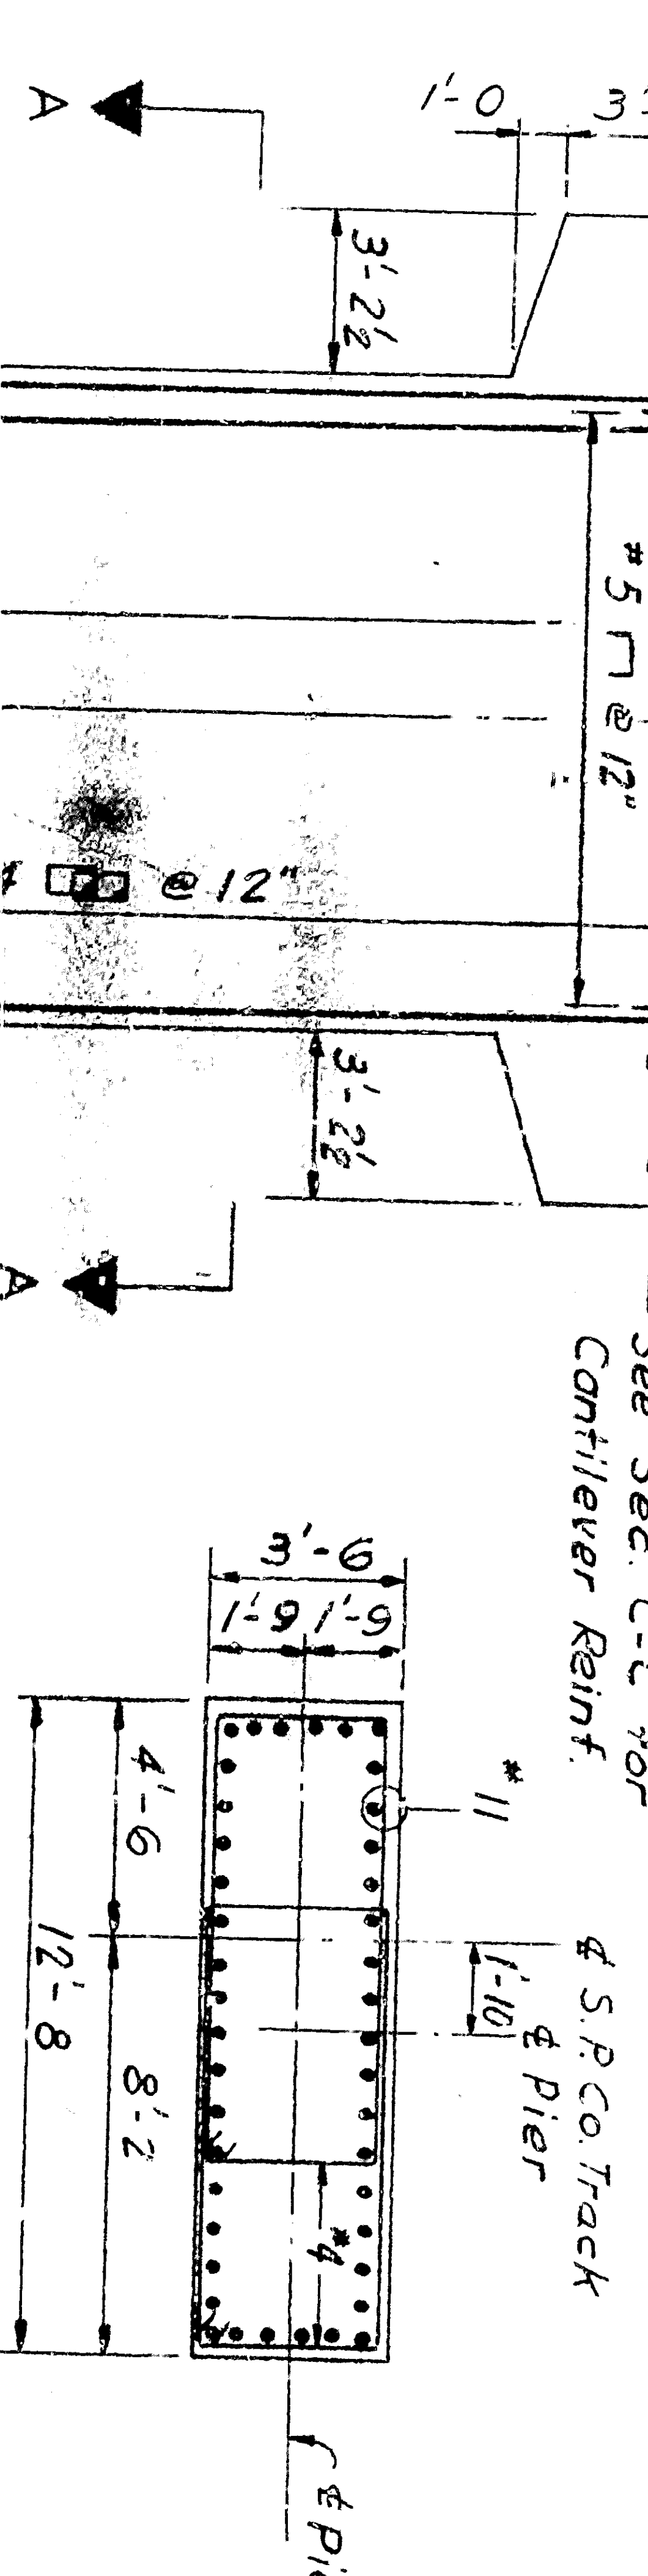


DESIGNED BY  
 DRAWN BY  
 CHECKED BY  
 APPROVED BY

U. G. GARDNER  
 J. A. HART  
 J. A. HART  
 J. A. HART

ELEVATION

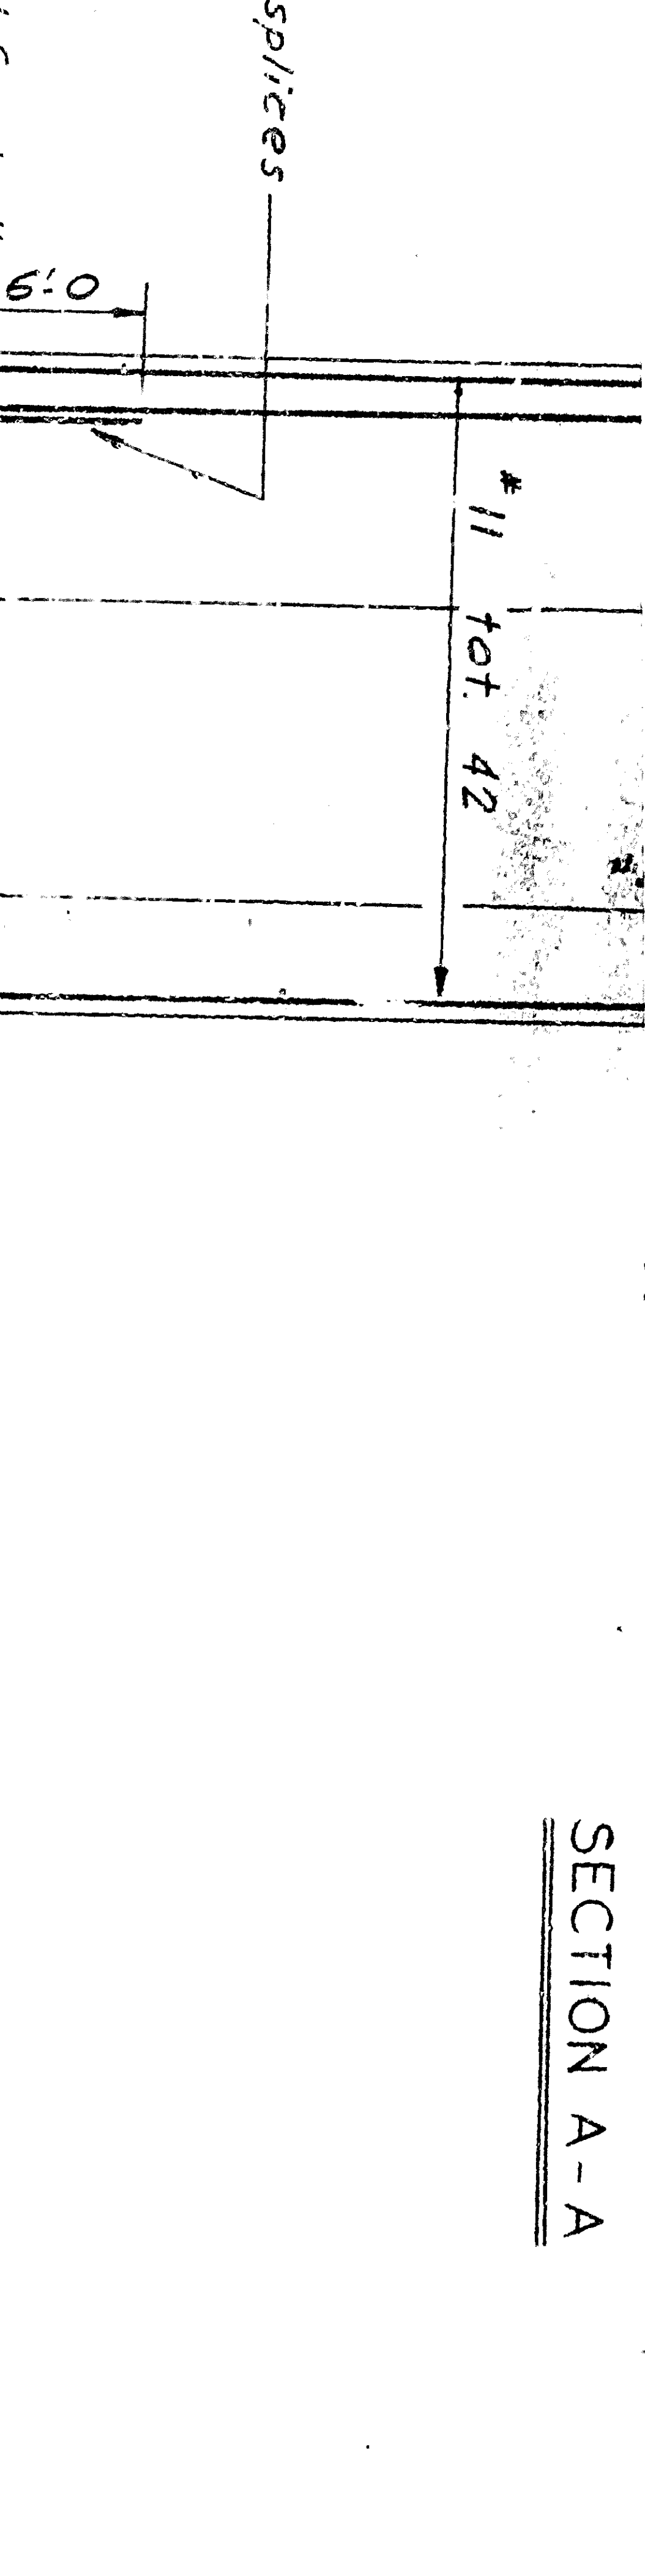

REVISIONS

REV.	DESCRIPTION	DATE	BY
1	Check & correct dimensions	5/24/48	JAG
2	Revised Pier Elevations	5/24/48	JAG

AS BUILT







CITY OF SAN BERNARDINO  
 ARROW ROUTE-RIALTO AVE. UNDERPASS  
 BRIDGE W/P 4900  
 PIER No 2

SOUTHERN PACIFIC COMPANY  
 PACIFIC LINES

DE LEUW, CATHERS & COMPANY  
 ENGINEERS  
 SAN FRANCISCO, CALIFORNIA

SHEET NO. 6  
 OF 6  
 DATE 5/24/48






PLAN

   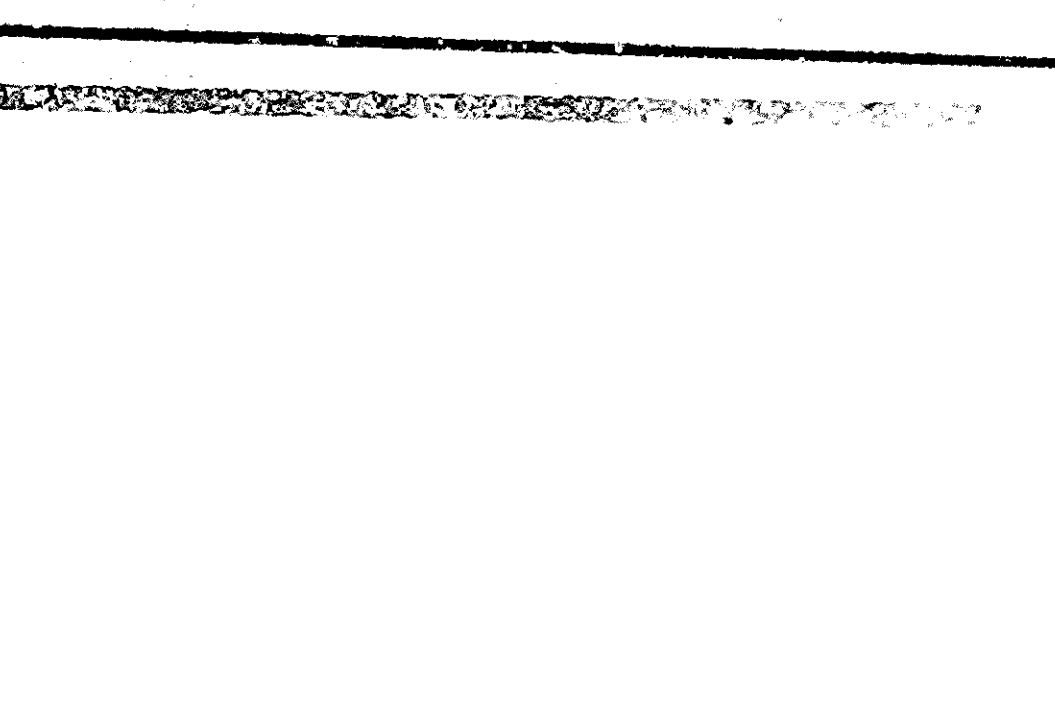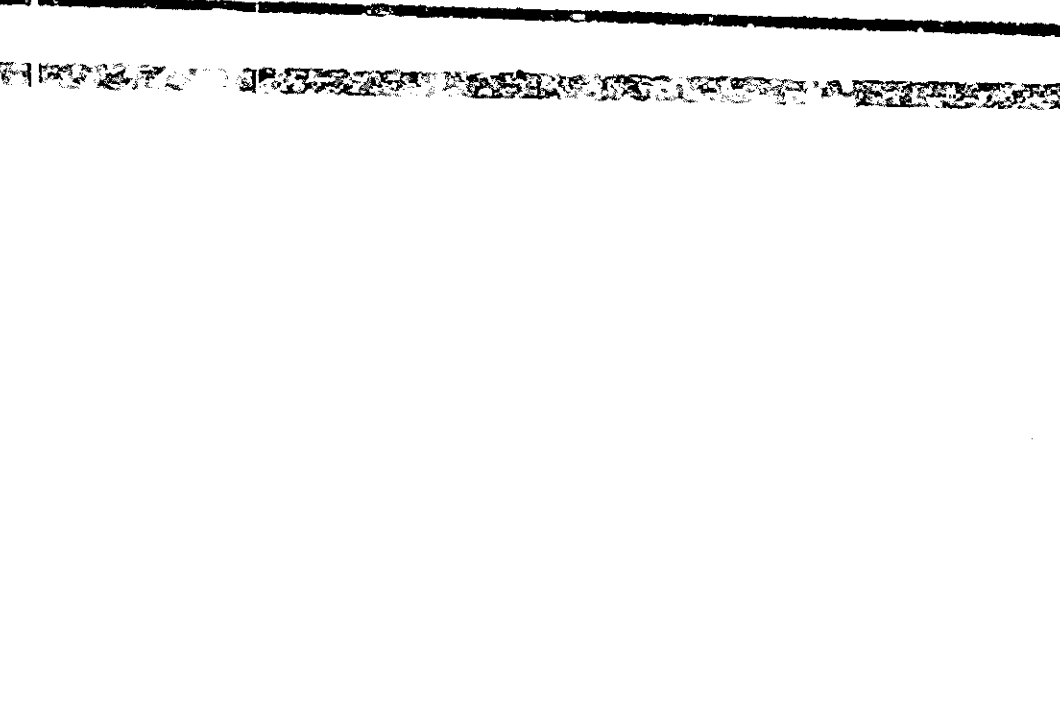 

PLAN





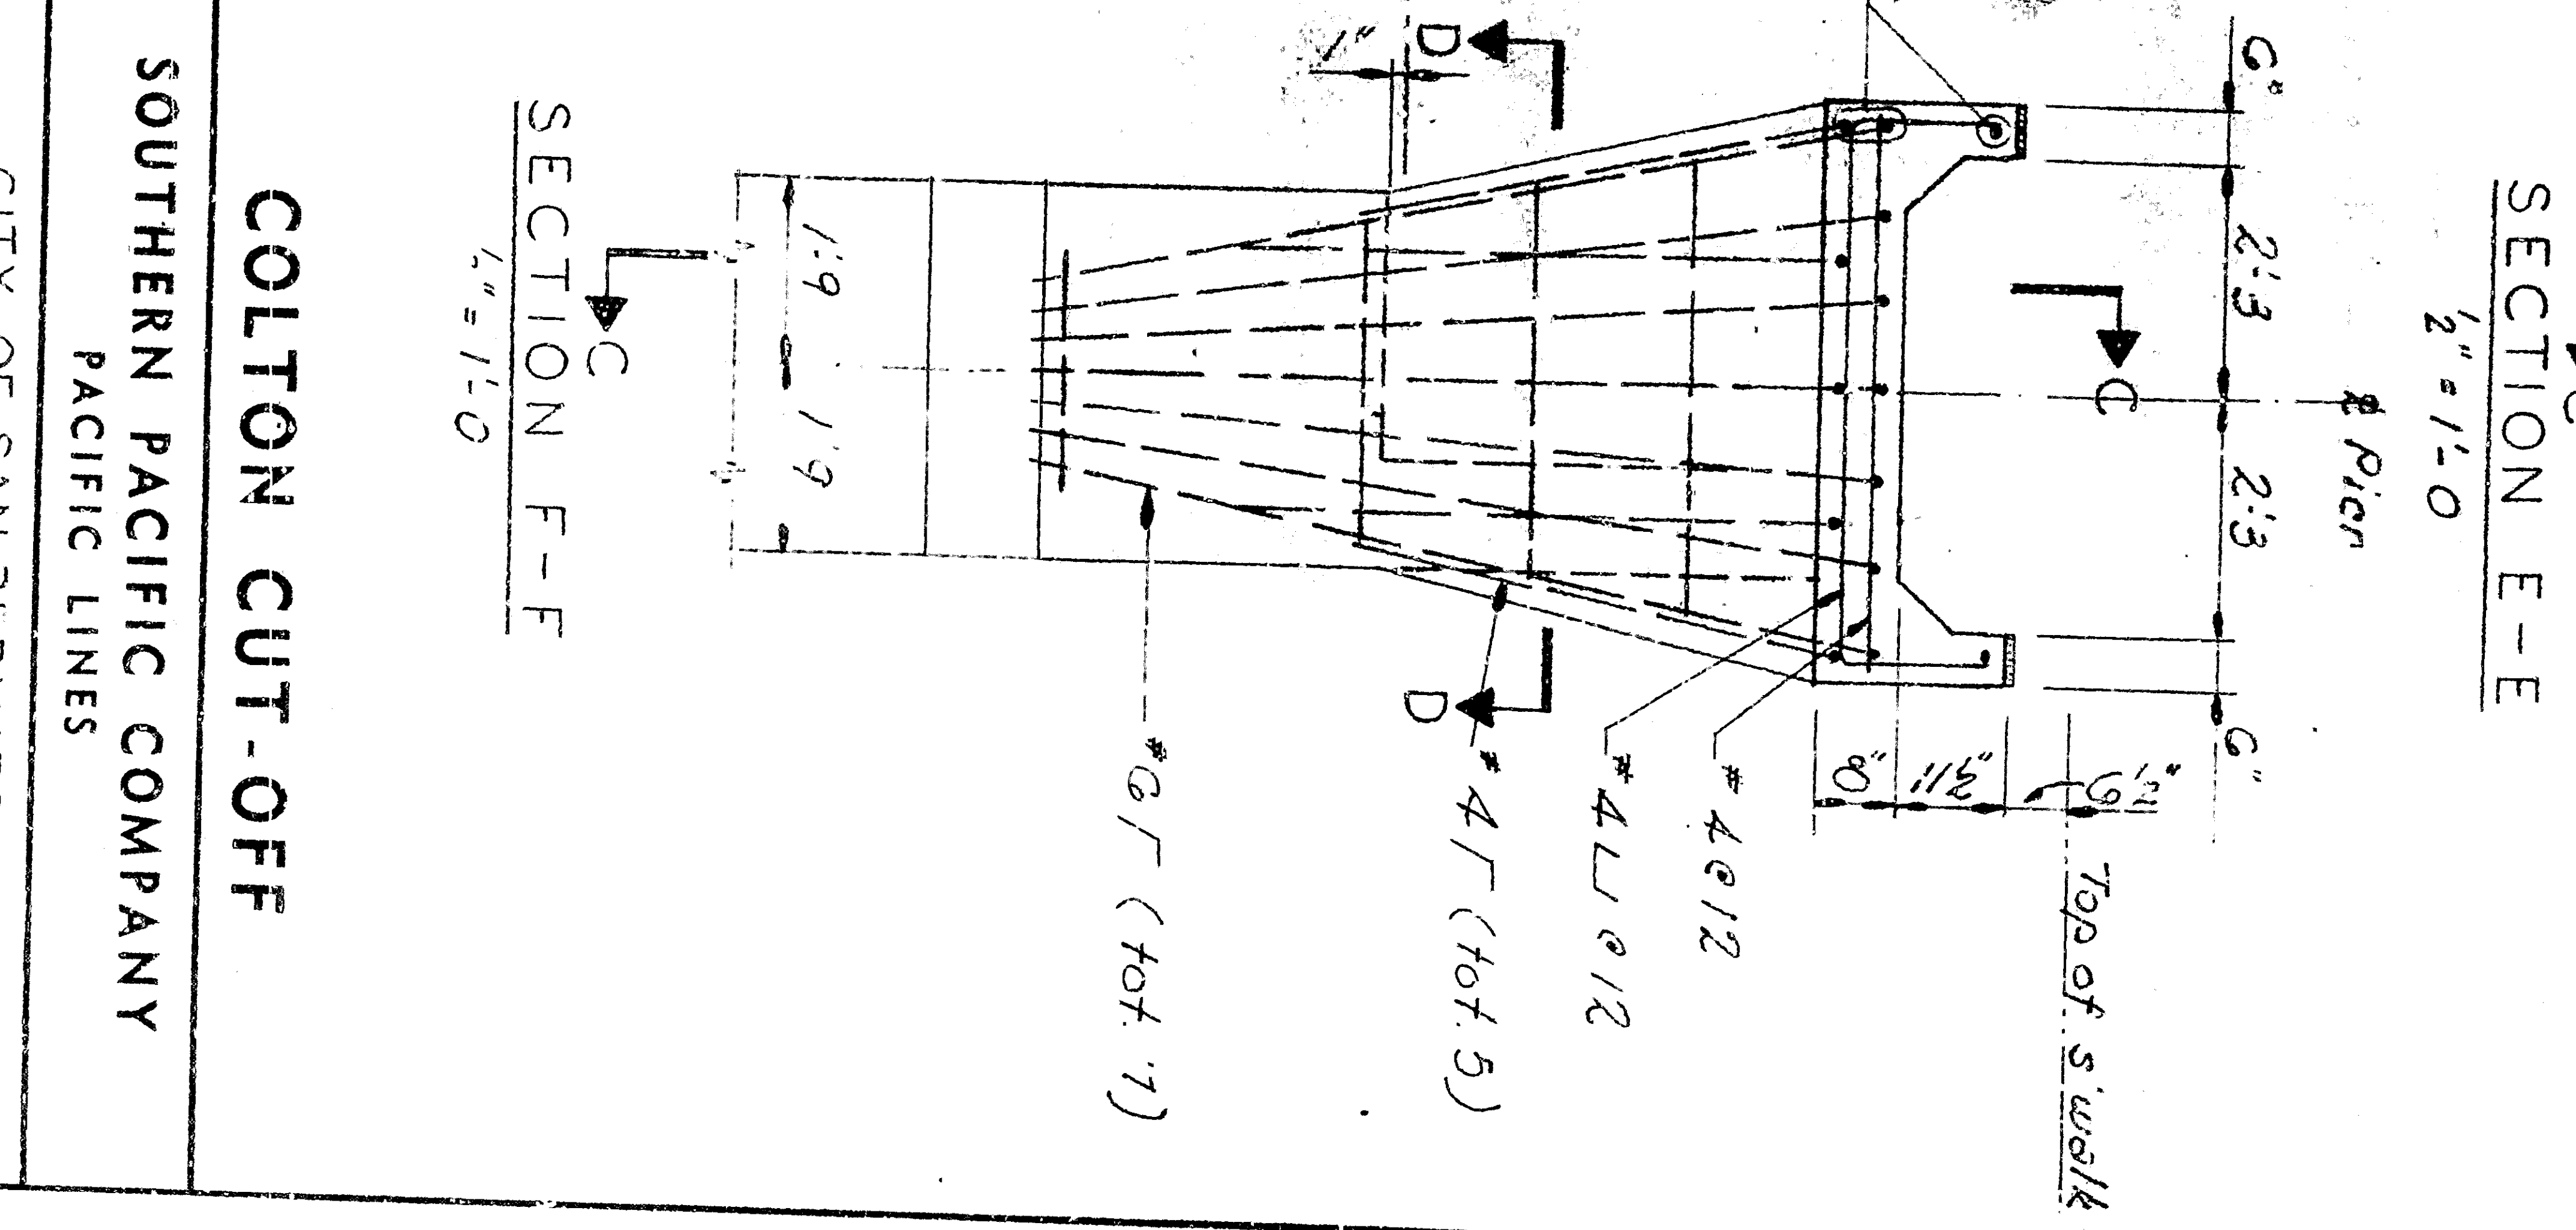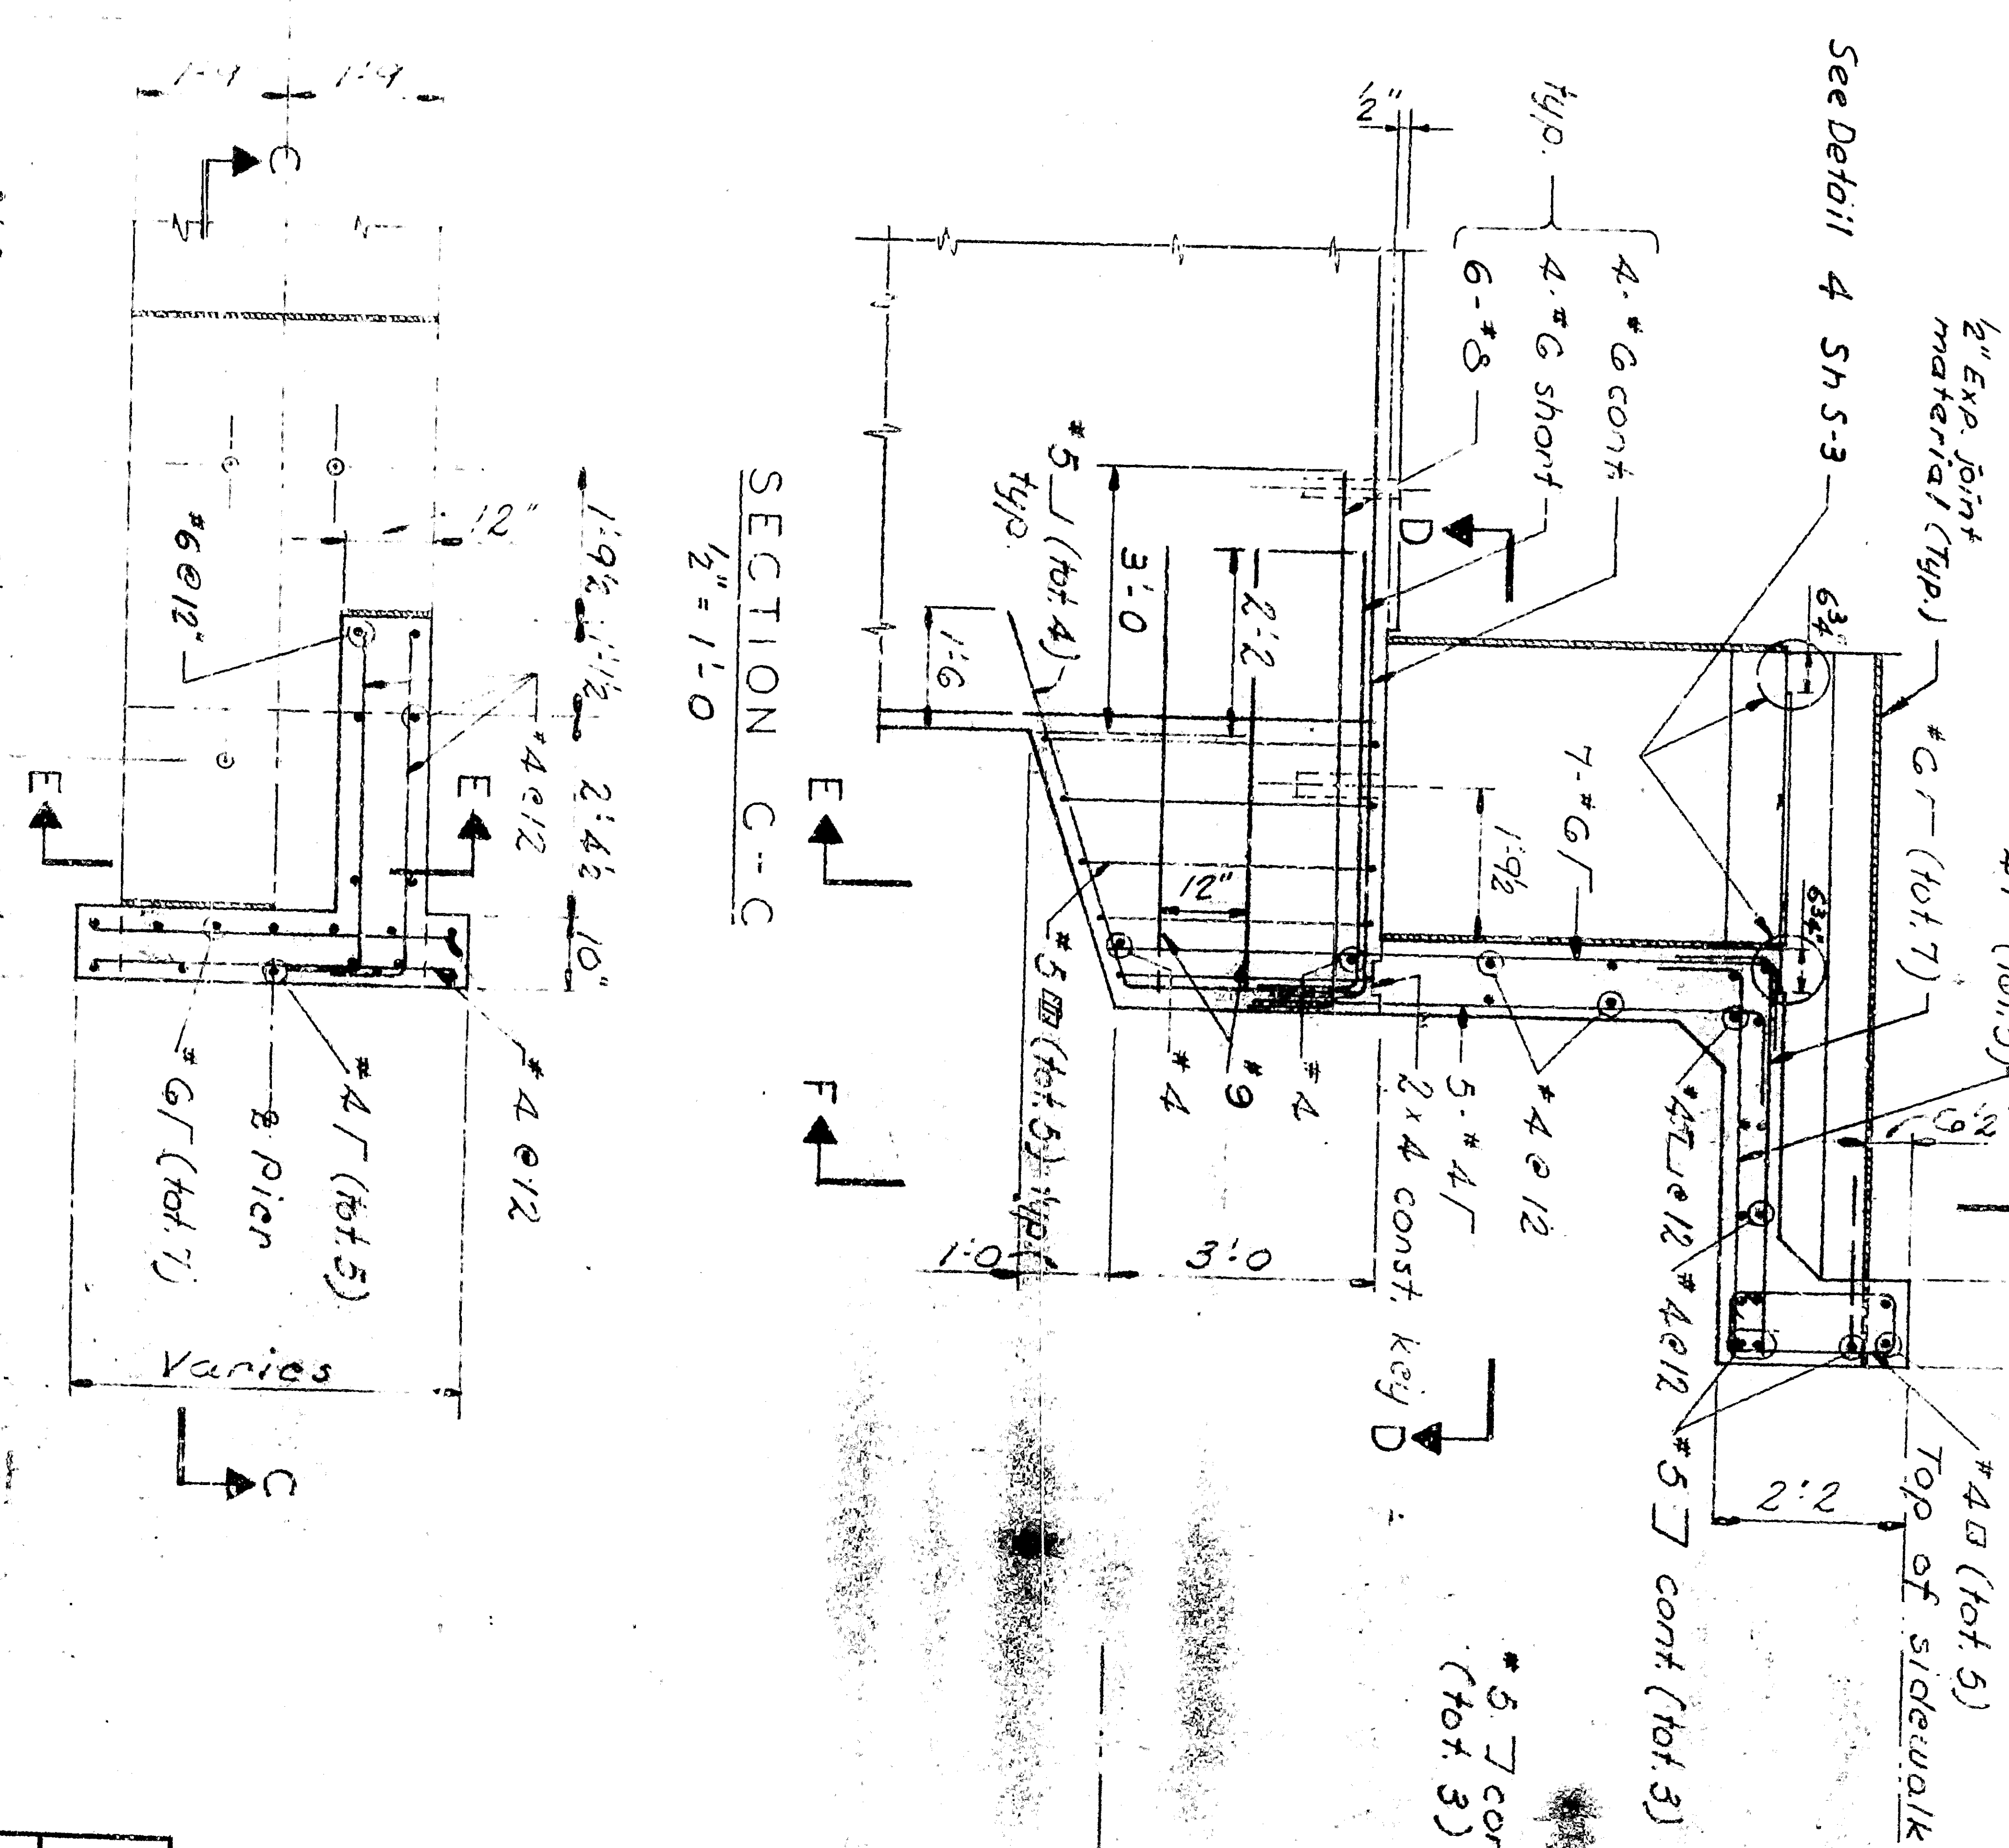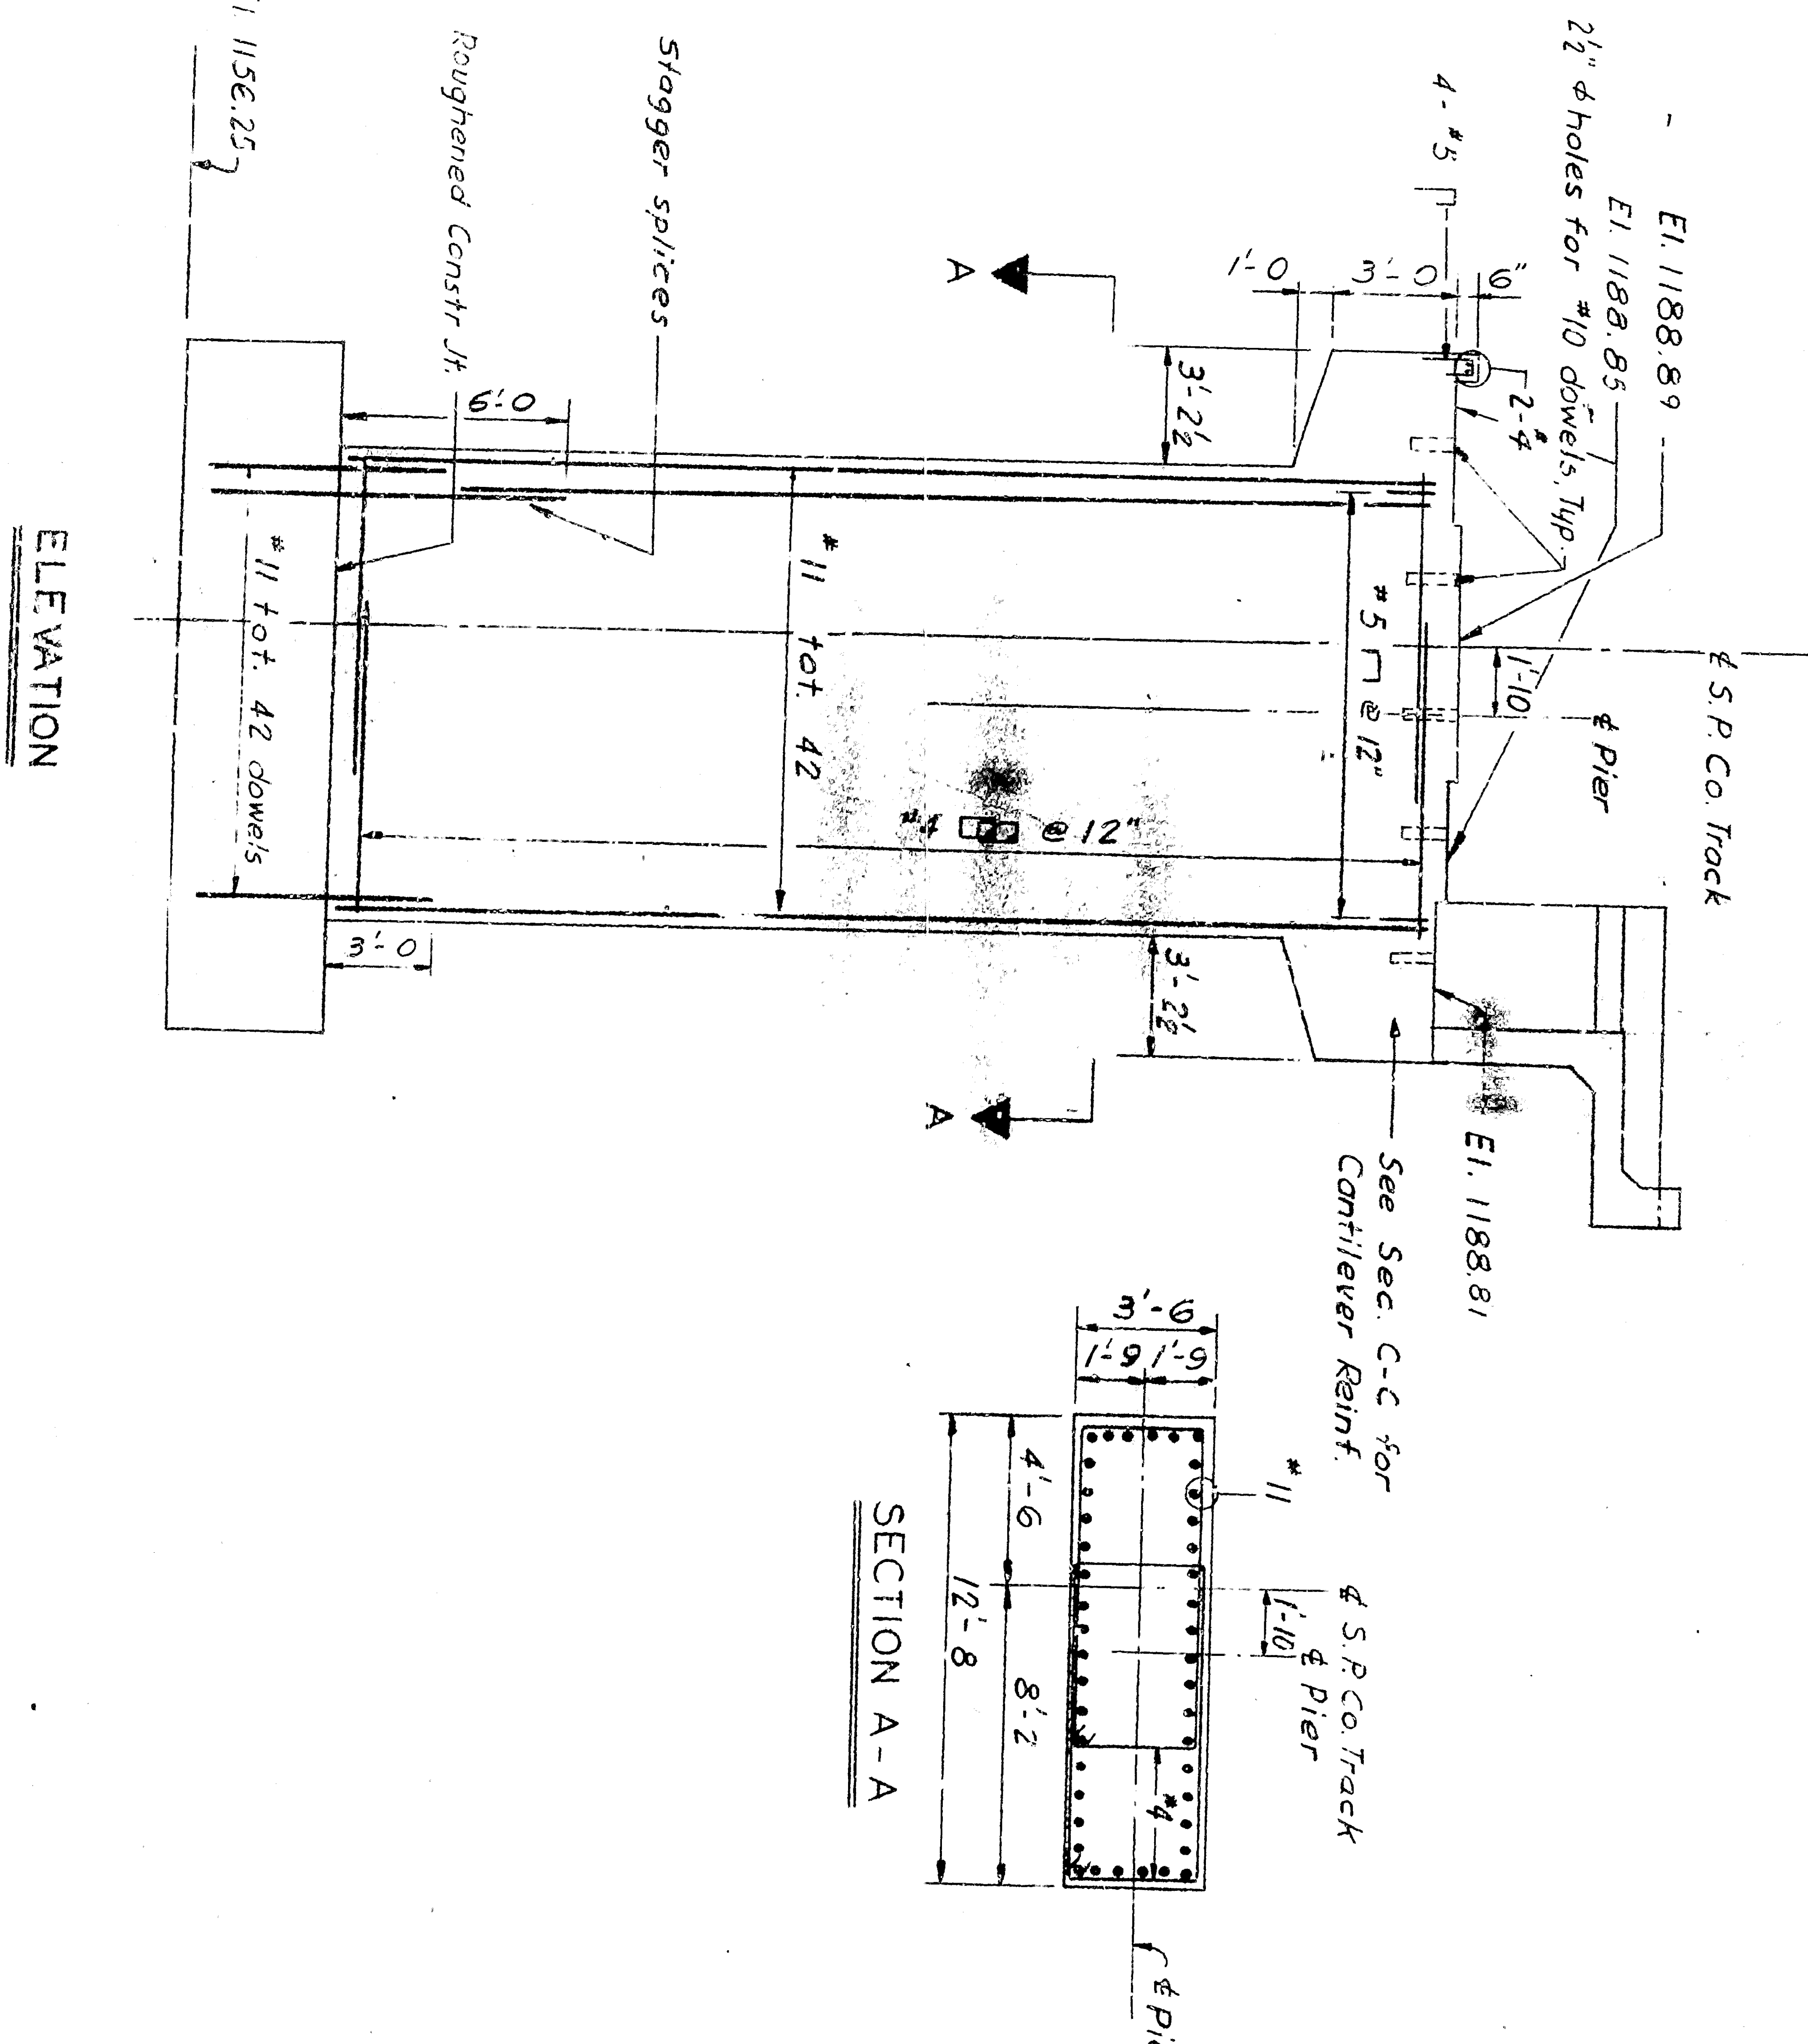 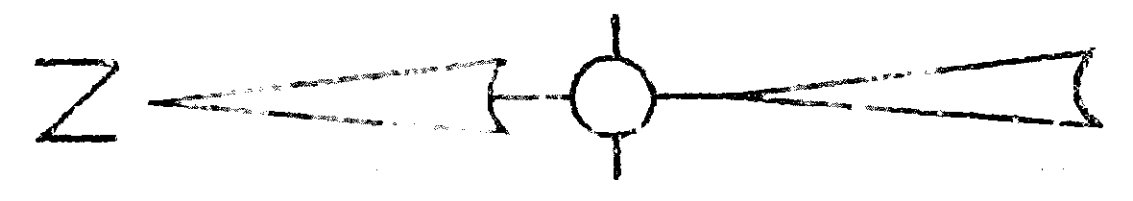

**AS BUILT**

**COLTON CUT-OFF**

**SOUTHERN PACIFIC COMPANY**

CITY OF SAN BERNARDINO  
ARROW ROUTE-RIALTO AVE. UNDERPASS  
BRIDGE W.P. 4900  
PIER No 2

REV.	DESCRIPTION	DATE	BY
1	Check and correct dimensions	5/24/48	JLB
2	Revised Pier Elevations	5/24/48	JLB

DE LEUW, CATHERS & COMPANY  
ENGINEERS  
SAN FRANCISCO, CALIFORNIA

DESIGNED BY  
DRAWN BY  
CHECKED BY  
APPROVED BY