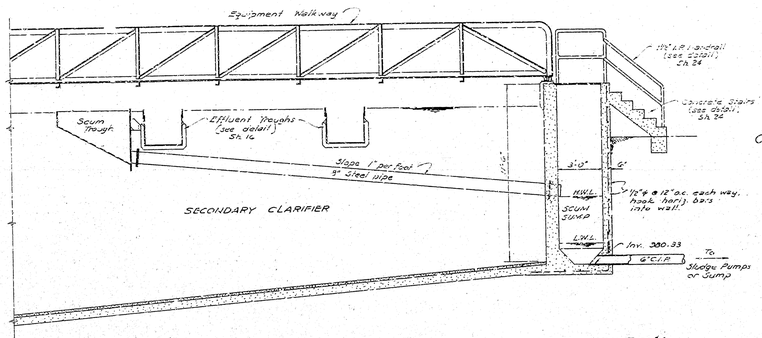

SECTION THRU SCUM SUMP
Scale: 1/2" = 1'-0"

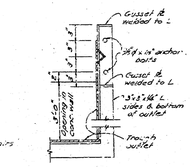

CONNECTION AT (A)

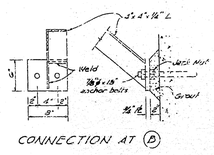

CONNECTION AT (B)

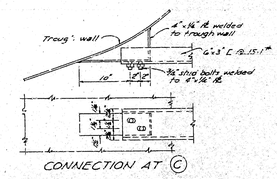

CONNECTION AT (C)

DETAIL OF CONNECTIONS
Scale: 1" = 1'-0"

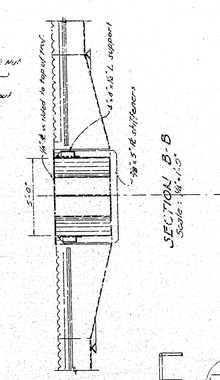

SECTION B-B
Scale: 1/4" = 1'-0"

SECTION A-A
Scale: 1/2" = 1'-0"

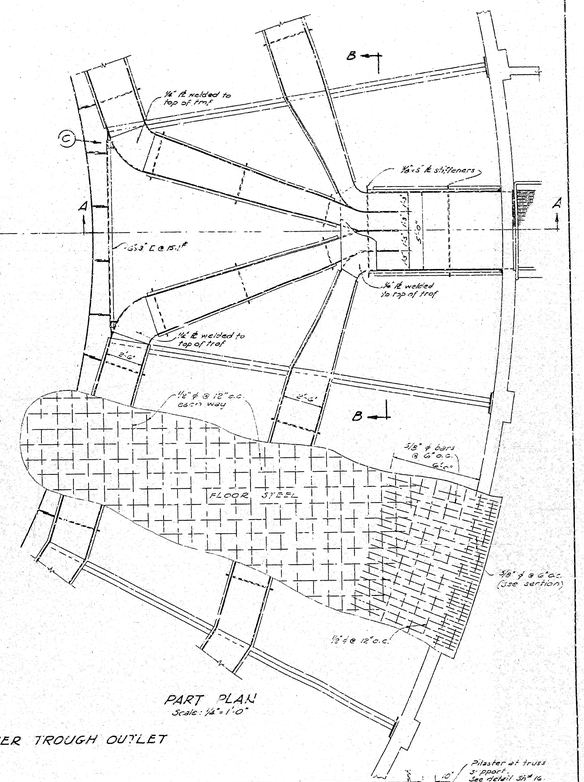

PART PLAN
Scale: 1/4" = 1'-0"

SECONDARY CLARIFIER TROUGH OUTLET

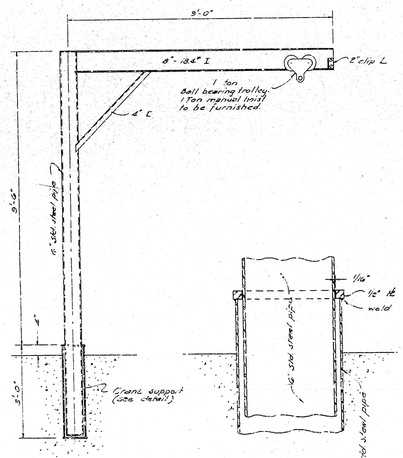

GATE CRANE
Scale: 1/2" = 1'-0"

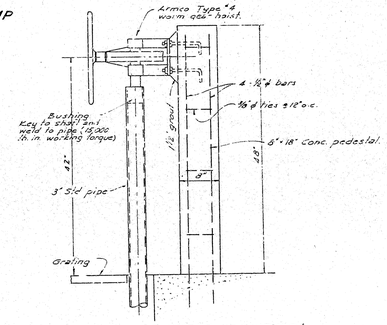

DETAIL - BAFFLE CONTROL
Scale: 1" = 1'-0"

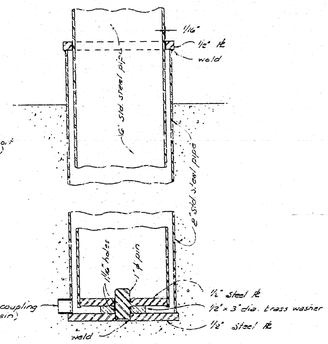

DETAIL
CRANE SUPPORT
Scale: 3" = 1'-0"

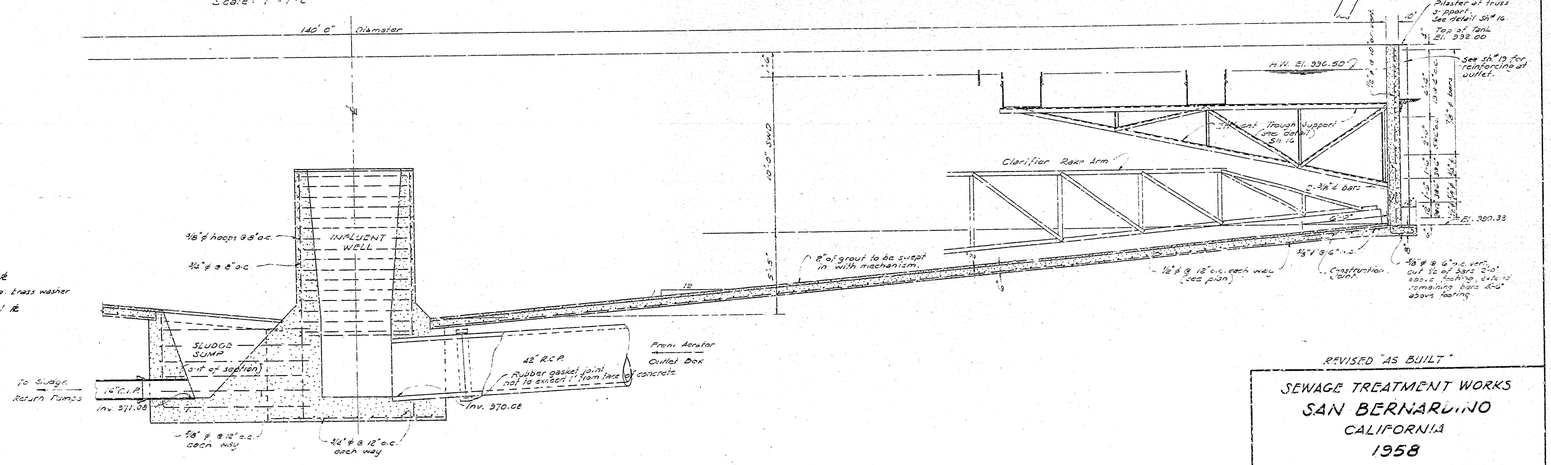

TYPICAL SECTION
SECONDARY CLARIFIER
Scale: 1/4" = 1'-0"

"REVISED AS BUILT"

SEWAGE TREATMENT WORKS
SAN BERNARDINO
CALIFORNIA
1958

CURRIE ENGINEERING COMPANY
CONSULTING ENGINEERS

SECONDARY CLARIFIER
PART PLAN - SECTIONS - DETAILS

18

69/182