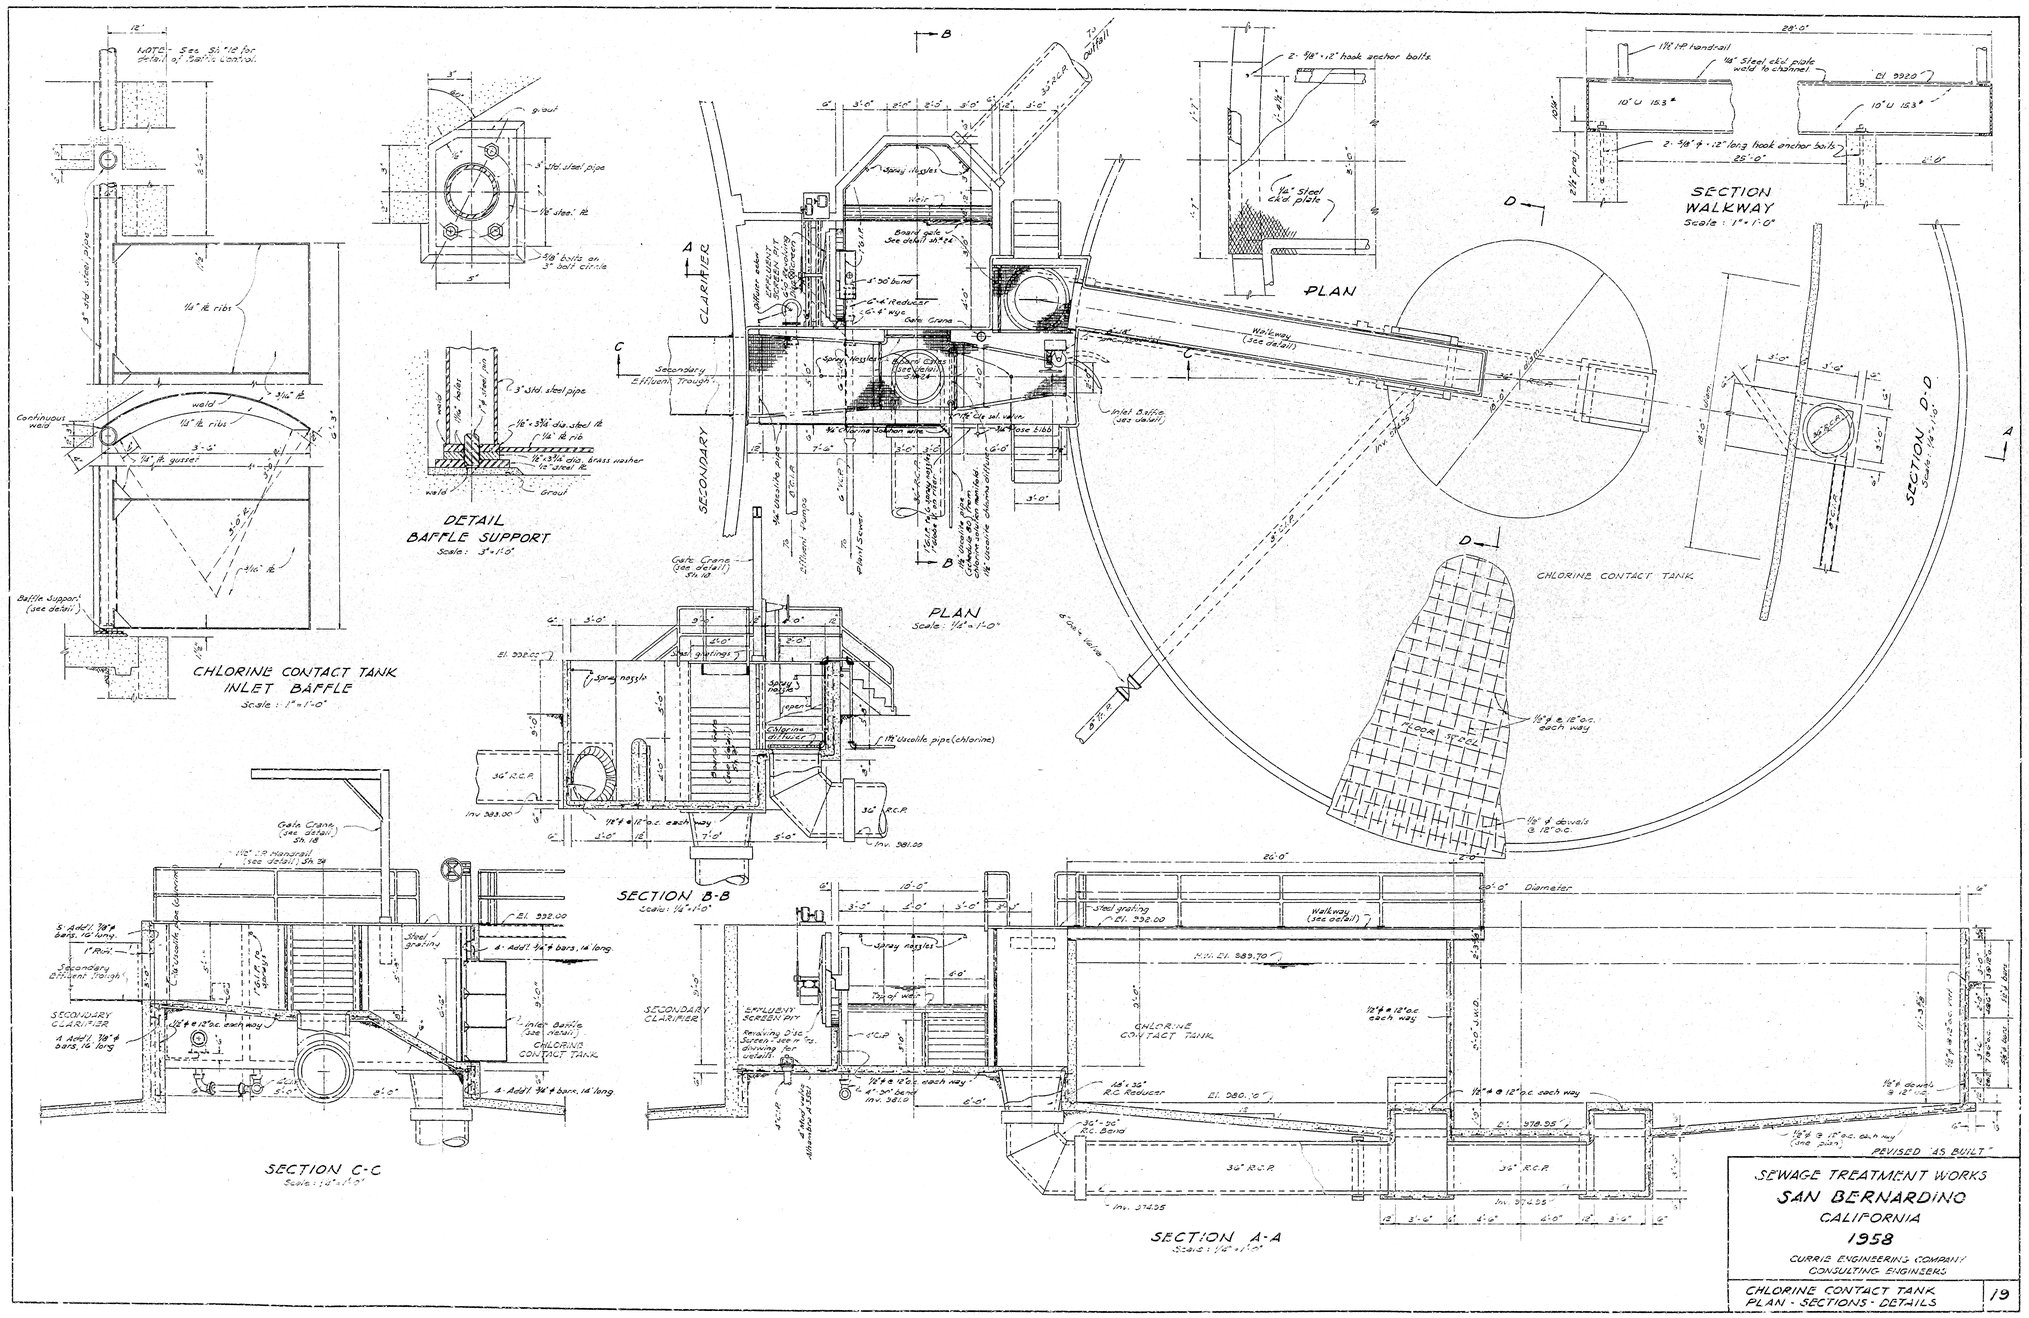
CHLORINE CONTACT TANK INLET BAFFLE
Scale: 1" = 1'-0"
DETAIL BAFFLE SUPPORT
Scale: 3" = 1'-0"
PLAN
Scale: 1/4" = 1'-0"
SECTION WALKWAY
Scale: 1" = 1'-0"
SECTION D-D
Scale: 1/4" = 1'-0"
SECTION B-B
Scale: 1/4" = 1'-0"
SECTION C-C
Scale: 1/4" = 1'-0"
SECTION A-A
Scale: 1/4" = 1'-0"
CHLORINE CONTACT TANK
SECONDARY CLARIFIER
Secondary Effluent Trough
Walkway (See detail)
Gate Crank (See detail Sh. 18)
Baffle Support (see detail)
Inlet Baffle (see detail)
Steel grating
Spray nozzles
Diameter
REVISED "AS BUILT"
SEWAGE TREATMENT WORKS
SAN BERNARDINO
CALIFORNIA
1958
CURRIE ENGINEERING COMPANY
CONSULTING ENGINEERS
CHLORINE CONTACT TANK
PLAN - SECTIONS - DETAILS
19

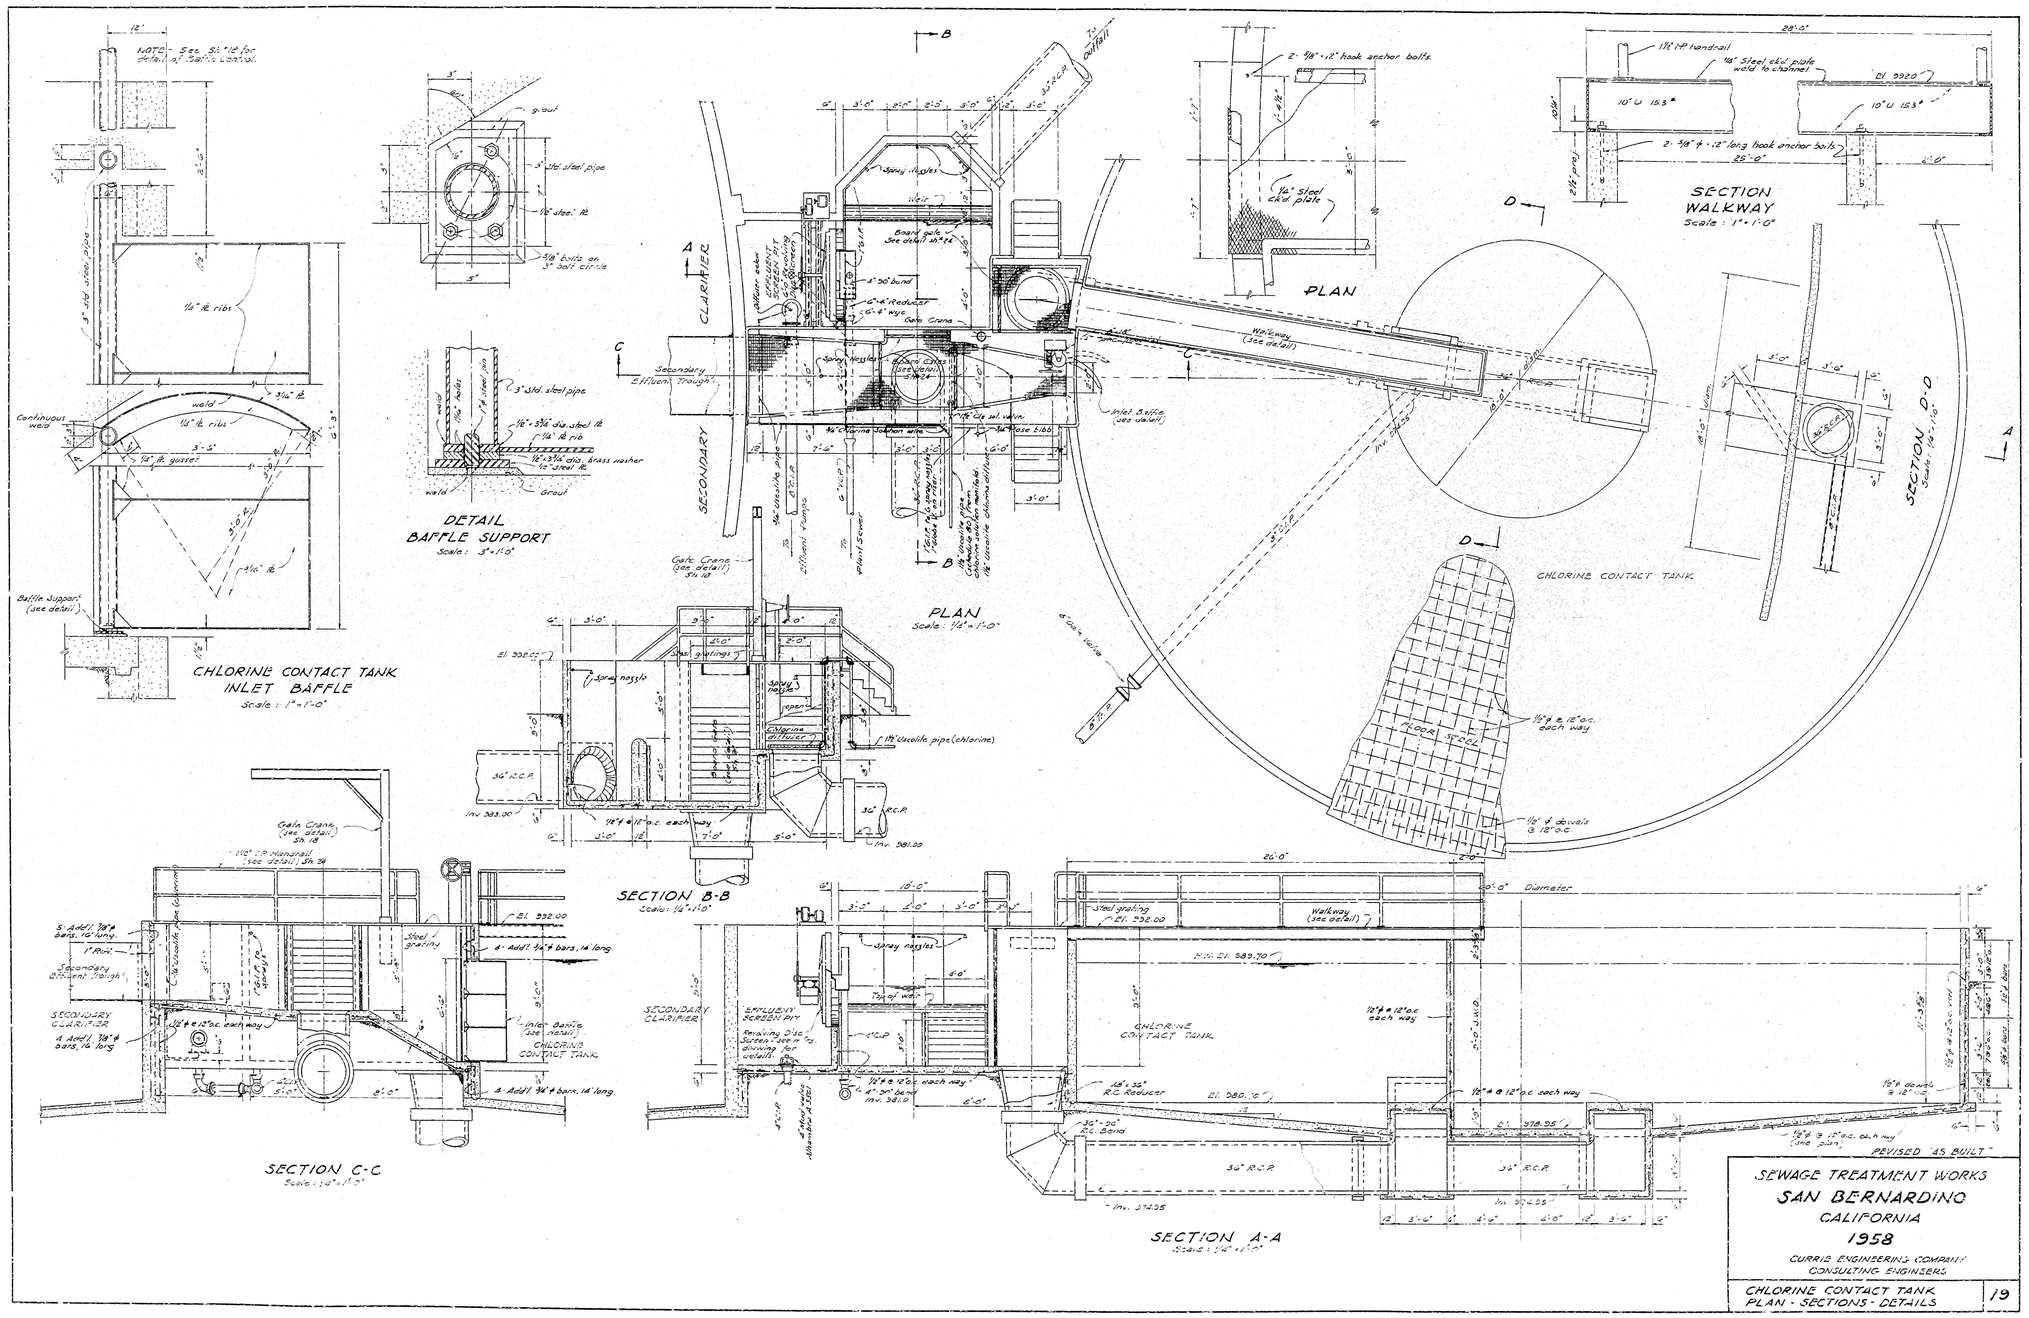
CHLORINE CONTACT TANK INLET BAFFLE
Scale: 1" = 1'-0"
DETAIL BAFFLE SUPPORT
Scale: 3" = 1'-0"
PLAN
Scale: 1/4" = 1'-0"
SECTION WALKWAY
Scale: 1" = 1'-0"
SECTION D-D
Scale: 1/4" = 1'-0"
SECTION B-B
Scale: 1/4" = 1'-0"
SECTION C-C
Scale: 1/4" = 1'-0"
SECTION A-A
Scale: 1/4" = 1'-0"
CHLORINE CONTACT TANK
SECONDARY CLARIFIER
Secondary Effluent Trough
Walkway (See detail)
Gate Crank (See detail Sh. 18)
Baffle Support (see detail)
Inlet Baffle (see detail)
Steel grating
Spray nozzles
Diameter
REVISED "AS BUILT"
SEWAGE TREATMENT WORKS
SAN BERNARDINO
CALIFORNIA
1958
CURRIE ENGINEERING COMPANY
CONSULTING ENGINEERS
CHLORINE CONTACT TANK
PLAN - SECTIONS - DETAILS
19