SHEET No 1

PLAN No 1064

FOR THE IMPROVEMENT OF

FIFTH STREET

BETWEEN

RAMONA AVENUE AND THE WEST CITY LIMITS

IN THE

CITY OF SAN BERNARDINO, CALIFORNIA.

DECEMBER 1930 A.H. LOWE, City Engineer.

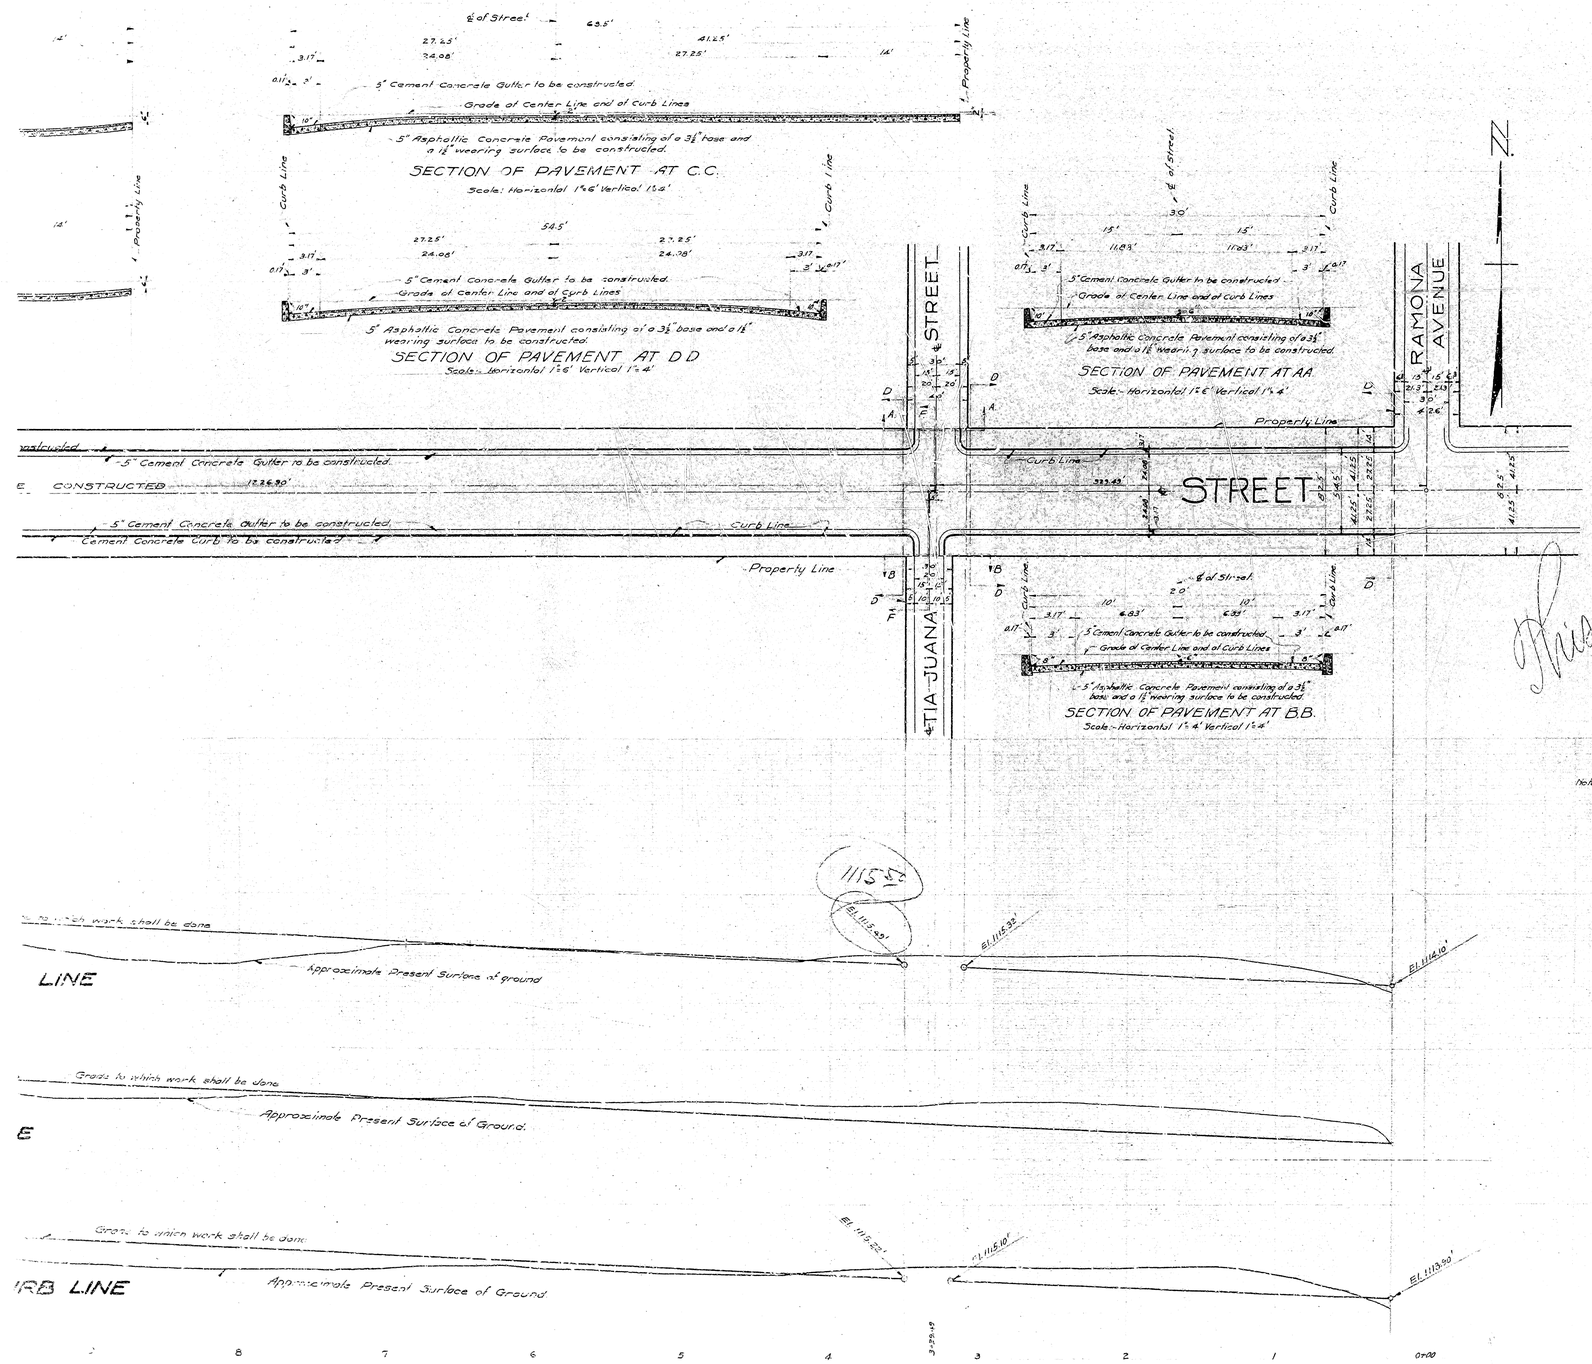

Plan work not done R.D. Stoney the

FILED JAN. 5, 1931. A.H. Lowe City Engineer

PLAN ADOPTED JANUARY 19, 1931.

TITLE TO STREET

Title of the City of San Bernardino to 5th Street was given by dedication of The Rancho San Bernardino as per map thereof recorded in Book 7 of Maps of Page 2 records of the County Recorder San Bernardino County California.

GRADE ESTABLISHED

Grade of 5th St was established by Resolution #1165 dated 12-30-8 and by Ordinance #692 dated 2-23-18 of the City of San Bernardino, California.

LEGEND

" or in. means inch or inches.
' or ft. means foot or feet.
℄ means center Line
No. means number.
El. means elevation.
St. means Street
Ave. means Avenue.
Cement Concrete Curb to be constructed shown thus in plan ___ thus in section
5" Cement Concrete Gutter to be constructed shown thus in plan ___ thus in section
5" Asphaltic Concrete Pavement consisting of a 3½" base and a 1½" wearing surface to be constructed shown thus in plan ___ thus in section

Note All elevations shown in Red figures are in feet and are above a plane which is 1045.20 feet below the City Bench Mark established by ordinance #383 City San Bernardino California.

Note: A ¾" expansion joint shall be constructed at intervals of approximately 30 feet thru all cement concrete curb and gutter ordered constructed on this plan.

PROFILE LEGEND

Approximate Present Surface of ground shown by Black Lines thus ———
Grade to which work shall be constructed shown by red lines thus ———
Scale:- Horizontal 1"=40' Vertical 1"=4'

SHEET No 1

PLAN No 1064

FOR THE IMPROVEMENT OF

FIFTH STREET

BETWEEN

RAMONA AVENUE AND THE WEST CITY LIMITS

IN THE

CITY OF SAN BERNARDINO, CALIFORNIA.

DECEMBER 1930 A.H. LOWE, City Engineer.

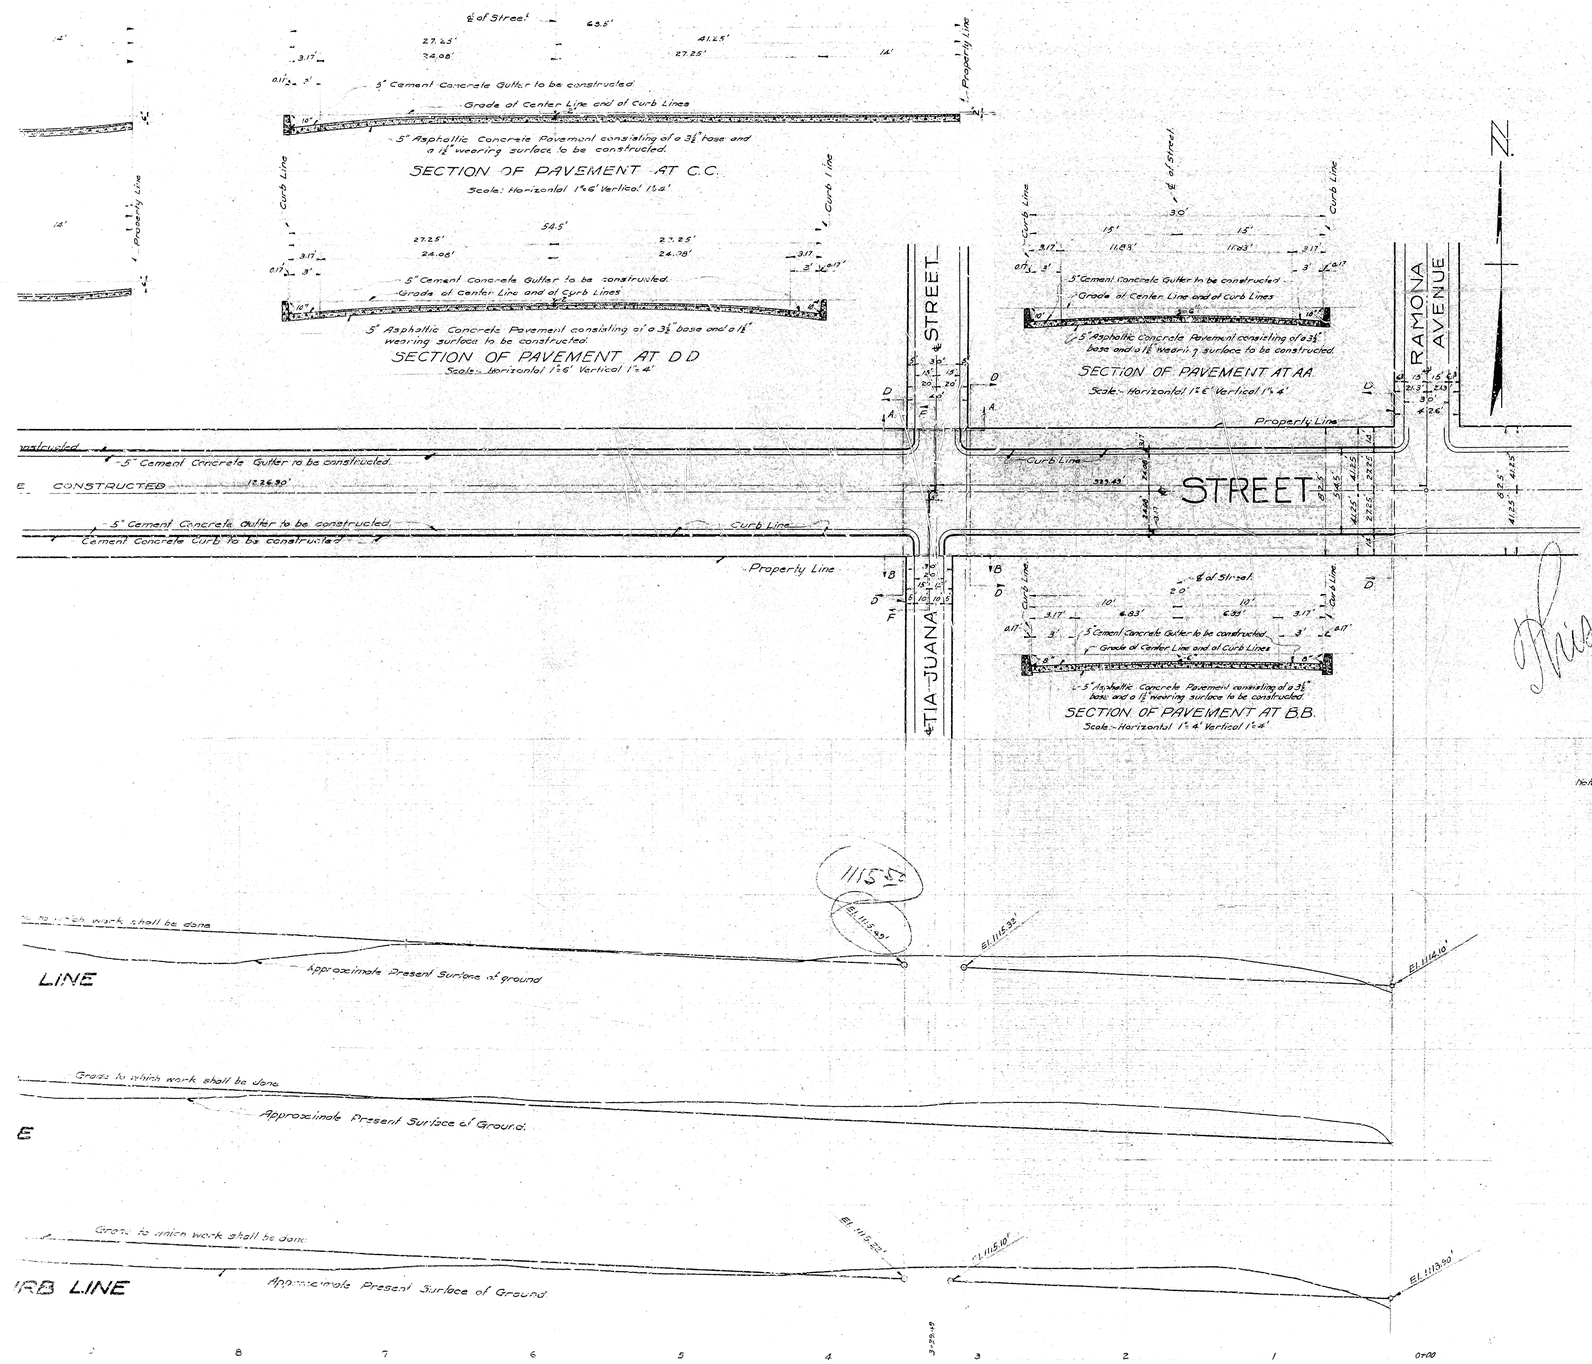

Plan work not done R.D. Stoney the

FILED JAN. 5, 1931. A.H. Lowe City Engineer

PLAN ADOPTED JANUARY 19, 1931.

TITLE TO STREET

Title of the City of San Bernardino to 5th Street was given by dedication of The Rancho San Bernardino as per map thereof recorded in Book 7 of Maps of Page 2 records of the County Recorder San Bernardino County California.

GRADE ESTABLISHED

Grade of 5th St was established by Resolution #1165 dated 12-30-8 and by Ordinance #692 dated 2-23-18 of the City of San Bernardino, California.

LEGEND

" or in. means inch or inches.
' or ft. means foot or feet.
℄ means center Line
No. means number.
El. means elevation.
St. means Street
Ave. means Avenue.
Cement Concrete Curb to be constructed shown thus in plan ___ thus in section
5" Cement Concrete Gutter to be constructed shown thus in plan ___ thus in section
5" Asphaltic Concrete Pavement consisting of a 3½" base and a 1½" wearing surface to be constructed shown thus in plan ___ thus in section

Note All elevations shown in Red figures are in feet and are above a plane which is 1045.20 feet below the City Bench Mark established by ordinance #383 City San Bernardino California.

Note: A ¾" expansion joint shall be constructed at intervals of approximately 30 feet thru all cement concrete curb and gutter ordered constructed on this plan.

PROFILE LEGEND

Approximate Present Surface of ground shown by Black Lines thus ———
Grade to which work shall be constructed shown by red lines thus ———
Scale:- Horizontal 1"=40' Vertical 1"=4'