

- 3' CONC. WALK 30'
- (REMOVE) 6' TREE 21'
- 10' TREE 33'
- (REMOVE) 6' TREE 21'
- 3' CONC. WALK 30'
- 6' TREE 21'
- 18' TREE 30'
- W.M. 21'
- (REMOVE) 6' TREE 21'
- 12' TREE 33'
- STEEL TOWER 18'
- END WALK 30'
- M.H. 22'

AS BUILT
DATE: 7/2/65
BY: [Signature]

BENCH MARKS
4. Station on corner of Mt. Vernon Ave. & Grant Avenue
Elev. 1054.07
5. Station on corner of Mt. Vernon Ave. & Fairview Ave.
Elev. 1050.21

GENERAL NOTES

3. All utilities to be retained by others.
4. All improvements, East of Holly Dr. are to be retained by others.

AS BUILT

CITY OF SAN BERNARDINO
GAS TAX PROJECT NO. 338
APPROVED BY: [Signature]
CITY ENGINEER




GRANT AVENUE
GAS TAX PROJECT NO. 1498
MT VERNON AVE TO HOLLY DRIVE
PLAN NO. 1498

DATE: 7/2/65
SCALE: 1" = 10'

DRAWN BY: [Signature]
CHECKED BY: [Signature]
DATE: 7/2/65

APPROVED BY: [Signature]
DATE: 7/2/65

SHEET 1 OF 2

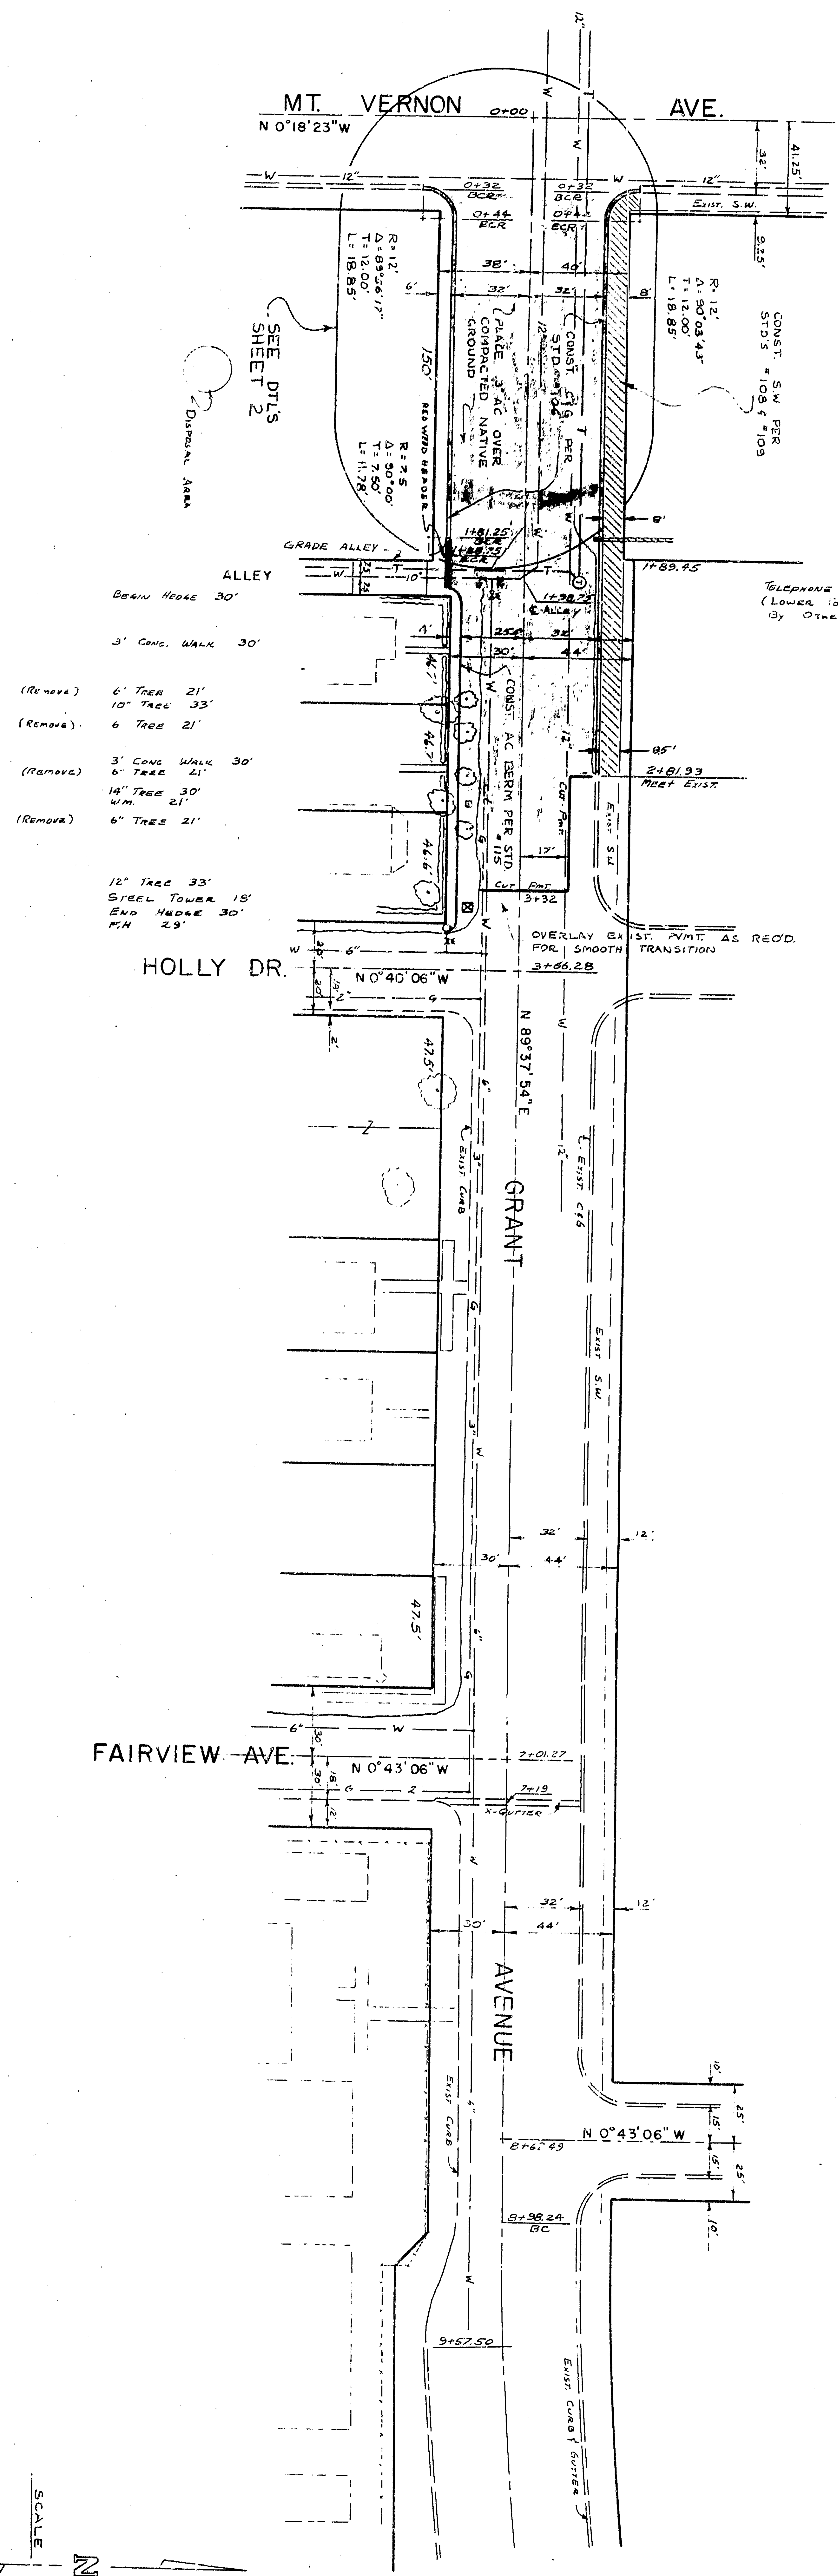 









