WAR DEPARTMENT

CORPS OF ENGINEERS, U. S. ARMY

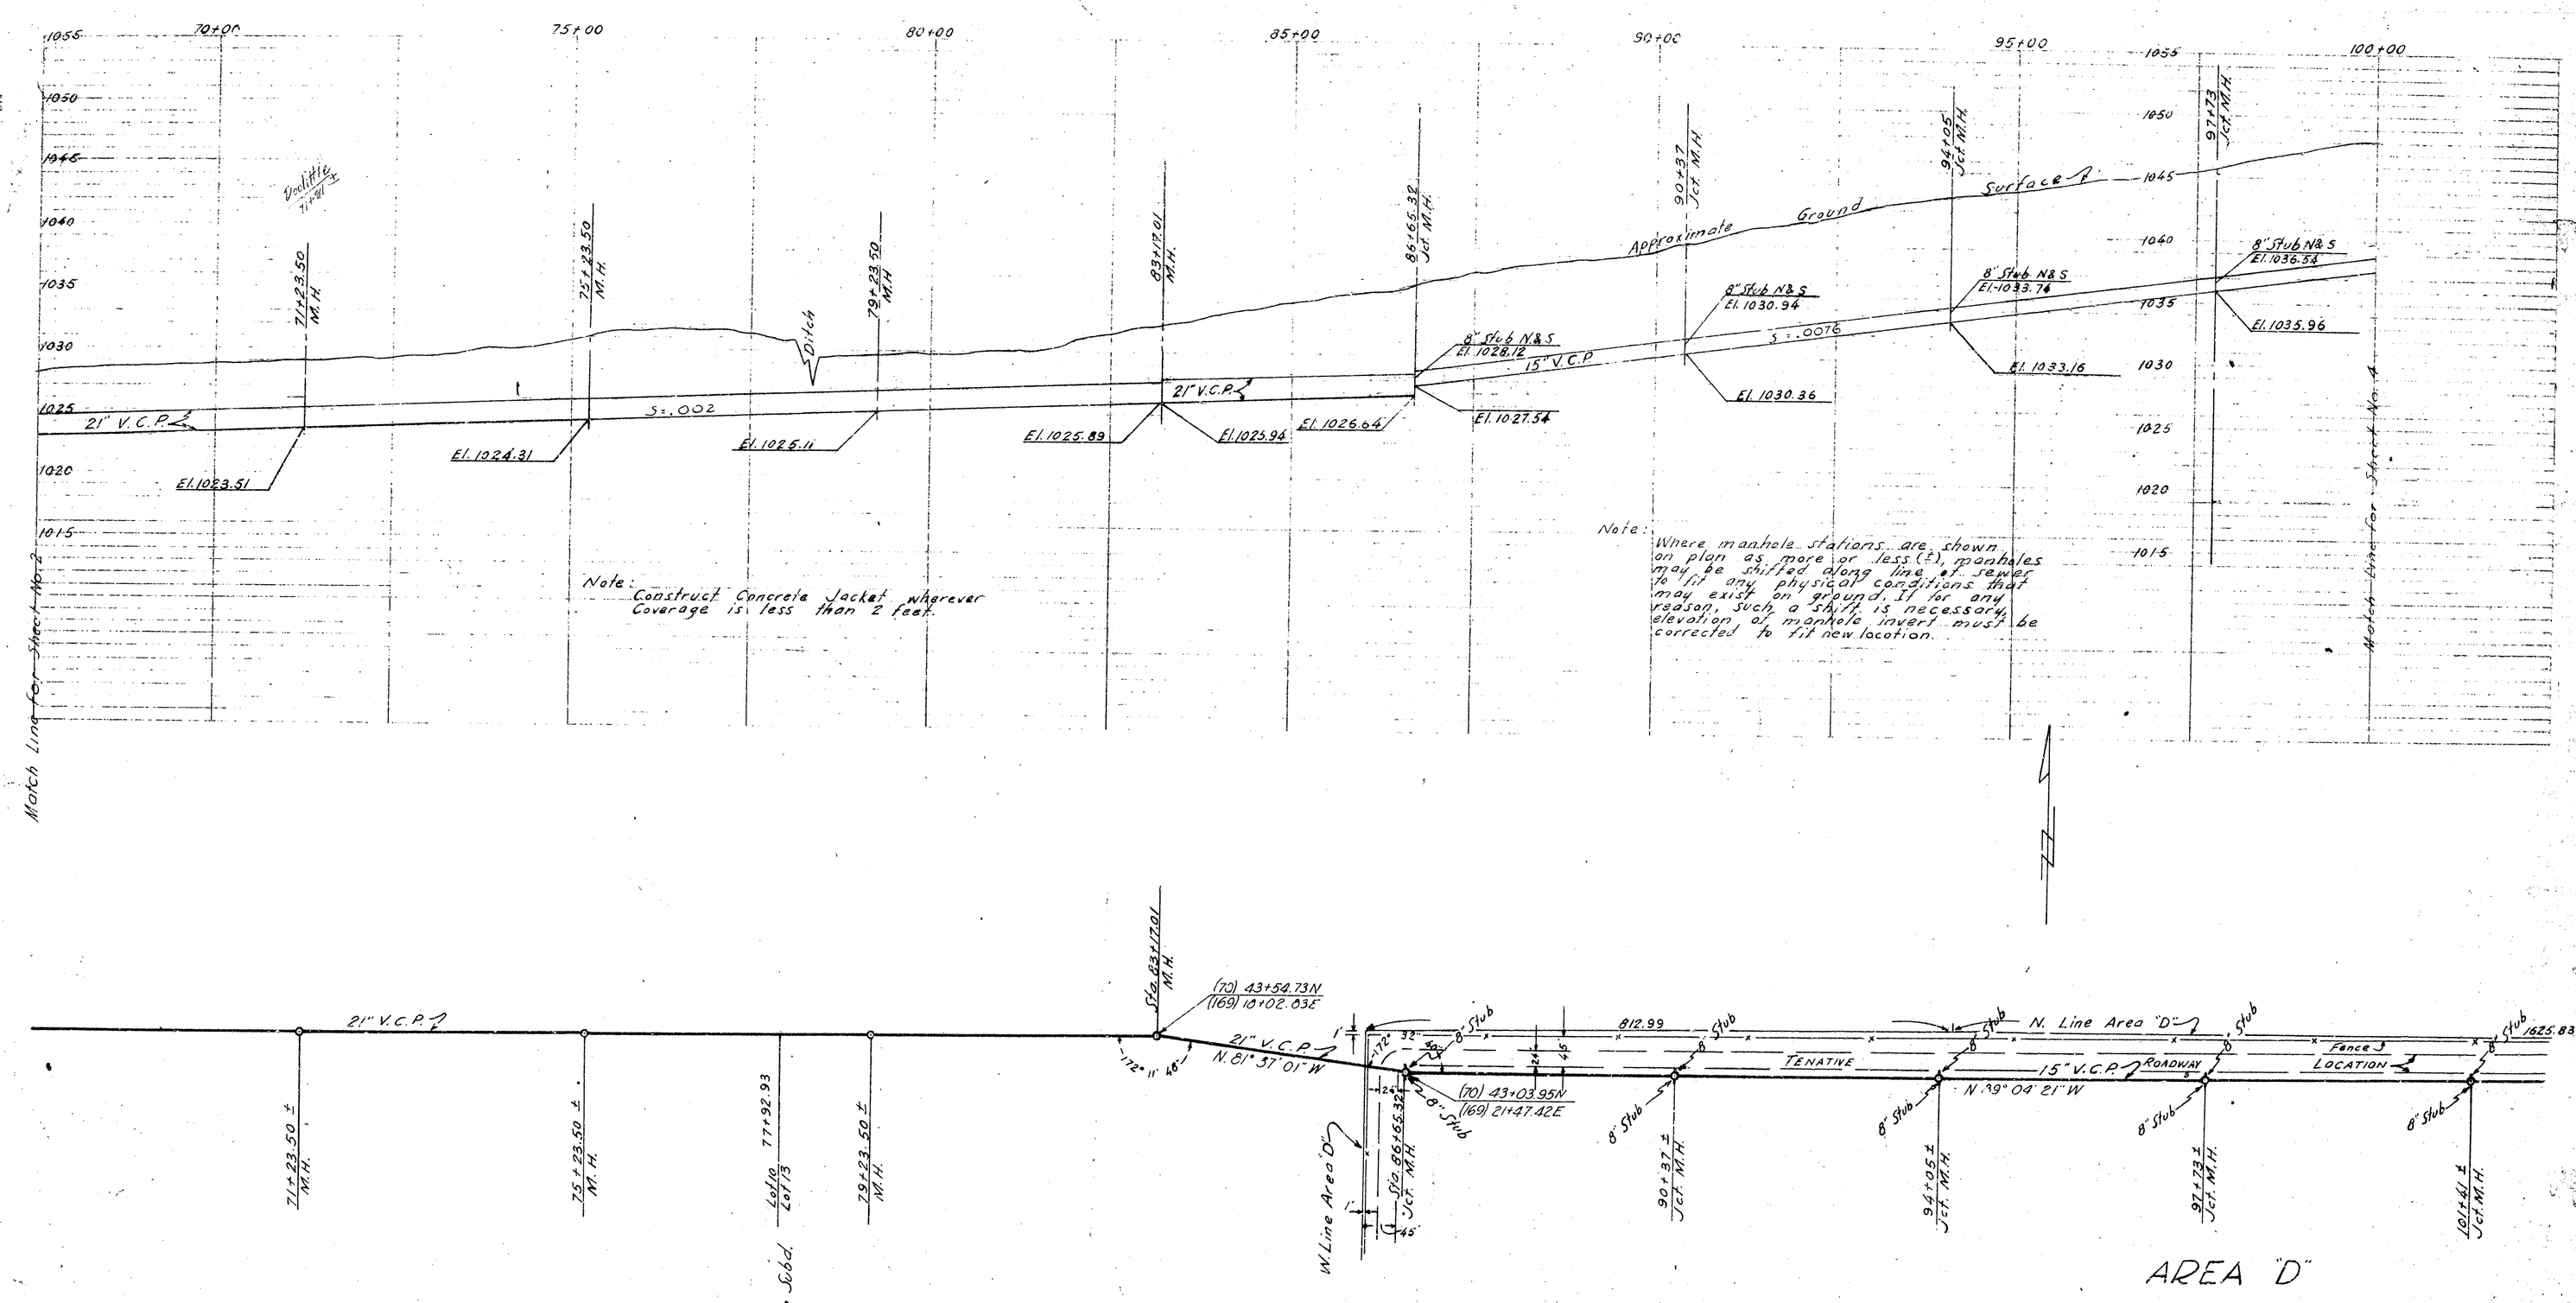

Contr. W-509-Eng. 2619

RECORD DRAWING - AS CONSTRUCTED

POSTED BY No Changes. DATE:

POSTED BY: DATE:

POSTED BY: DATE:

REV. NO.	DATE	REVISION	REV.	CHK.	APP.

MILITARY CONSTRUCTION

SAN BERNARDINO AIR DEPOT

SAN BERNARDINO, CALIF.

OUTFALL SANITARY SEWER

PLAN AND PROFILE NO. 3

SCALE: HORIZ 1" = 100'-0" VERT 1" = 8'-0" IN 5 SHEETS SHEET NO. 3

GRAPHIC SCALE FEET

U. S. ENGINEER OFFICE, LOS ANGELES, CALIF. APRIL, 1944

SUBMITTED BY: W. Pattinger LT. COL. CORPS OF ENGINEERS, U. S. ARMY CHIEF, ENGINEERING DIVISION

APPROVED BY: [illegible] COLONEL, CORPS OF ENGINEERS, U. S. ARMY DISTRICT ENGINEER

FILE NO.	DRAWN	TRACED	CHECKED	TO ACCOMPANY SPECIFICATION