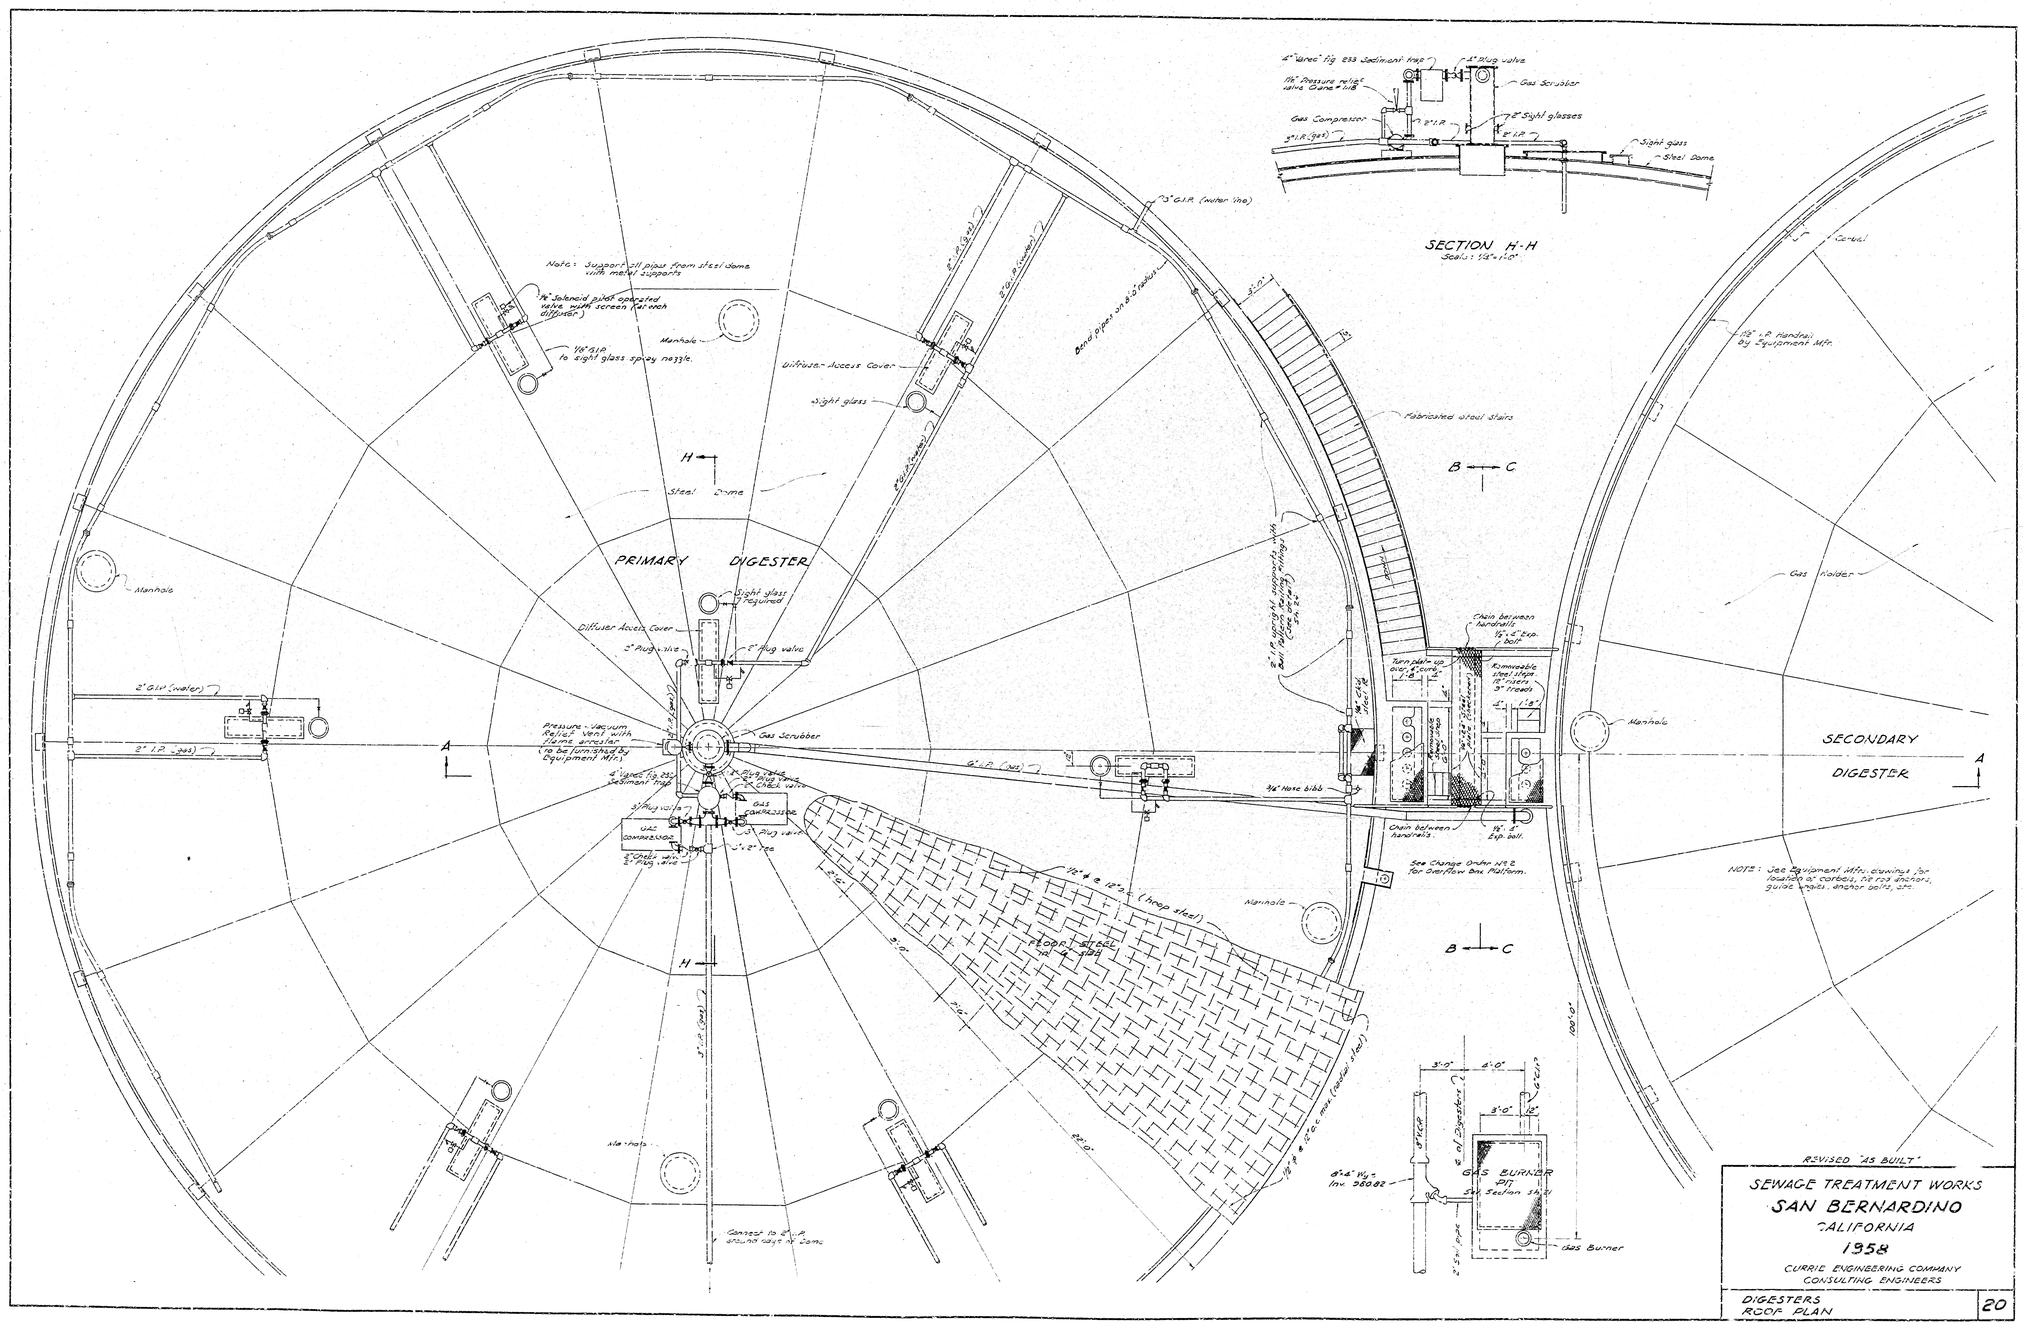
SECTION H-H
Scale: 1/4" = 1'-0"
PRIMARY DIGESTER
SECONDARY DIGESTER
Steel Dome
Manhole
Diffuser Access Cover
Sight glass
Gas Scrubber
Gas Compressor
Gas Holder
Fabricated steel stairs
Gas Burner
GAS BURNER PIT
REVISED "AS BUILT"
SEWAGE TREATMENT WORKS
SAN BERNARDINO
CALIFORNIA
1958
CURRIE ENGINEERING COMPANY
CONSULTING ENGINEERS
DIGESTERS
ROOF PLAN
20

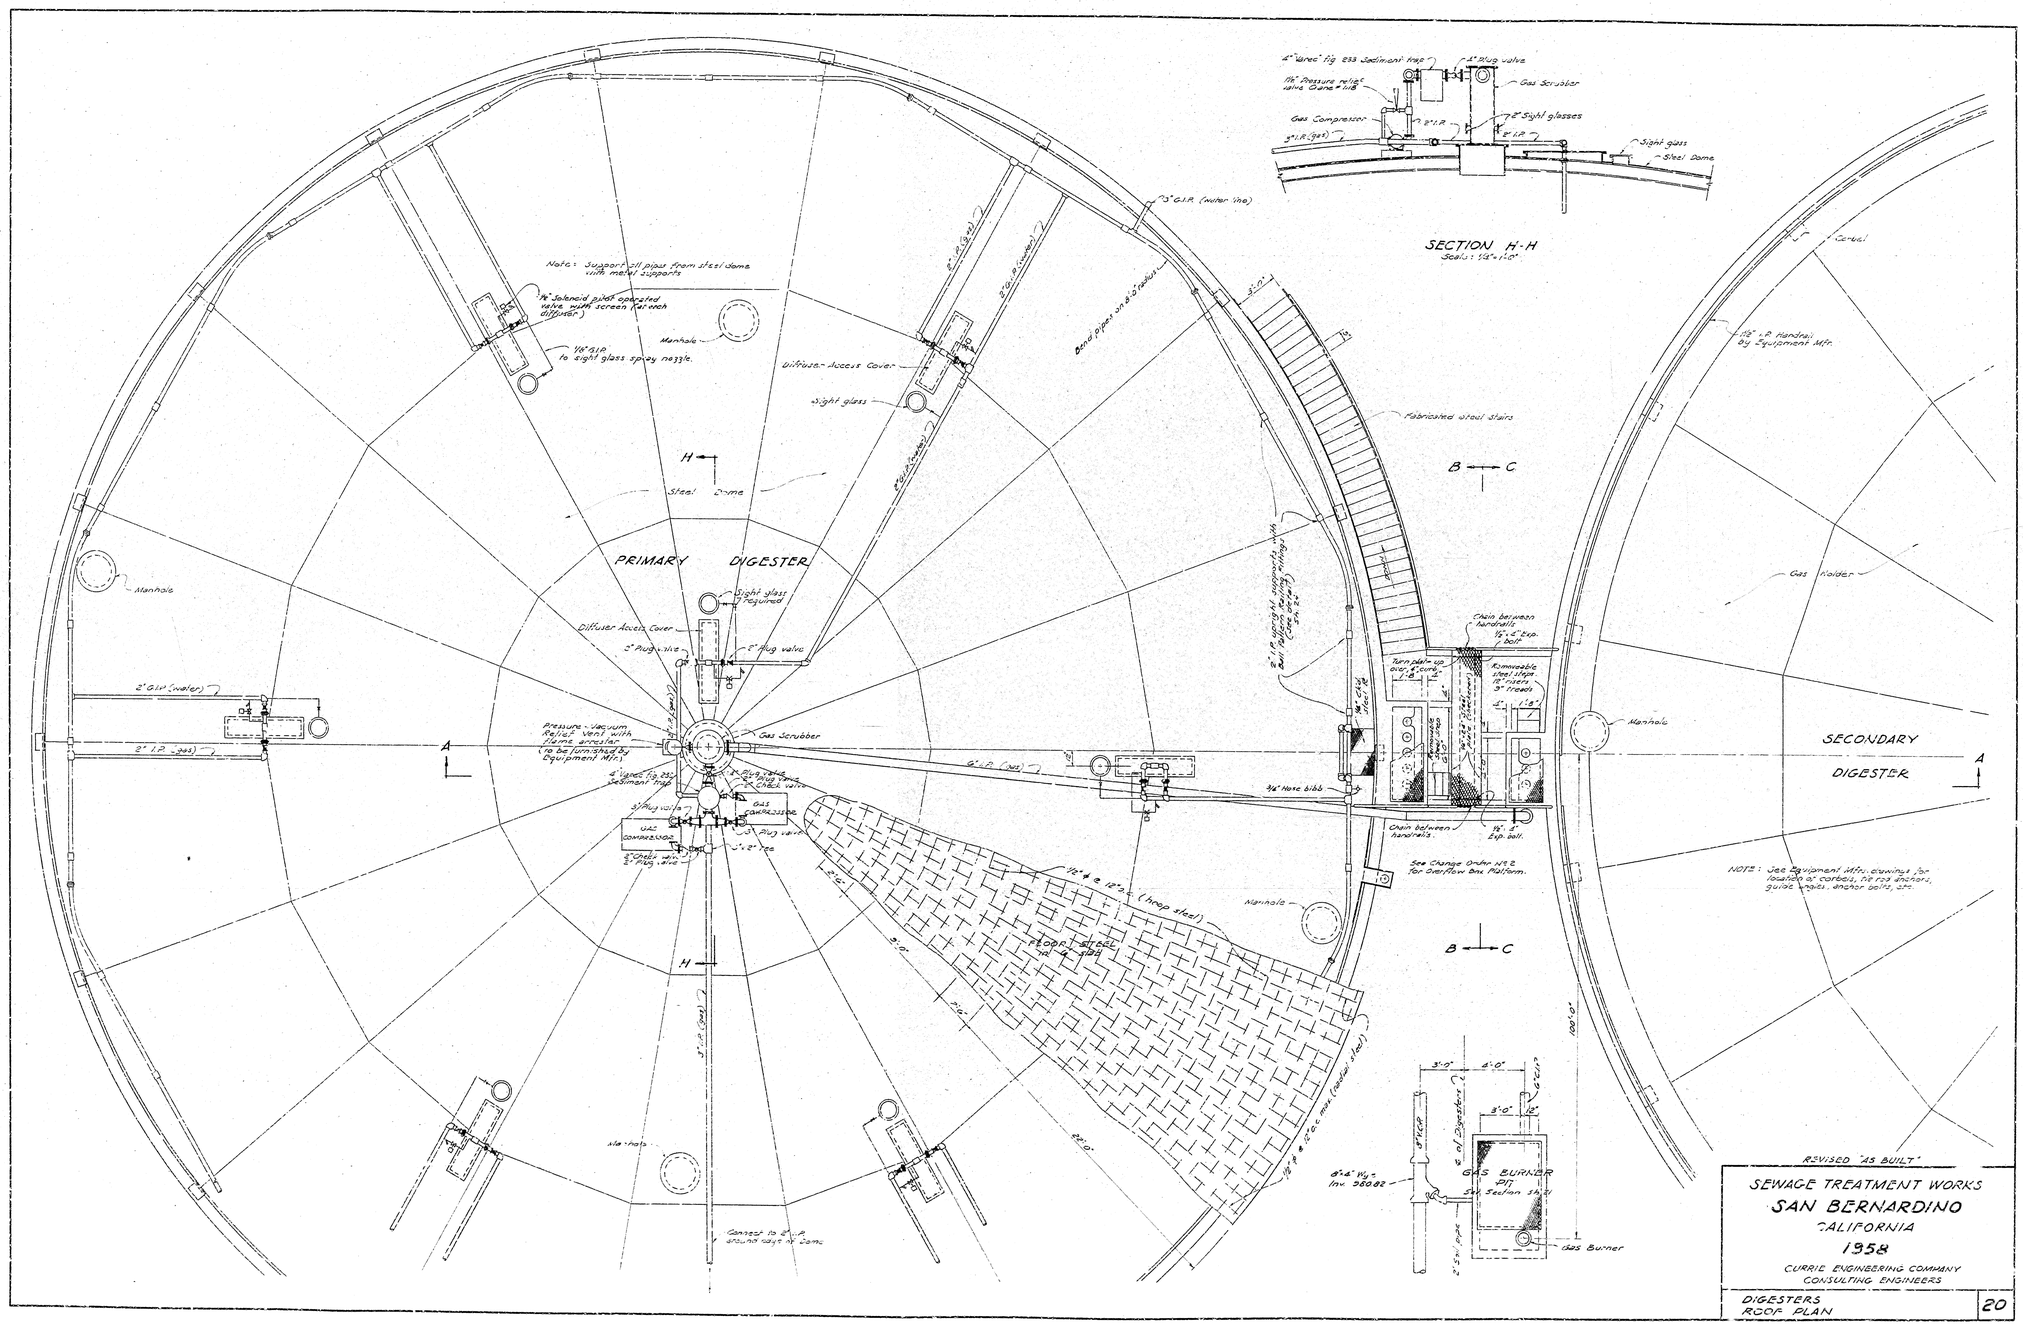
SECTION H-H
Scale: 1/4" = 1'-0"
PRIMARY DIGESTER
SECONDARY DIGESTER
Steel Dome
Manhole
Diffuser Access Cover
Sight glass
Gas Scrubber
Gas Compressor
Gas Holder
Fabricated steel stairs
Gas Burner
GAS BURNER PIT
REVISED "AS BUILT"
SEWAGE TREATMENT WORKS
SAN BERNARDINO
CALIFORNIA
1958
CURRIE ENGINEERING COMPANY
CONSULTING ENGINEERS
DIGESTERS
ROOF PLAN
20