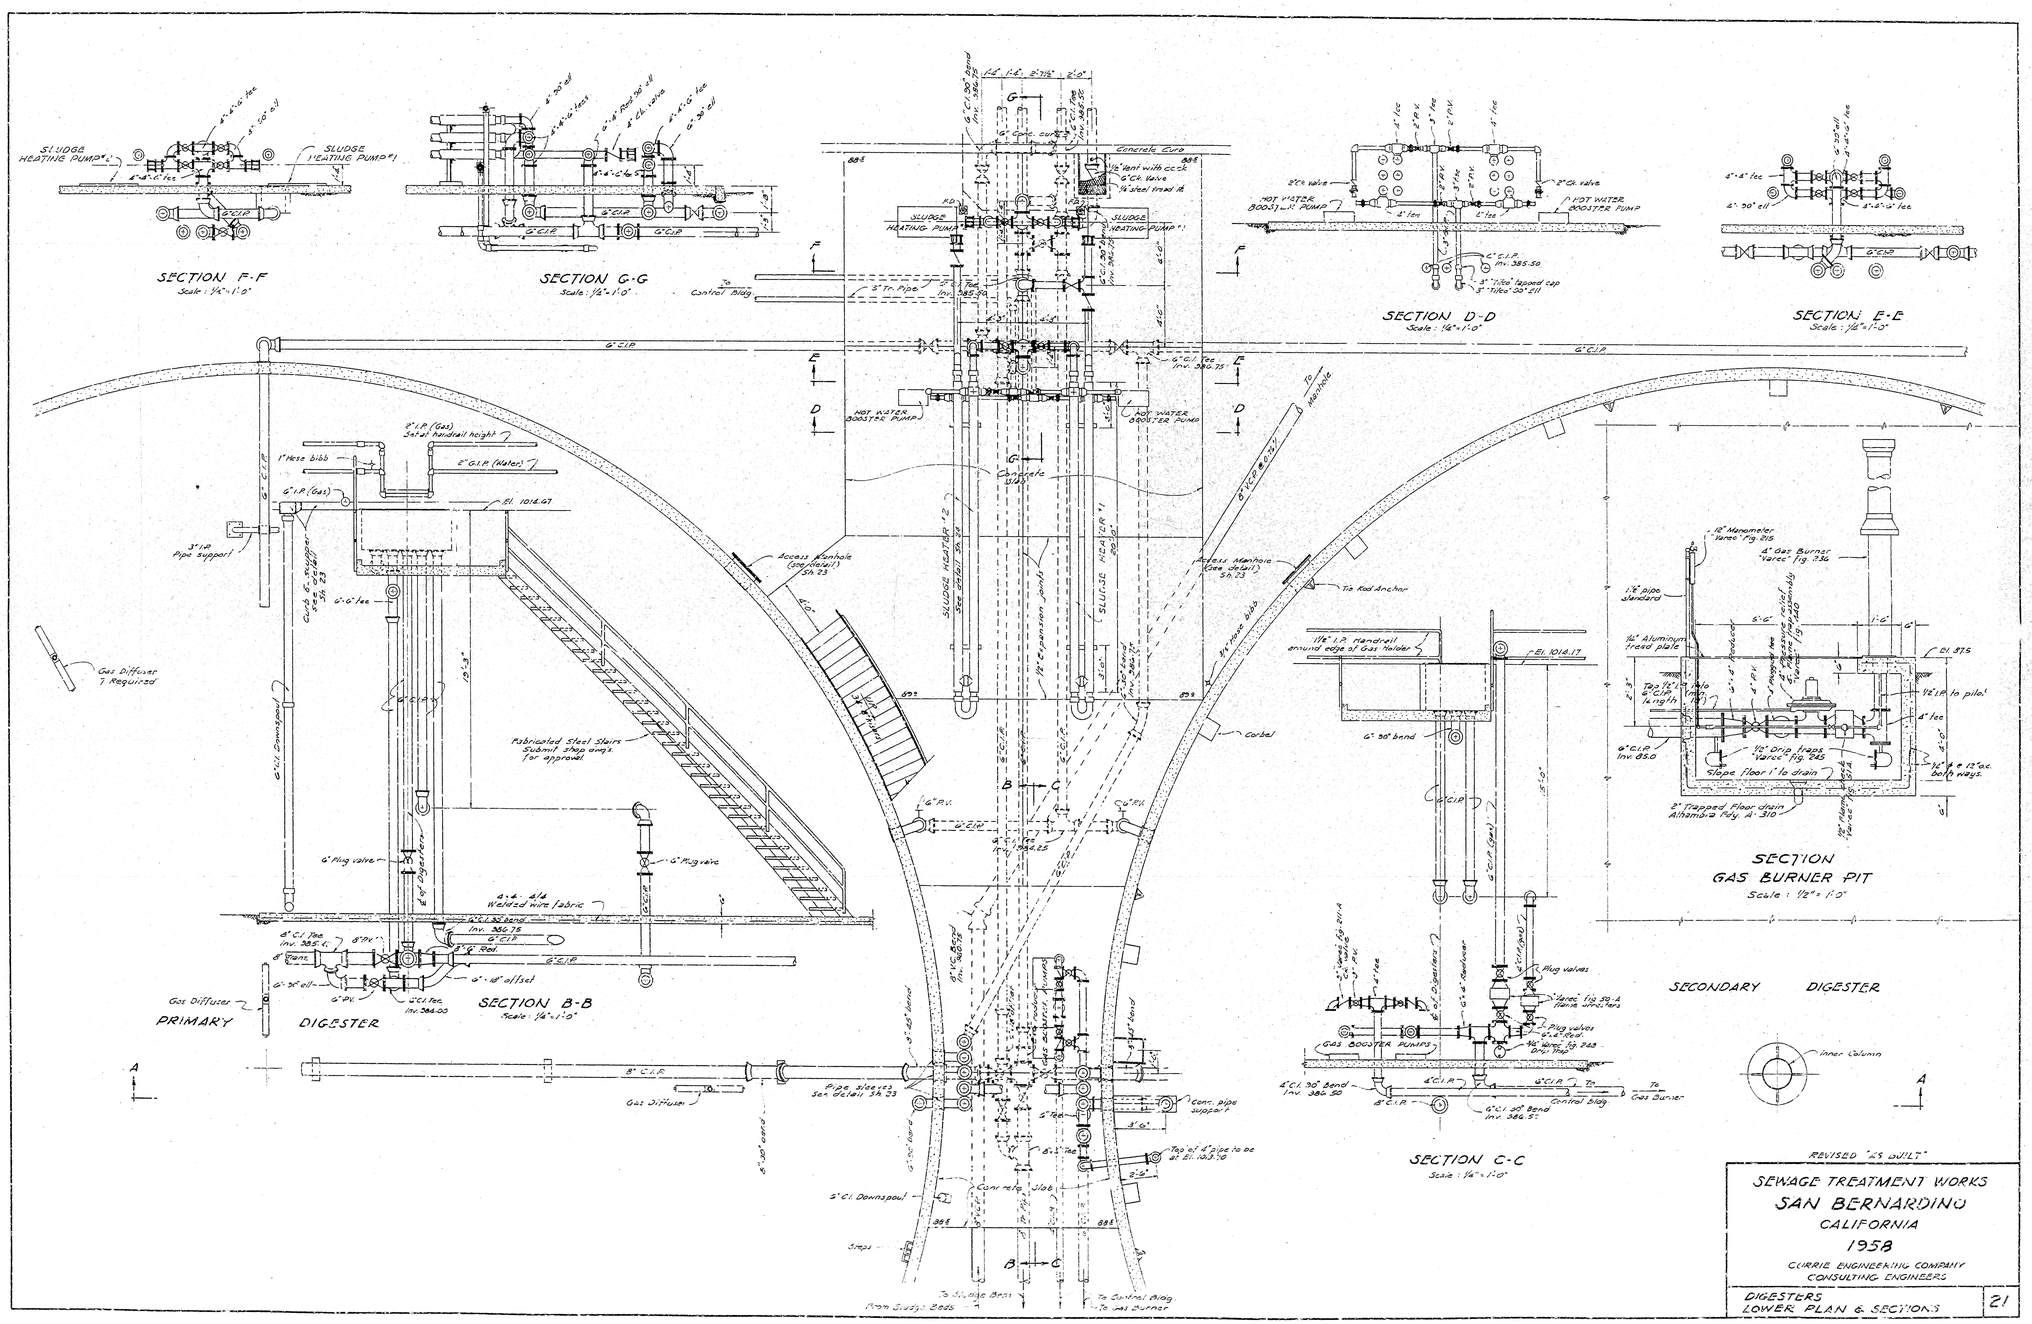
SECTION F-F
Scale: 1/2"=1'-0"
SECTION G-G
Scale: 1/2"=1'-0"
SECTION D-D
Scale: 1/2"=1'-0"
SECTION E-E
Scale: 1/2"=1'-0"
SECTION B-B
Scale: 1/2"=1'-0"
SECTION C-C
Scale: 1/2"=1'-0"
SECTION
GAS BURNER PIT
Scale: 1/2"=1'-0"
PRIMARY DIGESTER
SECONDARY DIGESTER
REVISED "AS BUILT"
SEWAGE TREATMENT WORKS
SAN BERNARDINO
CALIFORNIA
1958
CURRIE ENGINEERING COMPANY
CONSULTING ENGINEERS
DIGESTERS
LOWER PLAN & SECTIONS
21

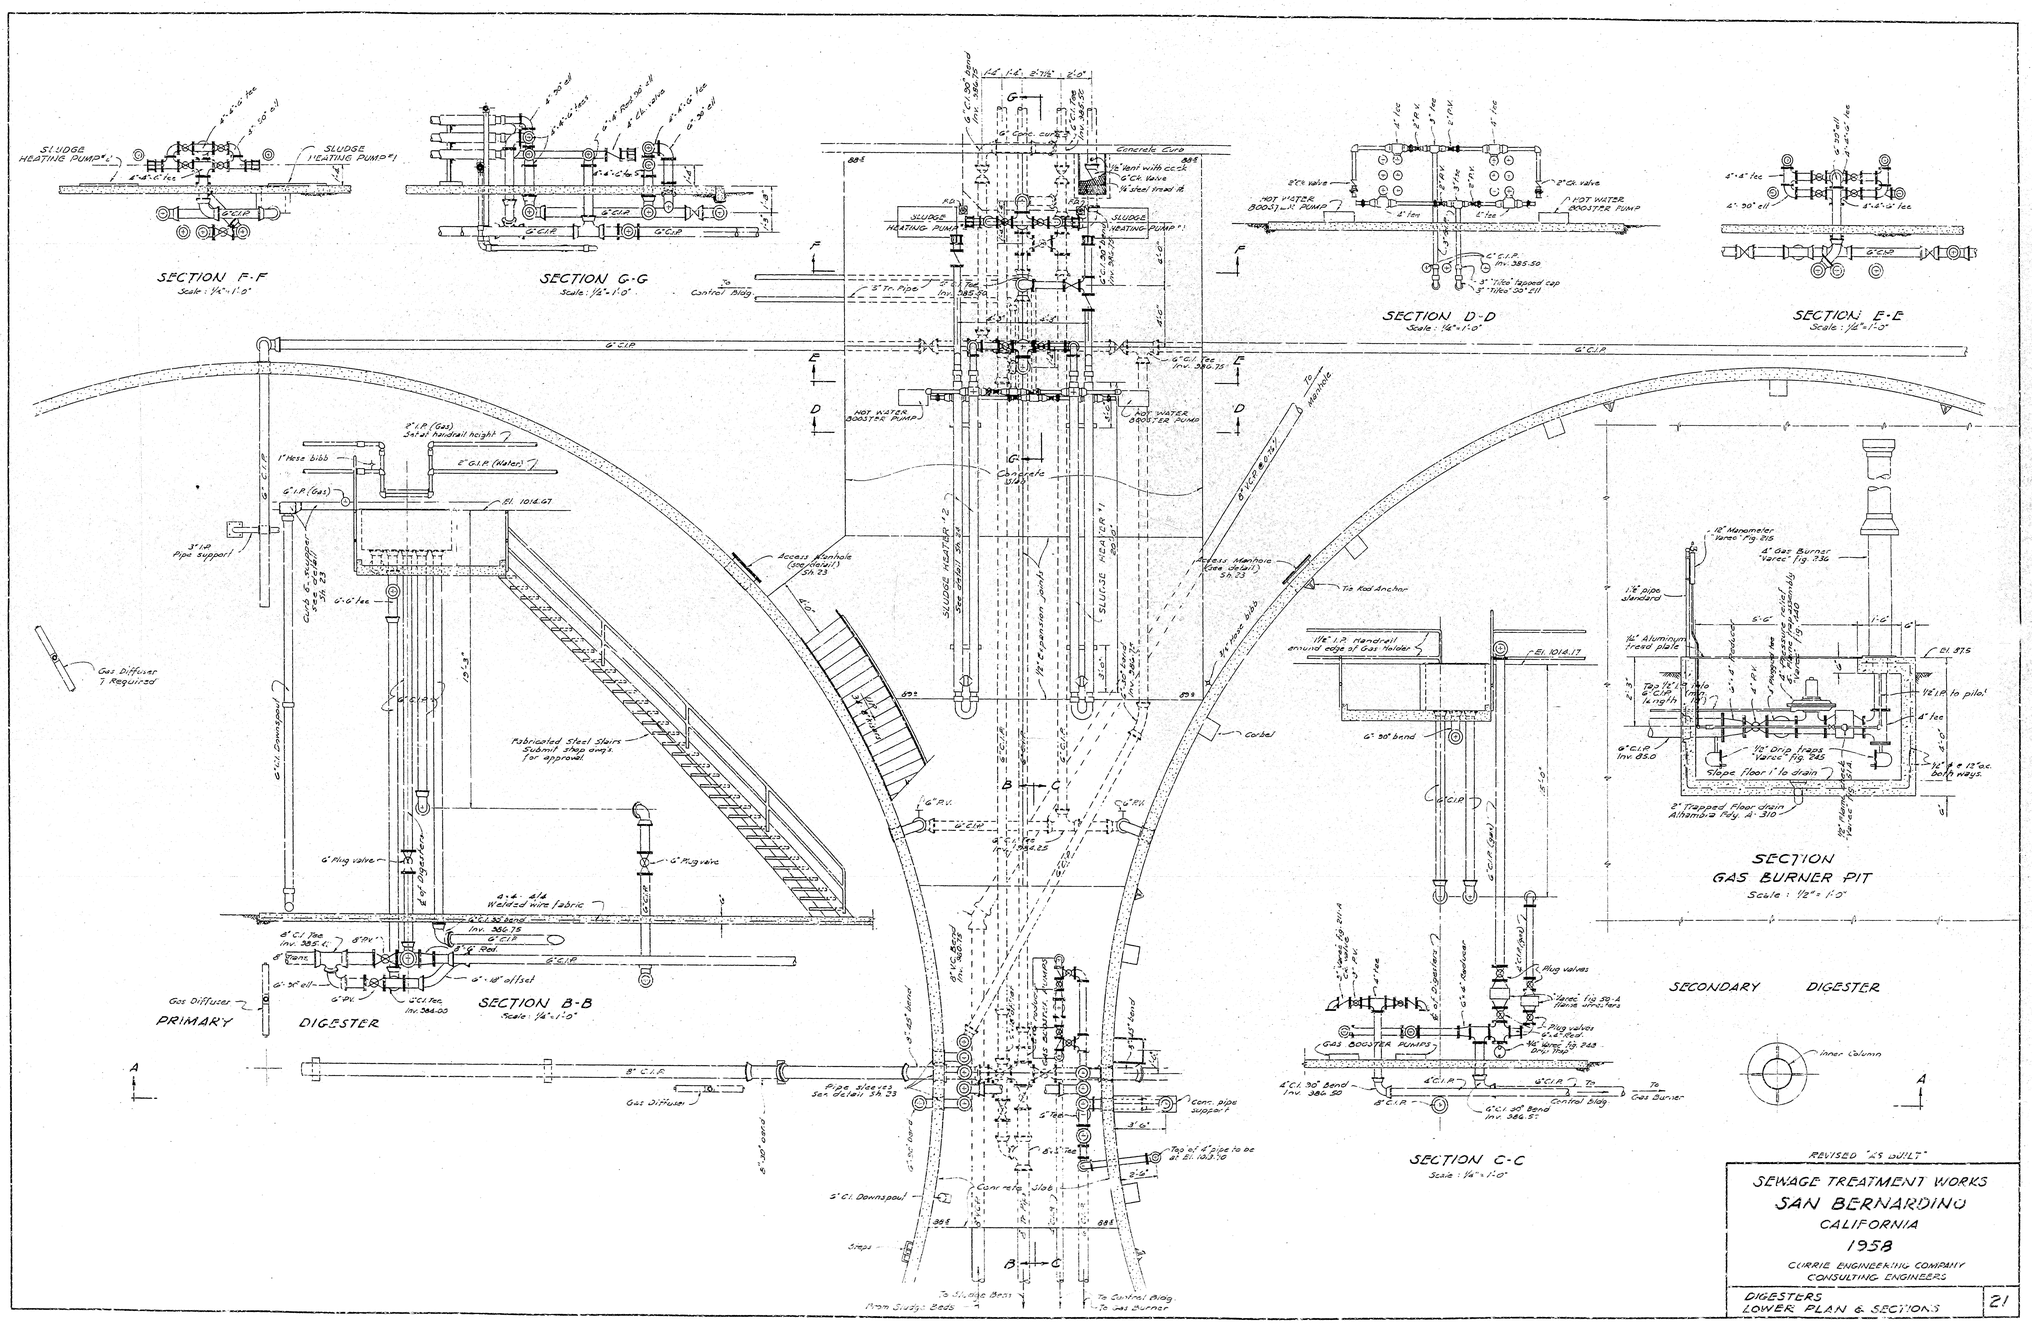
SECTION F-F
Scale: 1/2"=1'-0"
SECTION G-G
Scale: 1/2"=1'-0"
SECTION D-D
Scale: 1/2"=1'-0"
SECTION E-E
Scale: 1/2"=1'-0"
SECTION B-B
Scale: 1/2"=1'-0"
SECTION C-C
Scale: 1/2"=1'-0"
SECTION
GAS BURNER PIT
Scale: 1/2"=1'-0"
PRIMARY DIGESTER
SECONDARY DIGESTER
REVISED "AS BUILT"
SEWAGE TREATMENT WORKS
SAN BERNARDINO
CALIFORNIA
1958
CURRIE ENGINEERING COMPANY
CONSULTING ENGINEERS
DIGESTERS
LOWER PLAN & SECTIONS
21