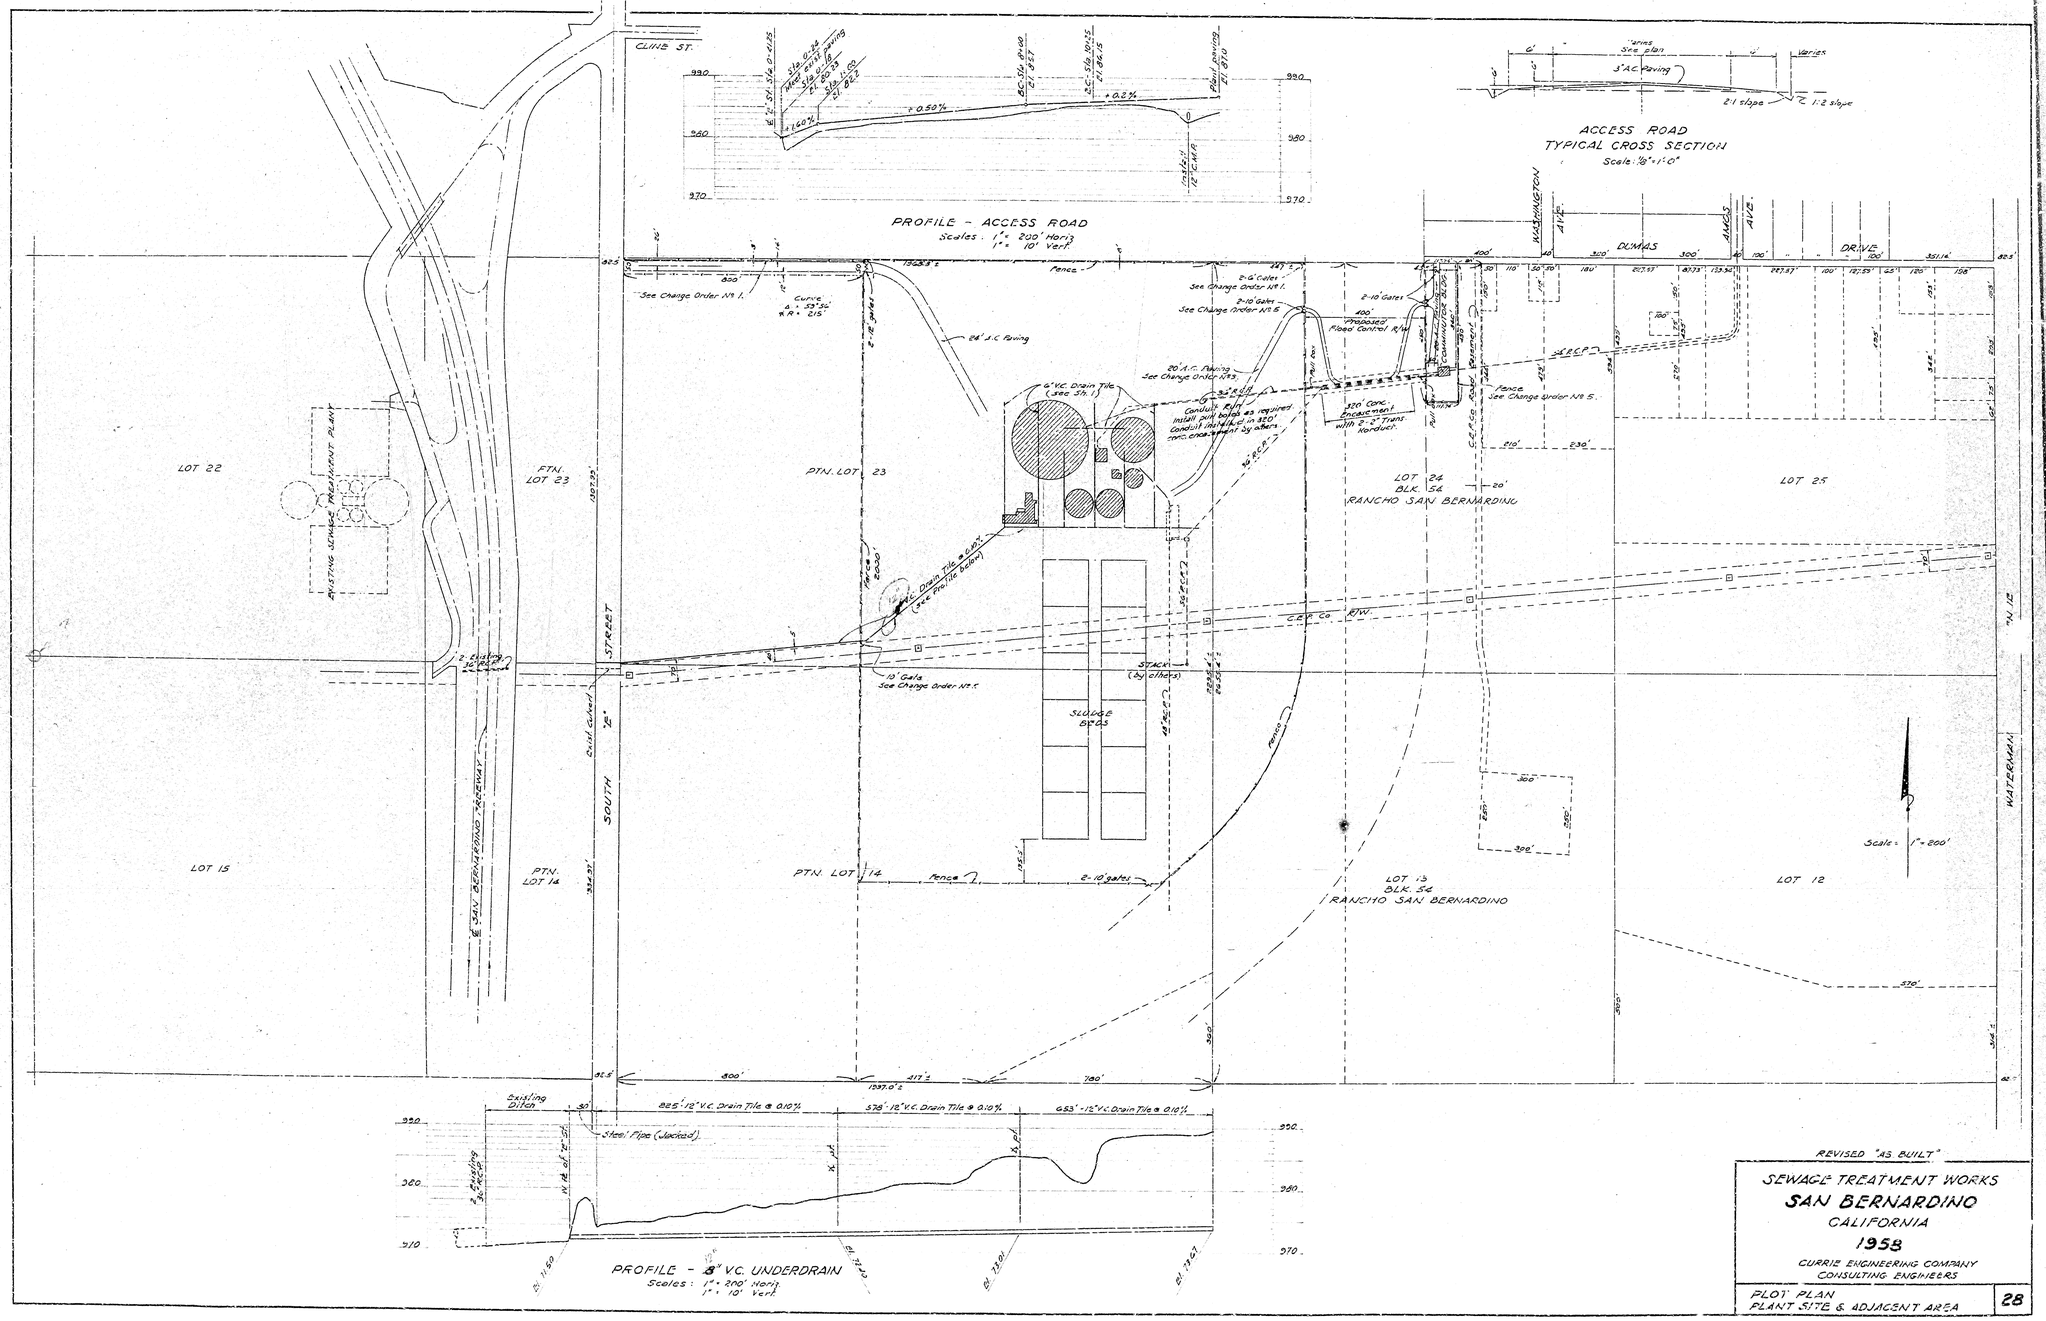
PROFILE - ACCESS ROAD
Scales: 1" = 200' Horiz
1" = 10' Vert.
ACCESS ROAD
TYPICAL CROSS SECTION
Scale: 1/8" = 1'-0"
3" AC Paving
2:1 slope
1:2 slope
Varies
CLINE ST.
WASHINGTON AVE.
DUMAS AVE.
DRIVE
LOT 22
PTN. LOT 23
LOT 24
BLK 54
RANCHO SAN BERNARDINO
LOT 25
EXISTING SEWAGE TREATMENT PLANT
SOUTH STREET
SLUDGE BEDS
C.R.P. Co. R/W
LOT 15
PTN. LOT 14
LOT 13
BLK 54
RANCHO SAN BERNARDINO
LOT 12
WATERMAN
Scale: 1" = 200'
PROFILE - 8" V.C. UNDERDRAIN
Scales: 1" = 200' Horiz
1" = 10' Vert.
REVISED "AS BUILT"
SEWAGE TREATMENT WORKS
SAN BERNARDINO
CALIFORNIA
1958
CURRIE ENGINEERING COMPANY
CONSULTING ENGINEERS
PLOT PLAN
PLANT SITE & ADJACENT AREA
28

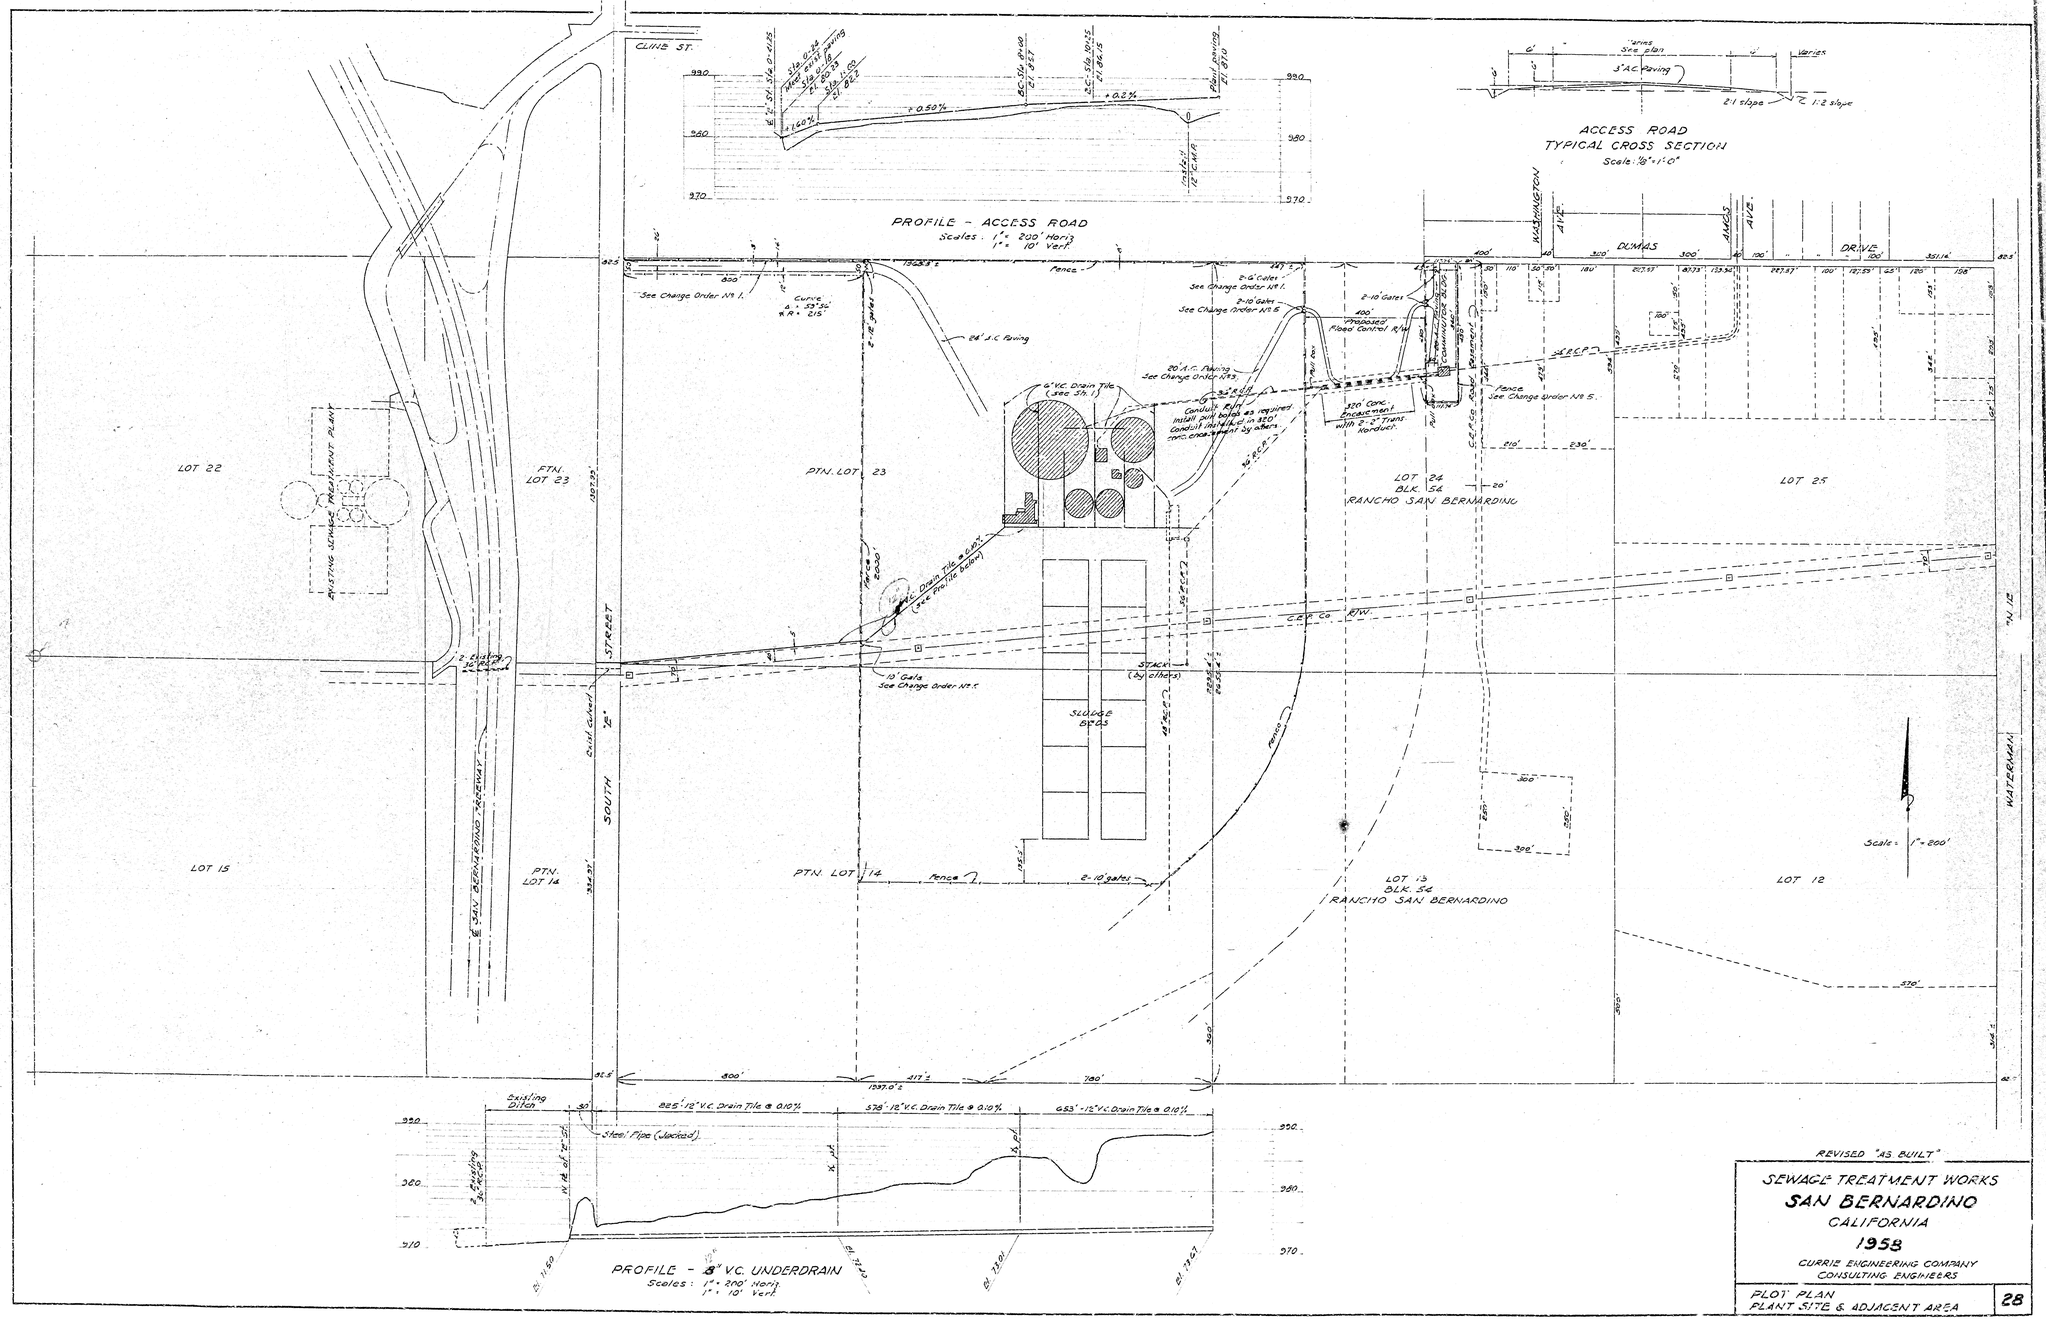
PROFILE - ACCESS ROAD
Scales: 1" = 200' Horiz
1" = 10' Vert.
ACCESS ROAD
TYPICAL CROSS SECTION
Scale: 1/8" = 1'-0"
3" AC Paving
2:1 slope
1:2 slope
Varies
CLINE ST.
WASHINGTON AVE.
DUMAS AVE.
DRIVE
LOT 22
PTN. LOT 23
LOT 24
BLK 54
RANCHO SAN BERNARDINO
LOT 25
EXISTING SEWAGE TREATMENT PLANT
SOUTH STREET
SLUDGE BEDS
C.R.P. Co. R/W
LOT 15
PTN. LOT 14
LOT 13
BLK 54
RANCHO SAN BERNARDINO
LOT 12
WATERMAN
Scale: 1" = 200'
PROFILE - 8" V.C. UNDERDRAIN
Scales: 1" = 200' Horiz
1" = 10' Vert.
REVISED "AS BUILT"
SEWAGE TREATMENT WORKS
SAN BERNARDINO
CALIFORNIA
1958
CURRIE ENGINEERING COMPANY
CONSULTING ENGINEERS
PLOT PLAN
PLANT SITE & ADJACENT AREA
28