
 


AS BUILT

BENCH MARKS

DATE: 7/2/65
BY: [Signature]

SCALE: 1" = 40'

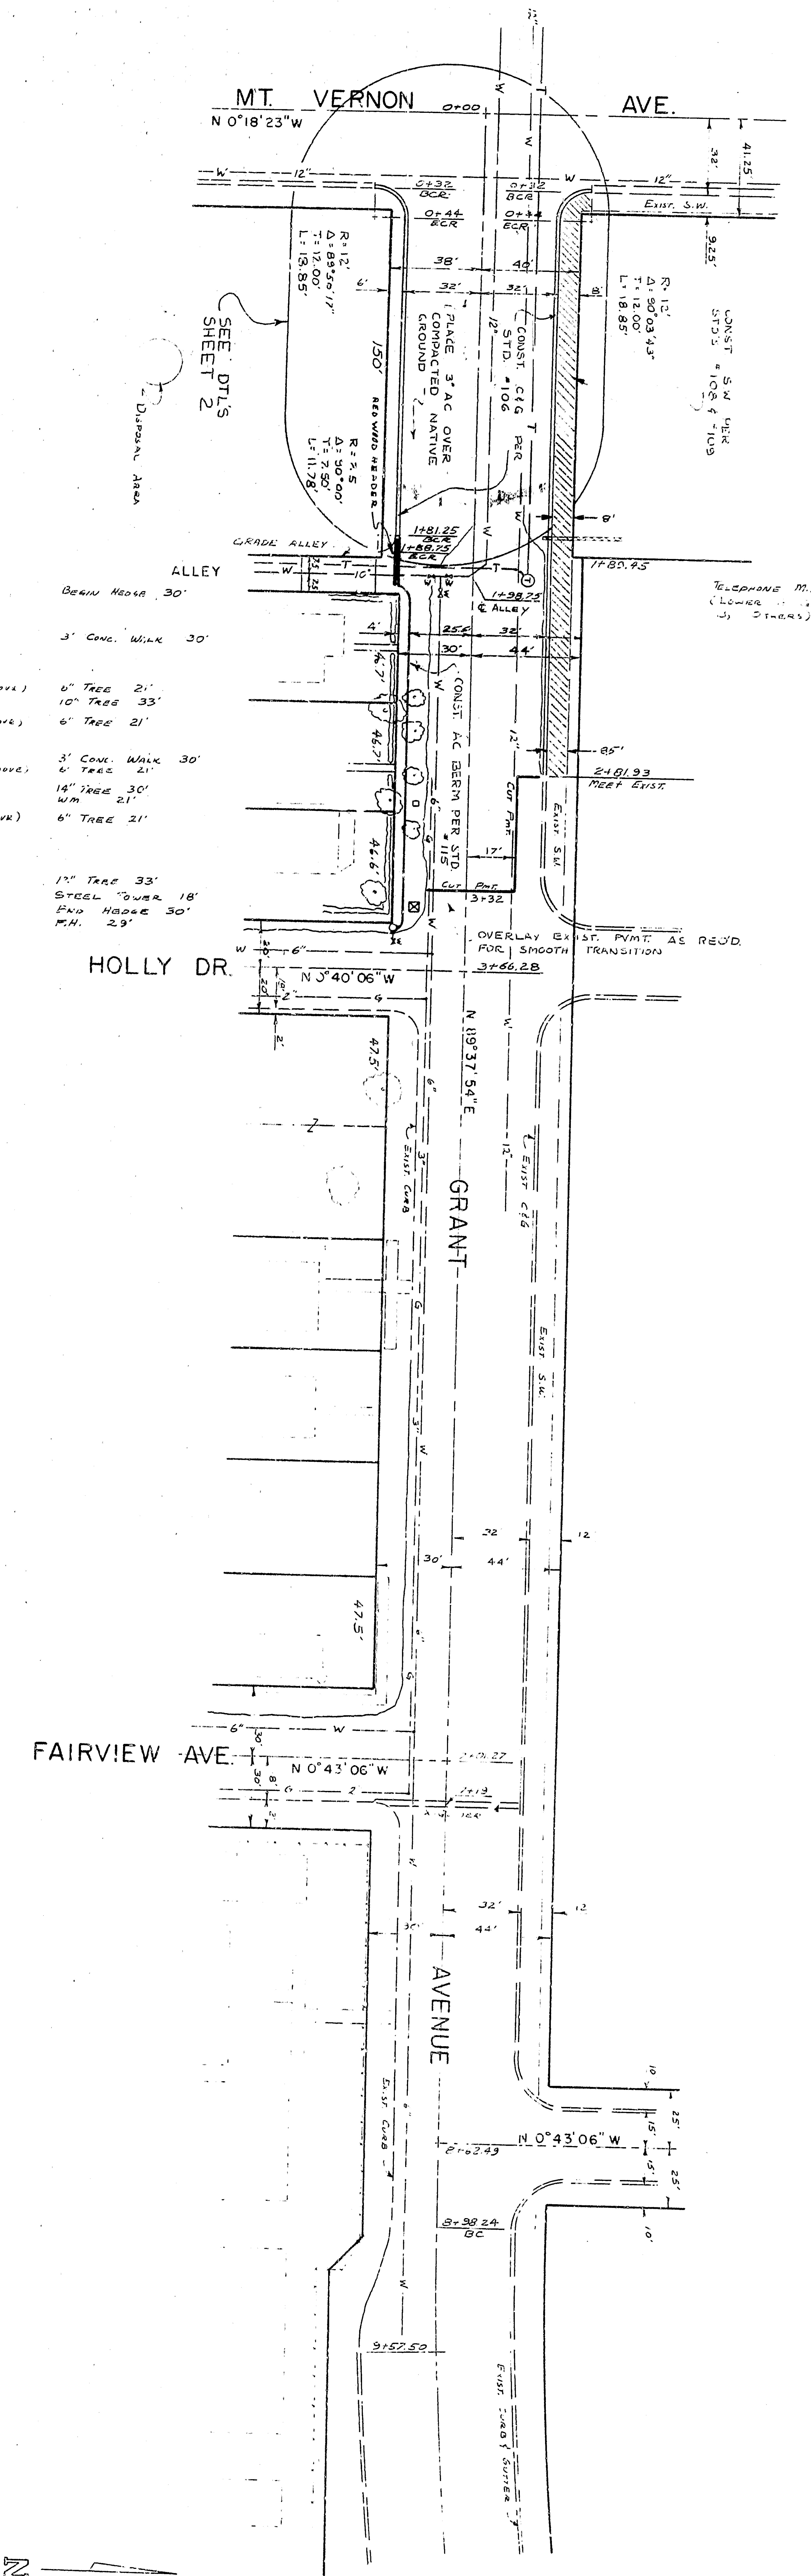

GENERAL NOTES

CITY OF SAN BERNARDINO
GAS TAX PROJECT NO. 338

APPROVED BY: [Signature]
CITY ENGINEER

DATE: 7/2/65


GRANT AVENUE
GAS TAX PROJECT NO. 95
MT VERNON AVE TO HOLLY DRIVE
PLAN NO. 1498

DATE: 7/2/65
SCALE: 1" = 40'

APPROVED BY: [Signature]
CITY ENGINEER

SHEET 1 OF 2