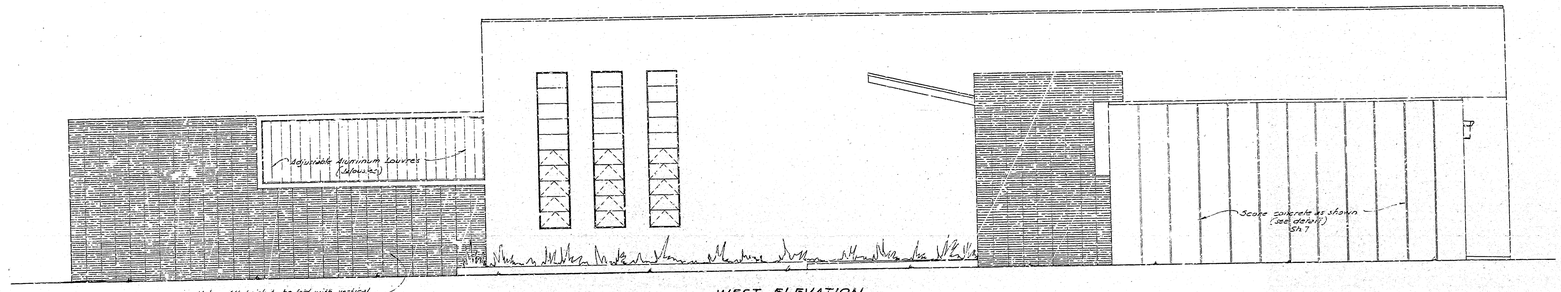

Note: All brick to be laid with vertical joints in line - joints to be raked. Brick to be Norman Brick of color as selected.

WEST ELEVATION
Scale: 1/8"=1'-0"

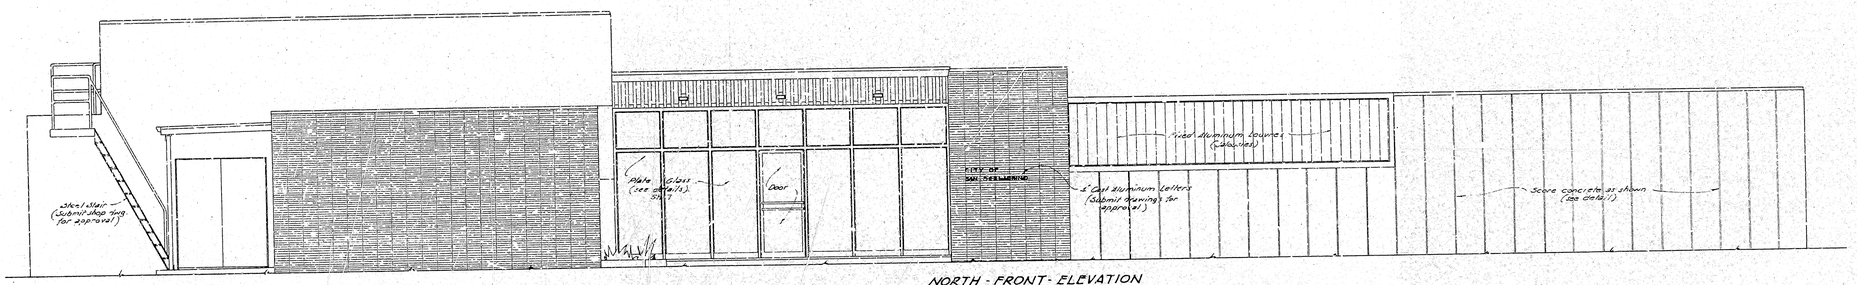

NORTH - FRONT - ELEVATION
Scale: 1/8"=1'-0"

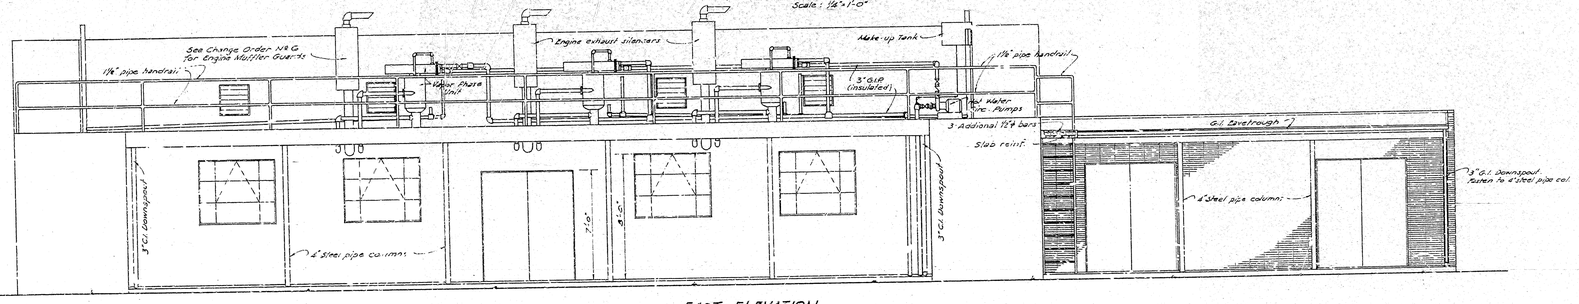

EAST ELEVATION
Scale: 1/8"=1'-0"

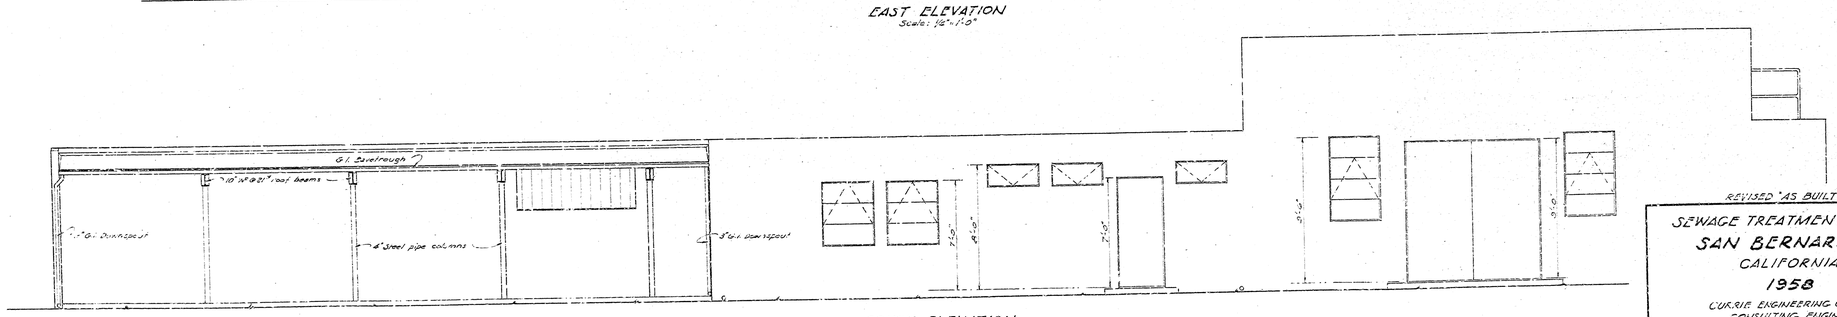

SOUTH ELEVATION
Scale: 1/8"=1'-0"

REVISED "AS BUILT"

SEWAGE TREATMENT WORKS
SAN BERNARDINO
CALIFORNIA
1958

CURRIE ENGINEERING COMPANY
CONSULTING ENGINEERS

CONTROL BUILDING ELEVATIONS

3

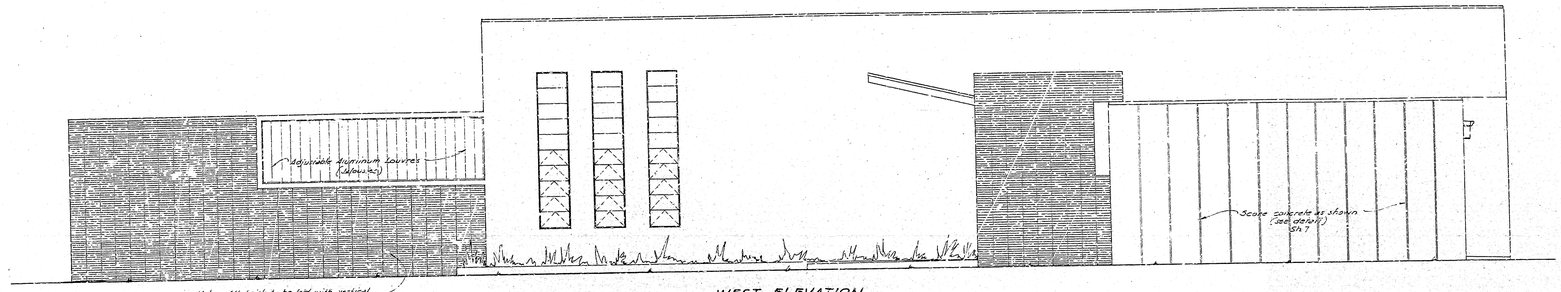

Note: All brick to be laid with vertical joints in line - joints to be raked. Brick to be Norman Brick of color as selected.

WEST ELEVATION
Scale: 1/8"=1'-0"

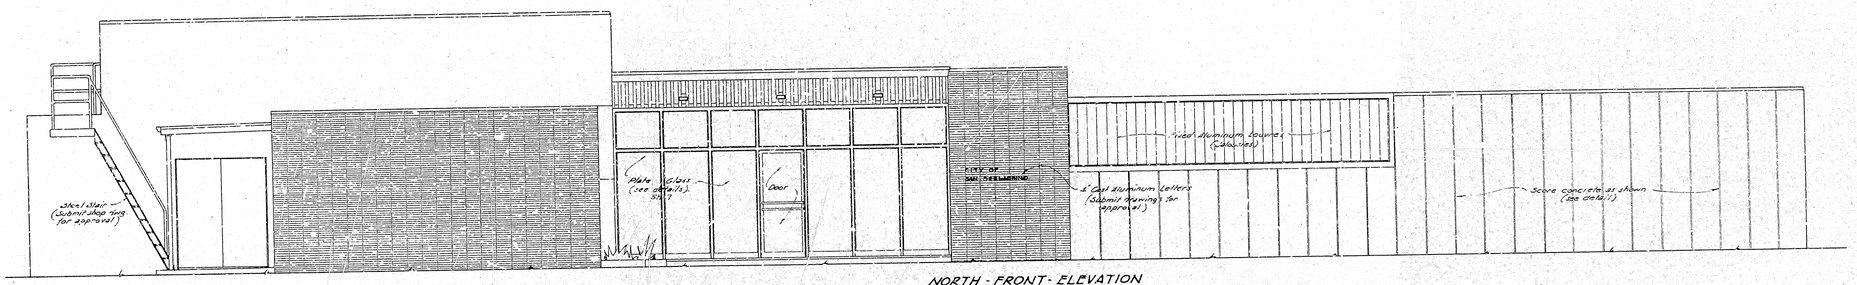

NORTH - FRONT - ELEVATION
Scale: 1/8"=1'-0"

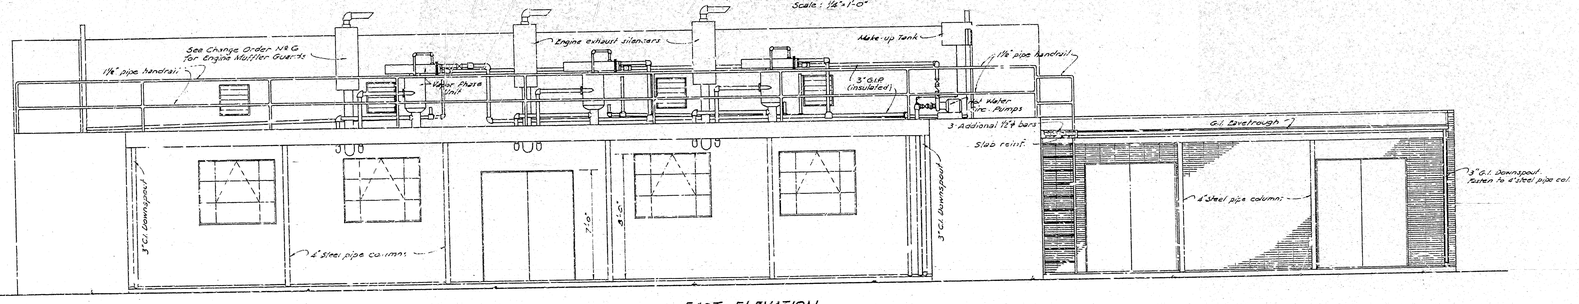

EAST ELEVATION
Scale: 1/8"=1'-0"

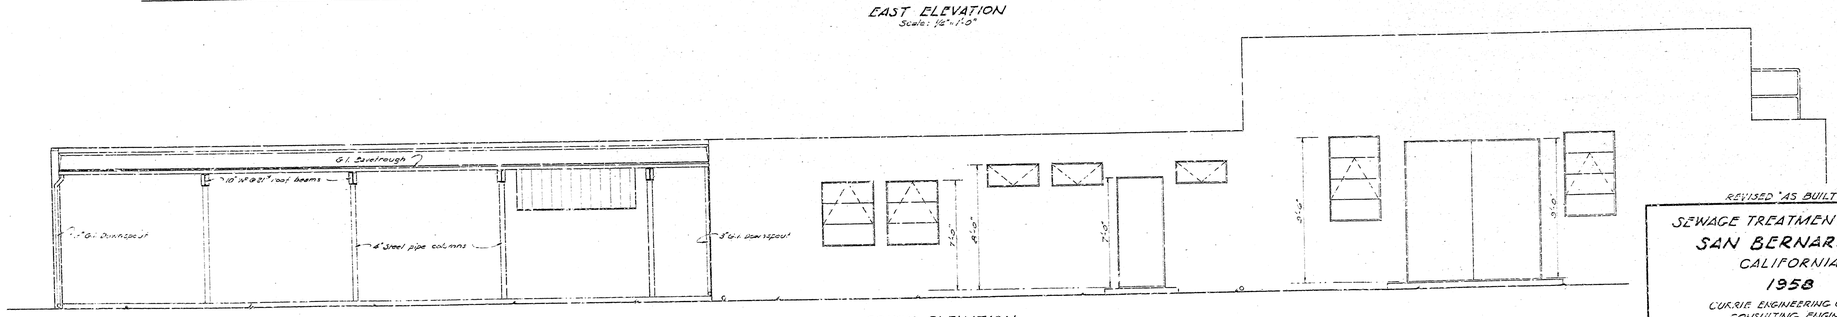

SOUTH ELEVATION
Scale: 1/8"=1'-0"

REVISED "AS BUILT"

SEWAGE TREATMENT WORKS
SAN BERNARDINO
CALIFORNIA
1958

CURRIE ENGINEERING COMPANY
CONSULTING ENGINEERS

CONTROL BUILDING ELEVATIONS

3

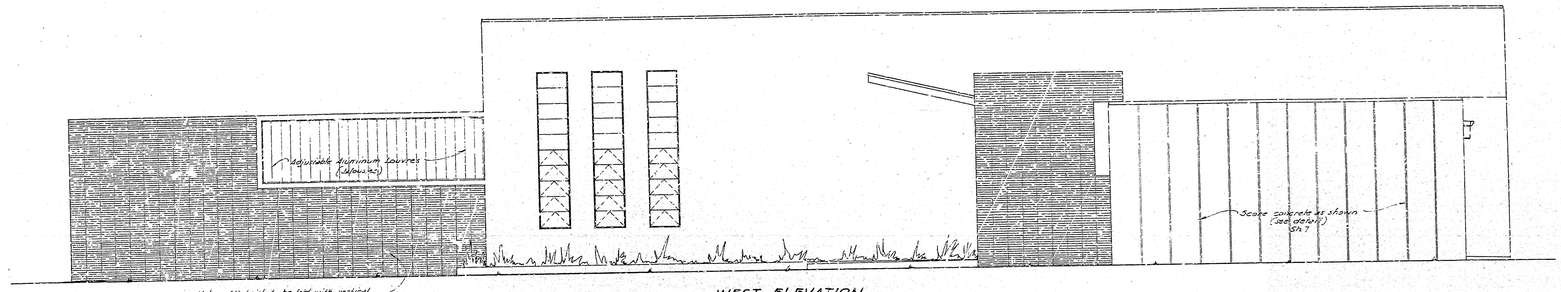

Note: All brick to be laid with vertical joints in line - joints to be raked. Brick to be Norman Brick of color as selected.

WEST ELEVATION
Scale: 1/8"=1'-0"

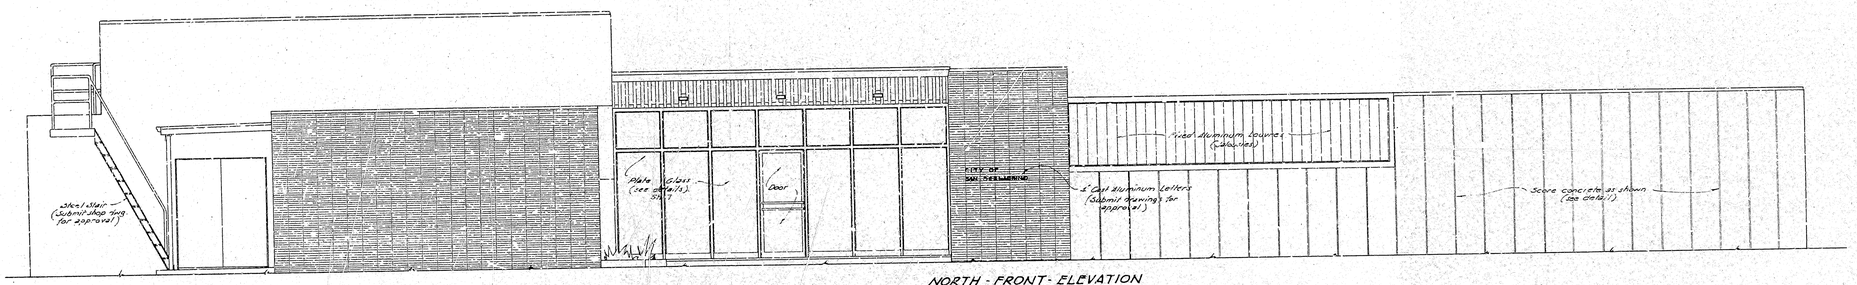

NORTH - FRONT - ELEVATION
Scale: 1/8"=1'-0"

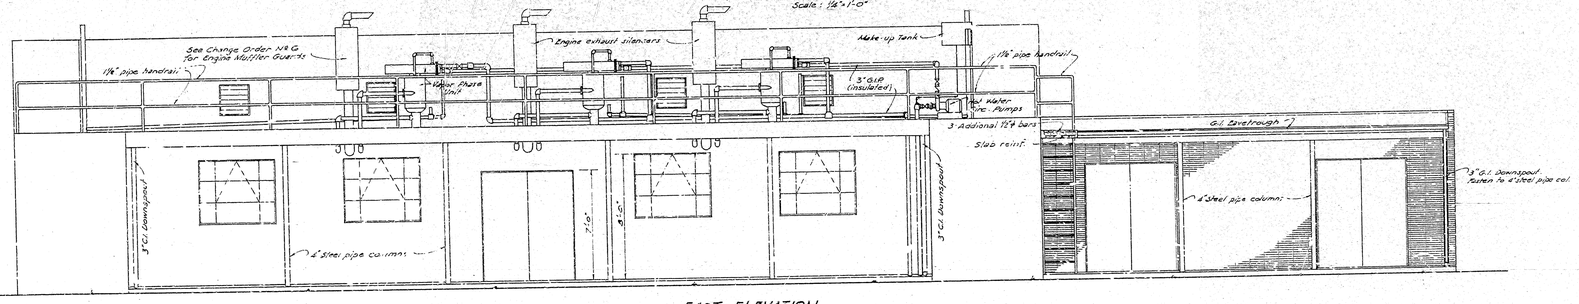

EAST ELEVATION
Scale: 1/8"=1'-0"

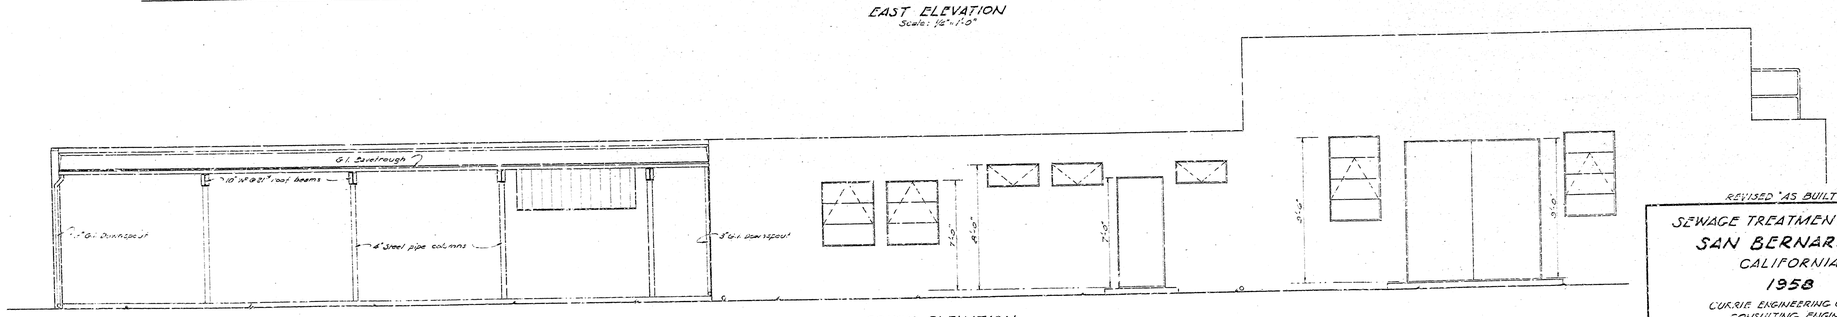

SOUTH ELEVATION
Scale: 1/8"=1'-0"

REVISED "AS BUILT"

SEWAGE TREATMENT WORKS
SAN BERNARDINO
CALIFORNIA
1958

CURRIE ENGINEERING COMPANY
CONSULTING ENGINEERS

CONTROL BUILDING ELEVATIONS

3