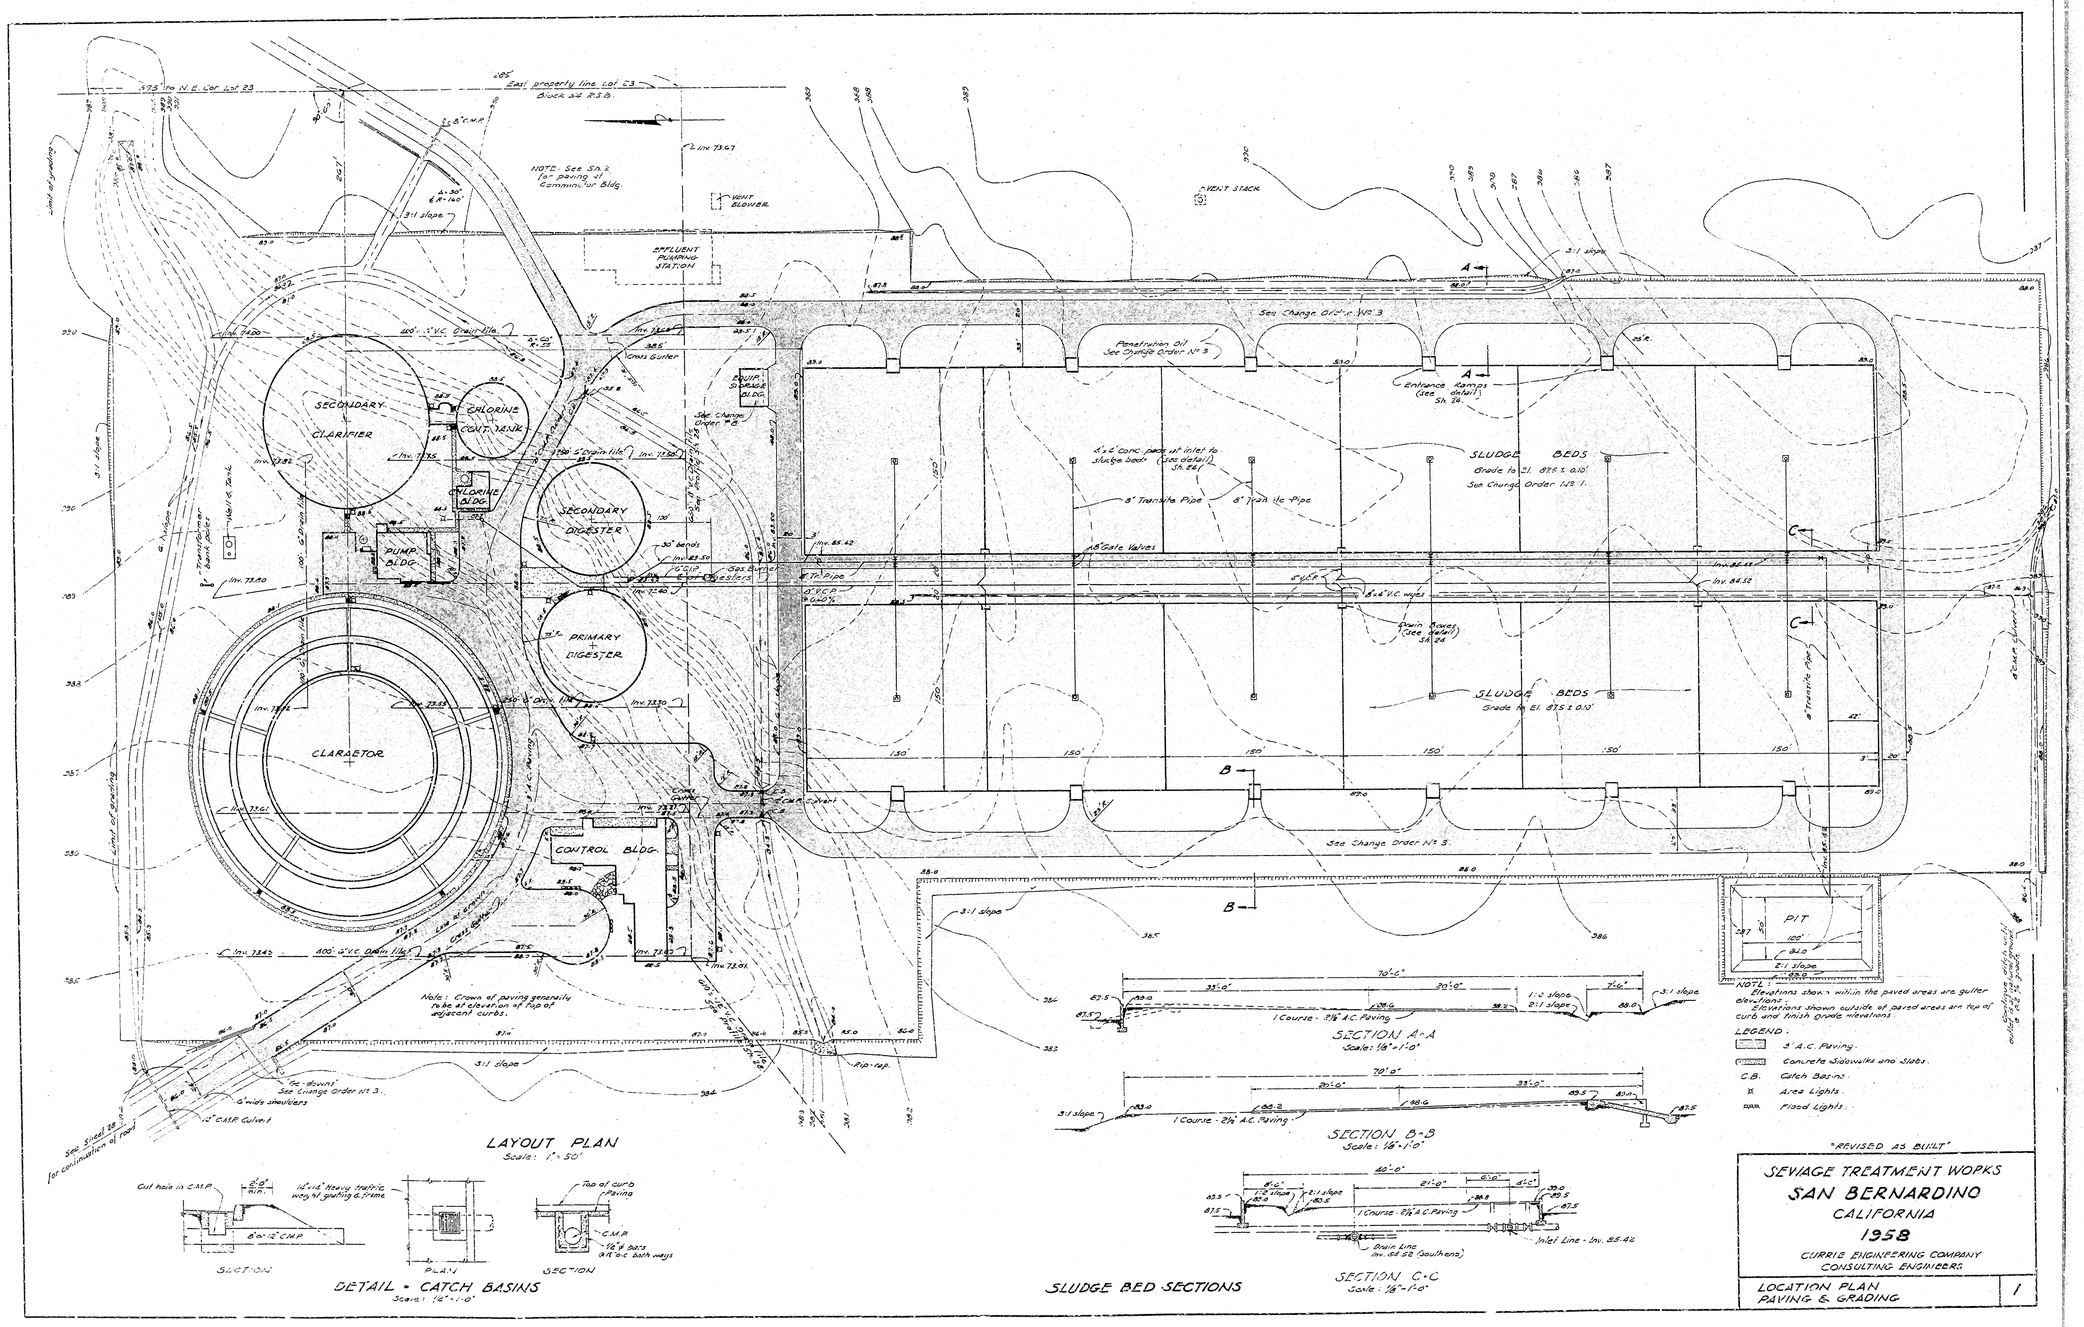
East property line Lot 23 Block 34 R.S.B.
NOTE: See Sh. 4 for paving at Commutator Bldg.
VENT BLOWER
EFFLUENT PUMPING STATION
VENT STACK
See Change Order No. 3
Penetration Oil See Change Order No. 3
Entrance Ramps (See detail) Sh. 24
SECONDARY CLARIFIER
CHLORINE CONT. TANK
CHLORINE BLDG.
SECONDARY DIGESTER
PUMP BLDG.
PRIMARY DIGESTER
CLARIFIER
CONTROL BLDG.
SLUDGE BEDS
Grade to El. 875 ± 0.10
See Change Order No. 3
8" Transite Pipe
8" Gate Valves
Drain Bowl (See detail) Sh. 24
See Change Order No. 3
PIT
Note: Crown of paving generally to be at elevation of top of adjacent curbs.
Tie-downs See Change Order No. 3.
See Sheet 28 for continuation of road
LAYOUT PLAN
Scale: 1" = 50'
SECTION A-A
Scale: 1/8" = 1'-0"
1 Course - 3 1/2" A.C. Paving
SECTION B-B
Scale: 1/8" = 1'-0"
1 Course - 2 1/2" A.C. Paving
SECTION C-C
Scale: 1/8" = 1'-0"
1 Course - 2 1/2" A.C. Paving
Drain Line Inv. 88.58 (southern)
Inlet Line - Inv. 85.42
SLUDGE BED SECTIONS
SECTION
PLAN
SECTION
DETAIL - CATCH BASINS
Scale: 1/2" = 1'-0"
NOTE: Elevations shown within the paved areas are gutter elevations. Elevations shown outside of paved areas are top of curb and finish grade elevations.
LEGEND:
3" A.C. Paving.
Concrete Sidewalks and Slabs.
C.B. Catch Basins.
Area Lights.
Flood Lights.
"REVISED AS BUILT"
SEWAGE TREATMENT WORKS
SAN BERNARDINO
CALIFORNIA
1958
CURRIE ENGINEERING COMPANY
CONSULTING ENGINEERS
LOCATION PLAN
PAVING & GRADING
1

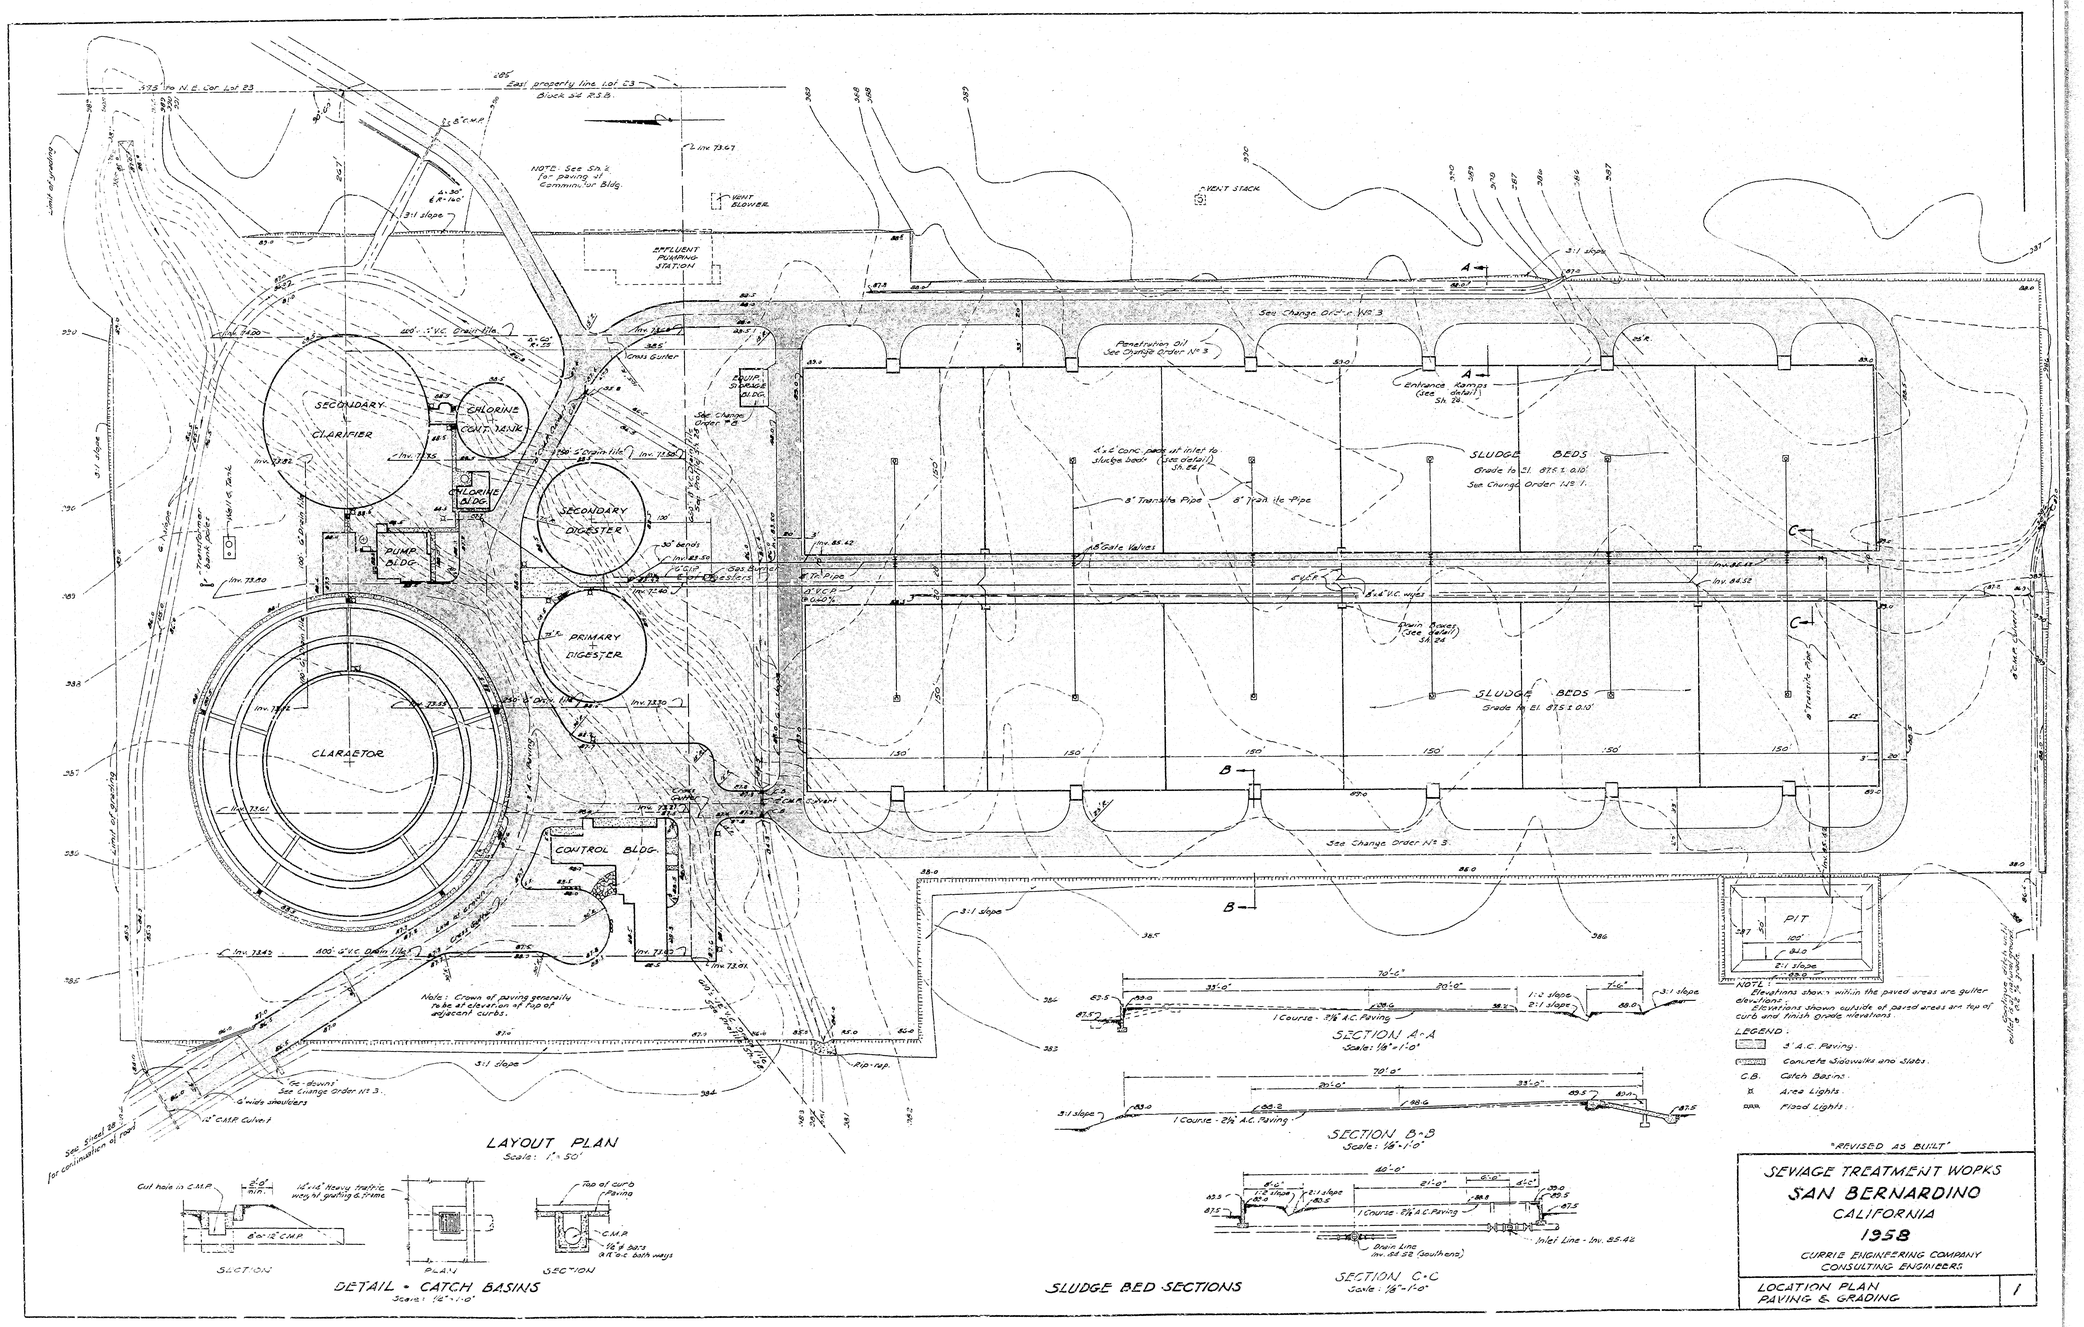
East property line Lot 23 Block 34 R.S.B.
NOTE: See Sh. 4 for paving at Commutator Bldg.
VENT BLOWER
EFFLUENT PUMPING STATION
VENT STACK
See Change Order No. 3
Penetration Oil See Change Order No. 3
Entrance Ramps (See detail) Sh. 24
SECONDARY CLARIFIER
CHLORINE CONT. TANK
CHLORINE BLDG.
SECONDARY DIGESTER
PUMP BLDG.
PRIMARY DIGESTER
CLARIFIER
CONTROL BLDG.
SLUDGE BEDS
Grade to El. 875 ± 0.10
See Change Order No. 3
8" Transite Pipe
8" Gate Valves
Drain Bowl (See detail) Sh. 24
See Change Order No. 3
PIT
Note: Crown of paving generally to be at elevation of top of adjacent curbs.
Tie-downs See Change Order No. 3.
See Sheet 28 for continuation of road
LAYOUT PLAN
Scale: 1" = 50'
SECTION A-A
Scale: 1/8" = 1'-0"
1 Course - 3 1/2" A.C. Paving
SECTION B-B
Scale: 1/8" = 1'-0"
1 Course - 2 1/2" A.C. Paving
SECTION C-C
Scale: 1/8" = 1'-0"
1 Course - 2 1/2" A.C. Paving
Drain Line Inv. 88.58 (southern)
Inlet Line - Inv. 85.42
SLUDGE BED SECTIONS
SECTION
PLAN
SECTION
DETAIL - CATCH BASINS
Scale: 1/2" = 1'-0"
NOTE: Elevations shown within the paved areas are gutter elevations. Elevations shown outside of paved areas are top of curb and finish grade elevations.
LEGEND:
3" A.C. Paving.
Concrete Sidewalks and Slabs.
C.B. Catch Basins.
Area Lights.
Flood Lights.
"REVISED AS BUILT"
SEWAGE TREATMENT WORKS
SAN BERNARDINO
CALIFORNIA
1958
CURRIE ENGINEERING COMPANY
CONSULTING ENGINEERS
LOCATION PLAN
PAVING & GRADING
1