

Note: Position of Pier A and dimensions of bearing abutment in Plan 5 are to be confirmed with the Engineer after verification of dimension "B".




PIER FOOTING TABLE

NOTE: FOR ABUTMENT & ABOUT 7 DIMENSIONS SEE SH. A-2-2

| Pier | Plan 1 | Plan 2 | Plan 3 | Plan 4 | Plan 5 | Plan 6 |
|-------------------------------|--------|--------|--------|--------|--------|--------|



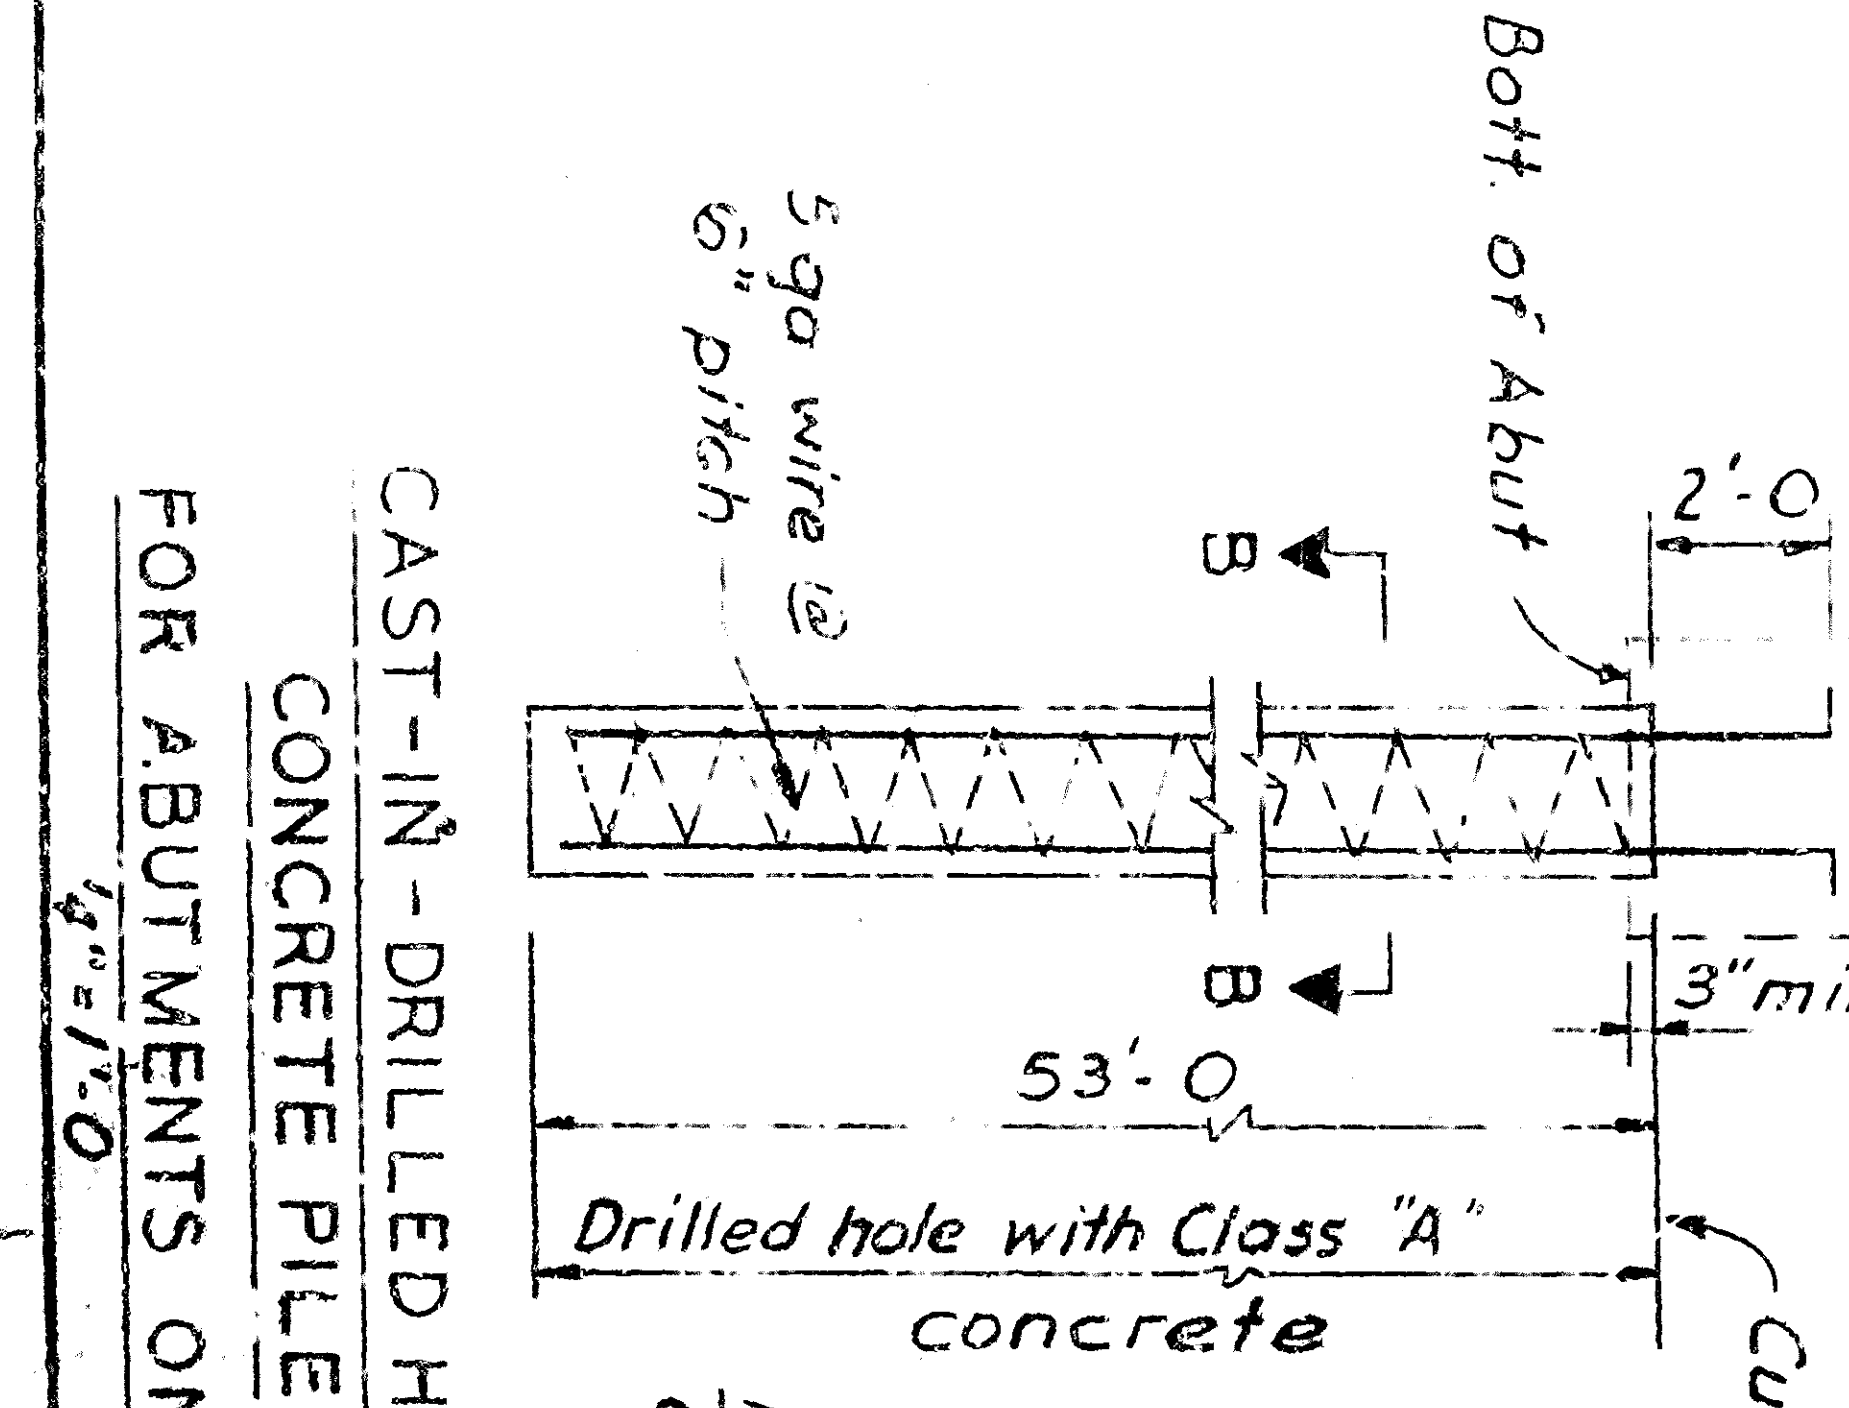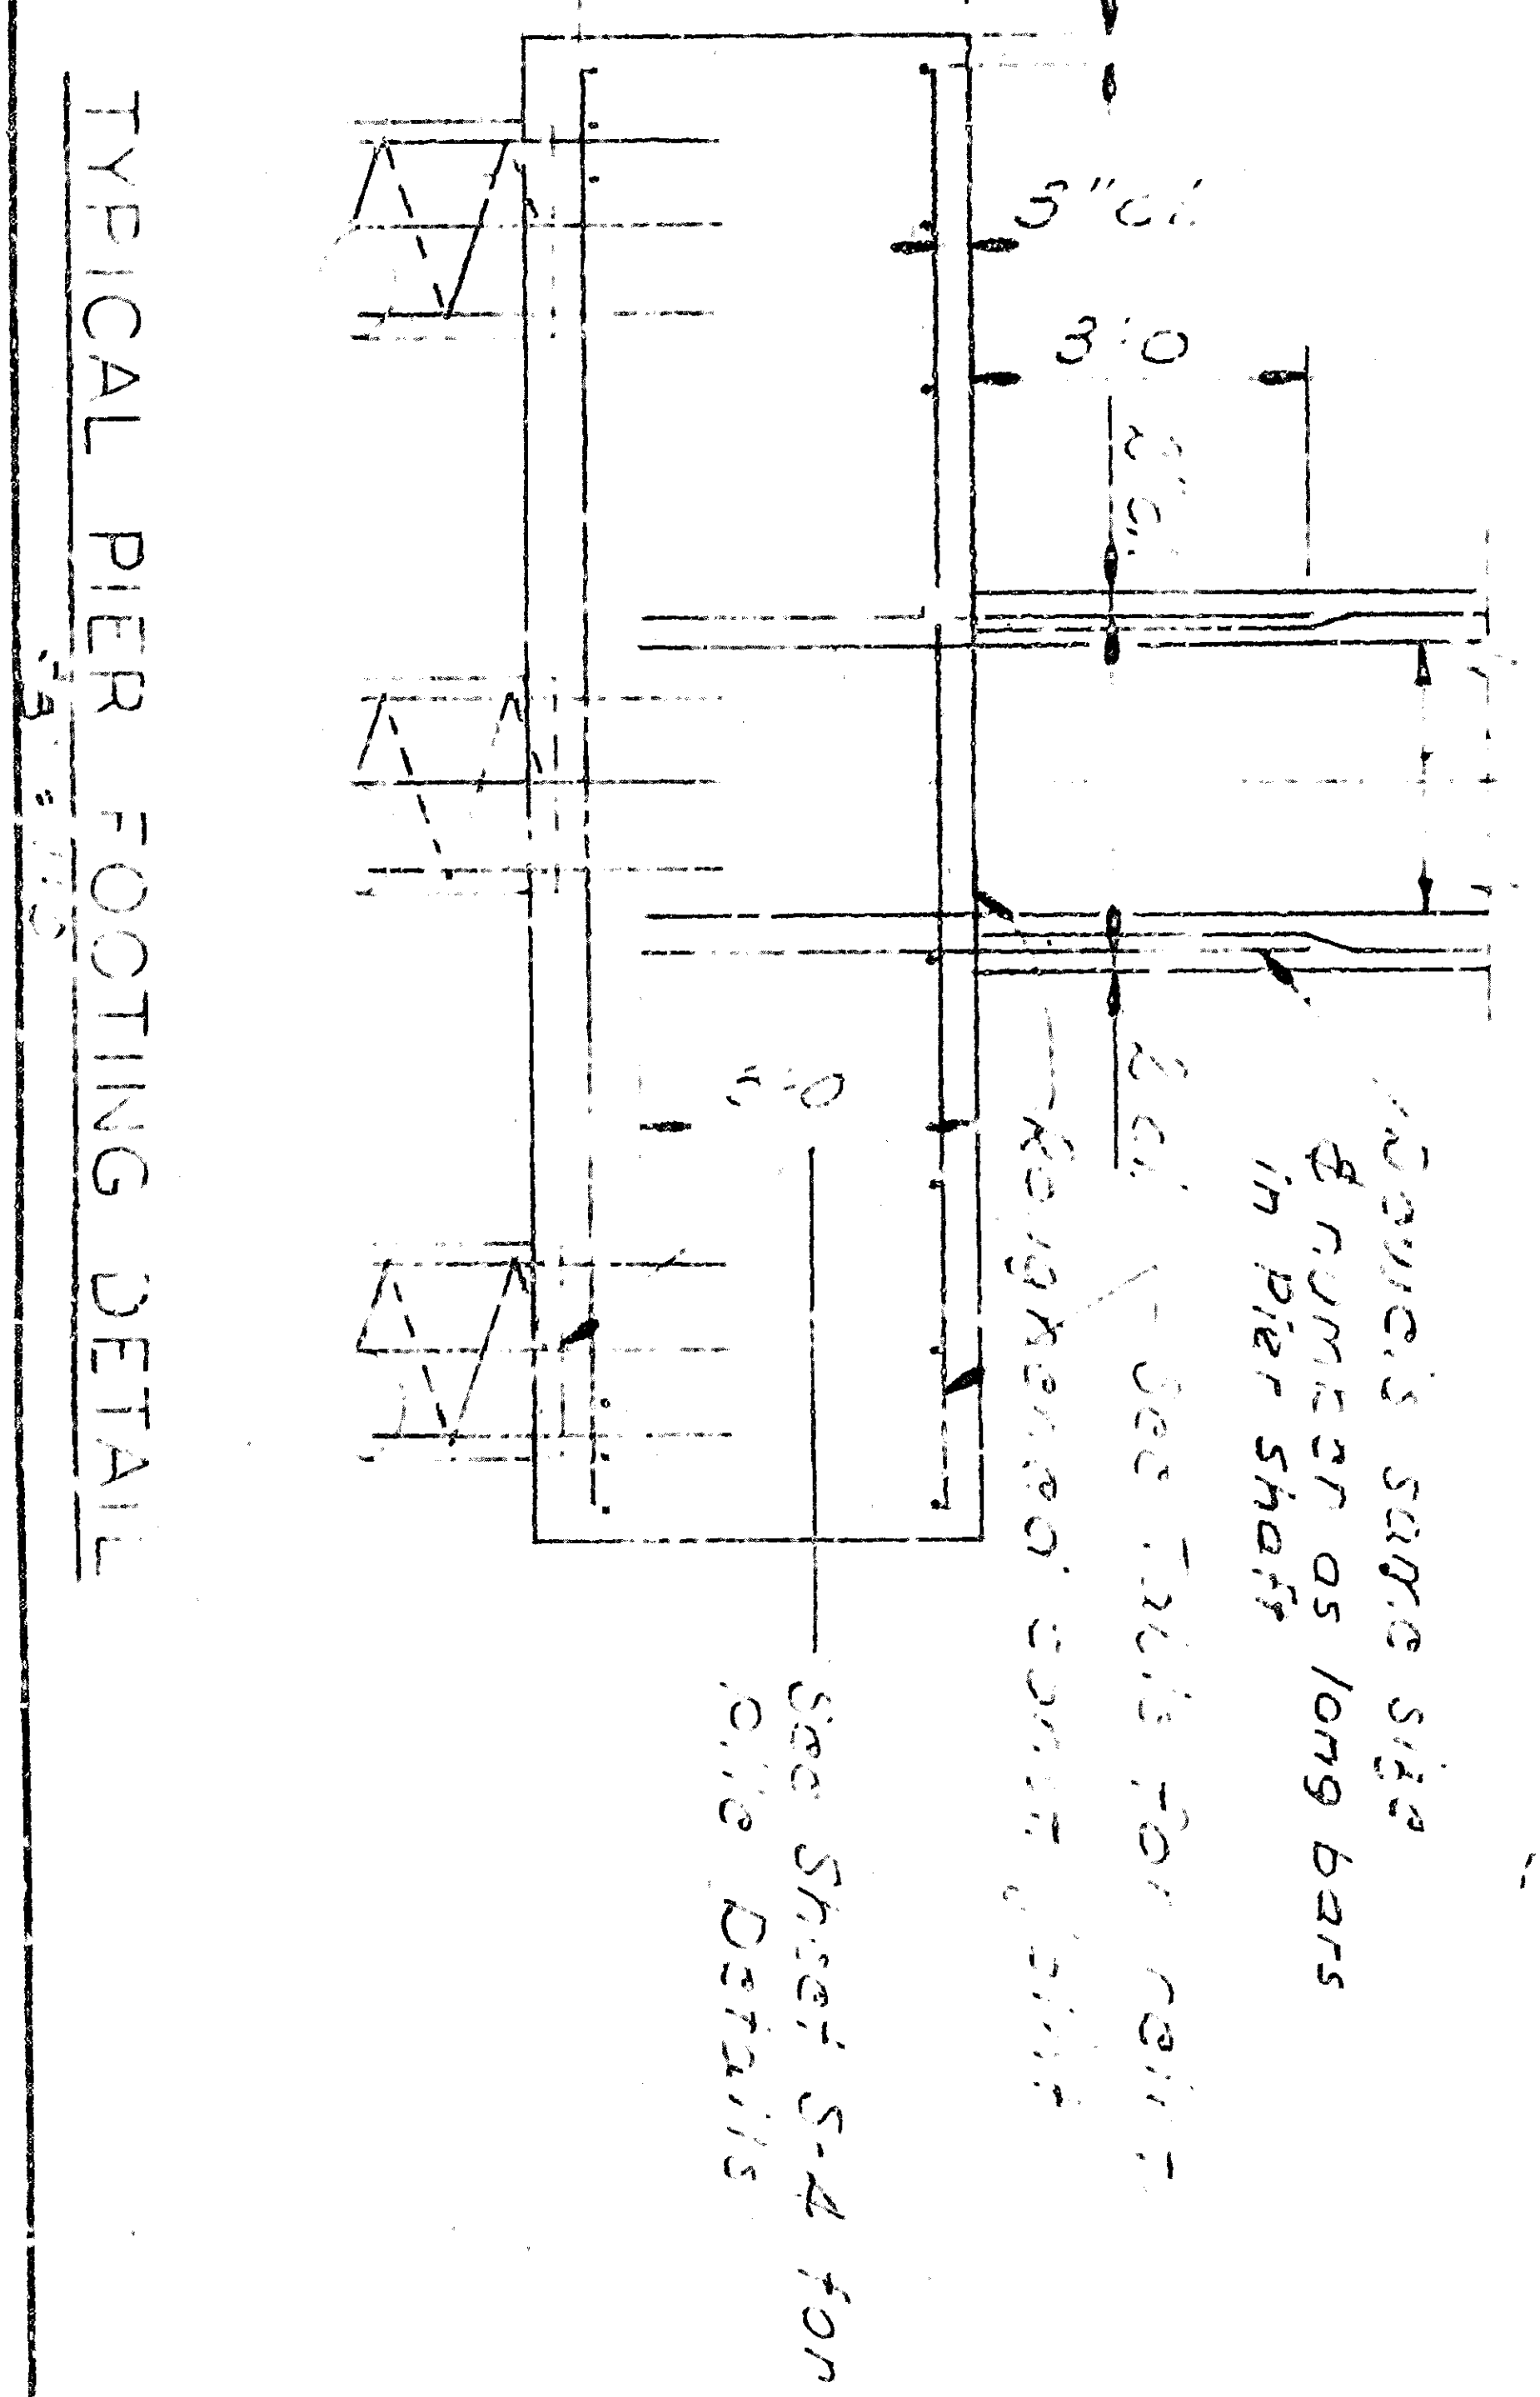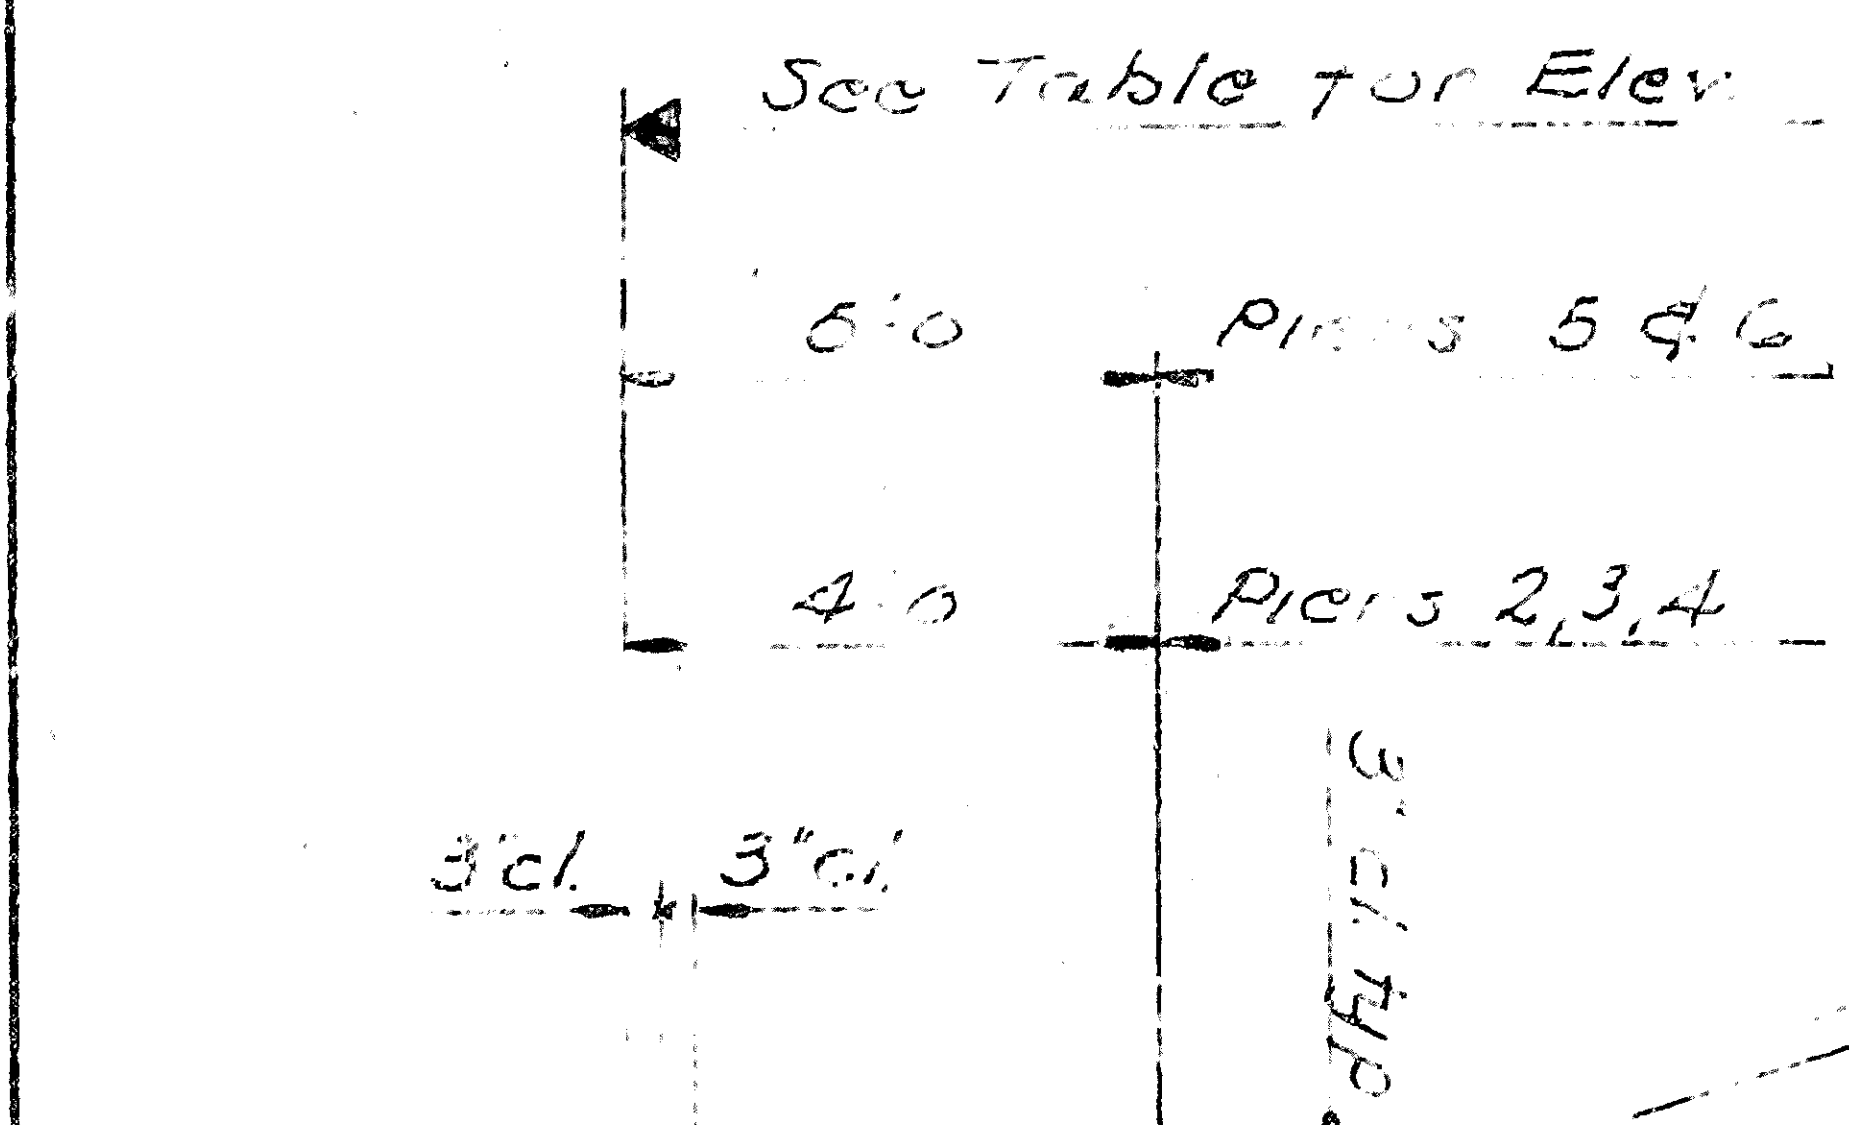

AS BUILT

COLTON CUT-OFF


SOUTHERN PACIFIC COMPANY

CITY OF SAN BERNARDINO
ARROW ROUTE-RIA TO AVE/JUNDERPAS
BRIDGE MP 49.00

FOUNDATION PLAN

| | |
|-------|---------------------------|
| DATE | 3/1/64 |
| BY | SAI FRANCISCO, CALIFORNIA |
| SCALE | AS SHOWN |
| DATE | 3/1/64 |
| BY | SAI FRANCISCO, CALIFORNIA |

← Pacific Elect. Co. Track ← S.P. Co. Track

 

Note: Position of Pier 1 and dimensions of bearing abutment in Plan 5 are to be confirmed with the Engineer after verification of dimension "B".

PIER FOOTING TABLE



NOTE: FOR ABUTMENT & ABOUT 7 DIMENSIONS SEE SH. A-2-4

| Pier No. | Plan 1 | Plan 2 | Plan 3 | Plan 4 | Plan 5 | Plan 6 |
|--------------------------|--------|--------|--------|--------|--------|--------|

NOTE: ALL DIMENSIONS ARE TO CENTER UNLESS OTHERWISE NOTED


SEE TABLE FOR ELEV. OF PIER TOPS

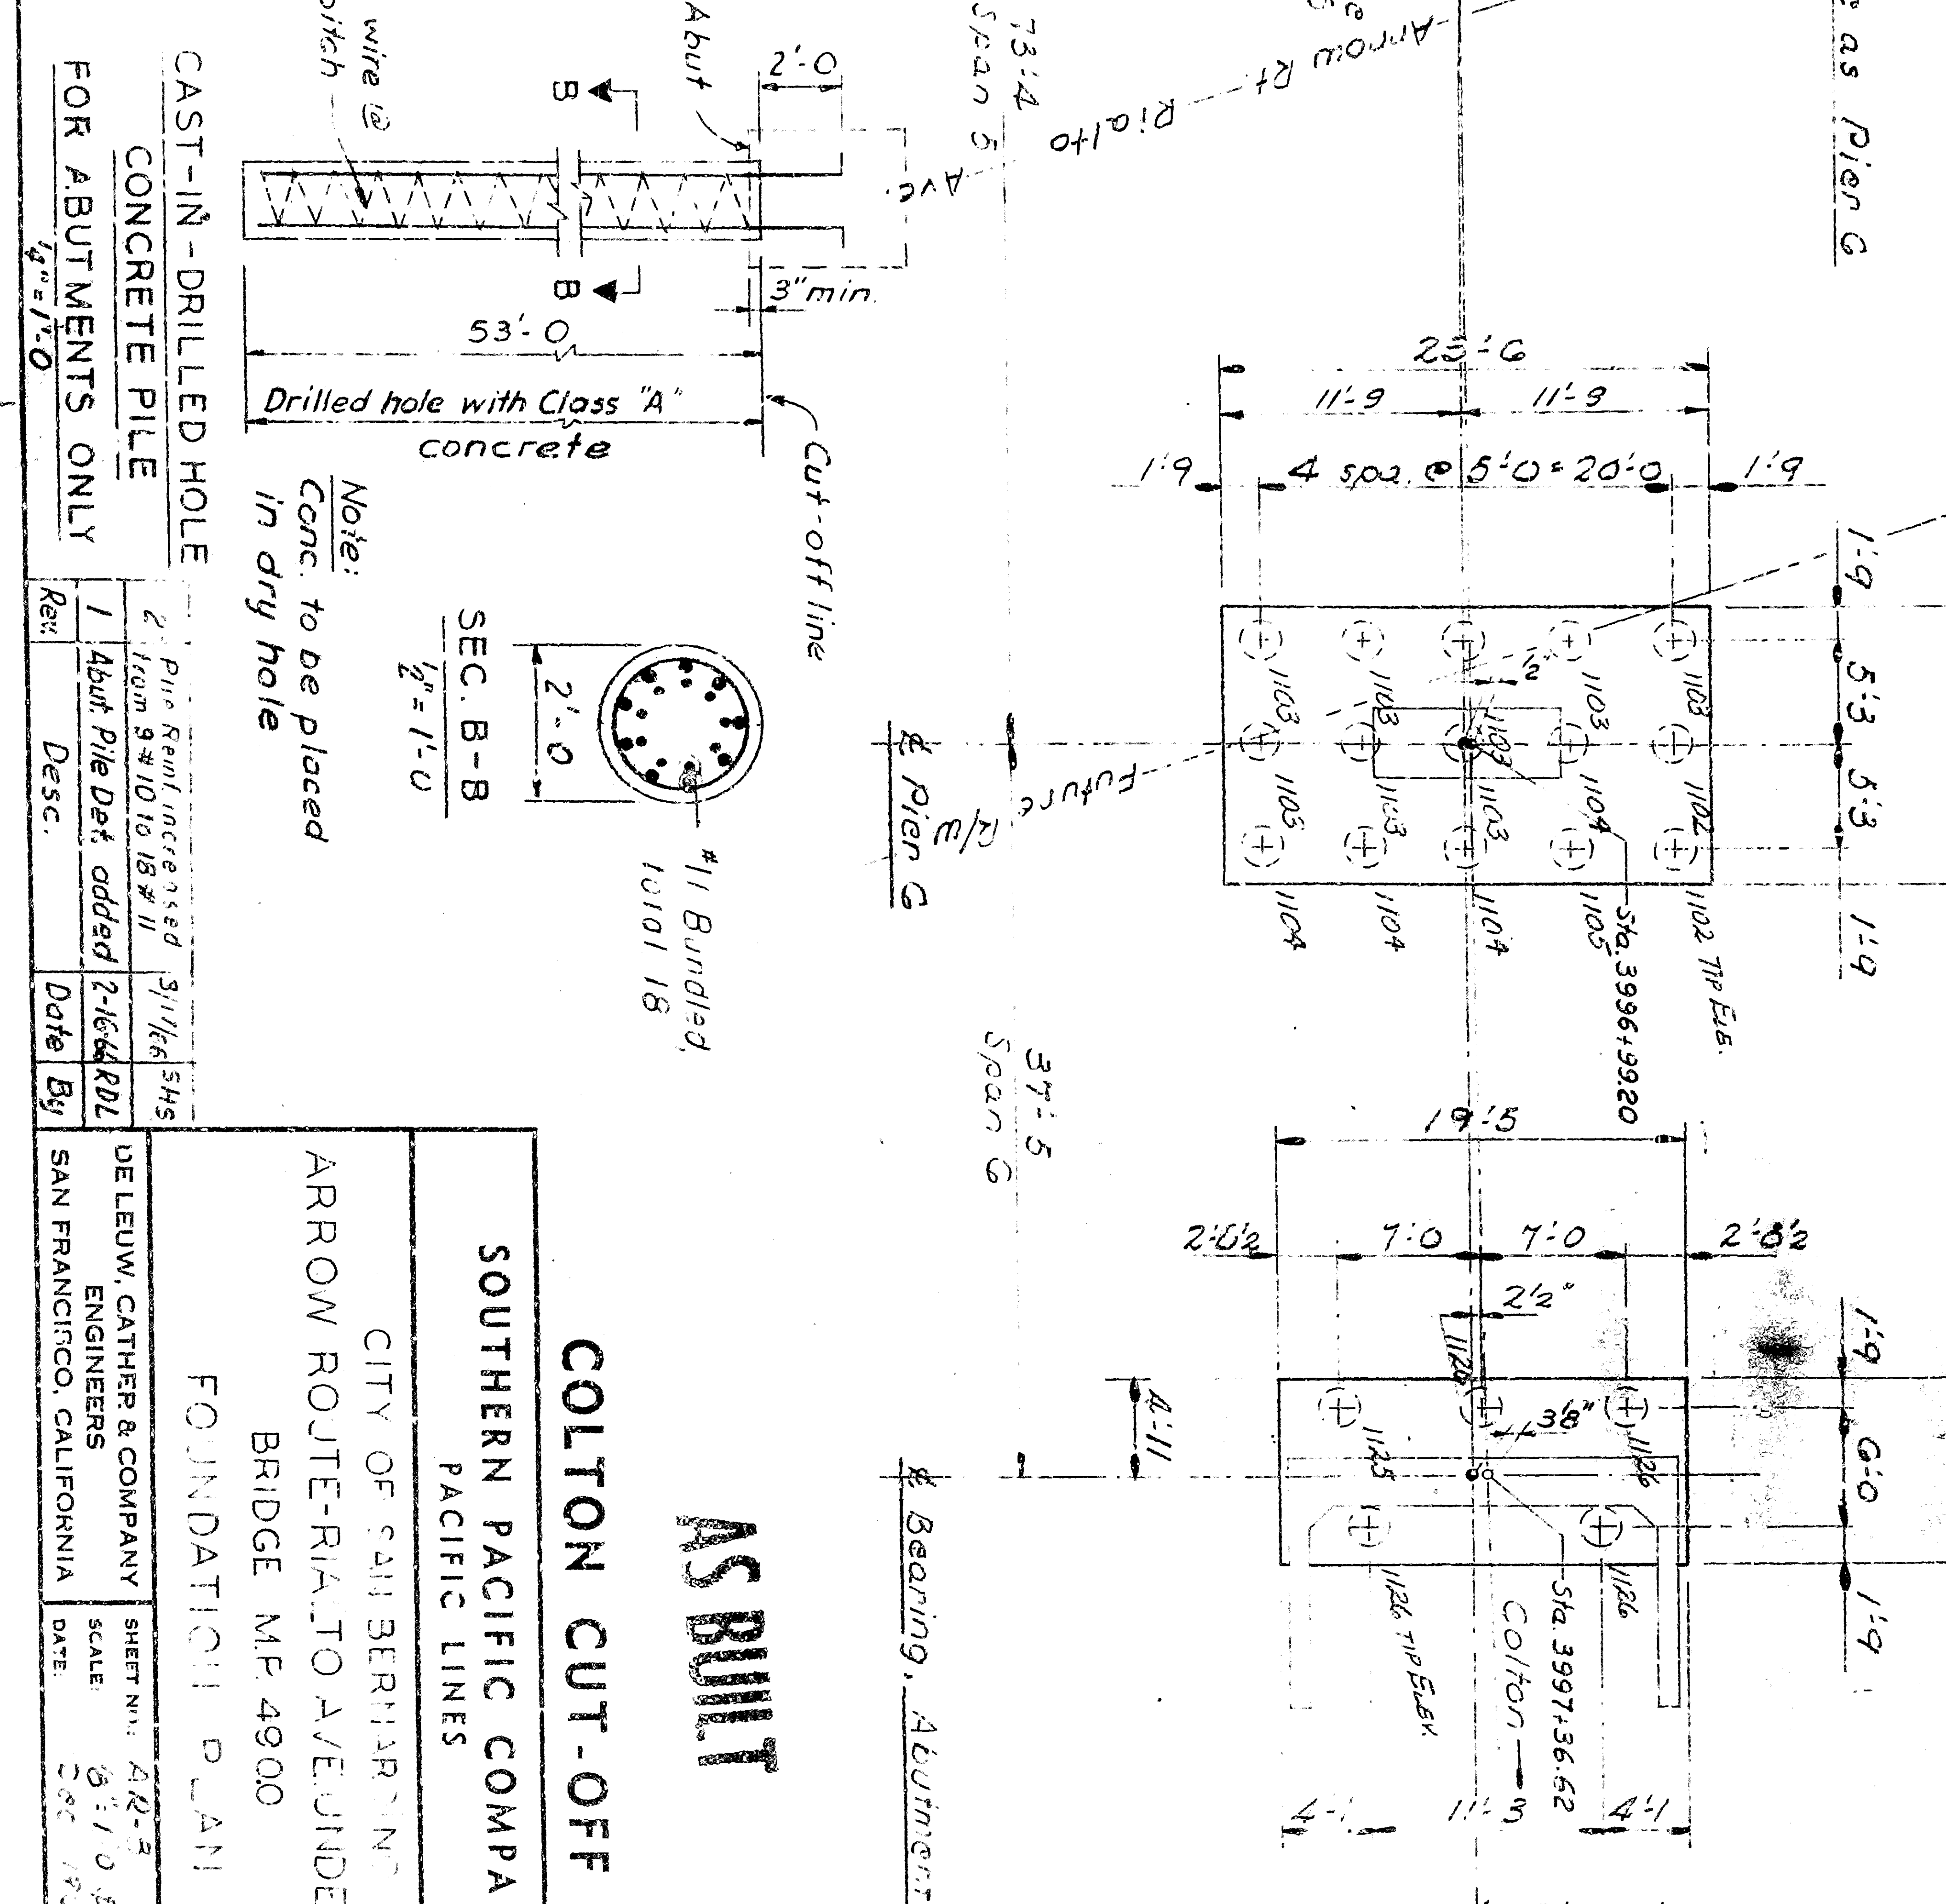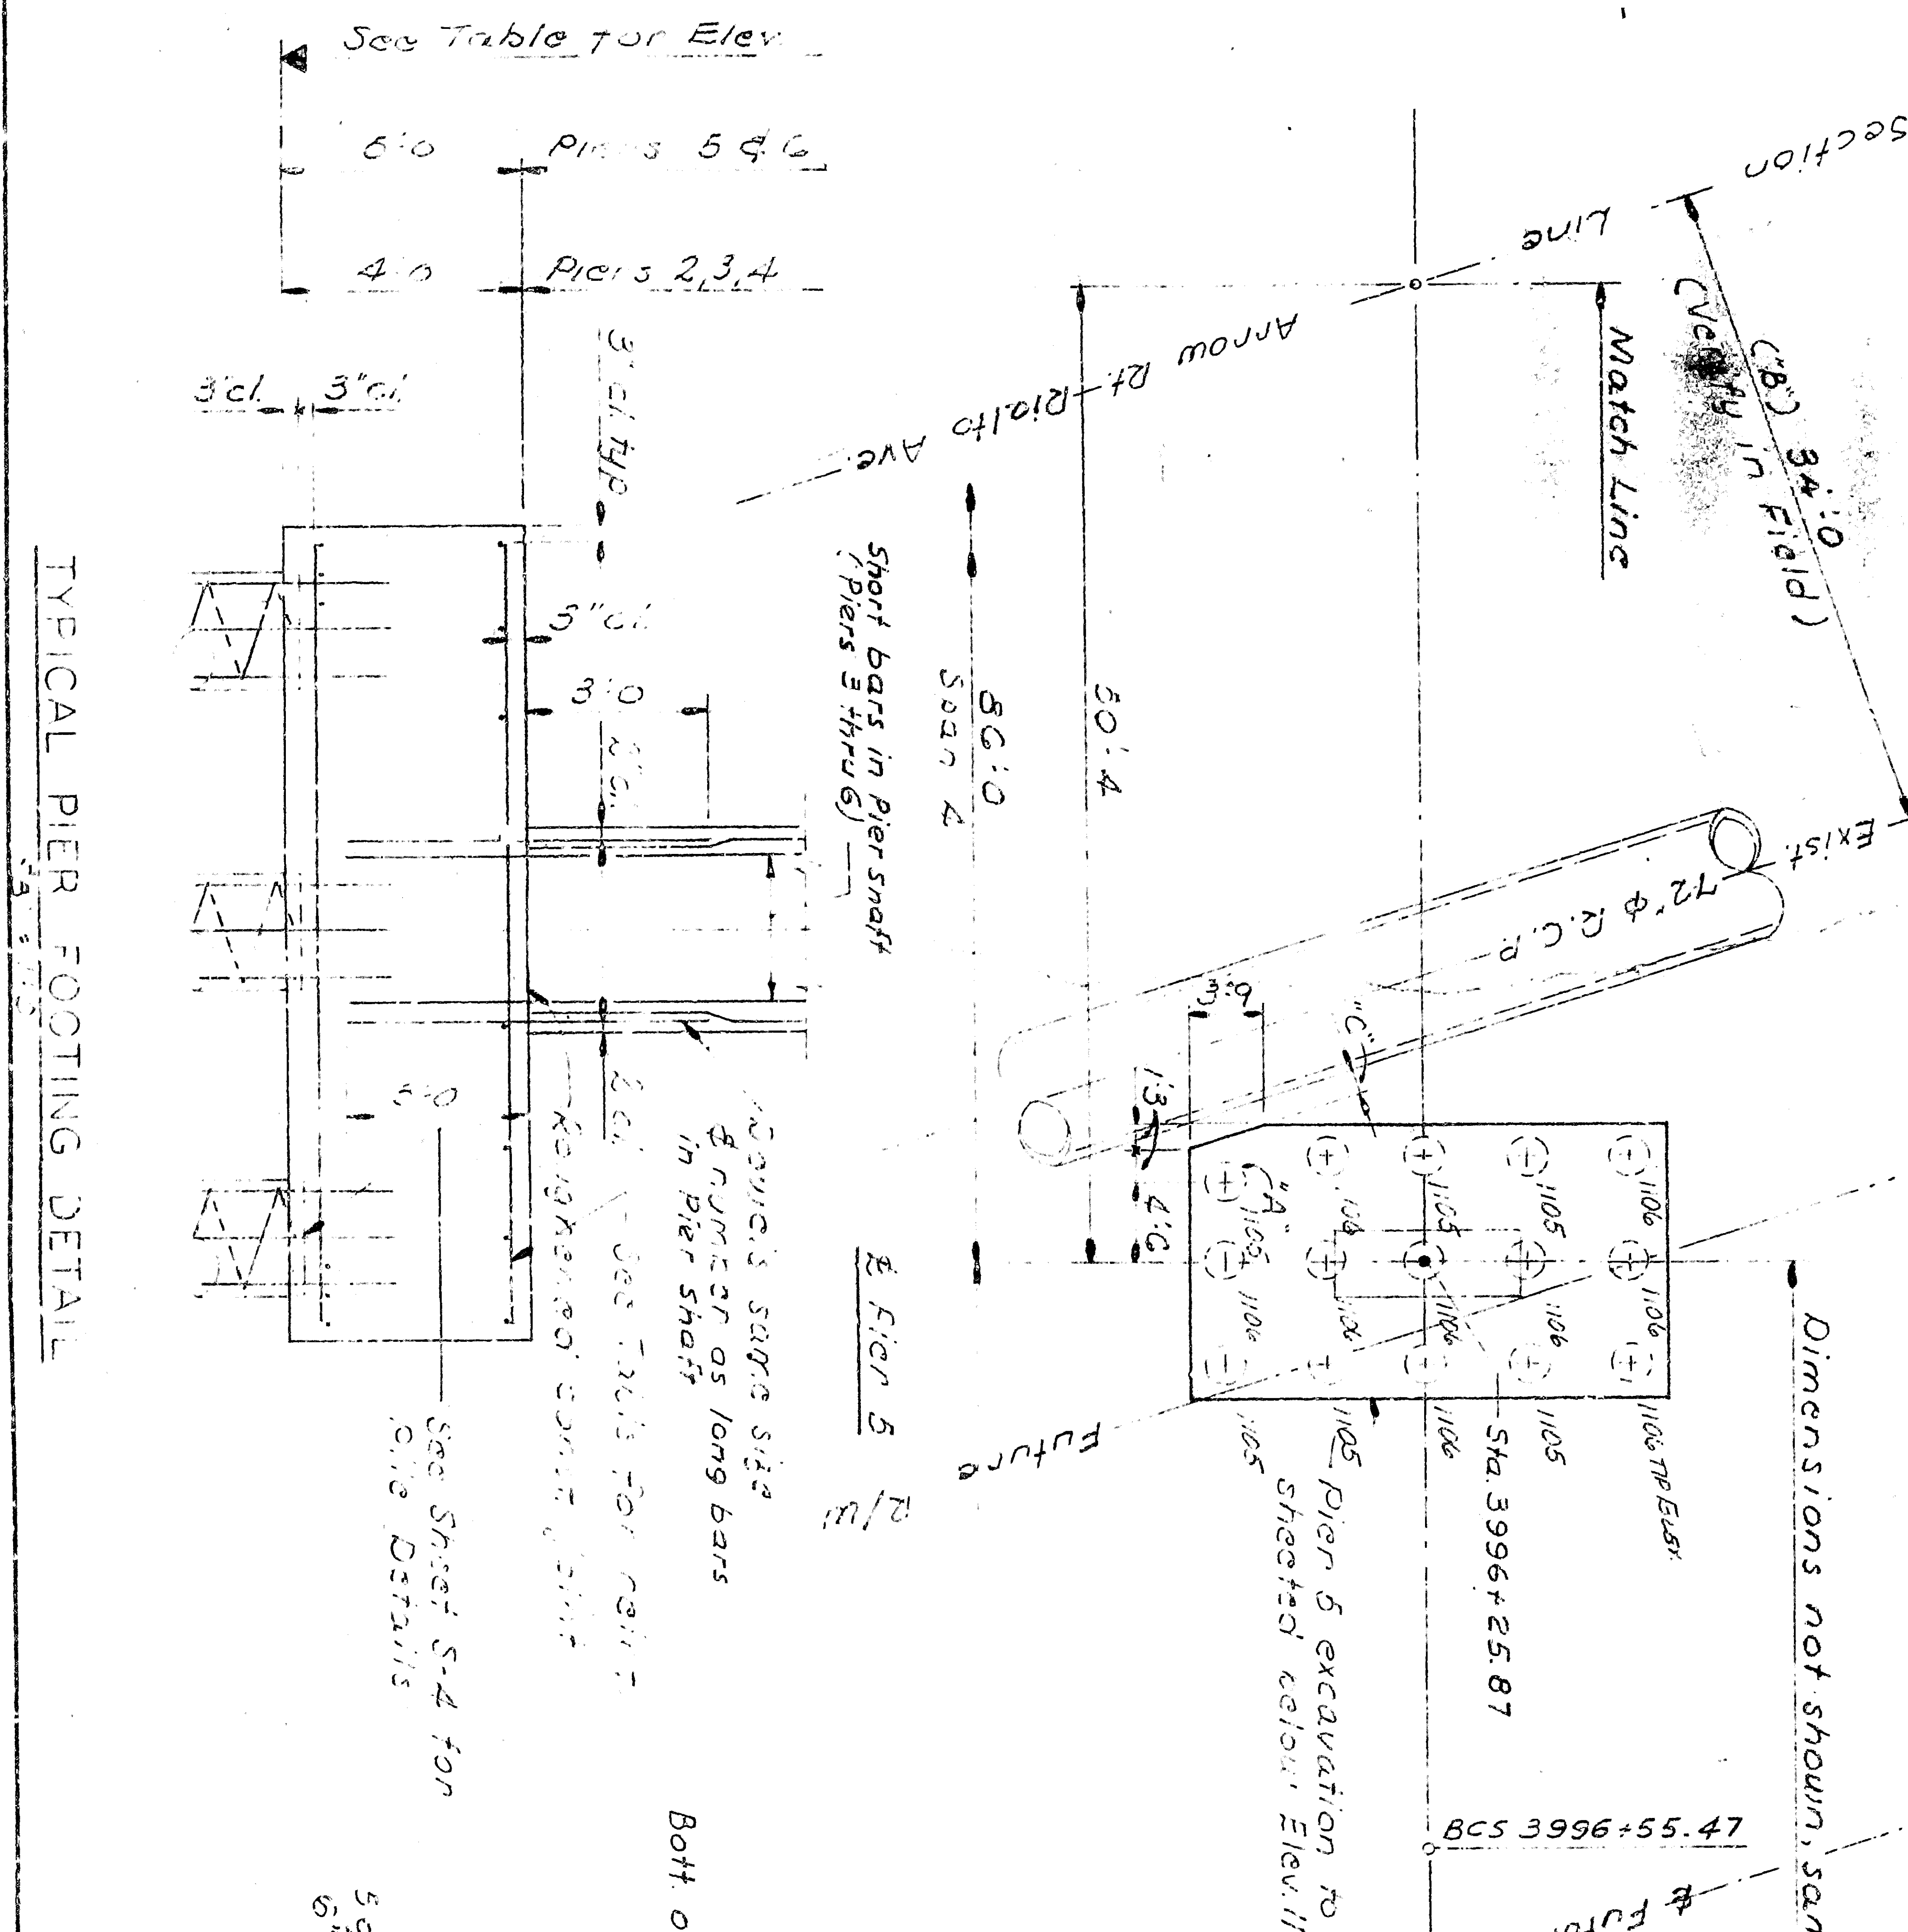


AS BUILT

COLTON CUT-OFF

SOUTHERN PACIFIC COMPANY
CITY OF SAN BERNARDINO
ARROW ROUTE-RIA TO AVE. UNDERPASS
FOUNDATION PLAN


 









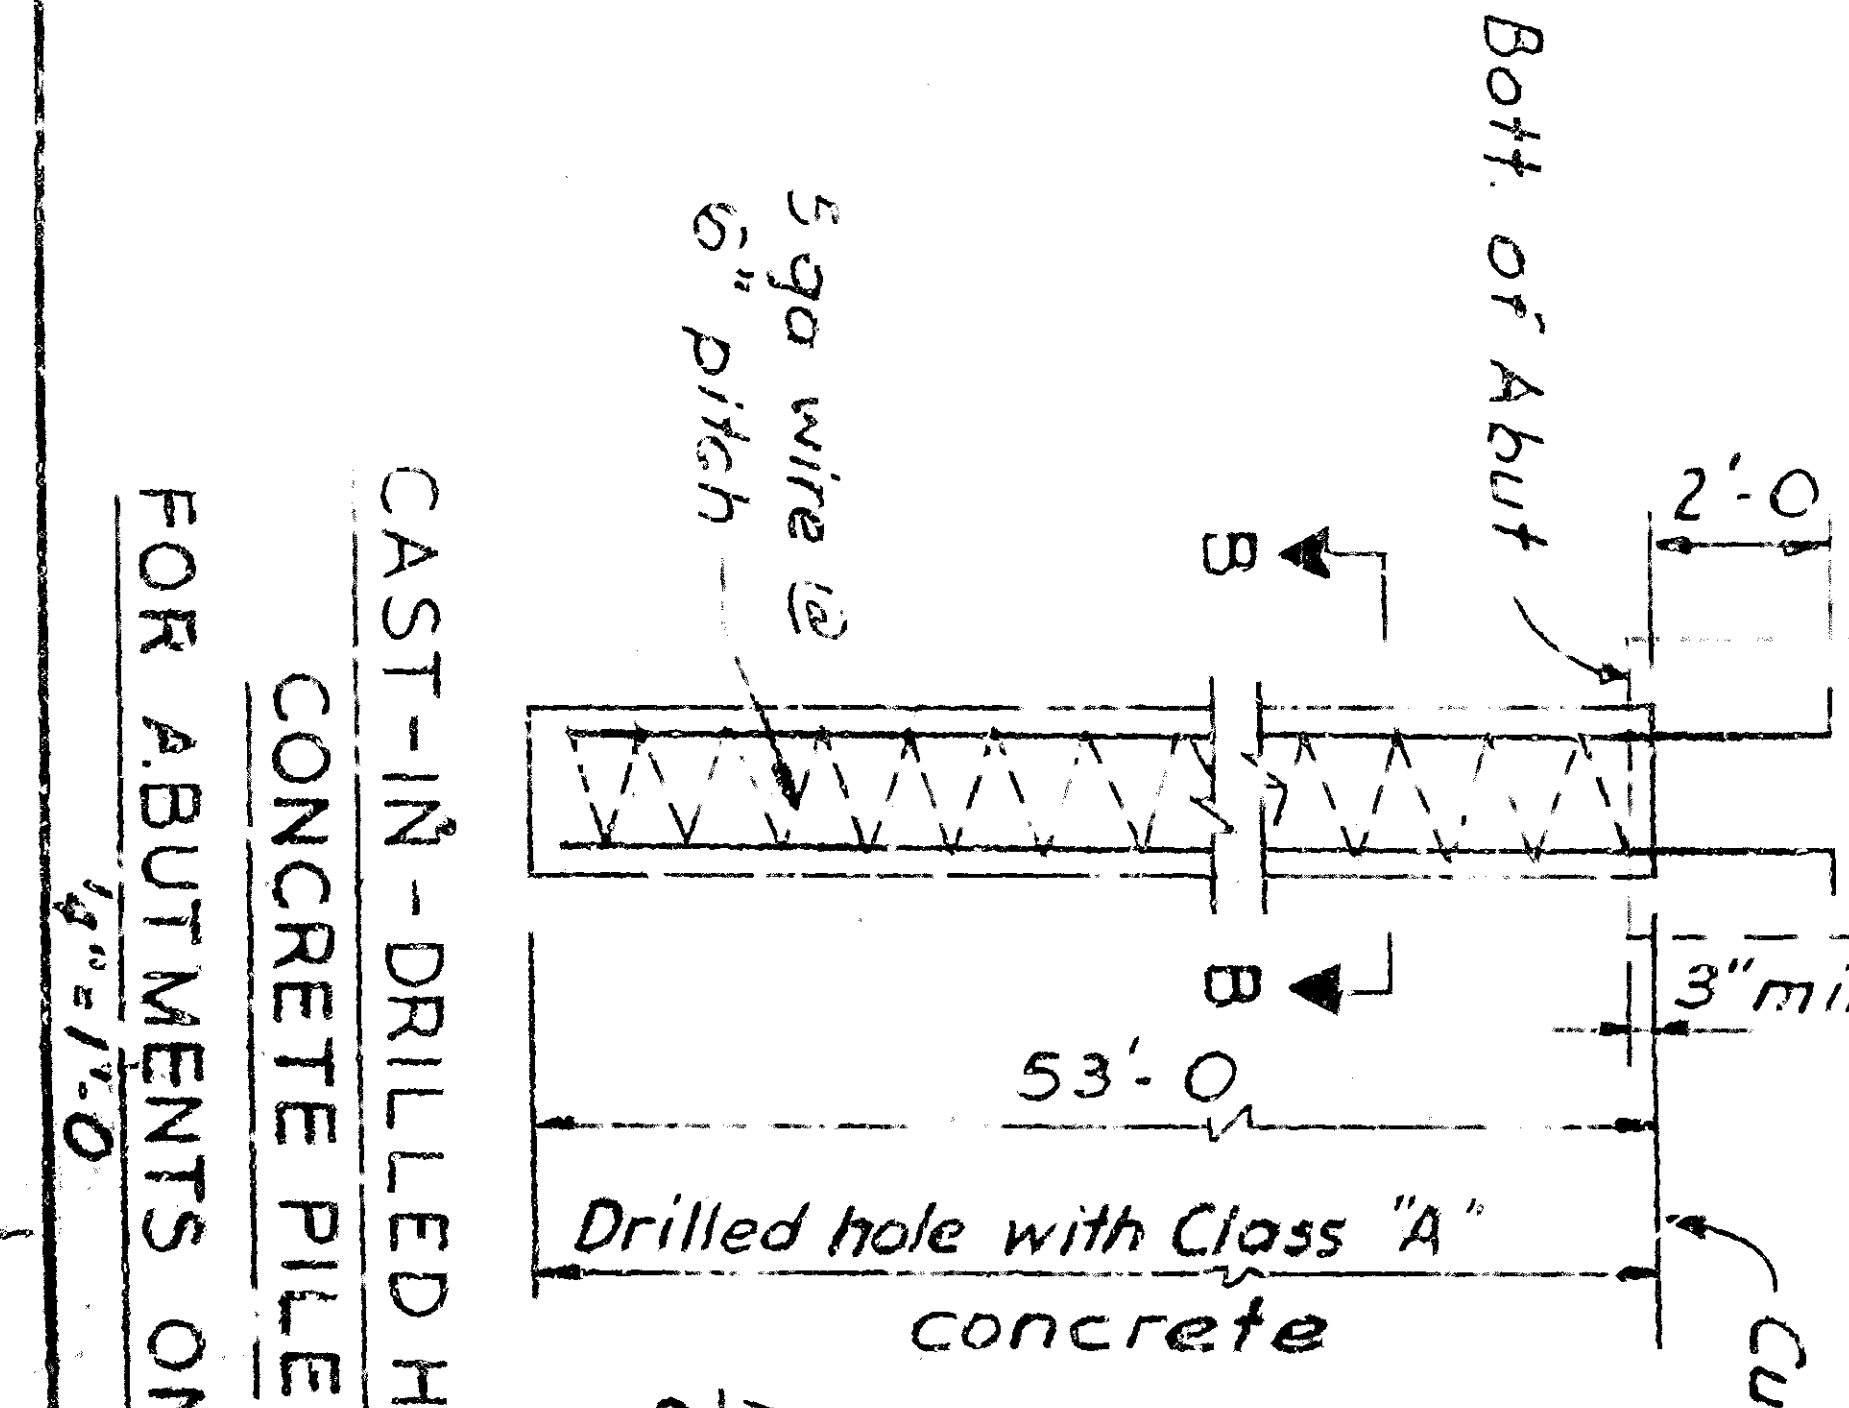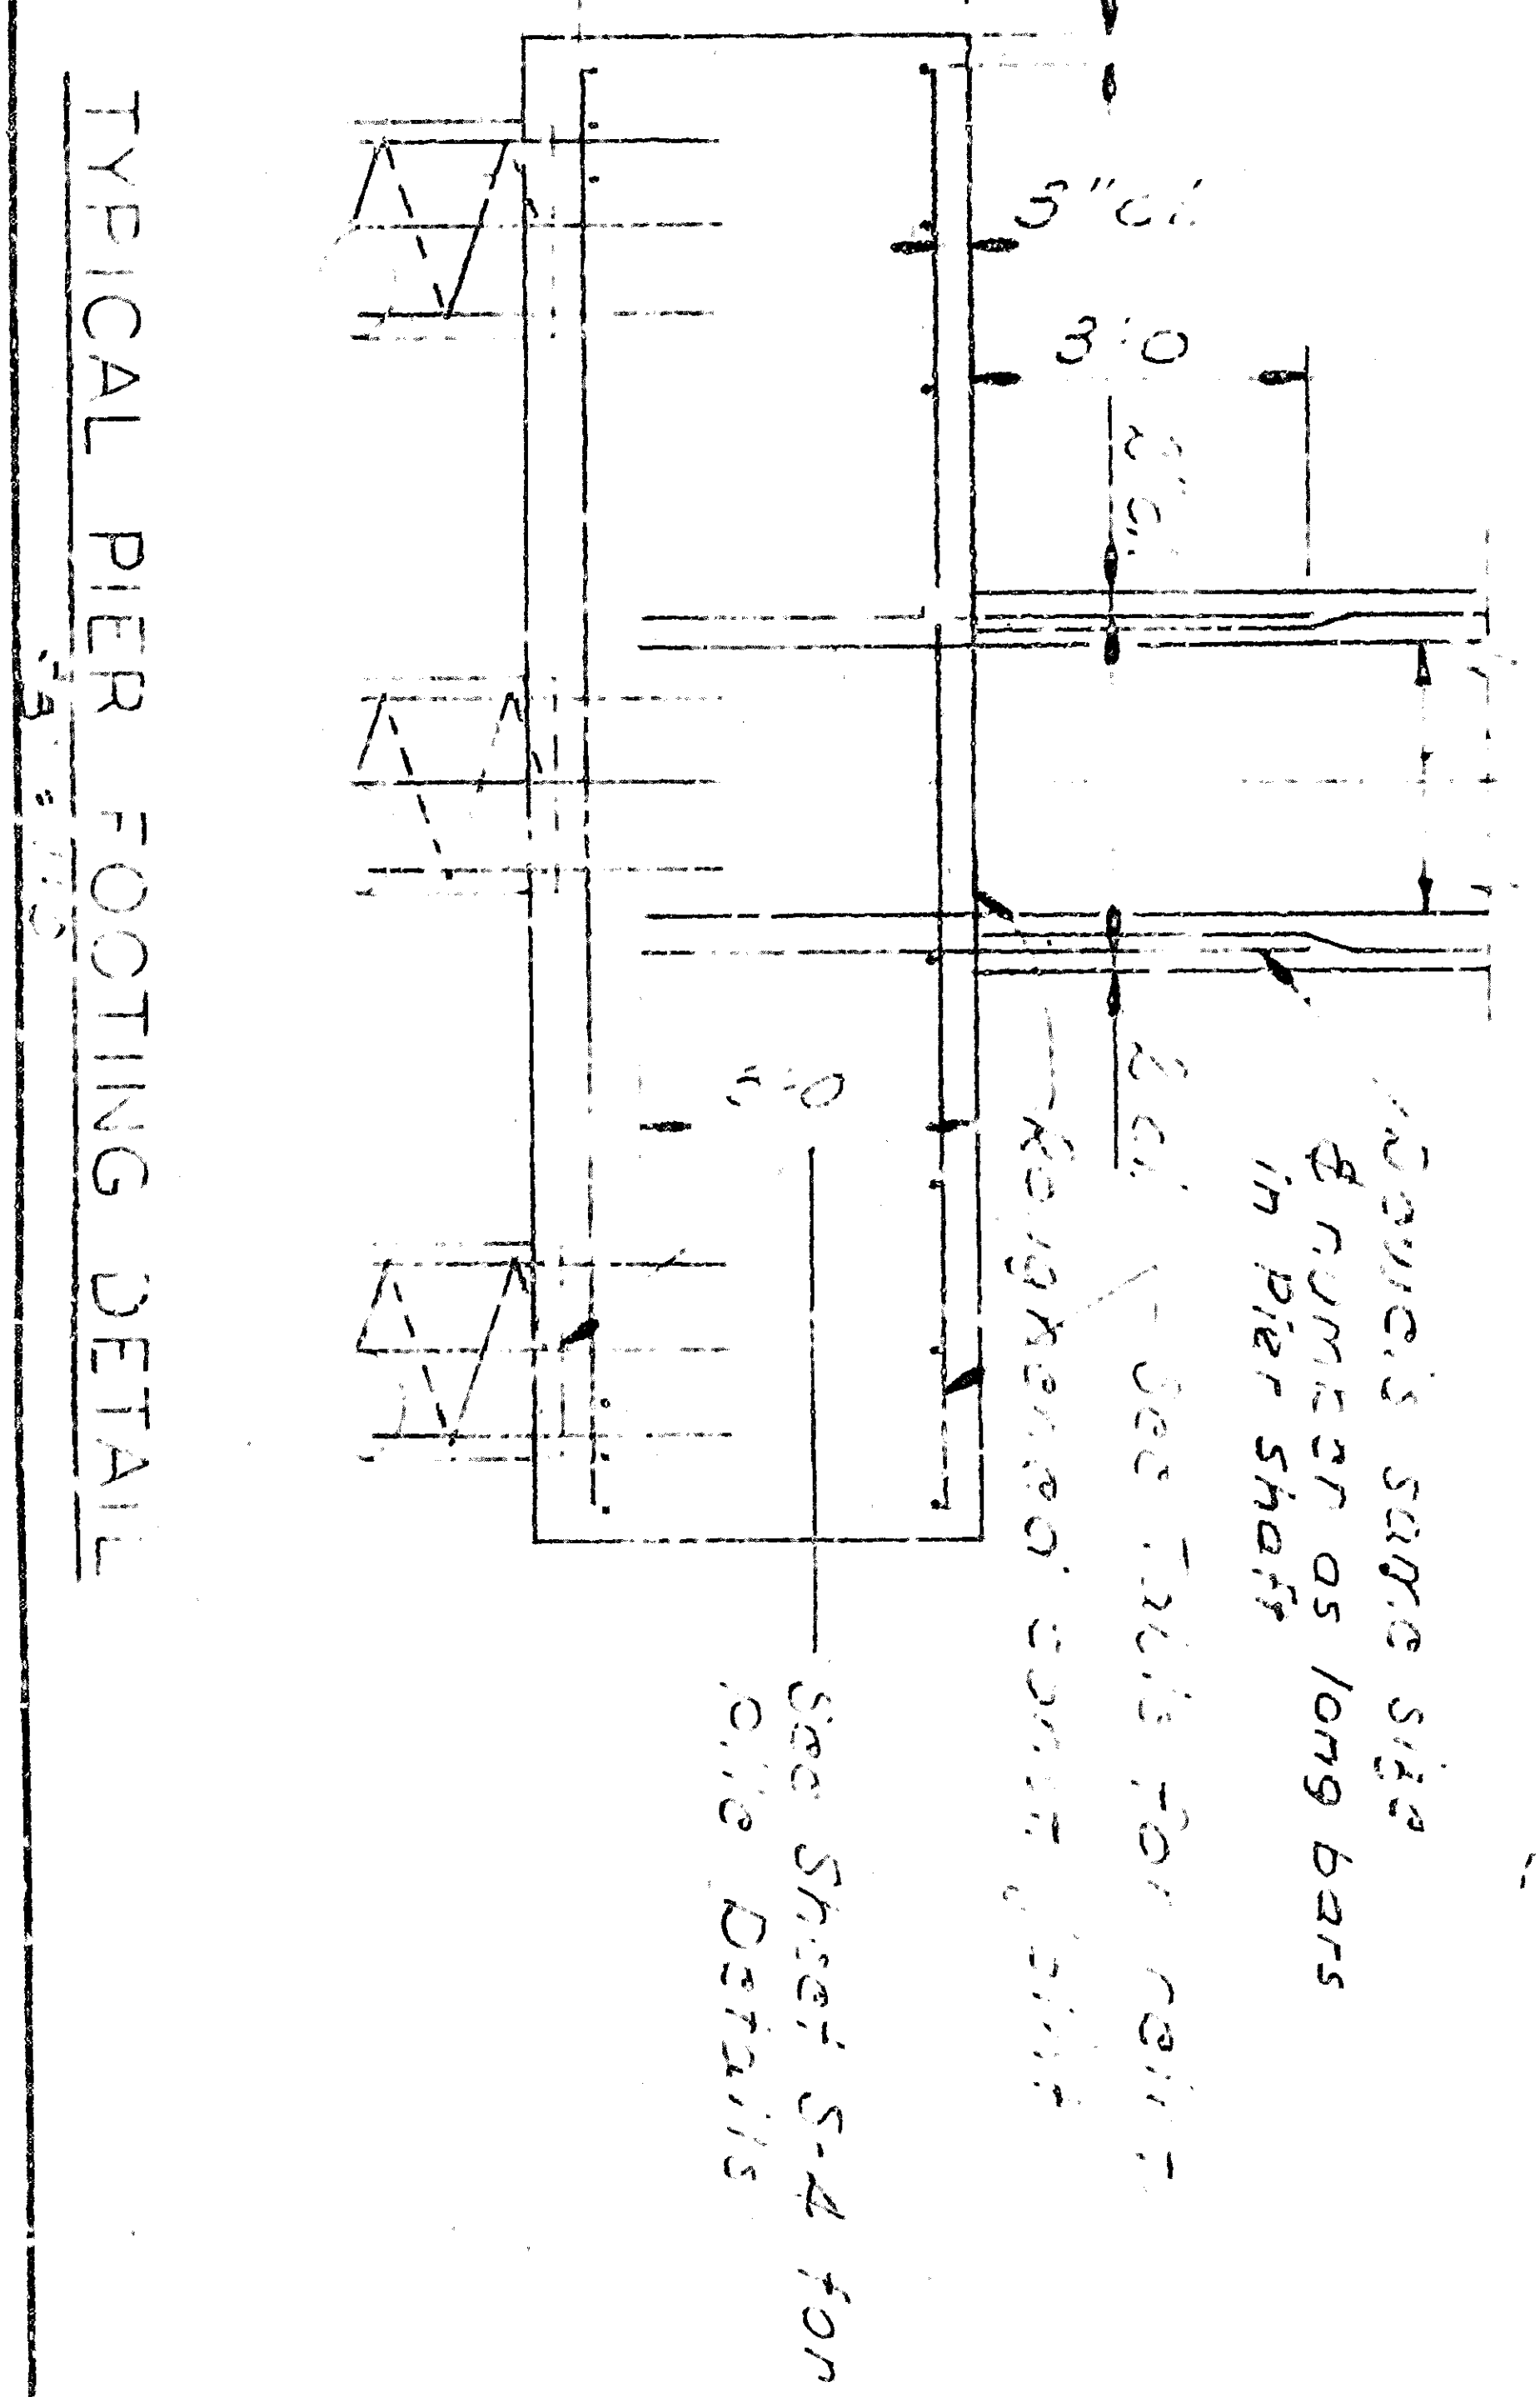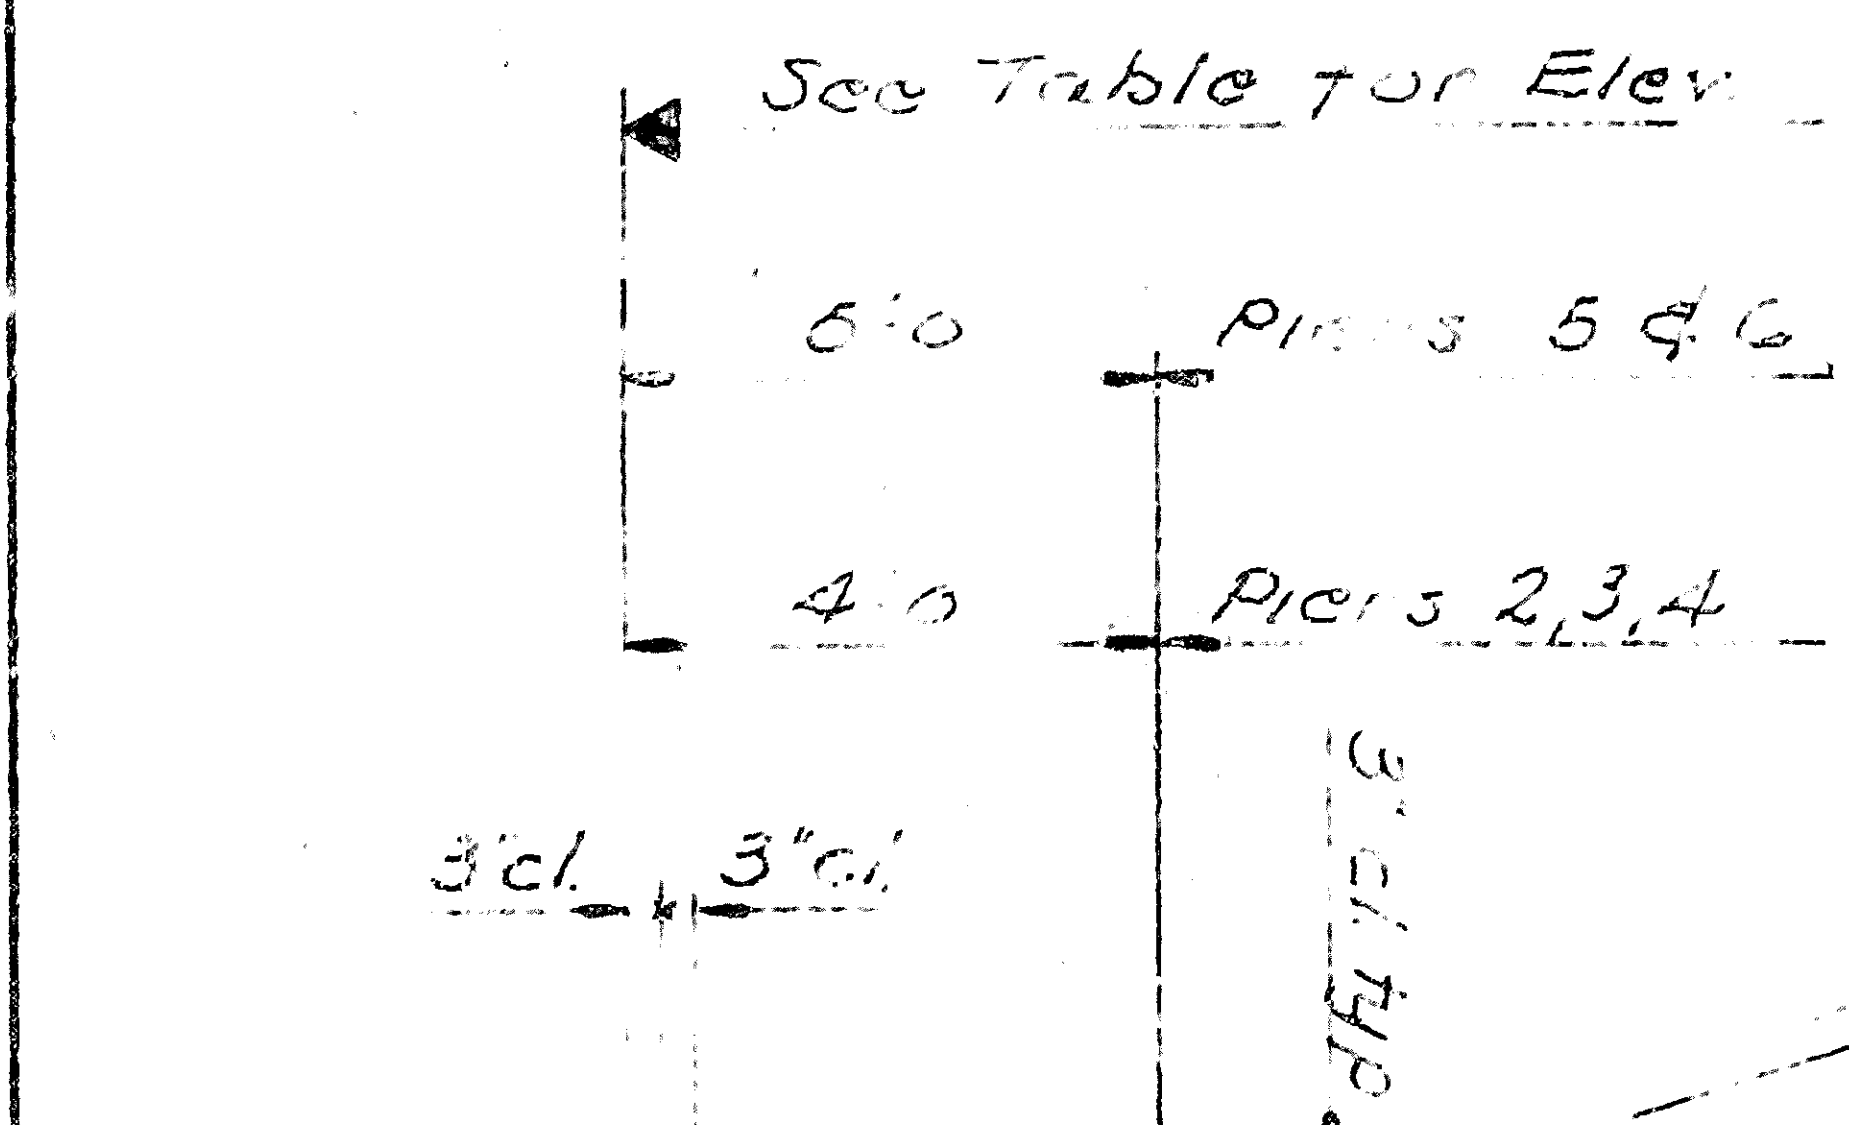

AS BUILT

COLTON CUT-OFF

SOUTHERN PACIFIC COMPANY
 CITY OF SAN BERNARDINO
 ARROW ROUTE-RIA TO AVE/JUNDERPAS
 BRIDGE MP 49.00
 FOUNDATION PLAN

| Rev. | Desc. | Date | By |
|------|----------|--------|-----|
| 1 | As Built | 3/1/64 | ... |

DE LEUW, CATHER & COMPANY
 ENGINEERS
 SAN FRANCISCO, CALIFORNIA