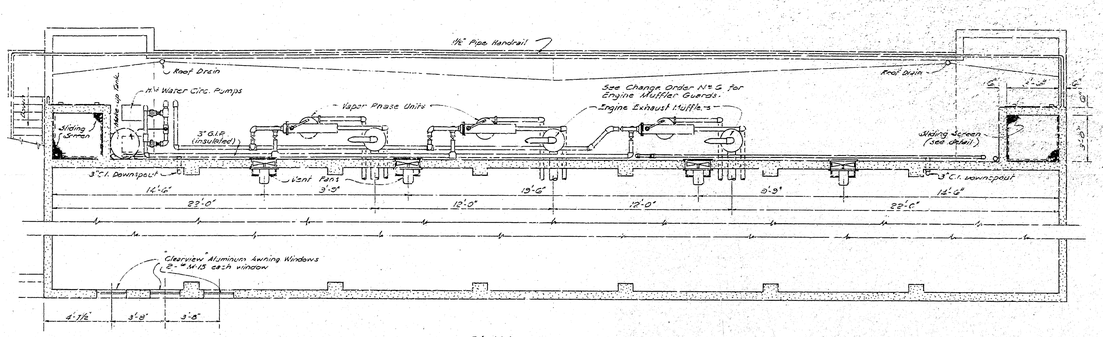

PLAN UPPER PART BLOWER ROOM
Scale: 1/4" = 1'-0"

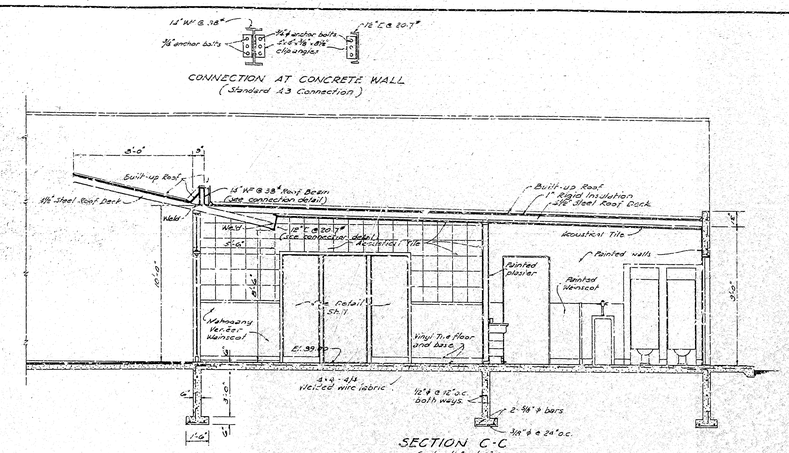

SECTION C-C
Scale: 1/4" = 1'-0"

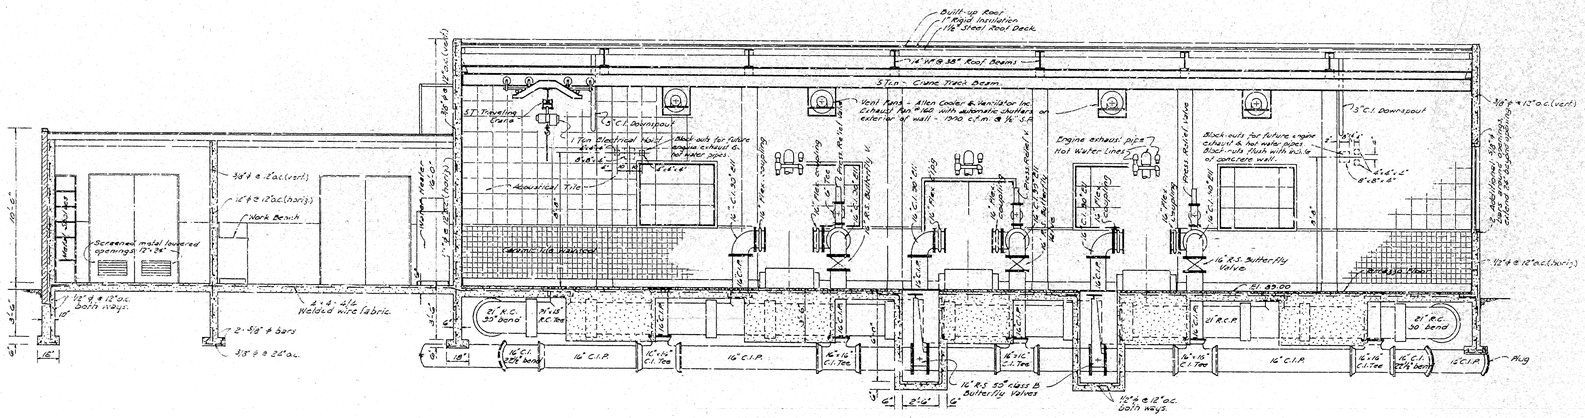

SECTION B-B
Scale: 1/4" = 1'-0"

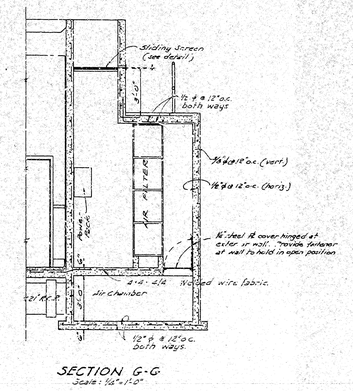

SECTION G-G
Scale: 1/4" = 1'-0"

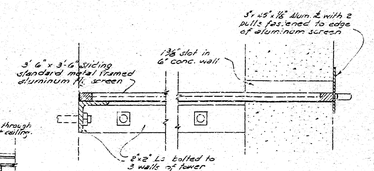

DETAIL - SLIDING SCREEN
IN AIR FILTER SUCTION TOWER

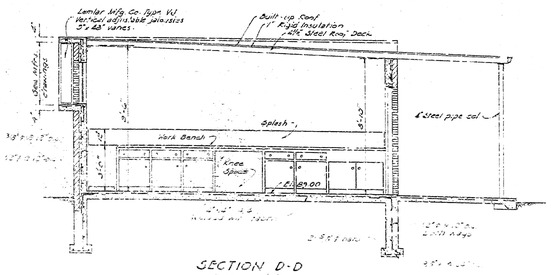

SECTION D-D

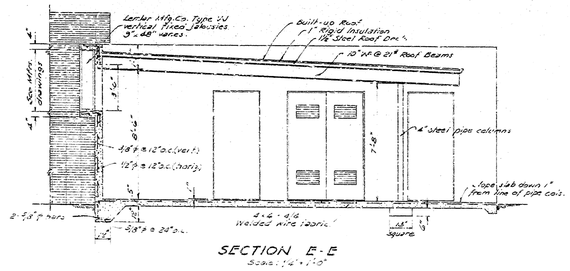

SECTION E-E
Scale: 1/4" = 1'-0"

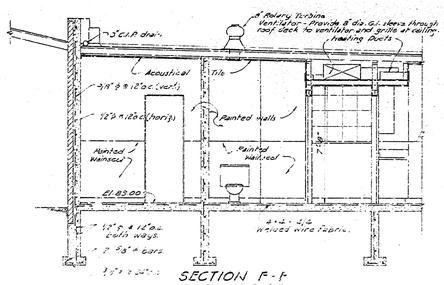

SECTION F-F
Scale: 1/4" = 1'-0"

REVISED "AS BUILT"

SEWAGE TREATMENT WORKS
SAN BERNARDINO
CALIFORNIA
1958
CURRIE ENGINEERING COMPANY
CONSULTING ENGINEERS

CONTROL BUILDING SECTIONS | 5

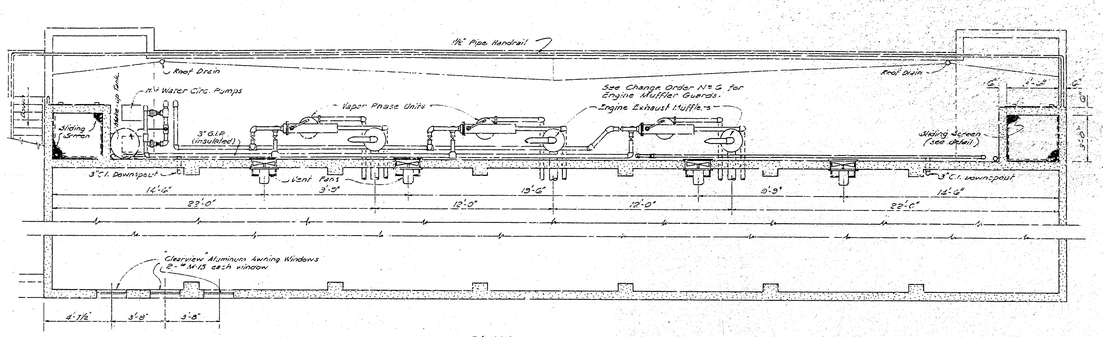

PLAN UPPER PART BLOWER ROOM
Scale: 1/4" = 1'-0"

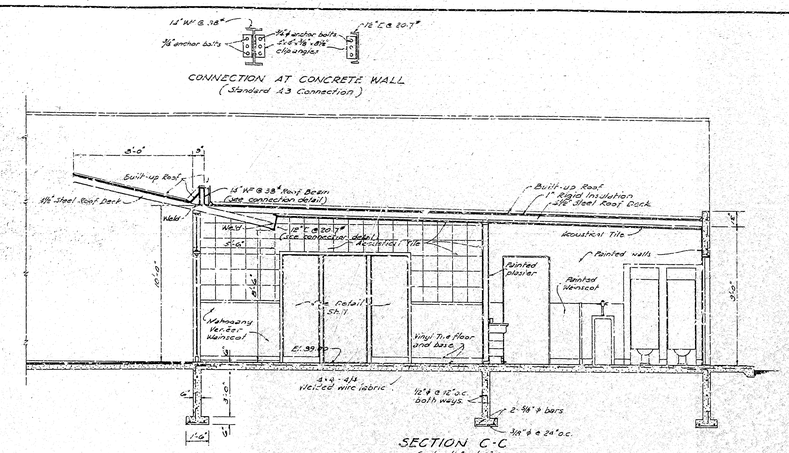

SECTION C-C
Scale: 1/4" = 1'-0"

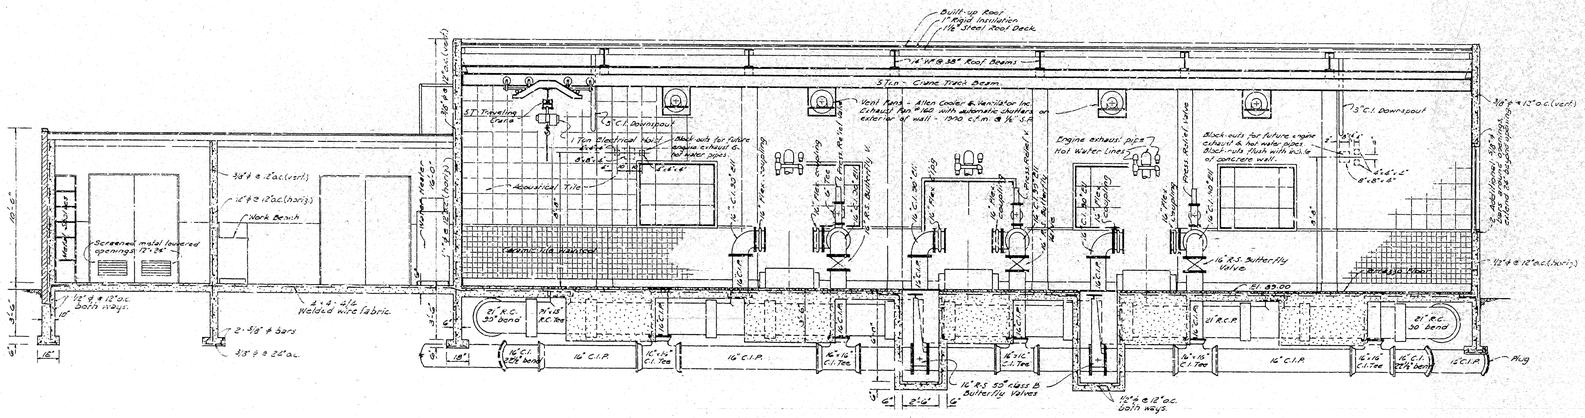

SECTION B-B
Scale: 1/4" = 1'-0"

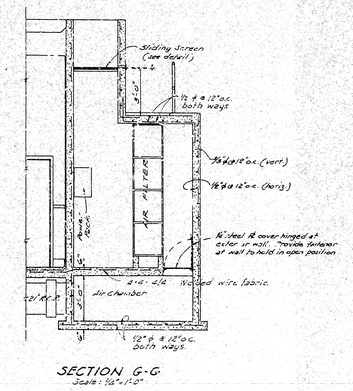

SECTION G-G
Scale: 1/4" = 1'-0"

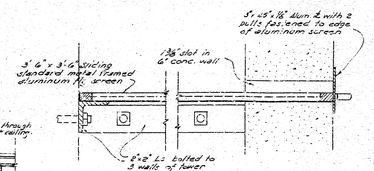

DETAIL - SLIDING SCREEN
IN AIR FILTER SUCTION TOWER

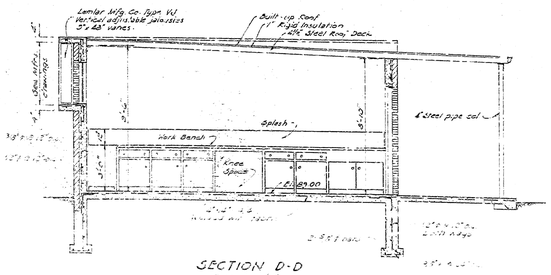

SECTION D-D

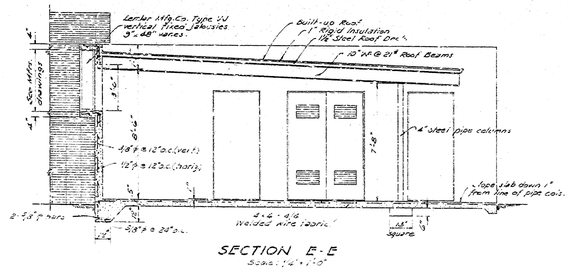

SECTION E-E
Scale: 1/4" = 1'-0"

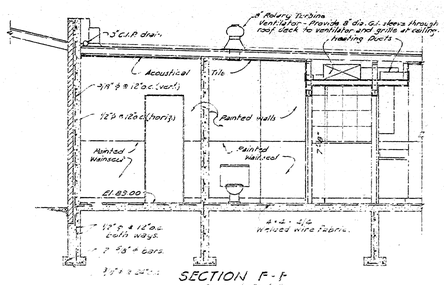

SECTION F-F
Scale: 1/4" = 1'-0"

REVISED "AS BUILT"

SEWAGE TREATMENT WORKS
SAN BERNARDINO
CALIFORNIA
1958
CURRIE ENGINEERING COMPANY
CONSULTING ENGINEERS

CONTROL BUILDING SECTIONS | 5