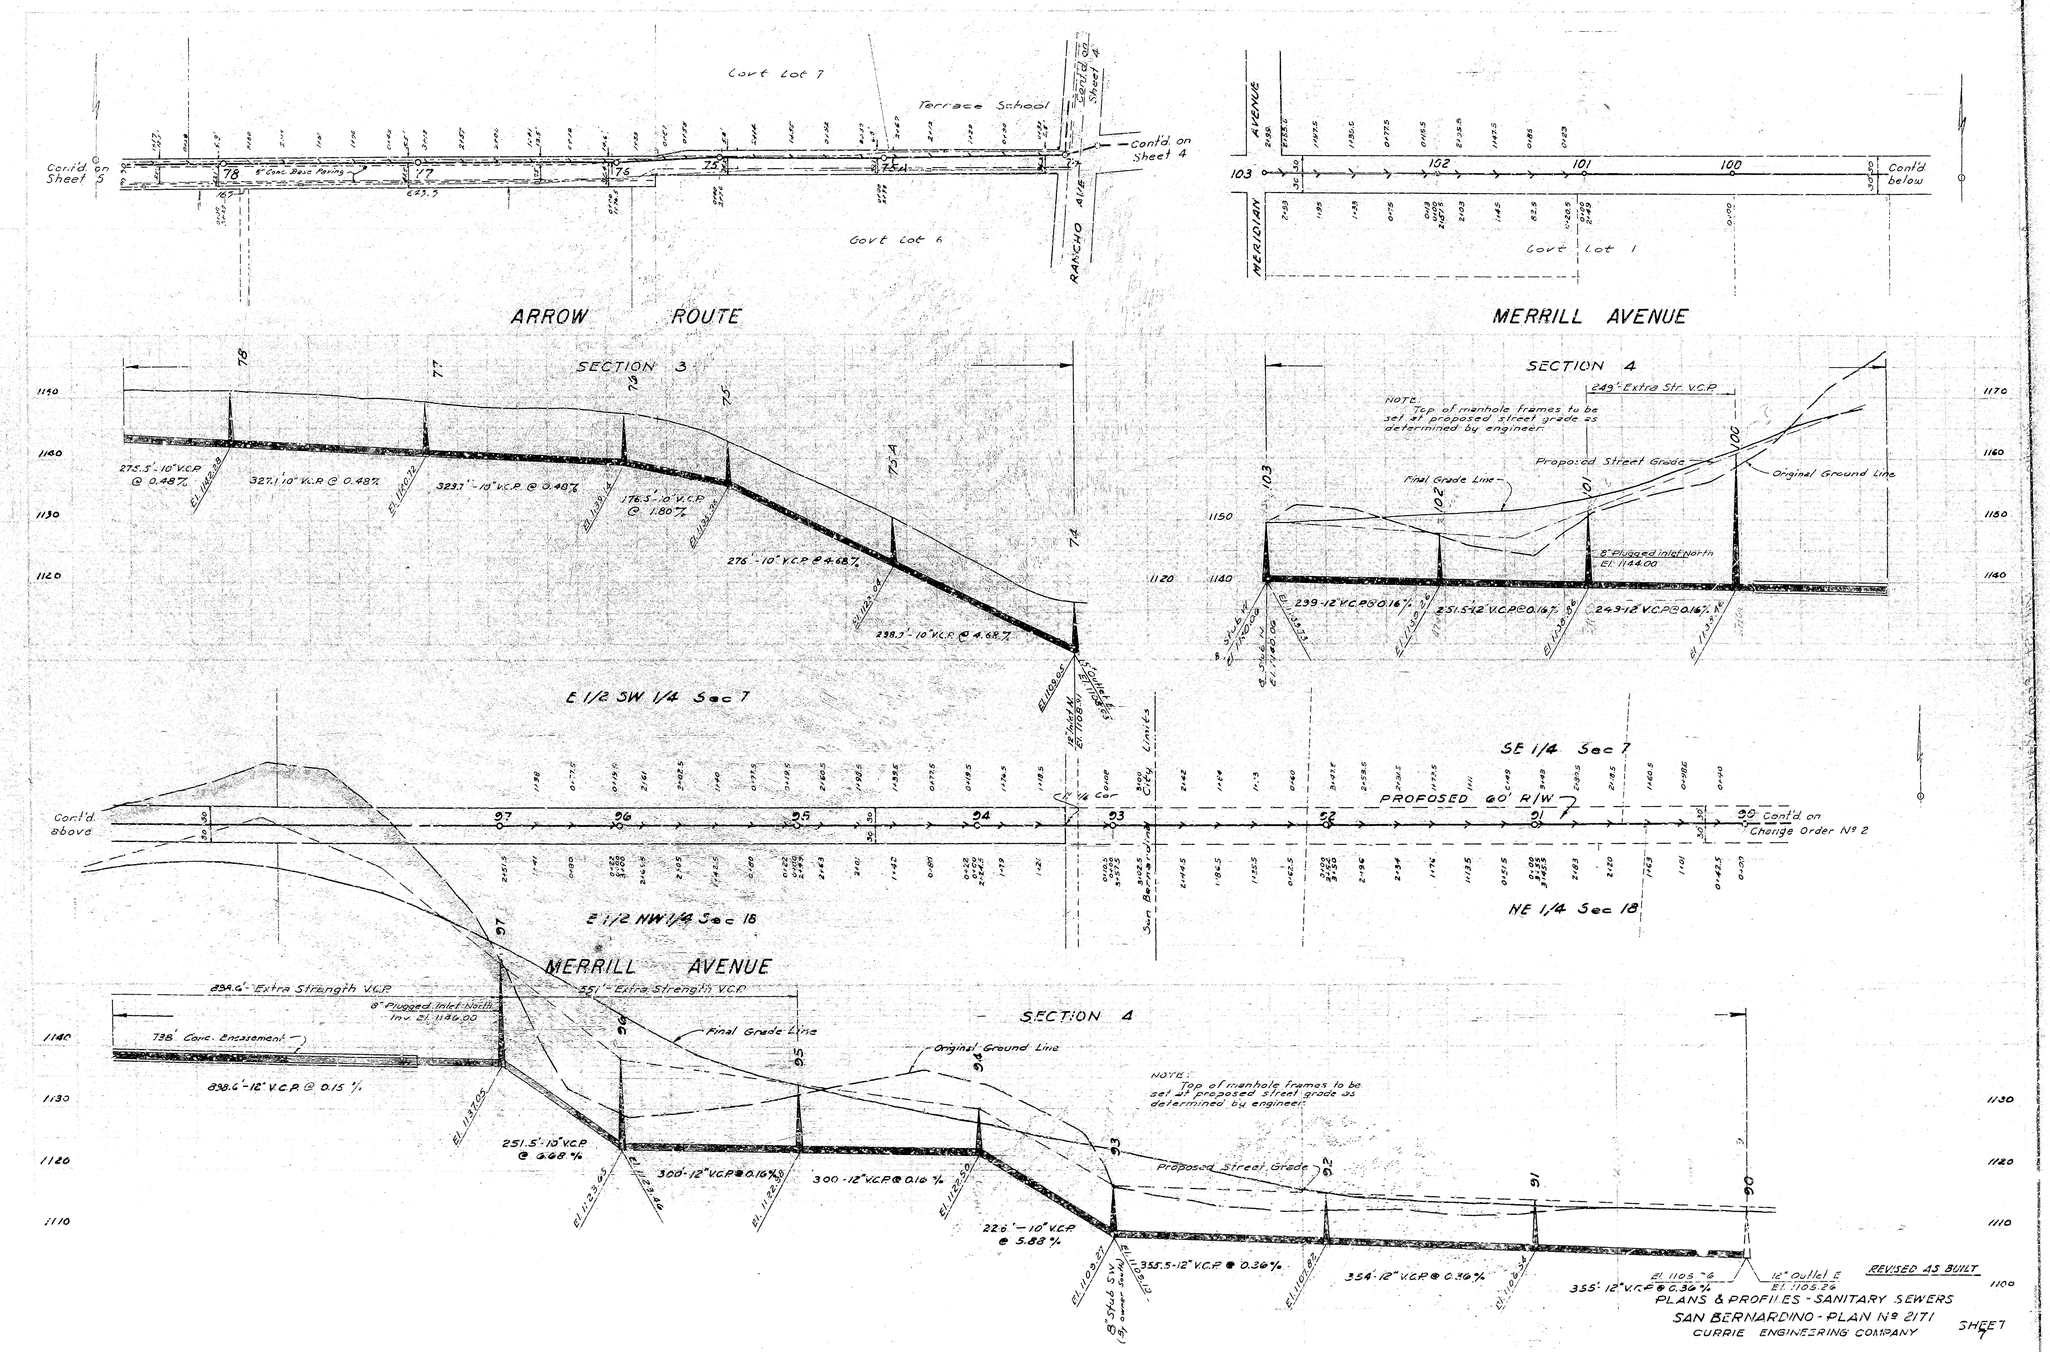
Govt Lot 7
Terrace School
Cont'd on Sheet 4
Cont'd on Sheet 5
8" Conc. Base Paving
Govt Lot 6
RANCHO AVE
ARROW ROUTE
AVENUE
MERIDIAN
Govt Lot 1
Cont'd below
MERRILL AVENUE
SECTION 3
275.5'-10" V.C.P. @ 0.48%
327.1'-10" V.C.P. @ 0.48%
323.7'-10" V.C.P. @ 0.48%
176.5'-10" V.C.P. @ 1.80%
276'-10" V.C.P. @ 4.48%
238.7'-10" V.C.P. @ 4.68%
SECTION 4
249'-Extra Str. V.C.P.
NOTE: Top of manhole frames to be set at proposed street grade as determined by engineer.
Proposed Street Grade
Original Ground Line
Final Grade Line
8" Plugged Inlet North El. 1144.00
239'-12" V.C.P. @ 0.16%
251.5'-12" V.C.P. @ 0.16%
249'-12" V.C.P. @ 0.16%
E 1/2 SW 1/4 Sec 7
SE 1/4 Sec 7
PROPOSED 60' R/W
Cont'd on Change Order No 2
Cont'd above
E 1/2 NW 1/4 Sec 18
NE 1/4 Sec 18
MERRILL AVENUE
SECTION 4
838.6'-Extra Strength V.C.P.
551'-Extra Strength V.C.P.
8" Plugged Inlet North Inv. El. 1146.00
738' Conc. Encasement
838.6'-12" V.C.P. @ 0.15%
251.5'-10" V.C.P. @ 6.68%
300'-12" V.C.P. @ 0.16%
300'-12" V.C.P. @ 0.16%
22.6'-10" V.C.P. @ 5.88%
355.5'-12" V.C.P. @ 0.36%
354'-12" V.C.P. @ 0.36%
355'-12" V.C.P. @ 0.36%
12" Outlet E El. 1105.26
REVISED AS BUILT
PLANS & PROFILES - SANITARY SEWERS
SAN BERNARDINO - PLAN No 2171
CURRIE ENGINEERING COMPANY
SHEET 7

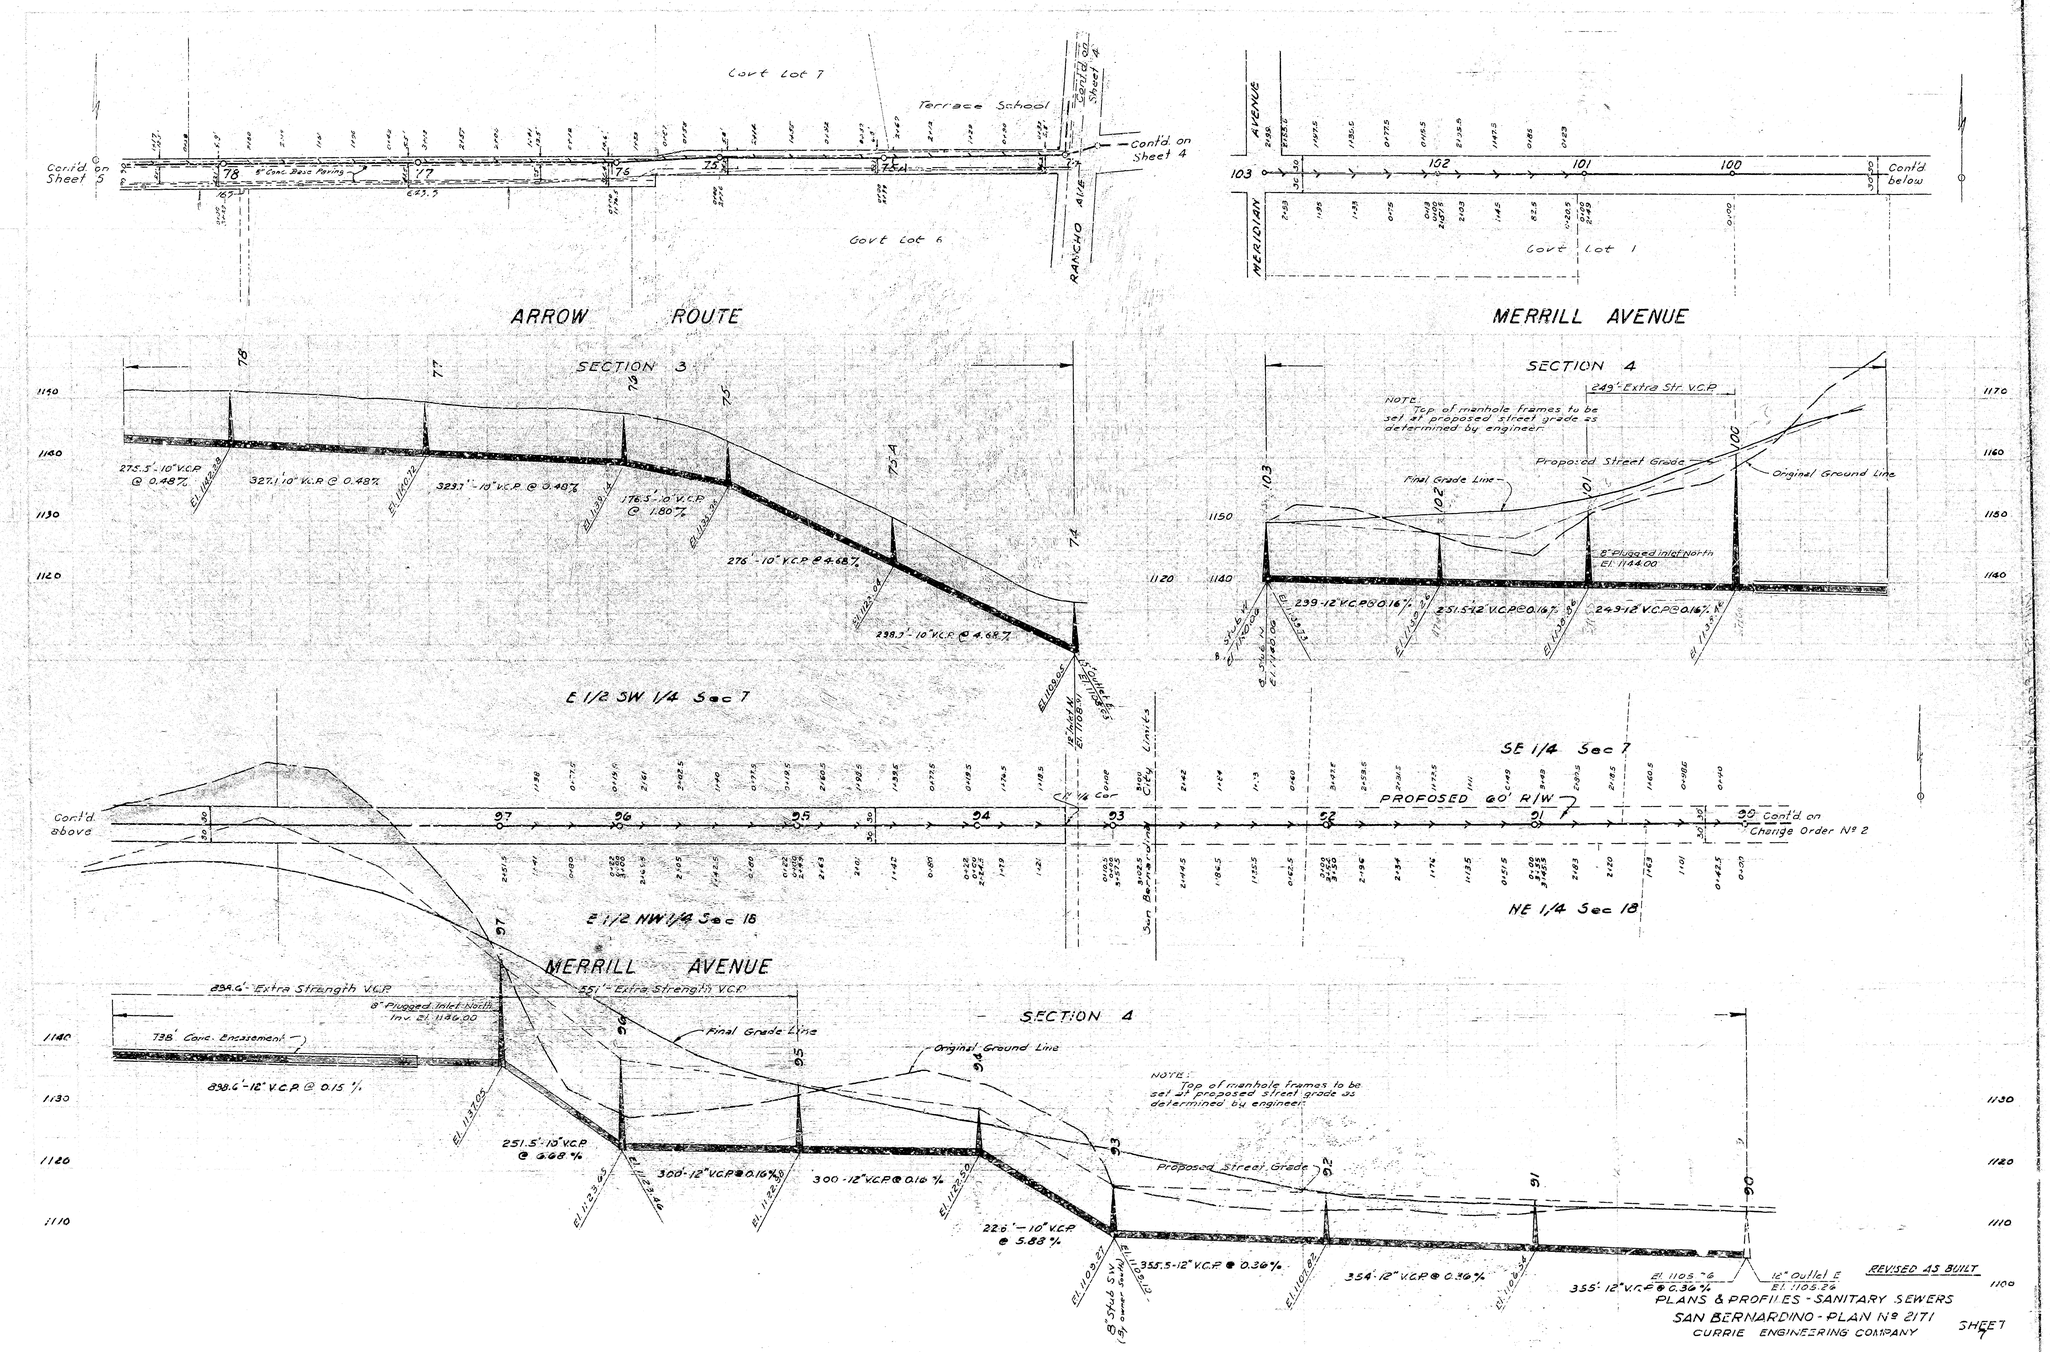
Govt Lot 7
Terrace School
Cont'd on Sheet 4
Cont'd on Sheet 5
8" Conc. Base Paving
Govt Lot 6
RANCHO AVE
ARROW ROUTE
AVENUE
MERIDIAN
Govt Lot 1
Cont'd below
MERRILL AVENUE
SECTION 3
275.5'-10" V.C.P. @ 0.48%
327.1'-10" V.C.P. @ 0.48%
323.7'-10" V.C.P. @ 0.48%
176.5'-10" V.C.P. @ 1.80%
276'-10" V.C.P. @ 4.48%
238.7'-10" V.C.P. @ 4.68%
SECTION 4
249'-Extra Str. V.C.P.
NOTE: Top of manhole frames to be set at proposed street grade as determined by engineer.
Proposed Street Grade
Original Ground Line
Final Grade Line
8" Plugged Inlet North El. 1144.00
239'-12" V.C.P. @ 0.16%
251.5'-12" V.C.P. @ 0.16%
249'-12" V.C.P. @ 0.16%
E 1/2 SW 1/4 Sec 7
SE 1/4 Sec 7
PROPOSED 60' R/W
Cont'd on Change Order No 2
Cont'd above
E 1/2 NW 1/4 Sec 18
NE 1/4 Sec 18
MERRILL AVENUE
SECTION 4
838.6'-Extra Strength V.C.P.
551'-Extra Strength V.C.P.
8" Plugged Inlet North Inv. El. 1146.00
738' Conc. Encasement
838.6'-12" V.C.P. @ 0.15%
251.5'-10" V.C.P. @ 6.68%
300'-12" V.C.P. @ 0.16%
300'-12" V.C.P. @ 0.16%
22.6'-10" V.C.P. @ 5.88%
355.5'-12" V.C.P. @ 0.36%
354'-12" V.C.P. @ 0.36%
355'-12" V.C.P. @ 0.36%
12" Outlet E El. 1105.26
REVISED AS BUILT
PLANS & PROFILES - SANITARY SEWERS
SAN BERNARDINO - PLAN No 2171
CURRIE ENGINEERING COMPANY
SHEET 7