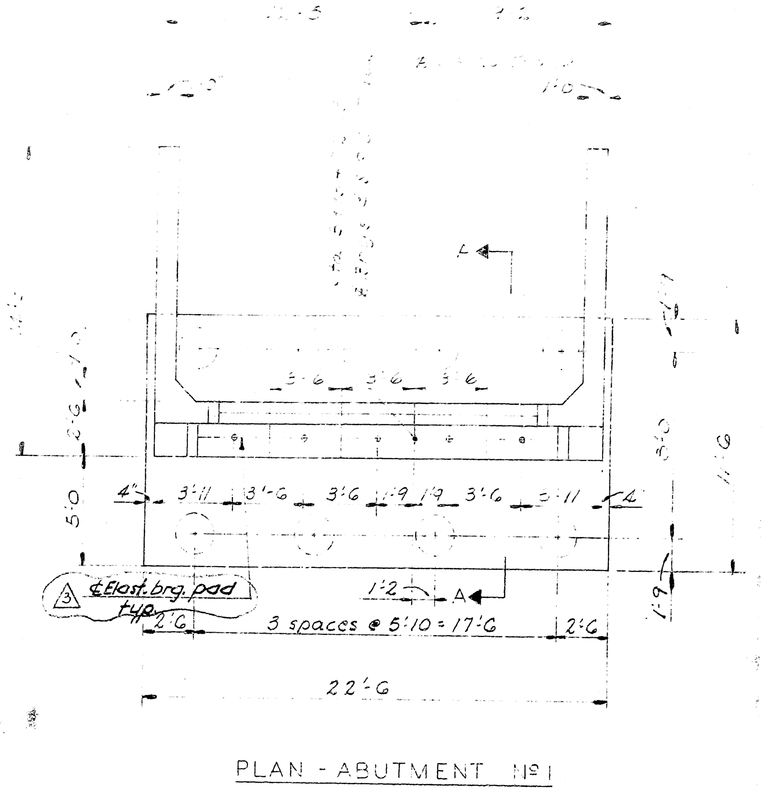

PLAN - ABUTMENT No 1

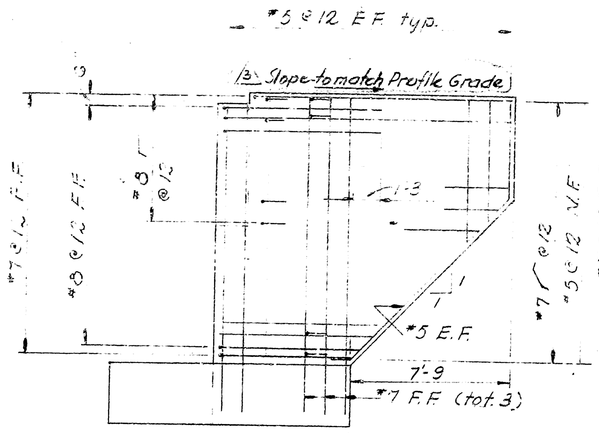

WINGWALL ELEVATION
ABUTMENT No 1

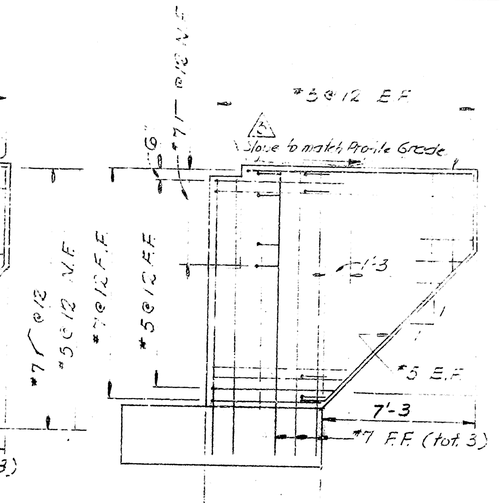

WINGWALL ELEVATION
ABUTMENT No 7

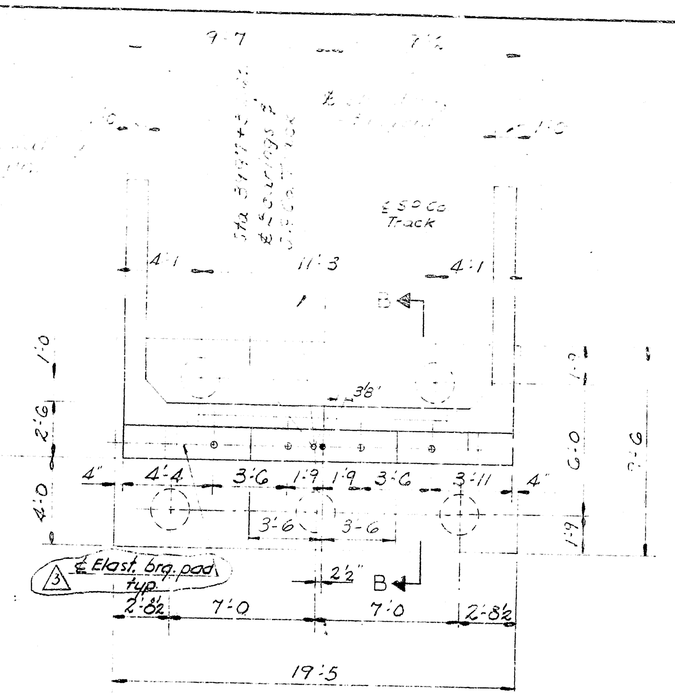

PLAN - ABUTMENT No 7

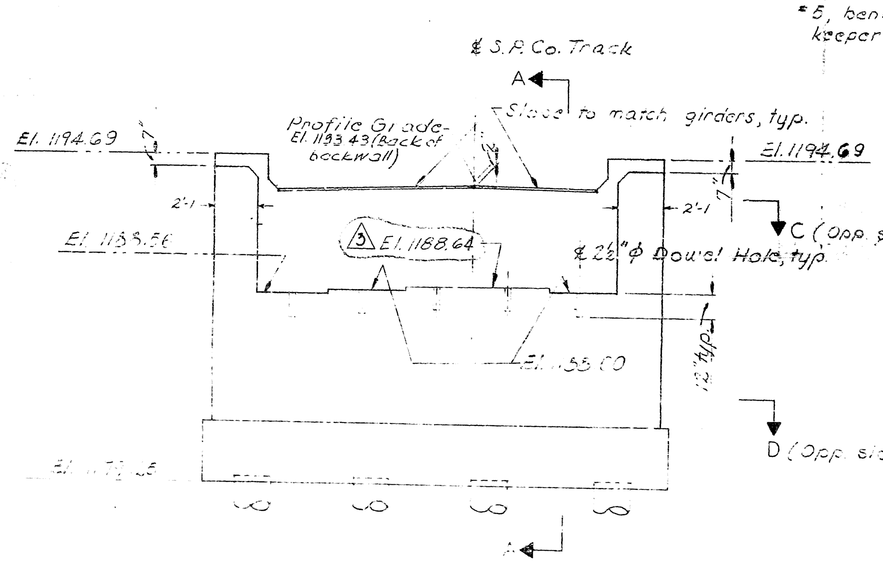

ELEVATION - ABUTMENT No 1

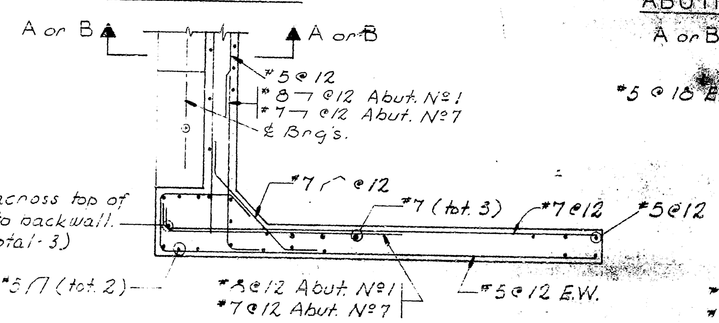

SECTION C-C

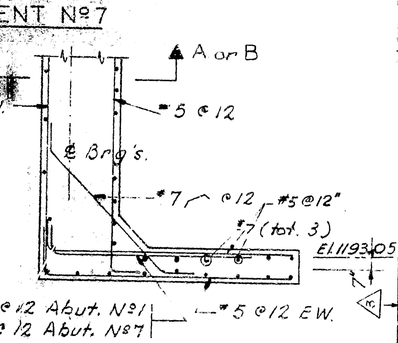

SECTION D-D

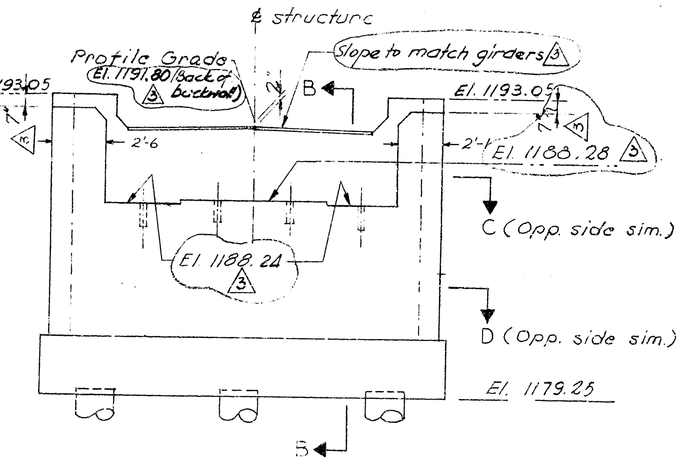

ELEVATION - ABUTMENT No 7

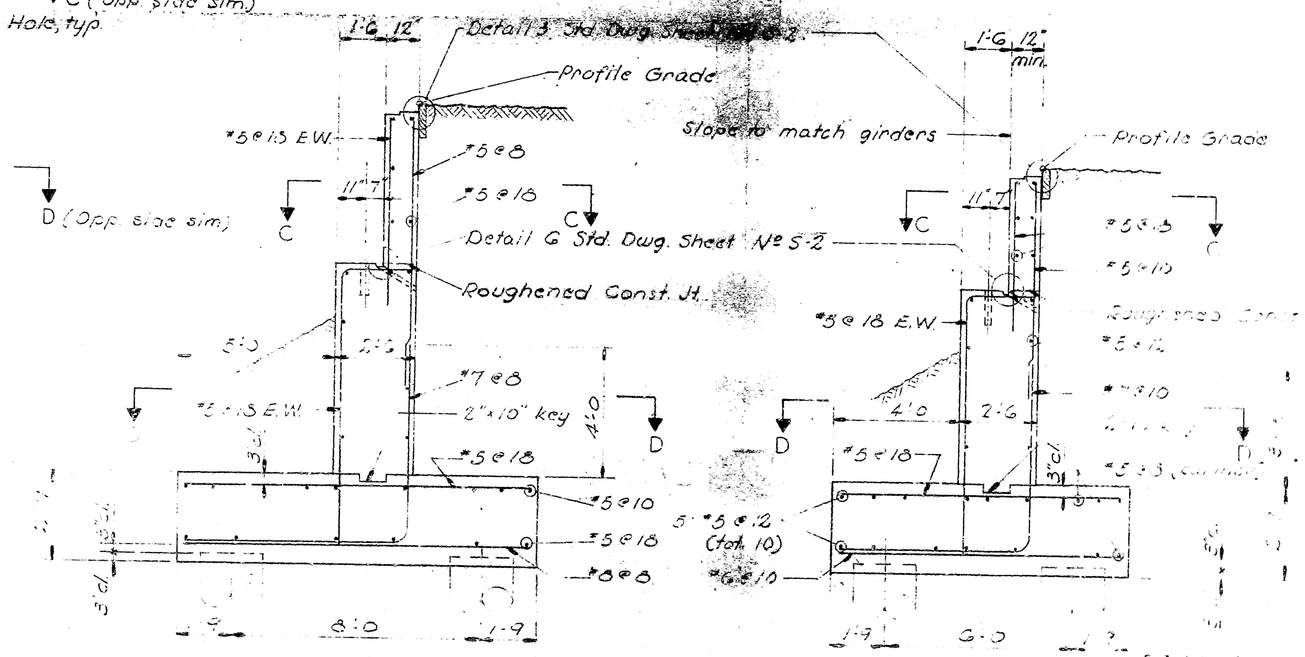

SECTION A-A

SECTION B-B

AS BUILT

COLTON CUT-OFF

SOUTHERN PACIFIC COMPANY
PACIFIC LINES

CITY OF SAN BERNARDINO

ARROW ROUTE-RIALTO AVE. UNDERPASS
BRIDGE M.P. 490.0

ABUT. No 1 & ABUT. No 7

DE LEUW, CATHER & COMPANY
ENGINEERS
SAN FRANCISCO, CALIFORNIA

SHEET NO. AR-4
SCALE 4"=1' & As Noted
DATE 1-30-1958

DESIGNED BY
DRAWN BY
CHECKED BY
APPROVED BY

1 Miscellaneous corrections incl. N 7 — AL
Pile Note 2 revised Add step in abut. seat — CV