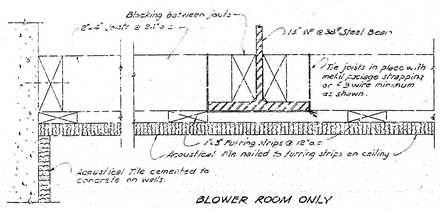

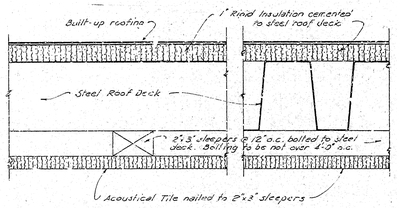

DETAIL FOR FASTENING ACOUSTICAL TILE
Scale : 3" = 1'-0"

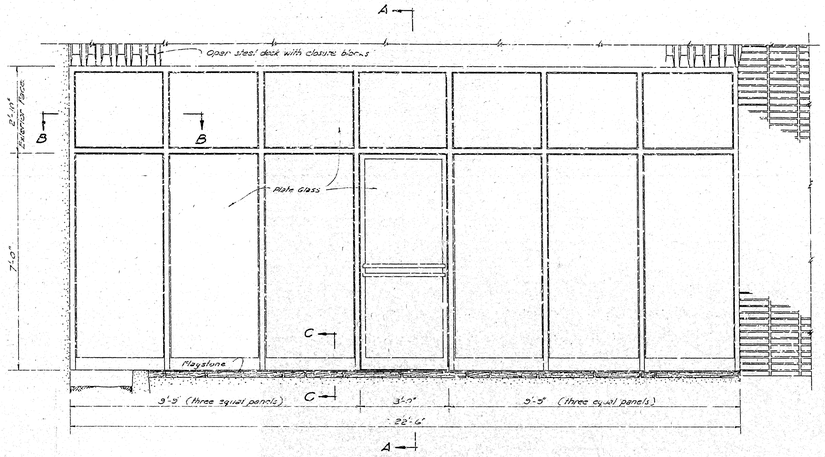

ELEVATION - MAIN ENTRANCE
Scale : 1/8" = 1'-0"
"Wallblit" Kawneer or equal.
Glazing to be for exterior date pass.
Submit drawings for approval.

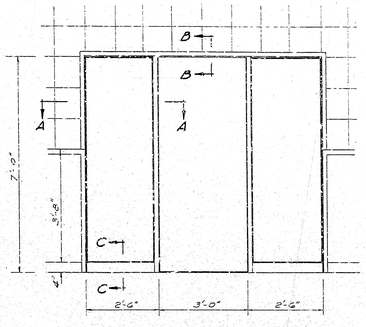

ELEVATION - DOOR & SIDE LIGHTS BETWEEN OFFICE & BLOWER ROOM
Scale : 1/2" = 1'-0"

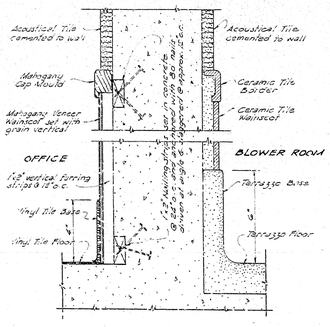

DETAIL - WALL SECTION
BETWEEN OFFICE & BLOWER ROOM
Scale : 3" = 1'-0"

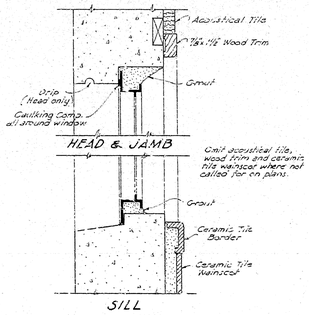

DETAIL - METAL WINDOWS
Scale : 3" = 1'-0"

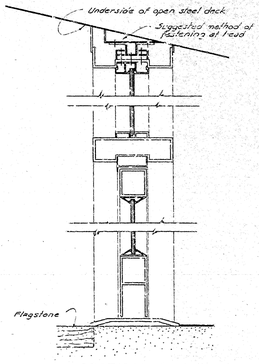

SECTION A-A
Scale : 3" = 1'-0"

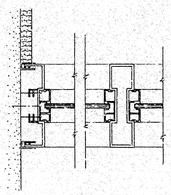

SECTION B-B
Scale : 3" = 1'-0"

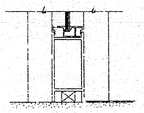

SECTION C-C
Scale : 3" = 1'-0"

MAIN ENTRANCE DETAILS

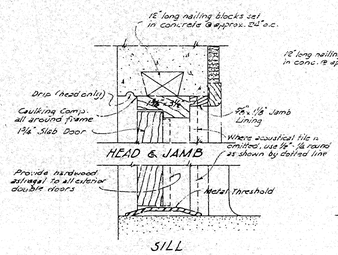

DETAIL
EXTERIOR DOOR FRAMES
EXCEPT MAIN ENTRANCE
Scale : 3" = 1'-0"

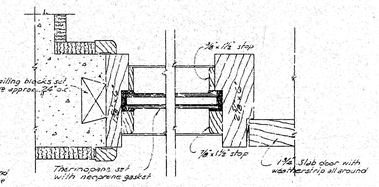

SECTION A-A
Scale : 3" = 1'-0"

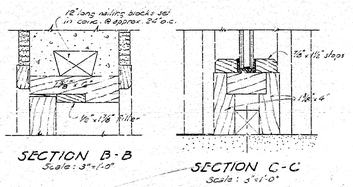

SECTION B-B
Scale : 3" = 1'-0"

SECTION C-C
Scale : 3" = 1'-0"

DOOR & SIDE LIGHTS DETAILS

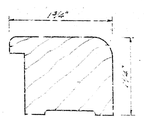

FULL SIZE DETAIL
MAHOGANY CAP MOULD

FULL SIZE DETAIL
WOOD TRIM TO BE USED
WITH ACOUSTICAL TILE

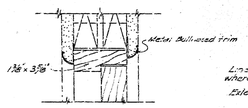

DETAIL
INTERIOR DOOR FRAMES
Scale : 3" = 1'-0"

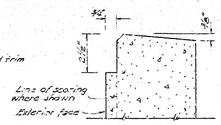

DETAIL
TOP OF CONC. WALLS
Scale : 3" = 1'-0"

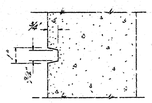

DETAIL OF SCORING
Scale : 3" = 1'-0"

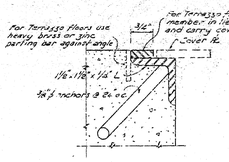

DETAIL
FRAME FOR PLATE COVER
Scale : Half Full Size.
NOTE: This frame to be used wherever sizes of aluminum plate covers are specified, unless otherwise noted.

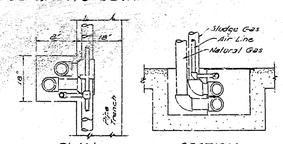

PLAN
SECTION
DETAIL - PIPE TRENCH
Scale : 1/4" = 1'-0"

REVISED "AS BUILT"

SEWAGE TREATMENT WORKS
SAN BERNARDINO
CALIFORNIA
1958

CURRIE ENGINEERING COMPANY
CONSULTING ENGINEERS

CONTROL BUILDING DETAILS | 7

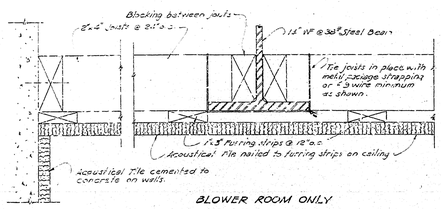

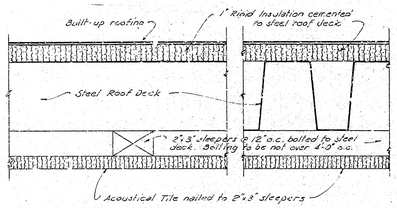

DETAIL FOR FASTENING ACOUSTICAL TILE
Scale : 3" = 1'-0"

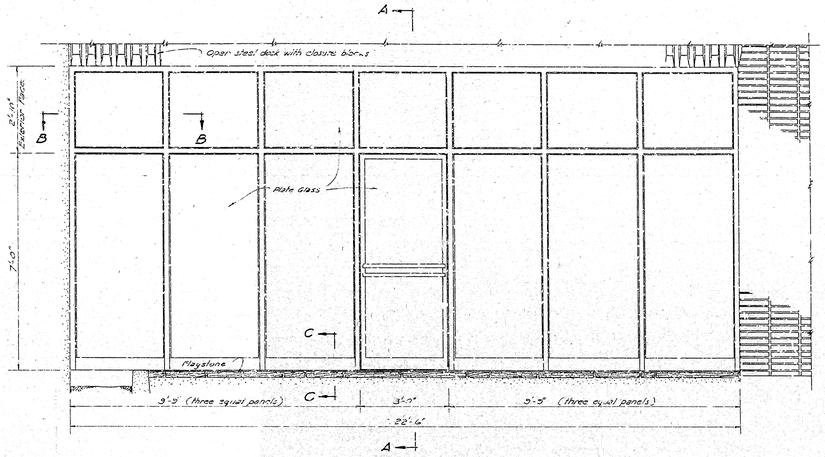

ELEVATION - MAIN ENTRANCE
Scale : 1/8" = 1'-0"
"Wallblit" Kawneer or equal.
Glazing to be for exterior date pass.
Submit drawings for approval.

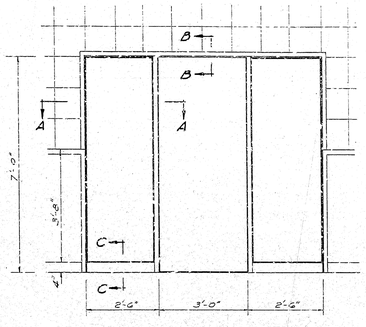

ELEVATION - DOOR & SIDE LIGHTS BETWEEN OFFICE & BLOWER ROOM
Scale : 1/2" = 1'-0"

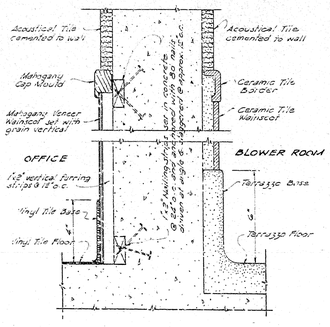

DETAIL - WALL SECTION
BETWEEN OFFICE & BLOWER ROOM
Scale : 3" = 1'-0"

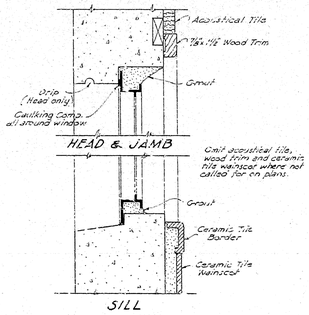

DETAIL - METAL WINDOWS
Scale : 3" = 1'-0"

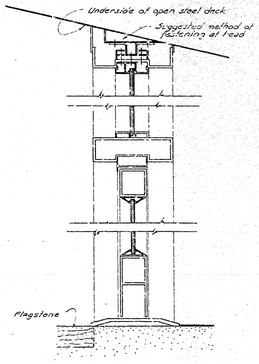

SECTION A-A
Scale : 3" = 1'-0"

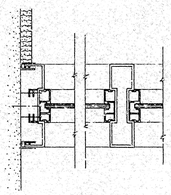

SECTION B-B
Scale : 3" = 1'-0"

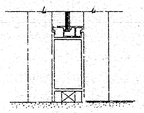

SECTION C-C
Scale : 3" = 1'-0"

MAIN ENTRANCE DETAILS

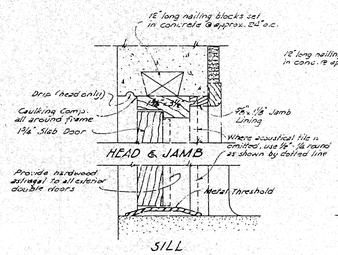

DETAIL
EXTERIOR DOOR FRAMES
EXCEPT MAIN ENTRANCE
Scale : 3" = 1'-0"

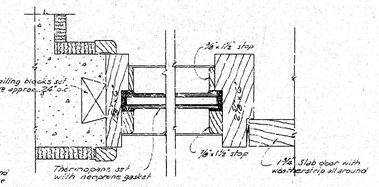

SECTION A-A
Scale : 3" = 1'-0"

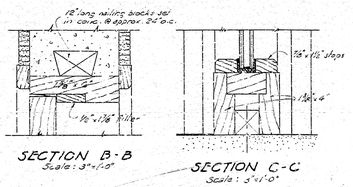

SECTION B-B
Scale : 3" = 1'-0"

SECTION C-C
Scale : 3" = 1'-0"

DOOR & SIDE LIGHTS DETAILS

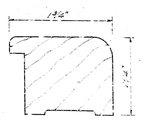

FULL SIZE DETAIL
MAHOGANY CAP MOULD

FULL SIZE DETAIL
WOOD TRIM TO BE USED
WITH ACOUSTICAL TILE

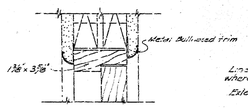

DETAIL
INTERIOR DOOR FRAMES
Scale : 3" = 1'-0"

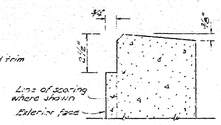

DETAIL
TOP OF CONC. WALLS
Scale : 3" = 1'-0"

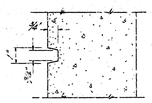

DETAIL OF SCORING
Scale : 3" = 1'-0"

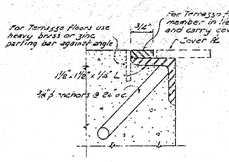

DETAIL
FRAME FOR PLATE COVER
Scale : Half Full Size.
NOTE: This frame to be used wherever sizes of aluminum plate covers are specified, unless otherwise noted.

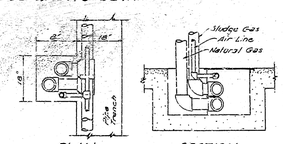

PLAN
SECTION
DETAIL - PIPE TRENCH
Scale : 1/4" = 1'-0"

REVISED "AS BUILT"

SEWAGE TREATMENT WORKS
SAN BERNARDINO
CALIFORNIA
1958

CURRIE ENGINEERING COMPANY
CONSULTING ENGINEERS

CONTROL BUILDING DETAILS | 7