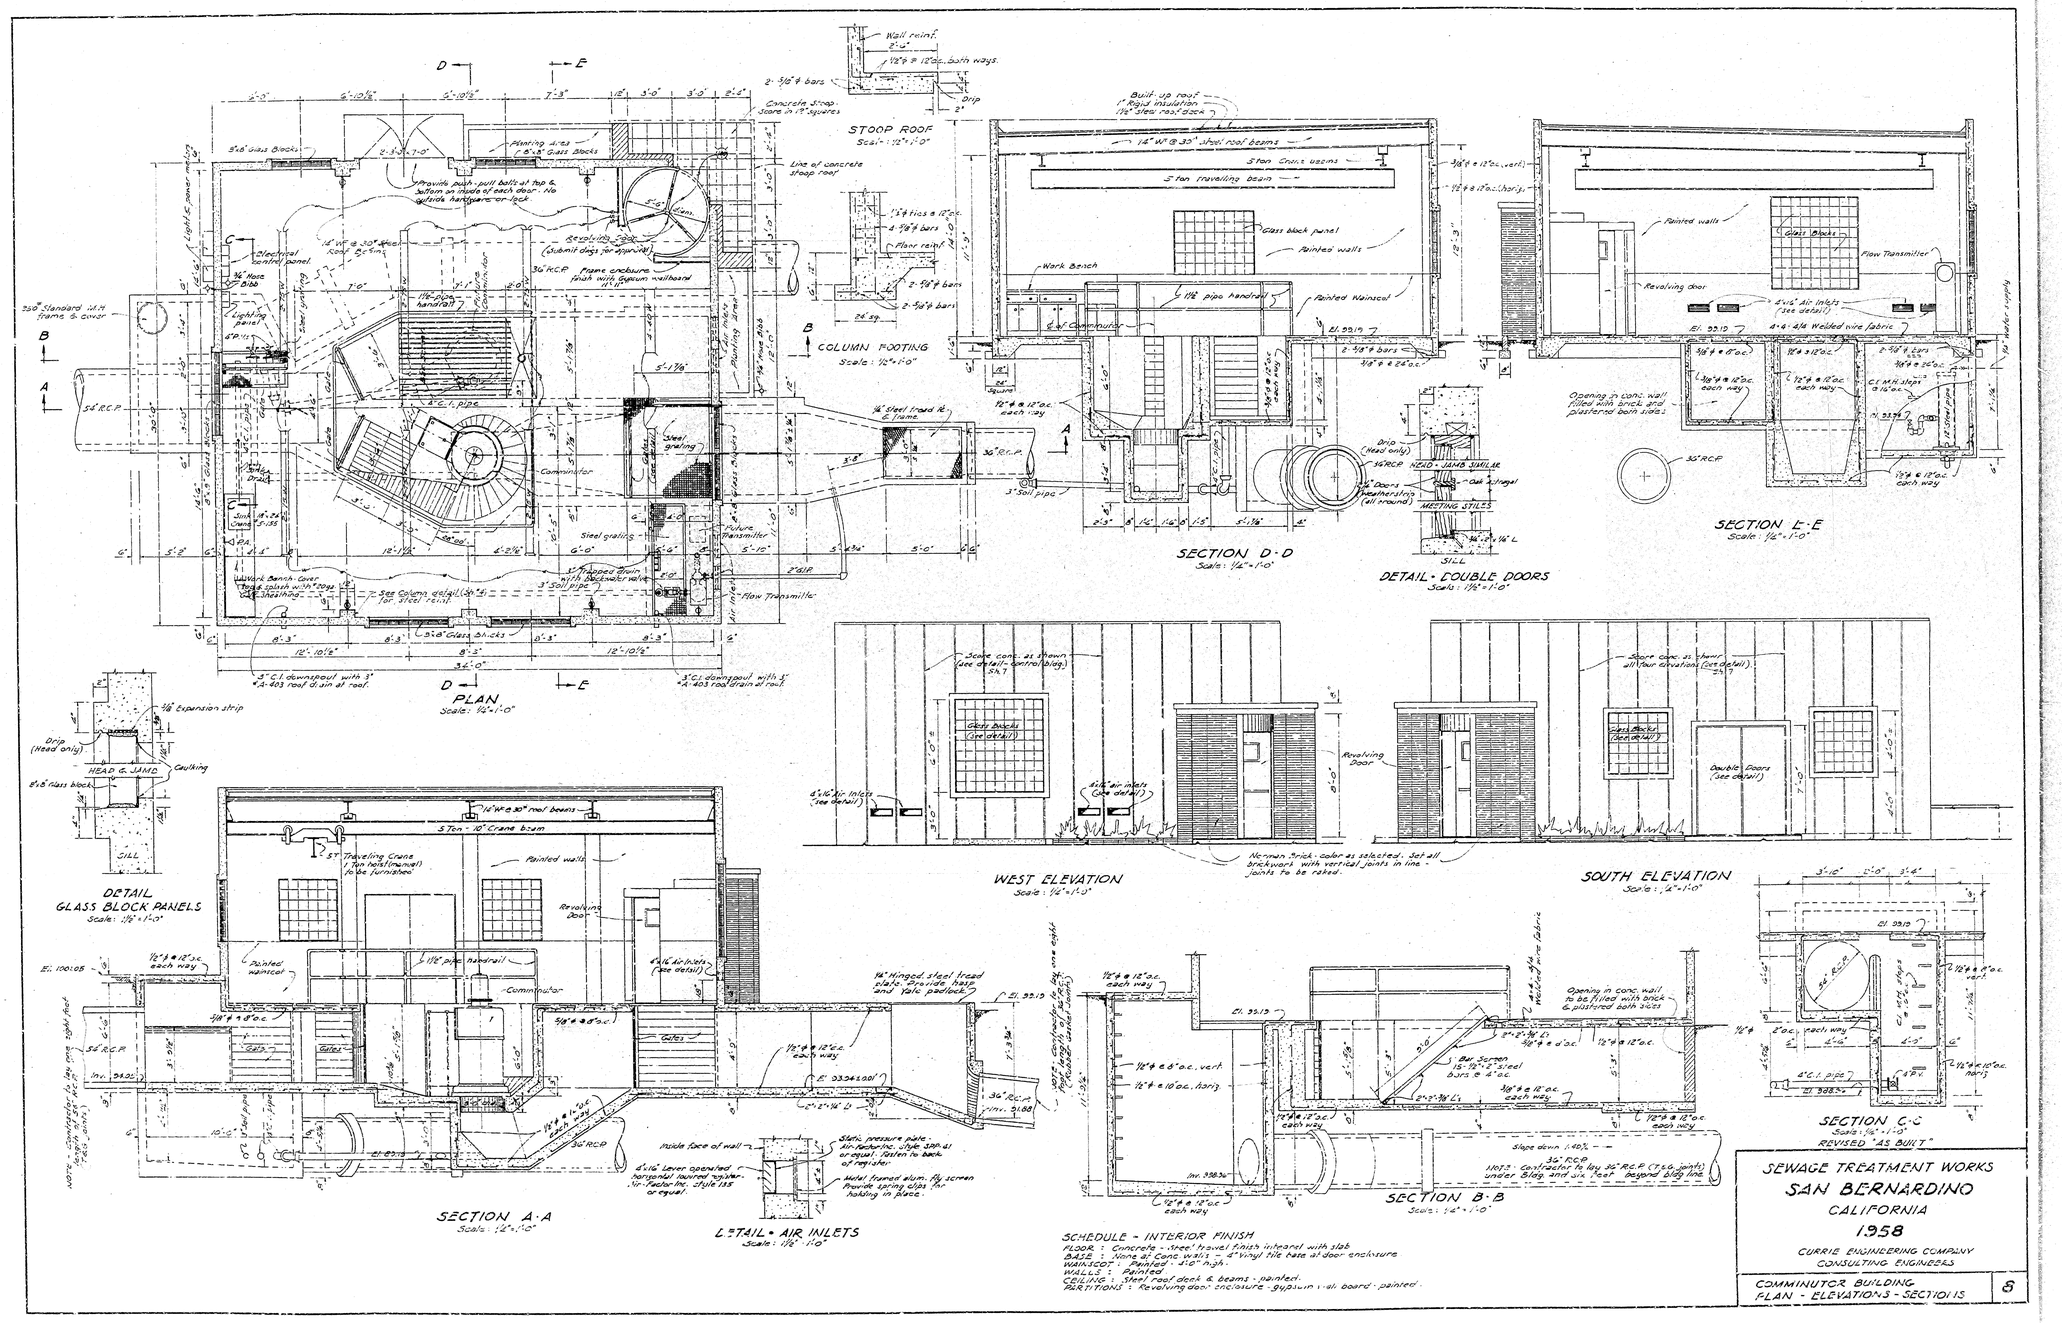
STOOP ROOF
Scale: 1/2"=1'-0"
COLUMN FOOTING
Scale: 1/2"=1'-0"
PLAN
Scale: 1/2"=1'-0"
SECTION D-D
Scale: 1/2"=1'-0"
SECTION E-E
Scale: 1/2"=1'-0"
DETAIL - DOUBLE DOORS
Scale: 1 1/2"=1'-0"
DETAIL
GLASS BLOCK PANELS
Scale: 1 1/2"=1'-0"
WEST ELEVATION
Scale: 1/2"=1'-0"
SOUTH ELEVATION
Scale: 1/2"=1'-0"
SECTION A-A
Scale: 1/2"=1'-0"
DETAIL - AIR INLETS
Scale: 1 1/2"=1'-0"
SECTION B-B
Scale: 1/2"=1'-0"
SECTION C-C
Scale: 1/2"=1'-0"
REVISED "AS BUILT"
SCHEDULE - INTERIOR FINISH
FLOOR : Concrete - steel trowel finish integral with slab
BASE : None at Conc. walls. 4" Vinyl tile base at door enclosure
WAINSCOT : Painted - 4'-0" high.
WALLS : Painted
CEILING : Steel roof deck & beams - painted.
PARTITIONS : Revolving door enclosure - gypsum board - painted.
SEWAGE TREATMENT WORKS
SAN BERNARDINO
CALIFORNIA
1958
CURRIE ENGINEERING COMPANY
CONSULTING ENGINEERS
COMMINUTOR BUILDING
PLAN - ELEVATIONS - SECTIONS

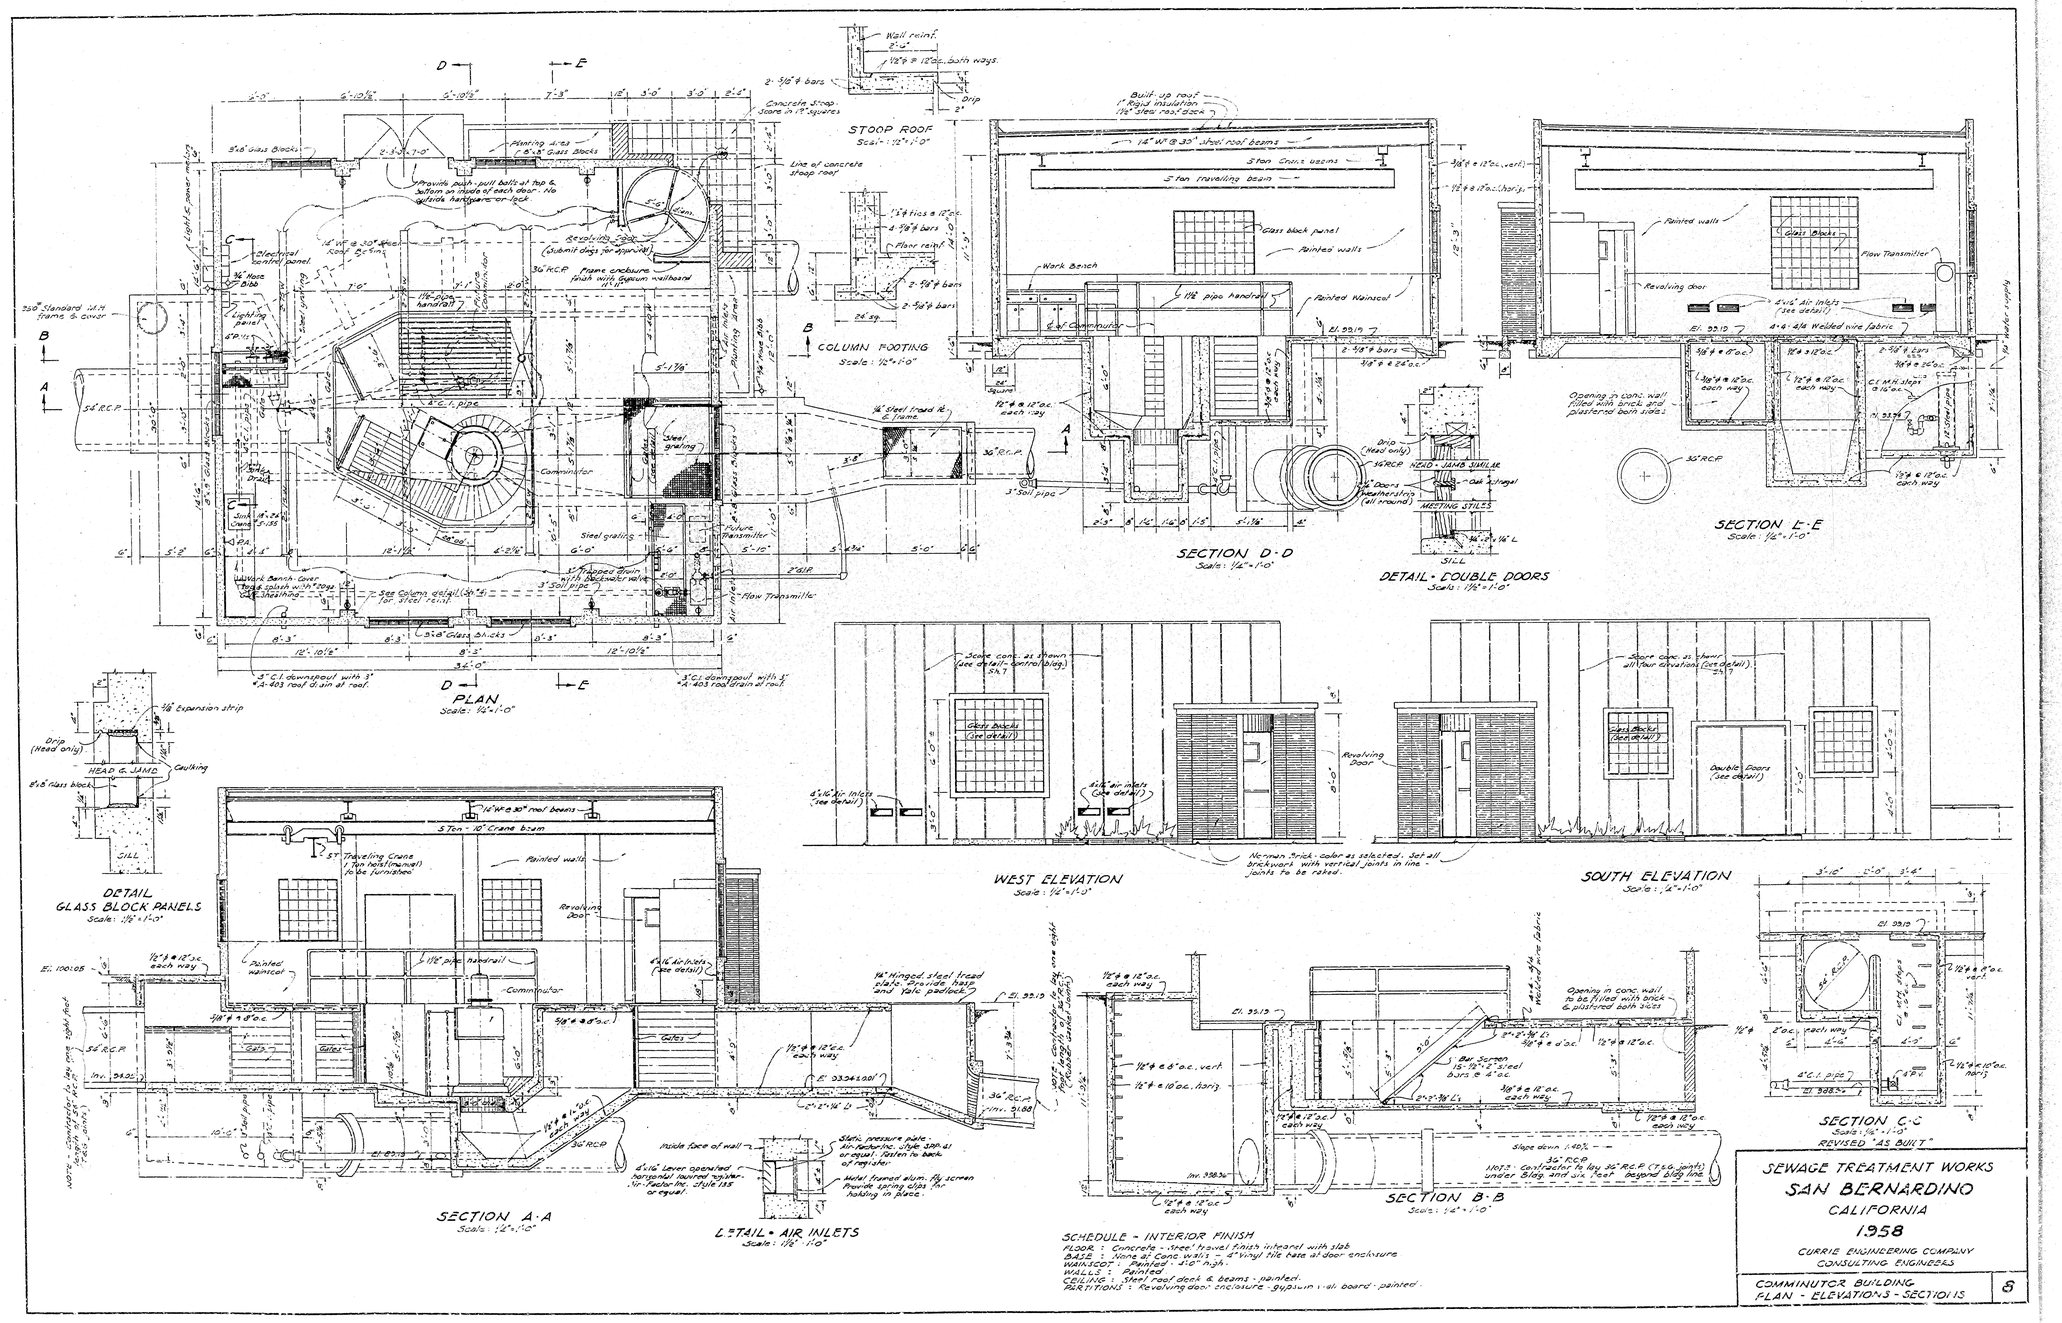
STOOP ROOF
Scale: 1/2"=1'-0"
COLUMN FOOTING
Scale: 1/2"=1'-0"
PLAN
Scale: 1/2"=1'-0"
SECTION D-D
Scale: 1/2"=1'-0"
SECTION E-E
Scale: 1/2"=1'-0"
DETAIL - DOUBLE DOORS
Scale: 1 1/2"=1'-0"
DETAIL
GLASS BLOCK PANELS
Scale: 1 1/2"=1'-0"
WEST ELEVATION
Scale: 1/2"=1'-0"
SOUTH ELEVATION
Scale: 1/2"=1'-0"
SECTION A-A
Scale: 1/2"=1'-0"
DETAIL - AIR INLETS
Scale: 1 1/2"=1'-0"
SECTION B-B
Scale: 1/2"=1'-0"
SECTION C-C
Scale: 1/2"=1'-0"
REVISED "AS BUILT"
SCHEDULE - INTERIOR FINISH
FLOOR : Concrete - steel trowel finish integral with slab
BASE : None at Conc. walls. 4" Vinyl tile base at door enclosure
WAINSCOT : Painted - 4'-0" high.
WALLS : Painted
CEILING : Steel roof deck & beams - painted.
PARTITIONS : Revolving door enclosure - gypsum board - painted.
SEWAGE TREATMENT WORKS
SAN BERNARDINO
CALIFORNIA
1958
CURRIE ENGINEERING COMPANY
CONSULTING ENGINEERS
COMMINUTOR BUILDING
PLAN - ELEVATIONS - SECTIONS
